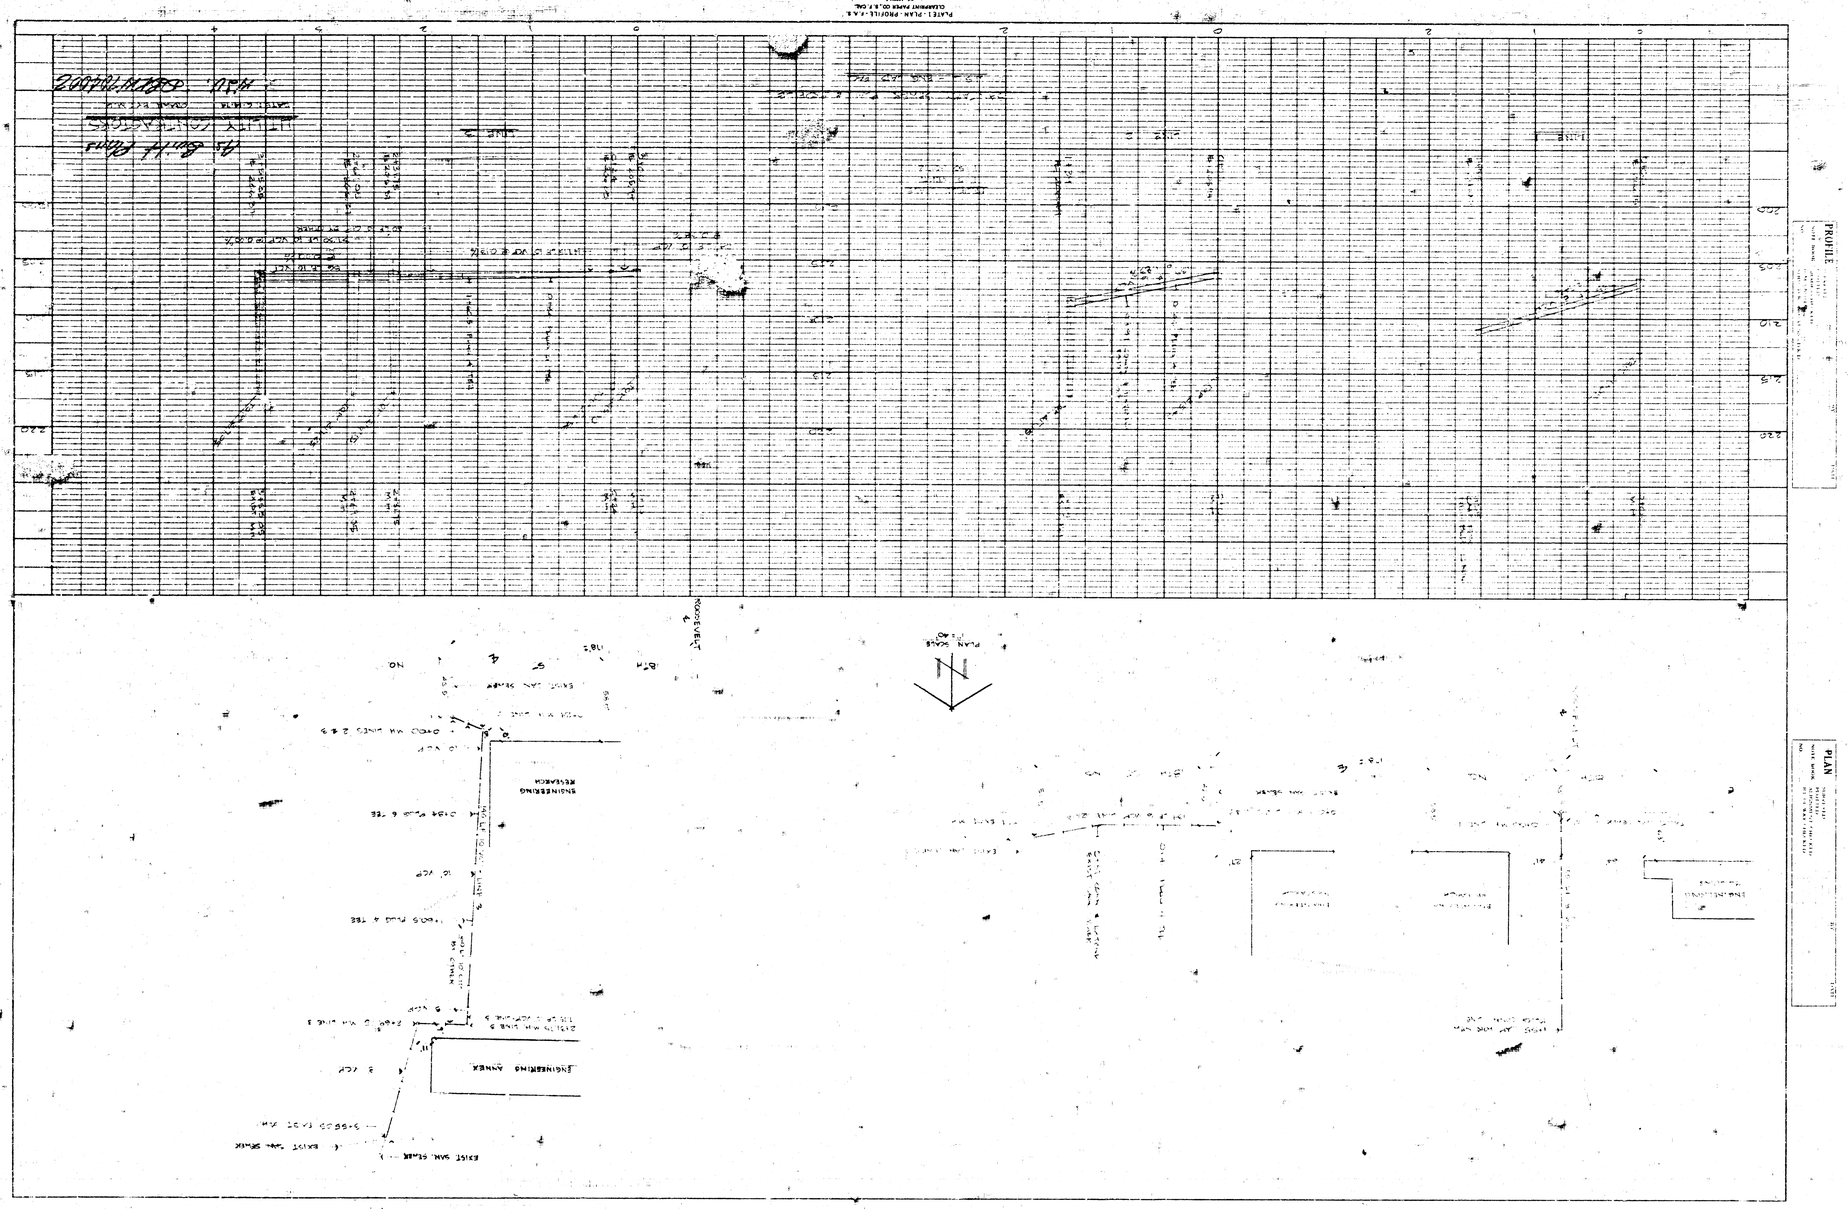
PLAN
PROFILE
PLAN SCALE
ENGINEERING ANNEX
ENGINEERING RESEARCH
EXIST SAN SEWER
EXIST SAN SEWER
10" VCP
3" VCP
10" VCP
3" VCP
PLAN SCALE
PROFILE
PLATE 1 - PLAN - PROFILE - E.A.R.

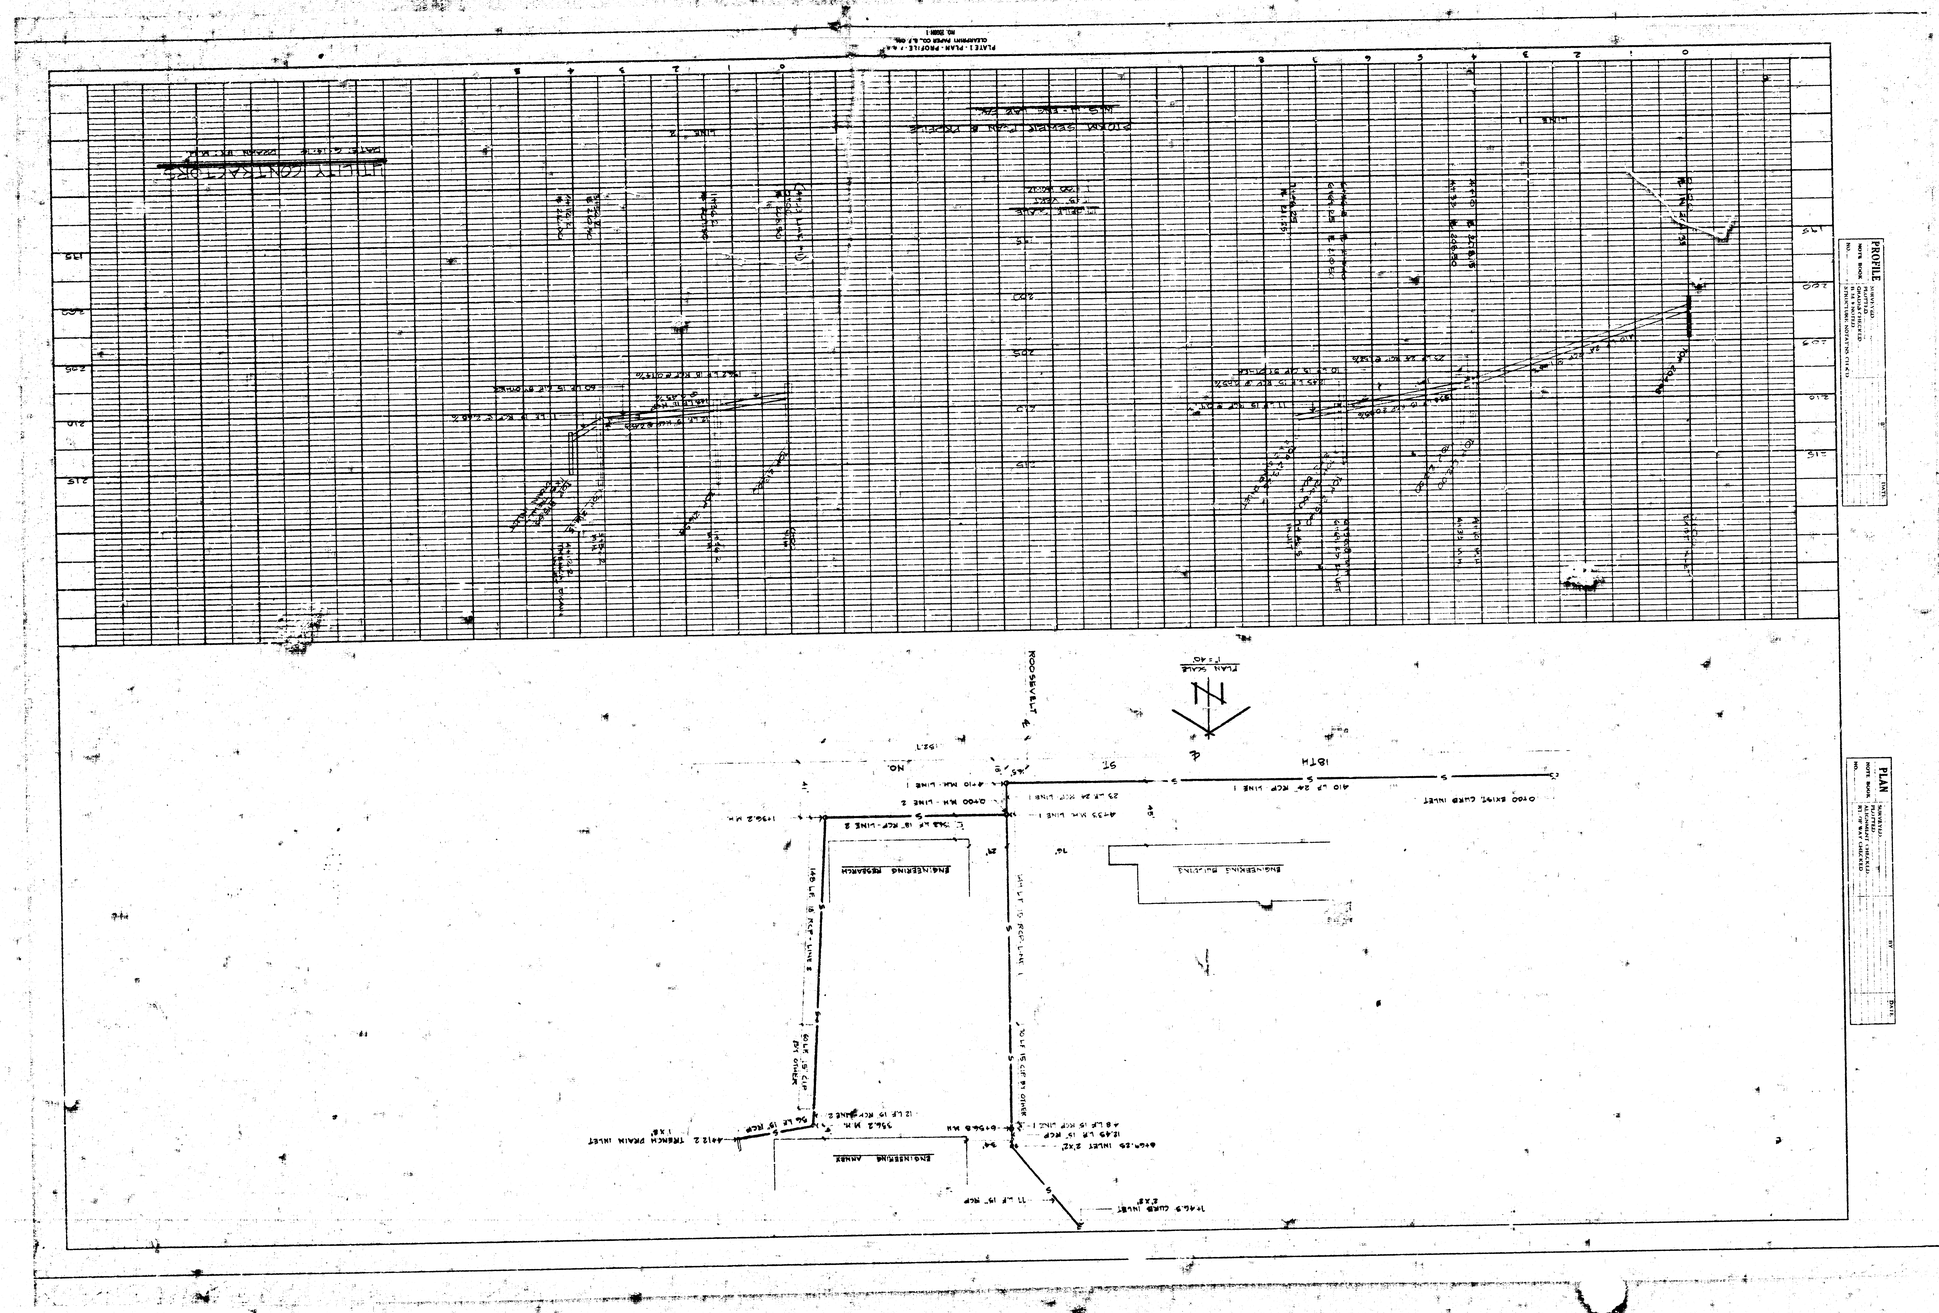
PLAN
PROFILE
ROOSEVELT
18TH
PLAN SCALE
1" = 40'
ENGINEERING BUILDING
ENGINEERING RESEARCH
ENGINEERING ANNEX
UTILITY CONTACTORS