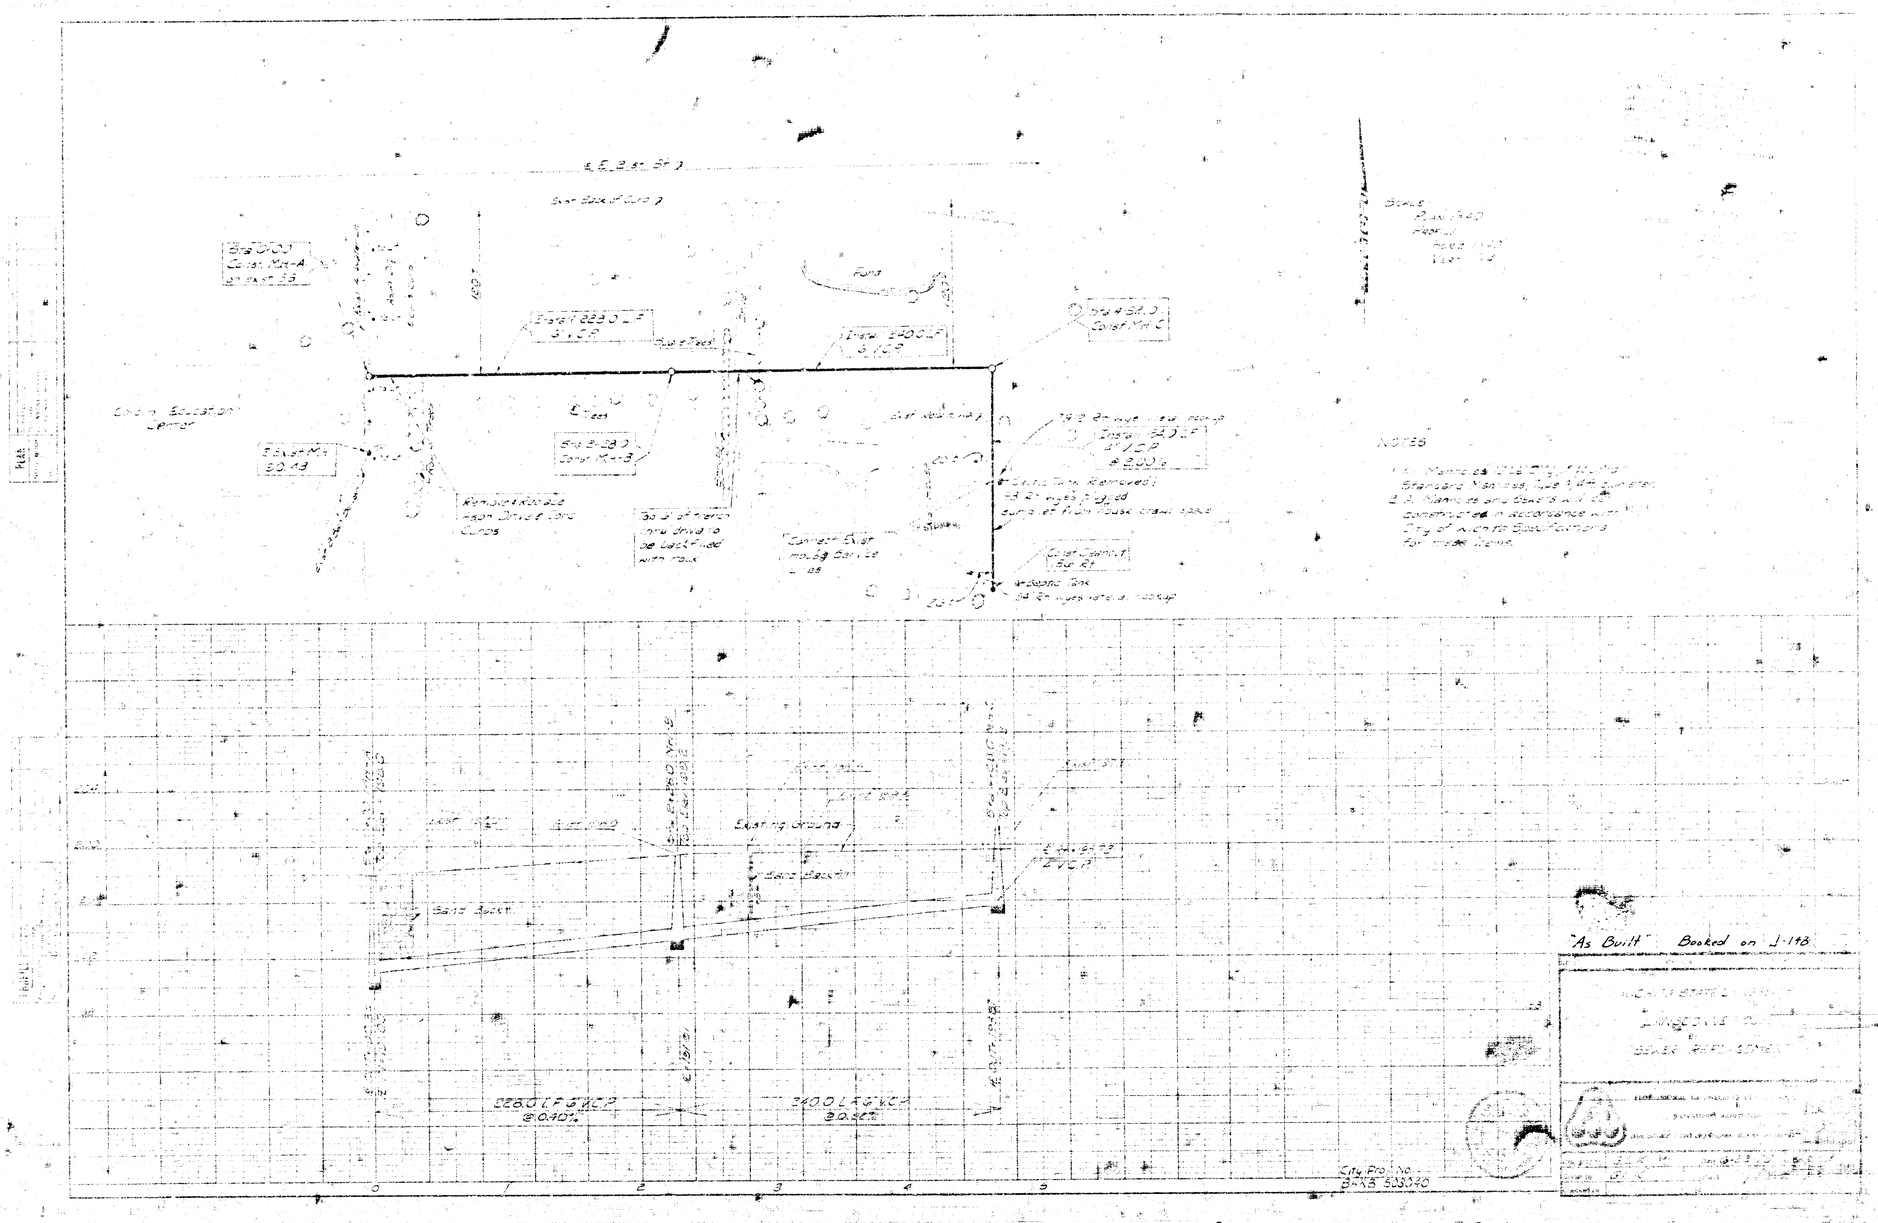
Notes
"As Built" Booked on J-148
Existing Ground
City Project No.
B-KB 539040