




NOTE TO CONTRACTOR

B.M. "M" in Mueller on Fire
Hydrant @ SE Cor. Waterman
& Greenwich. Elev. 176.07

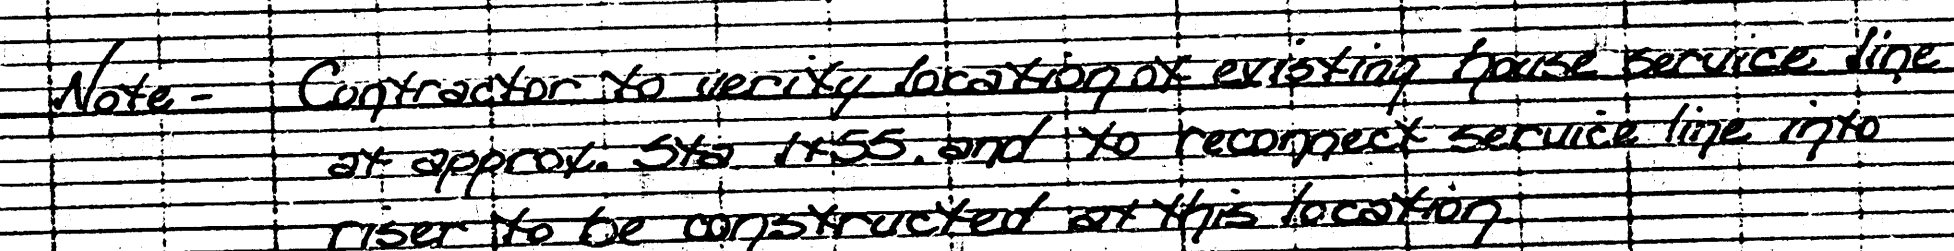

Risers shall be constructed on this project to serve individual houses where necessary as ordered by the field engineer. River construction shall conform to City of Wichita specs. All risers shall be constructed using S.O.R. 23.5 g.p.s. or PVC pipe.

APPROVED AS NOTED
By CITY ENGINEER OF WICHITA

Sanitary Sewers *YAS Ben 2-24-93*

Storm Sewers

Driveway Approaches

PRIVATE SANITARY SEWER RELOCATION
TO SERVE LOT 1, GLADYS WIEDEMANN ADD.
PRIVATE CITY PROJ. 468-76-245-80000-000-000-008

BAUGHMAN COMPANY, P.A.
SURVEYING & ENGINEERING
316/262-7271 • 330 LAURA • WICHITA, KANSAS 67211

09-7-80