

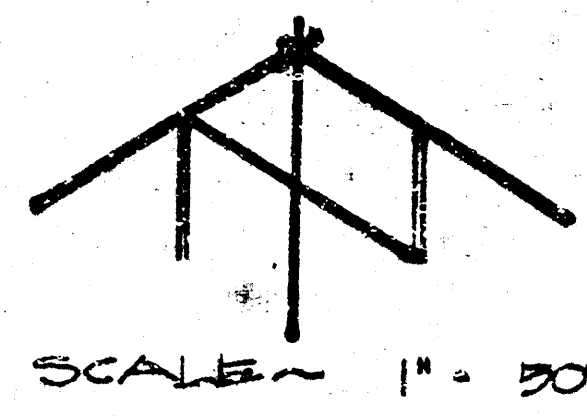
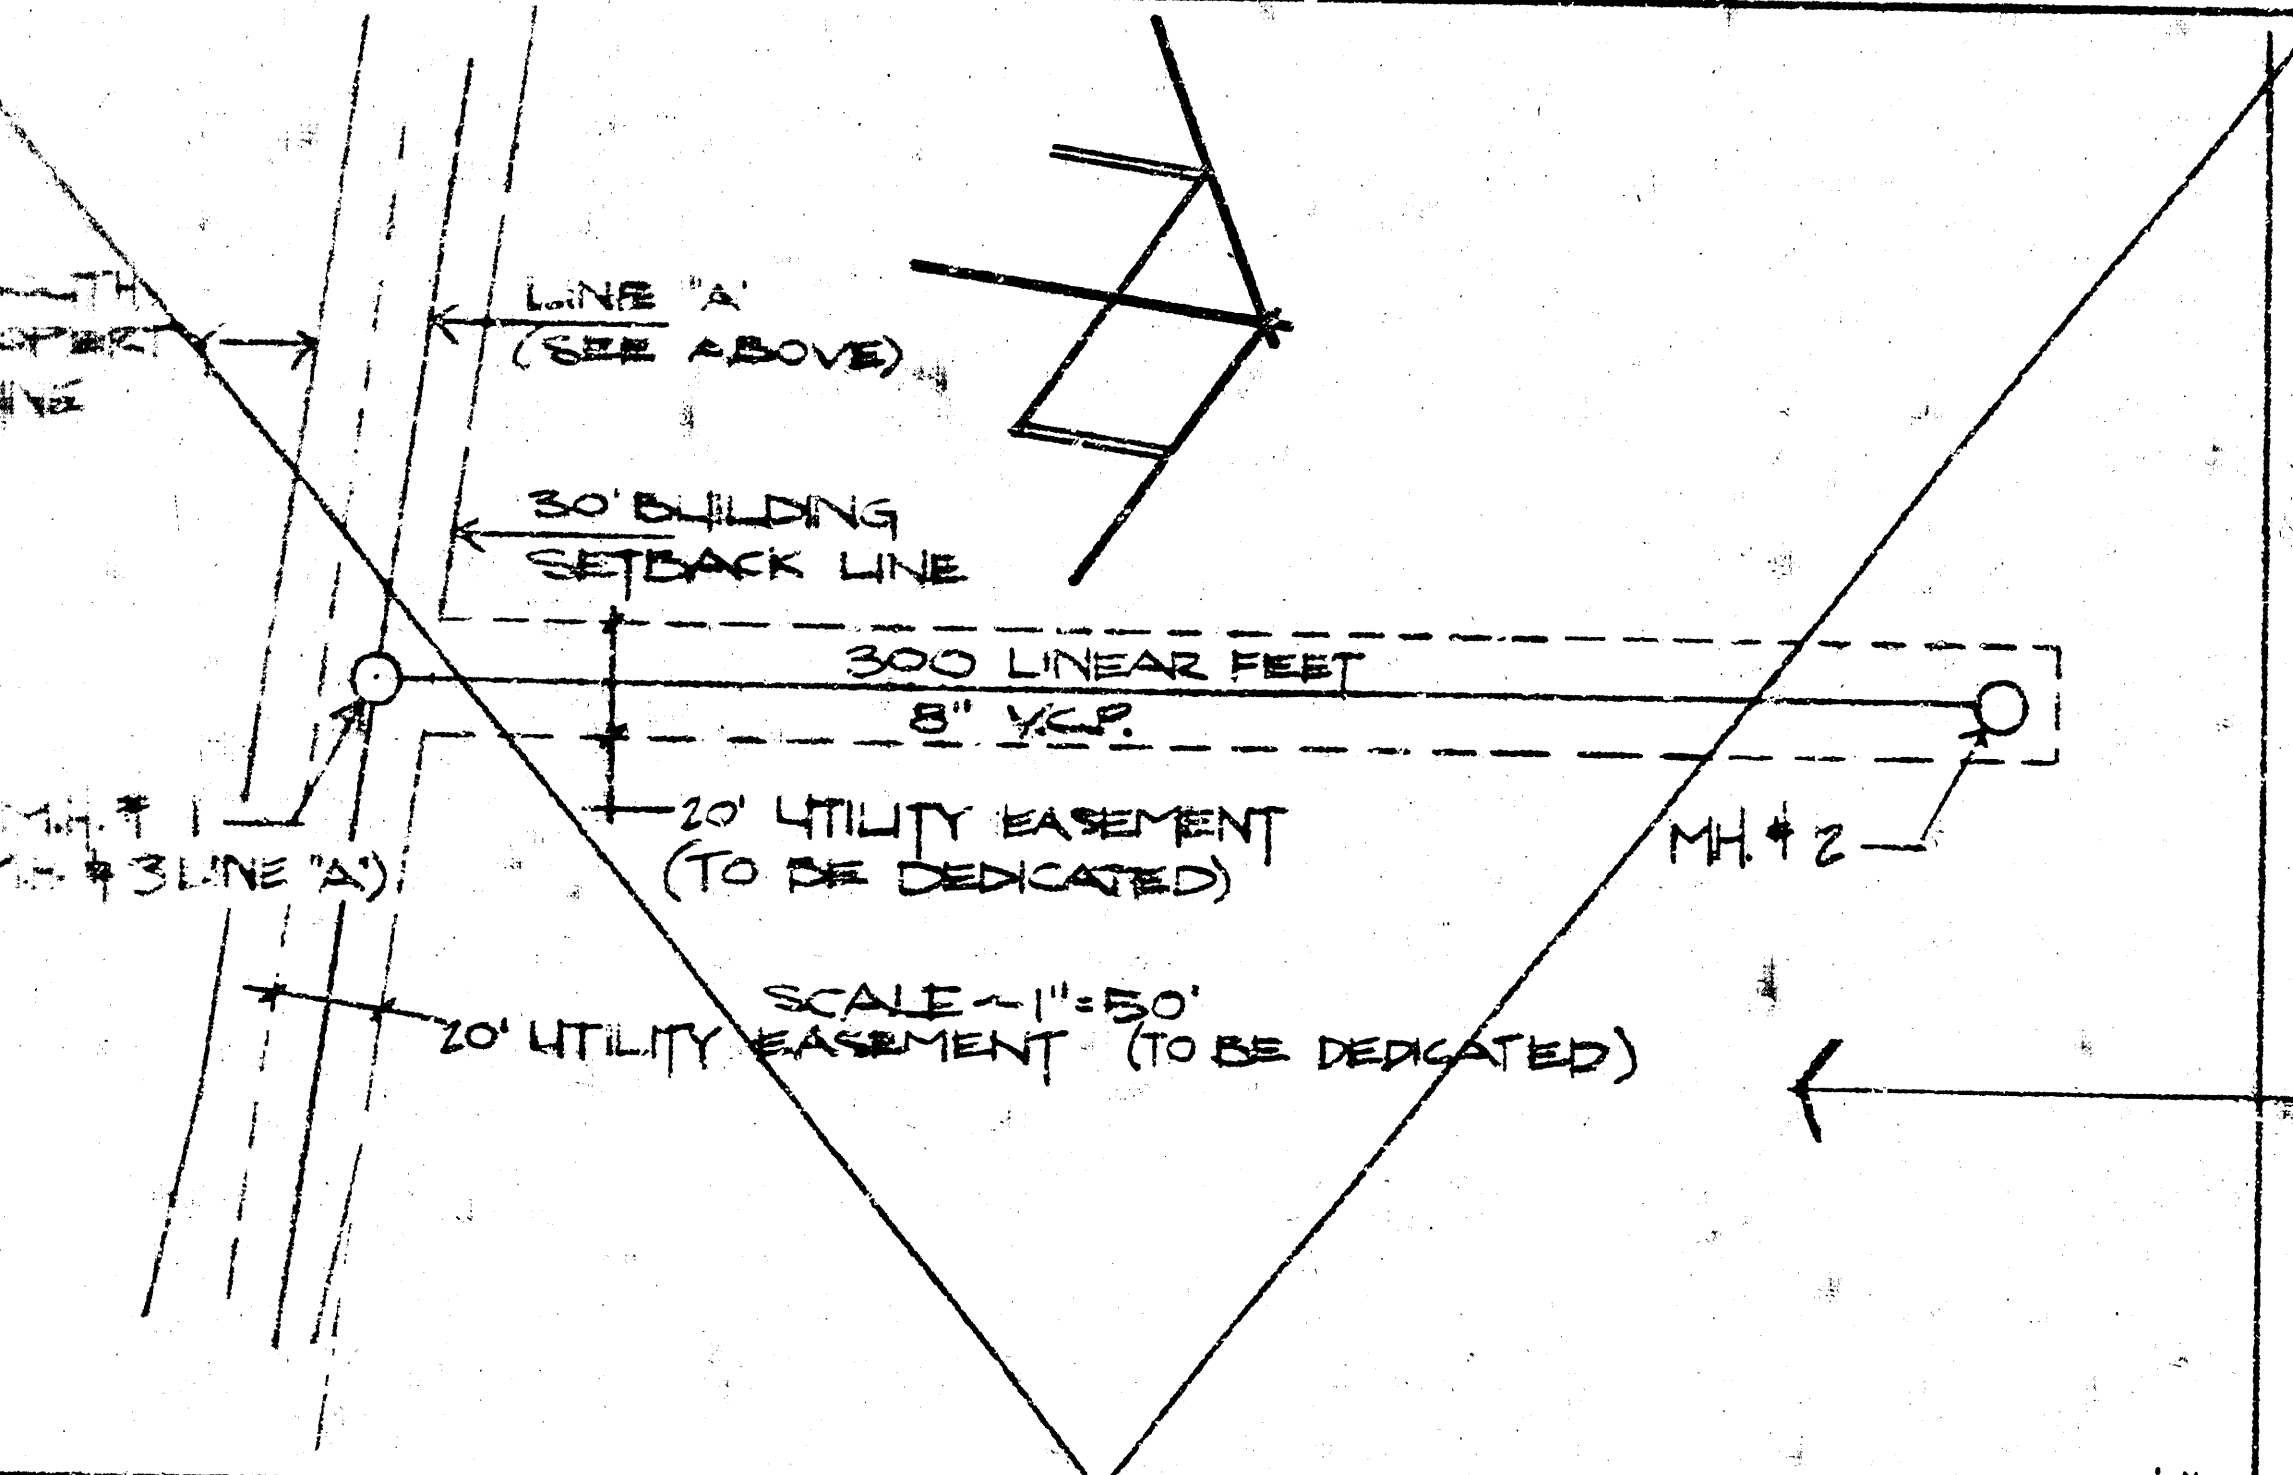
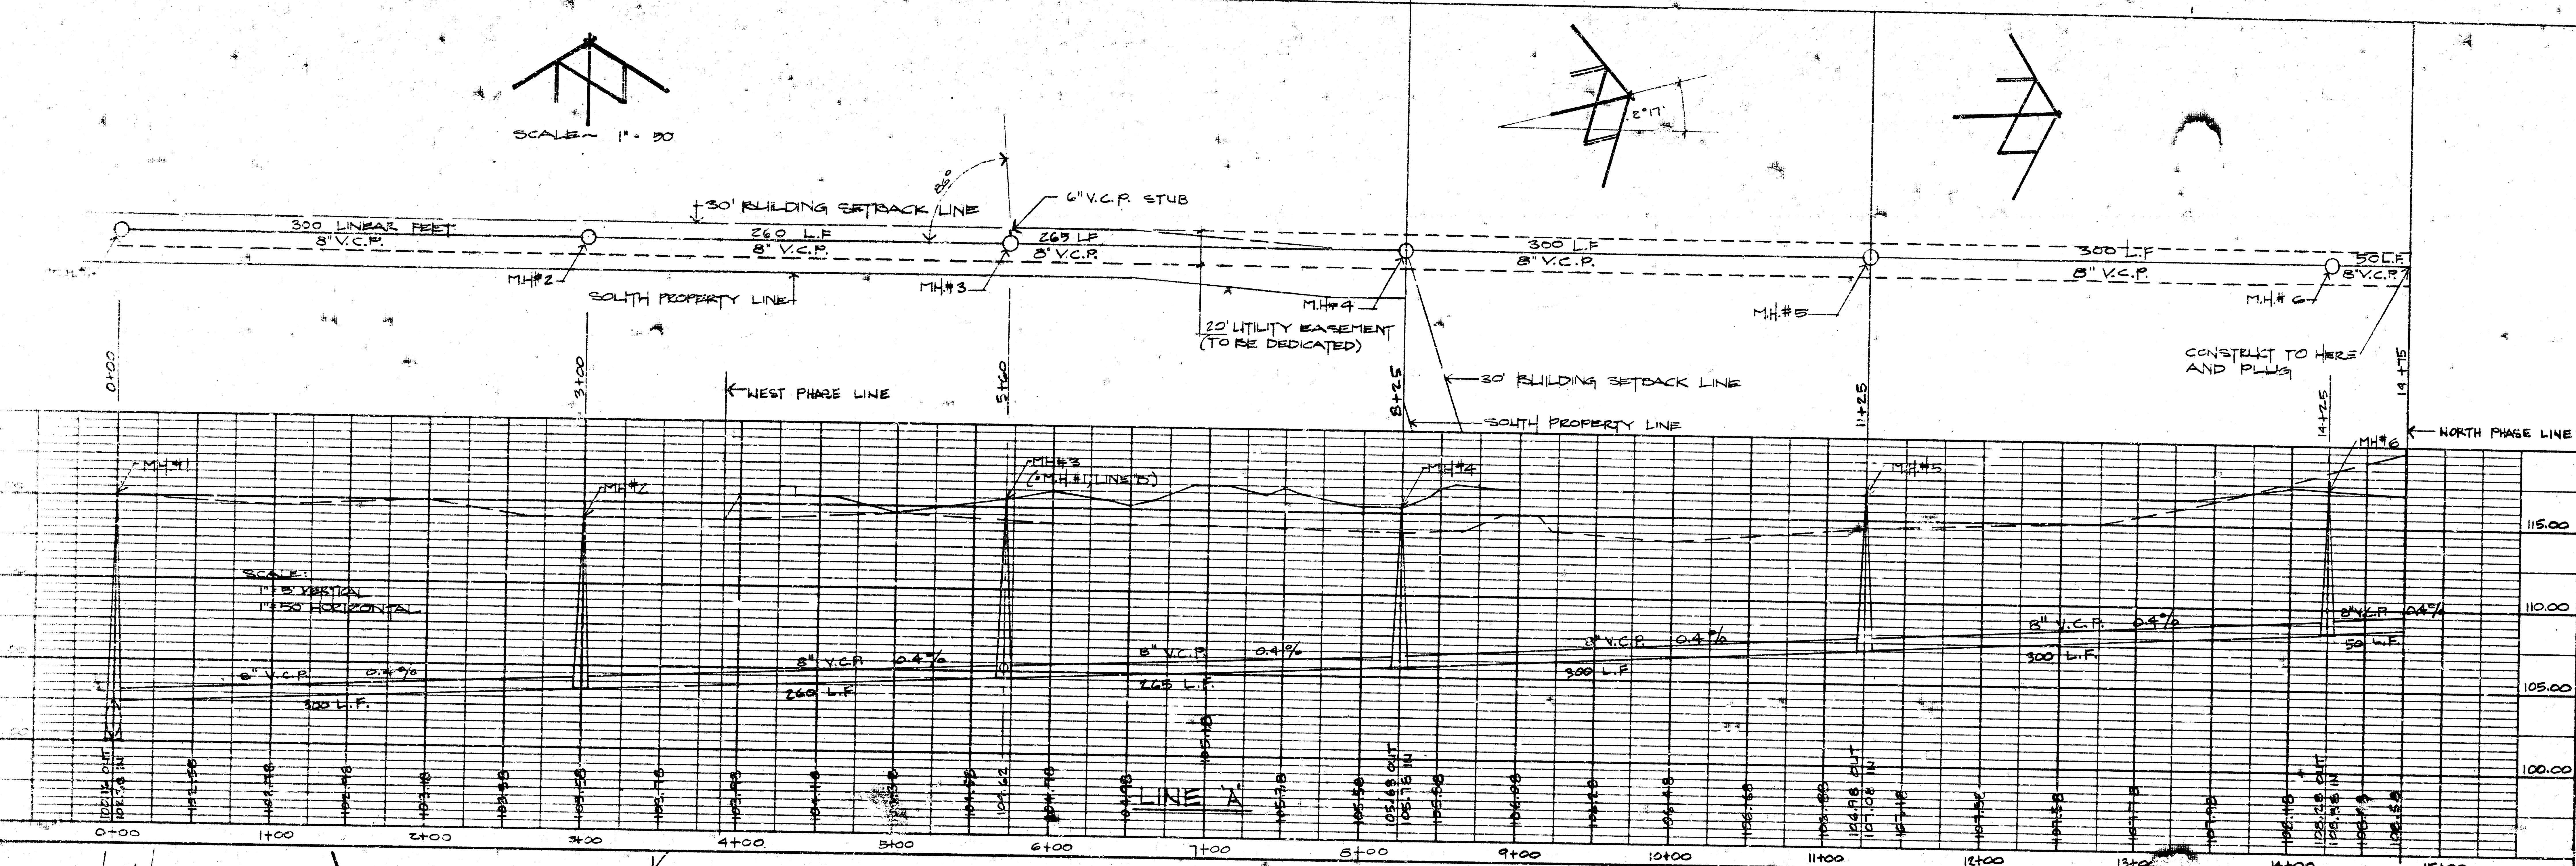


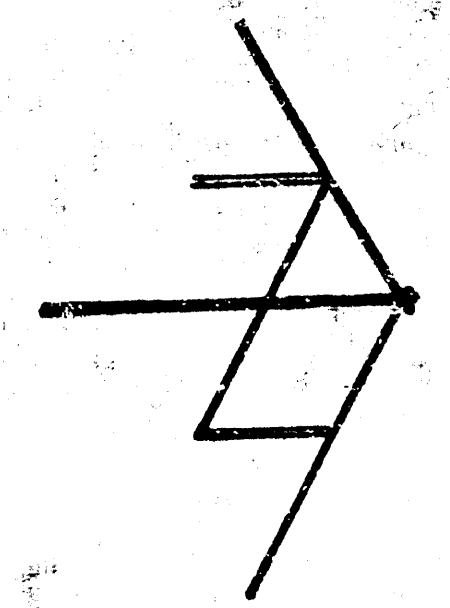


SCALE 1" = 30'

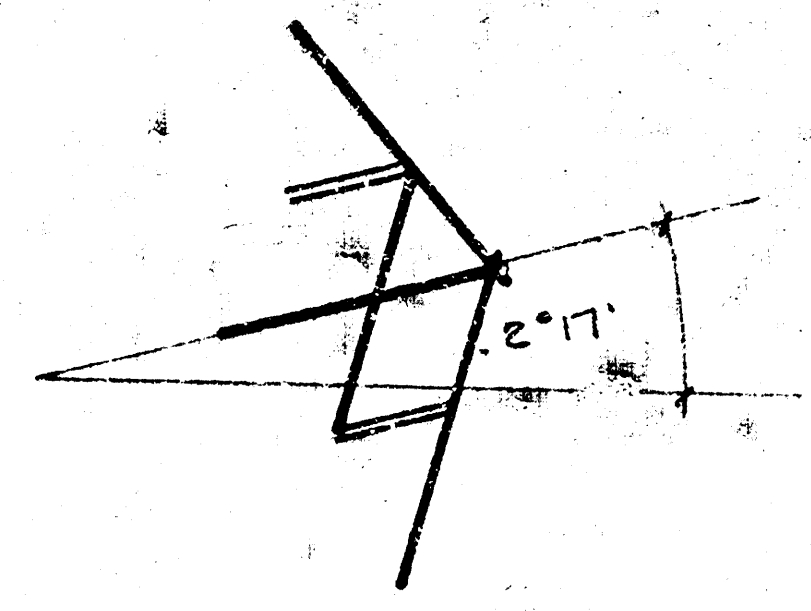

NOTE: ALL SANITARY SEWER TO BE CONSTRUCTED TO CITY OF WICHITA STANDARDS AND SPECIFICATIONS

LINE 'B' DELETED. 3.17.77

REVISED 3.17.77 J.W.H.

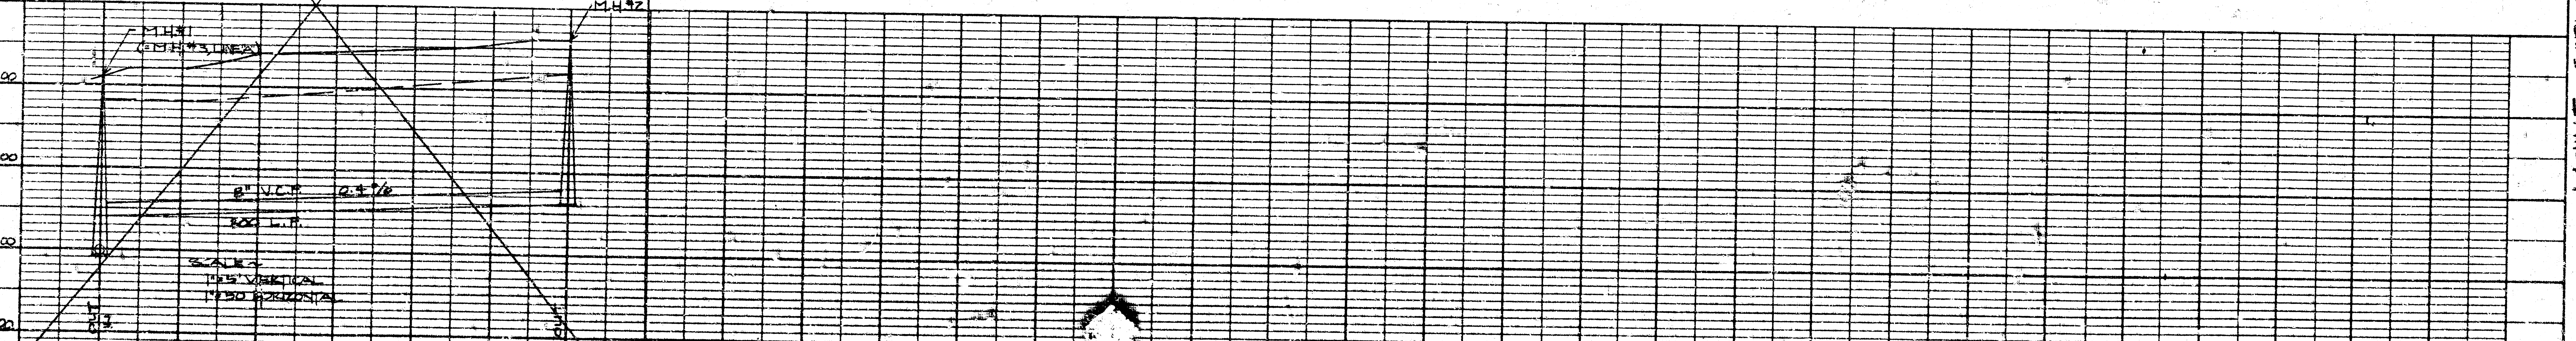

MOUNT CARMEL BUILDINGS