



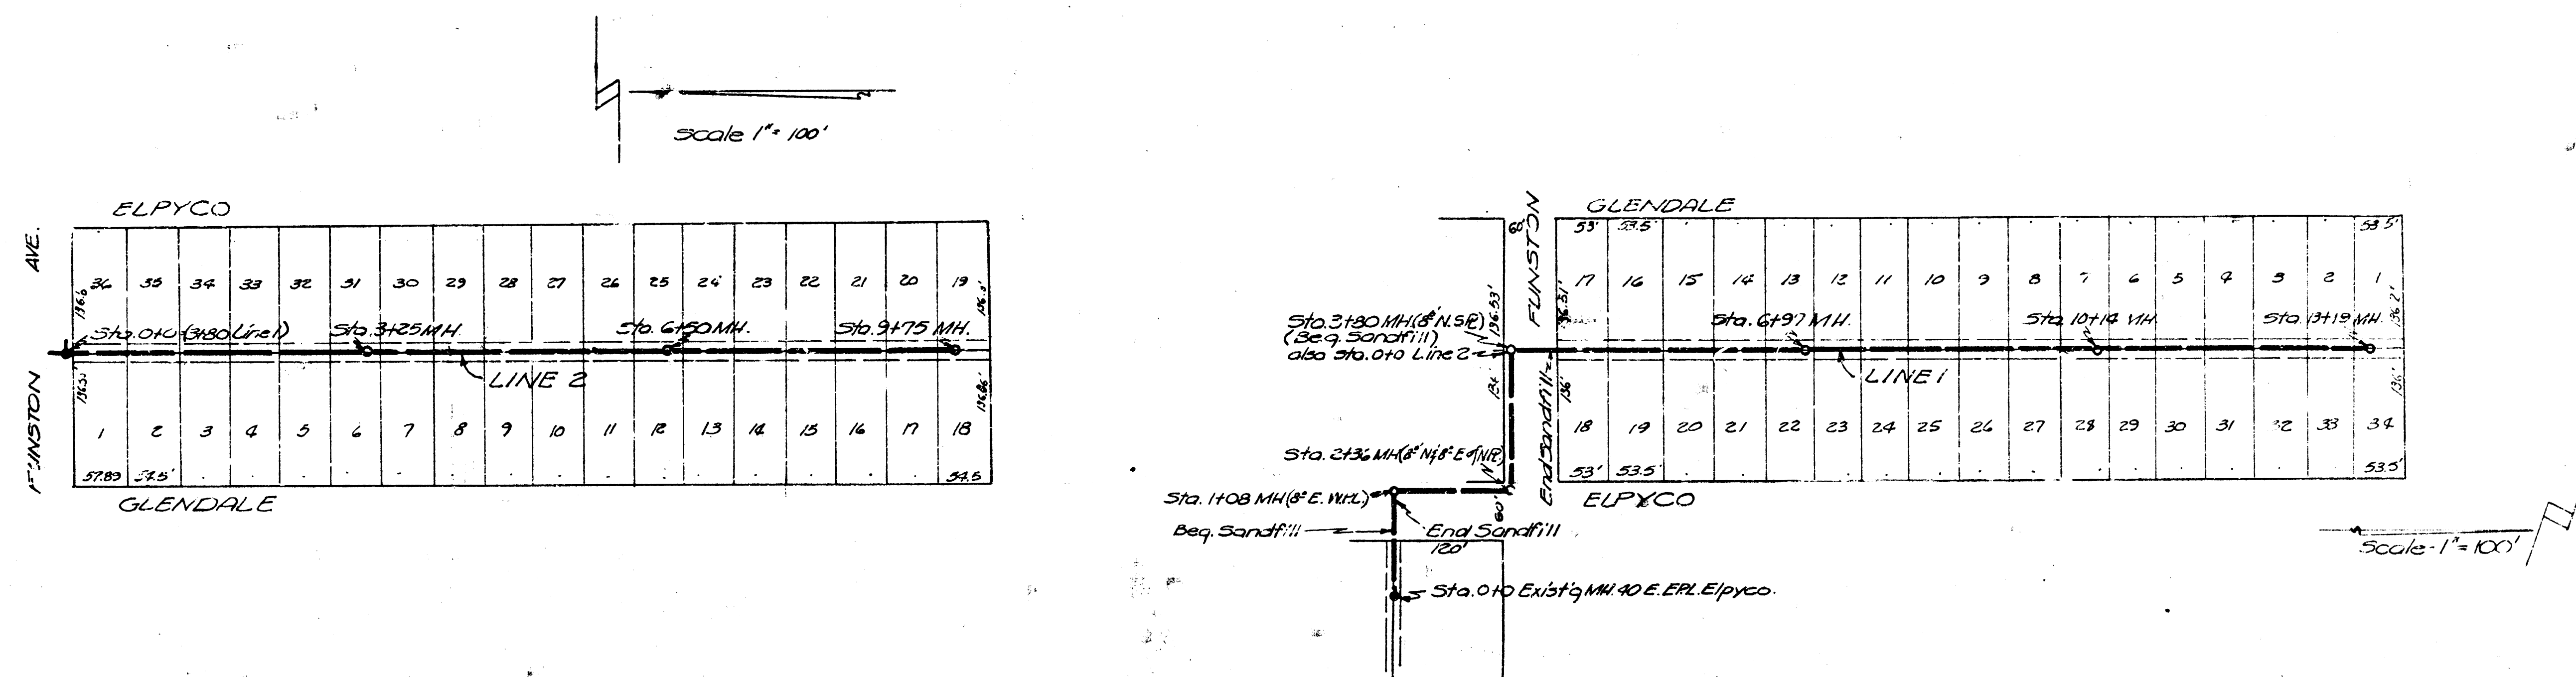

B.M. "M" in Mueller Fire Plug N.E. Cor. Elpyco & Rurston Elev. 130.58

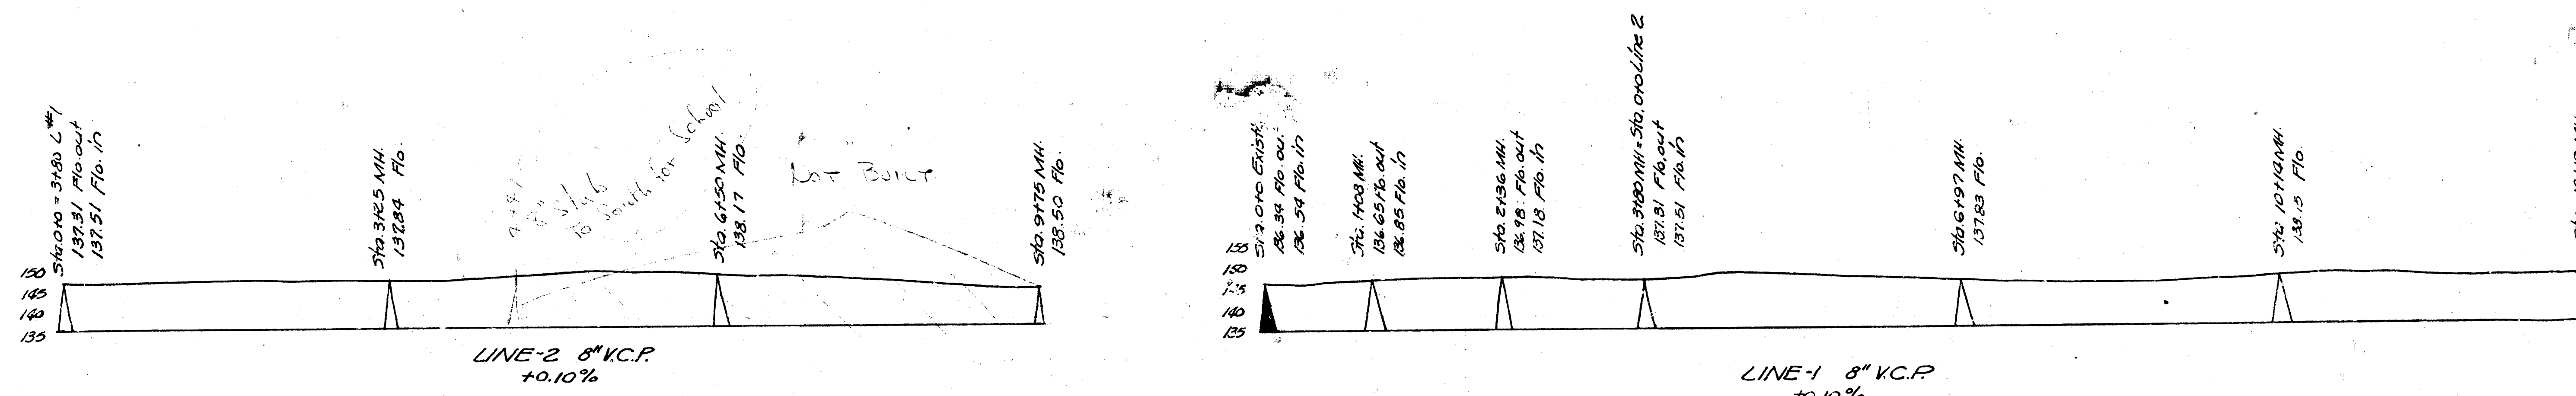

LAT. 6, DIST. 1, WAR INDUSTRIES SEWER
City of Wichita, Kansas
L.K. WHITE City Engineer
Date: 10-6-50 Proj. No. C20-35