

REPLAT OF RESERVE "A",


GREENDALE ADDITION.

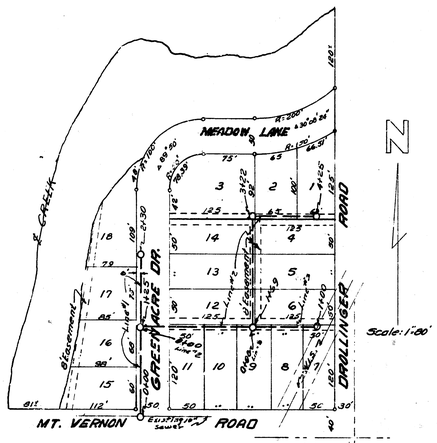


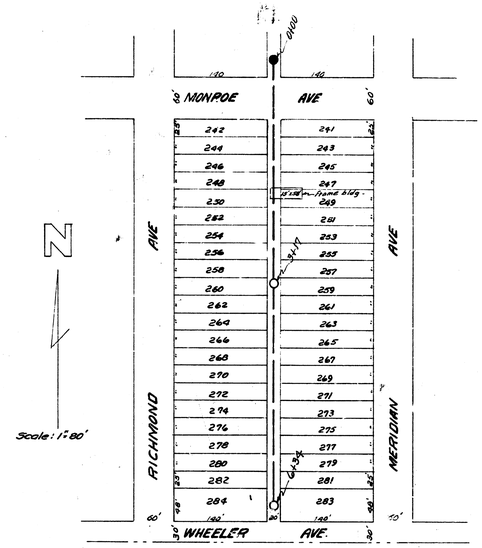


2-6-53 McClain 59-Y

Date Drawn by Checked by Book No.

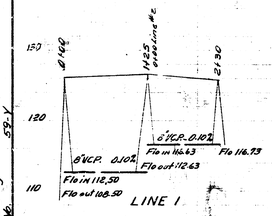

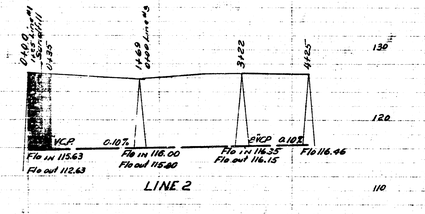

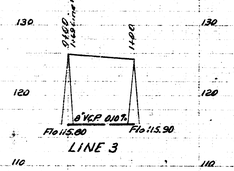


1-31-53 McClain 6-Y

Date Drawn by Checked by Book No.

BM. 106.81 "+" on sw. Cor. conc. sq. box C.B. NW. cor. Meridian & Wheeler
BM. 108.43 . Sq. rim NW. 0100.

Note: Hand excavate through building shown - Dirt floor with South side opening 3' high across length of bldg.

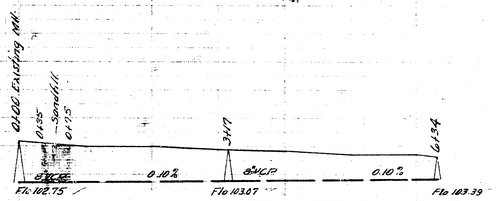

LAT. 9 SUB. 2 W.I.S.
CITY OF WICHITA KANSAS
B.E. SMITH CITY ENGINEER
Proj. No. C-23-4

LAT. 9 SUB. B 33, 21
CITY OF WICHITA KANSAS
B.E. SMITH CITY ENGINEER
Proj. No. C-23-3