
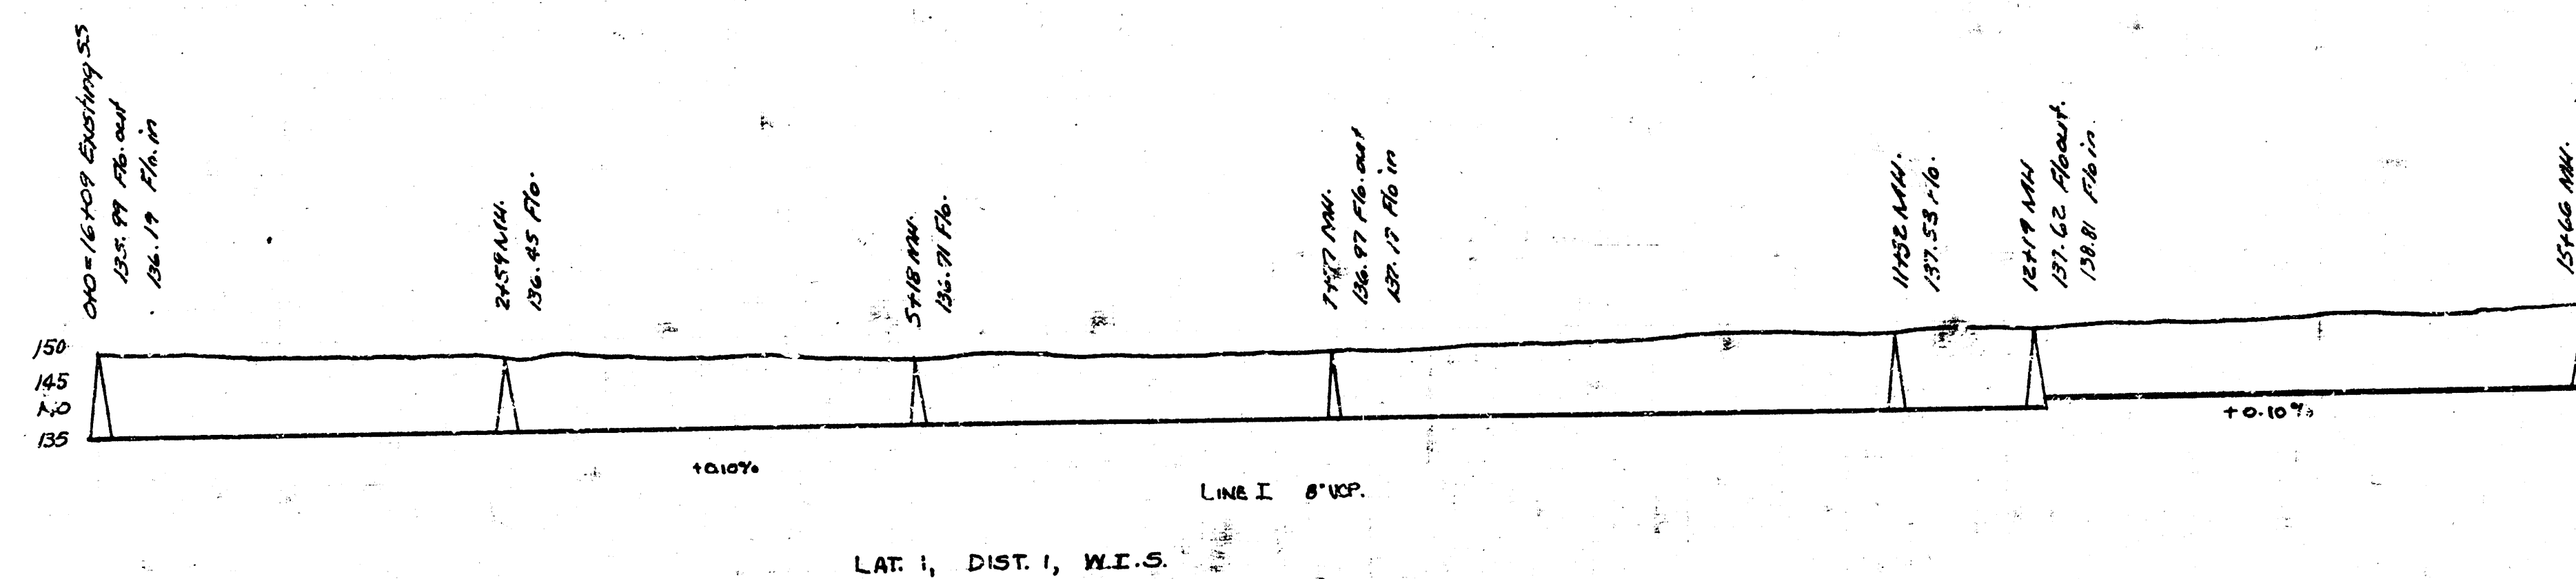
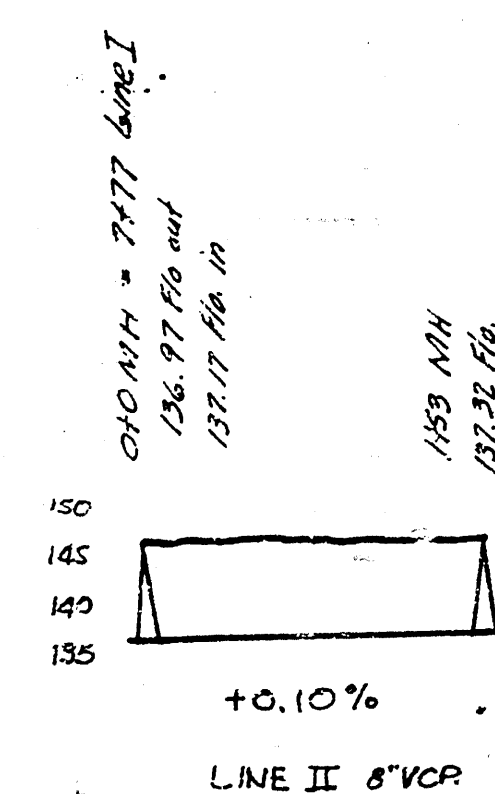
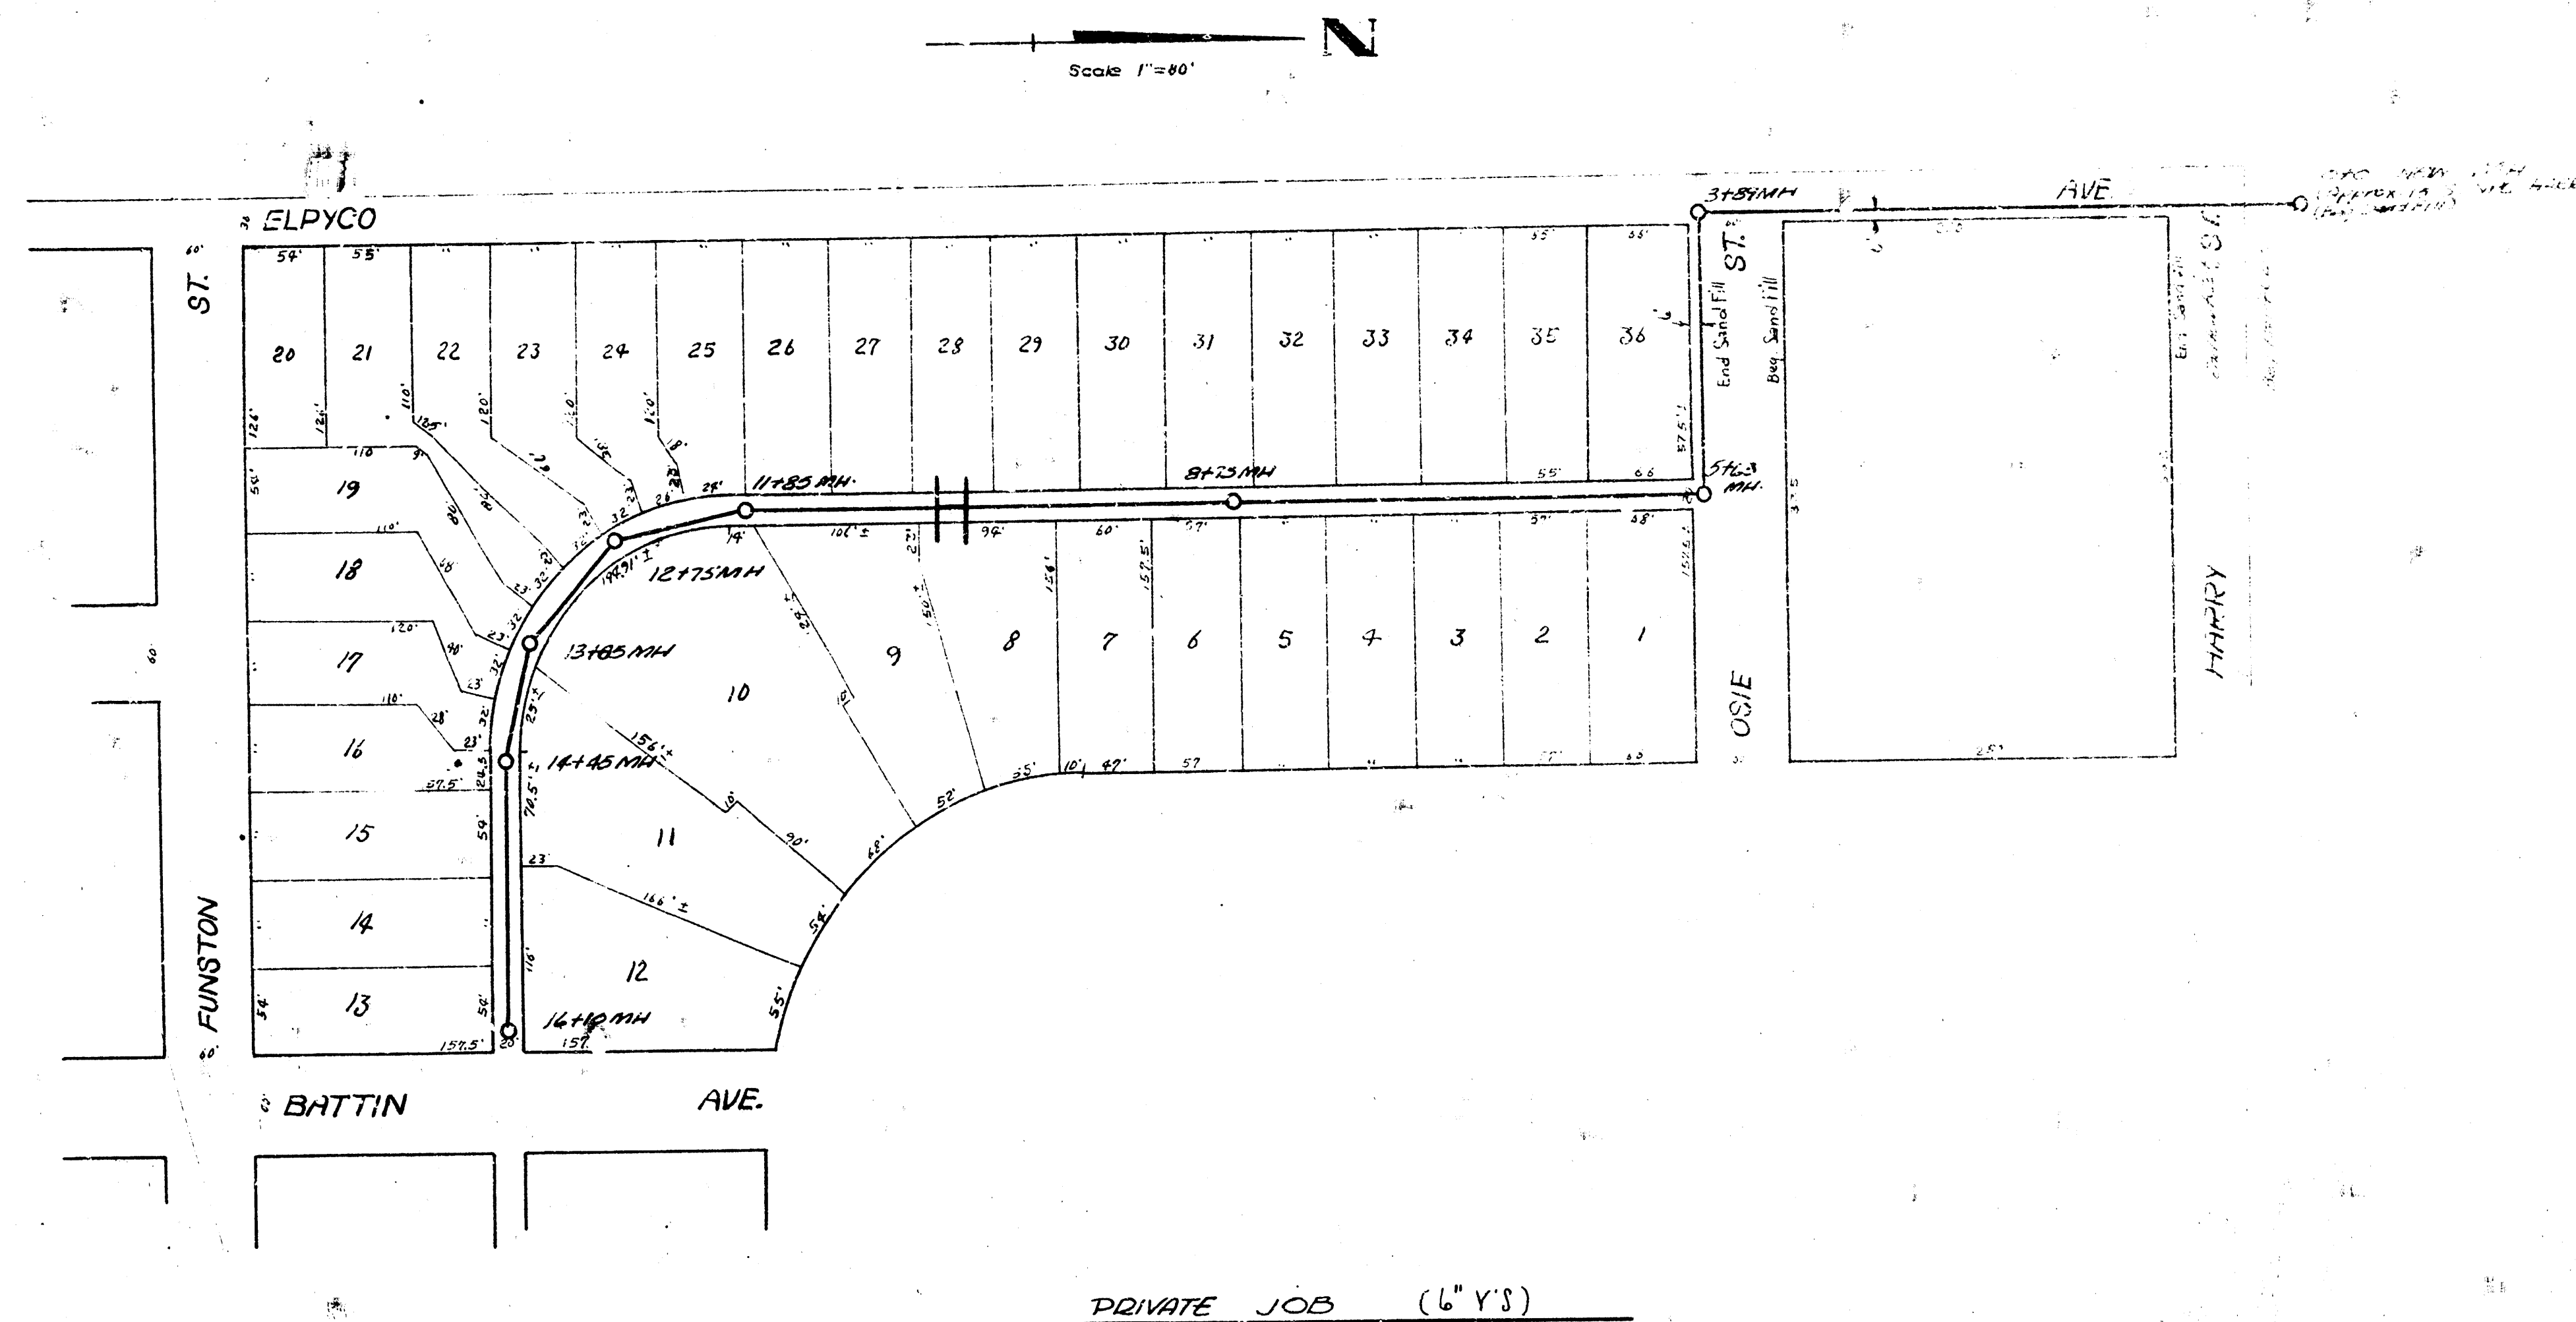


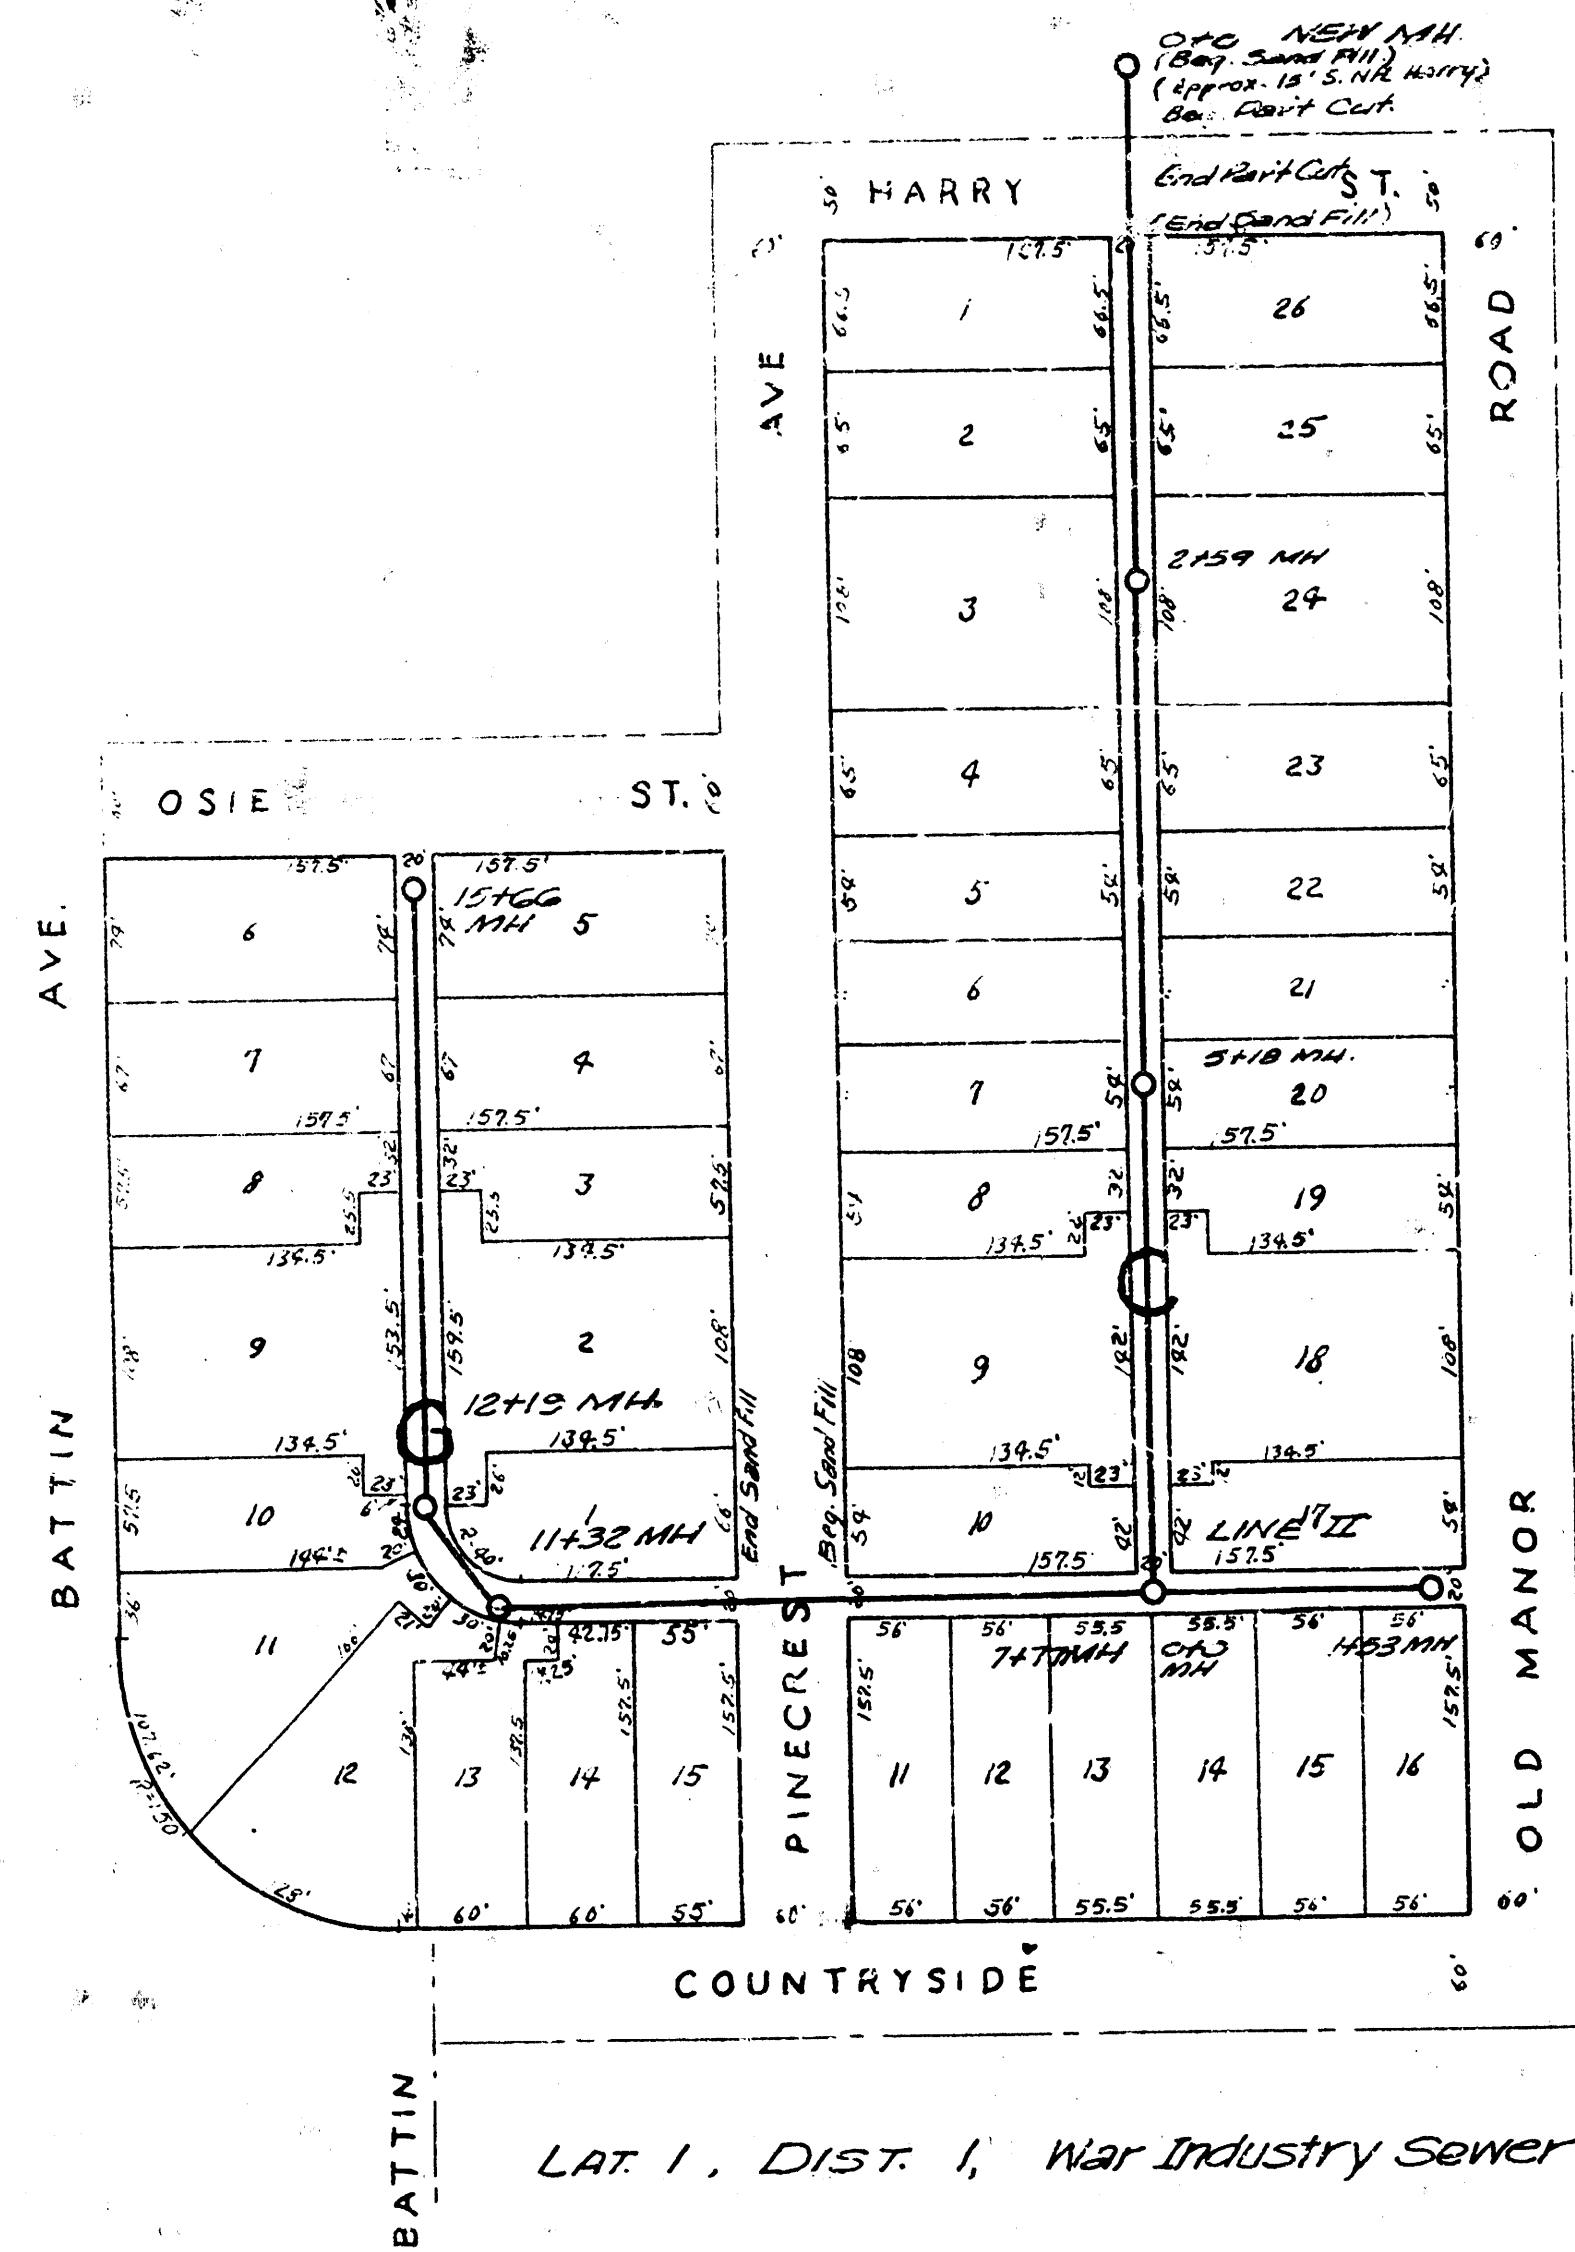

PRIVATE JOB - RES. H.
LAT. 1, DIST. 1, WAR INDUSTRY SEWER.
CITY OF WICHITA - KANSAS
L. K. WHITE - CITY ENGINEER
Date: 9-20-45 PROJ. NO. - C27-34