

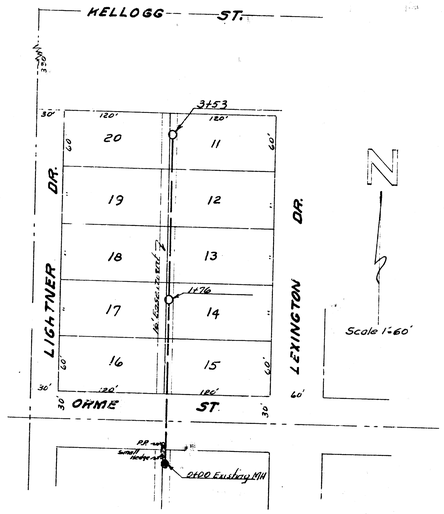


B.M. 167.26 "M" in Nueller F.P. NW Cor. Lightner & Orme.

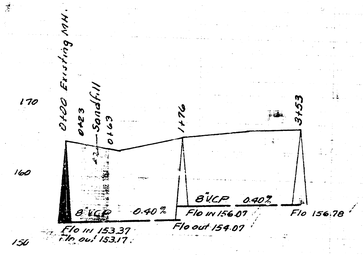


Date
Drawn by
Checked by
Book No
1-2-53
McClain
69-Y

LAT. 11 SUB. 3 WIS.
CITY OF WICHITA KANSAS
L.K. WHITE CITY ENGINEER
Proj. No. C-22-93

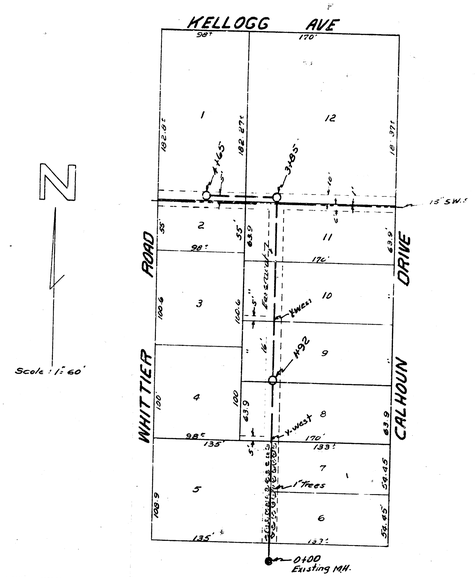

B.M. 158.20 R.R. Spike W.S. Bell Tel. Pole 100' North of NL of Eastridge 61ft. E.S. Whittier Rd.

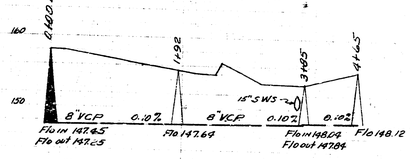

Date
Drawn by
Checked by
Book No
1-2-53
McClain
69-Y

LAT. 3 SUB. 5 WIS
CITY OF WICHITA KANSAS
L.K. WHITE CITY ENGINEER
Proj. No. C-22-55