

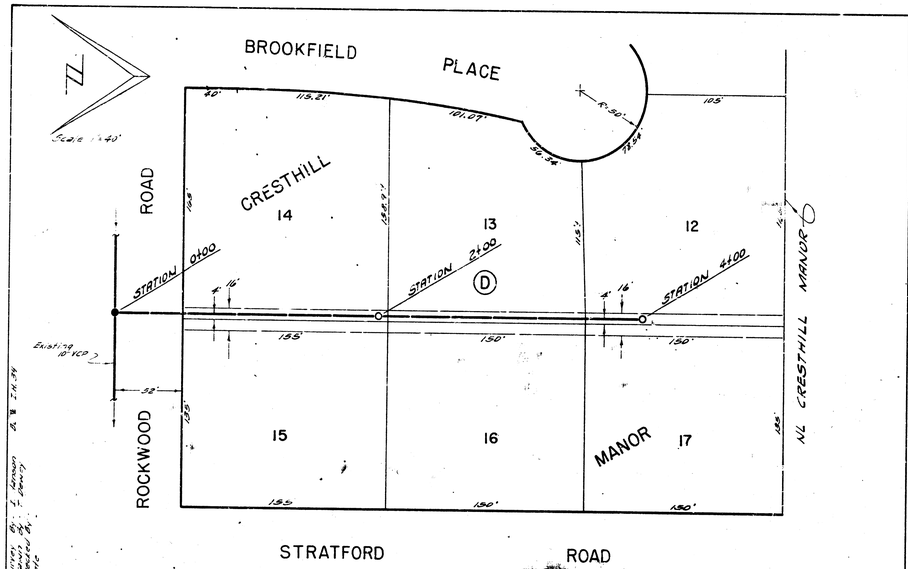


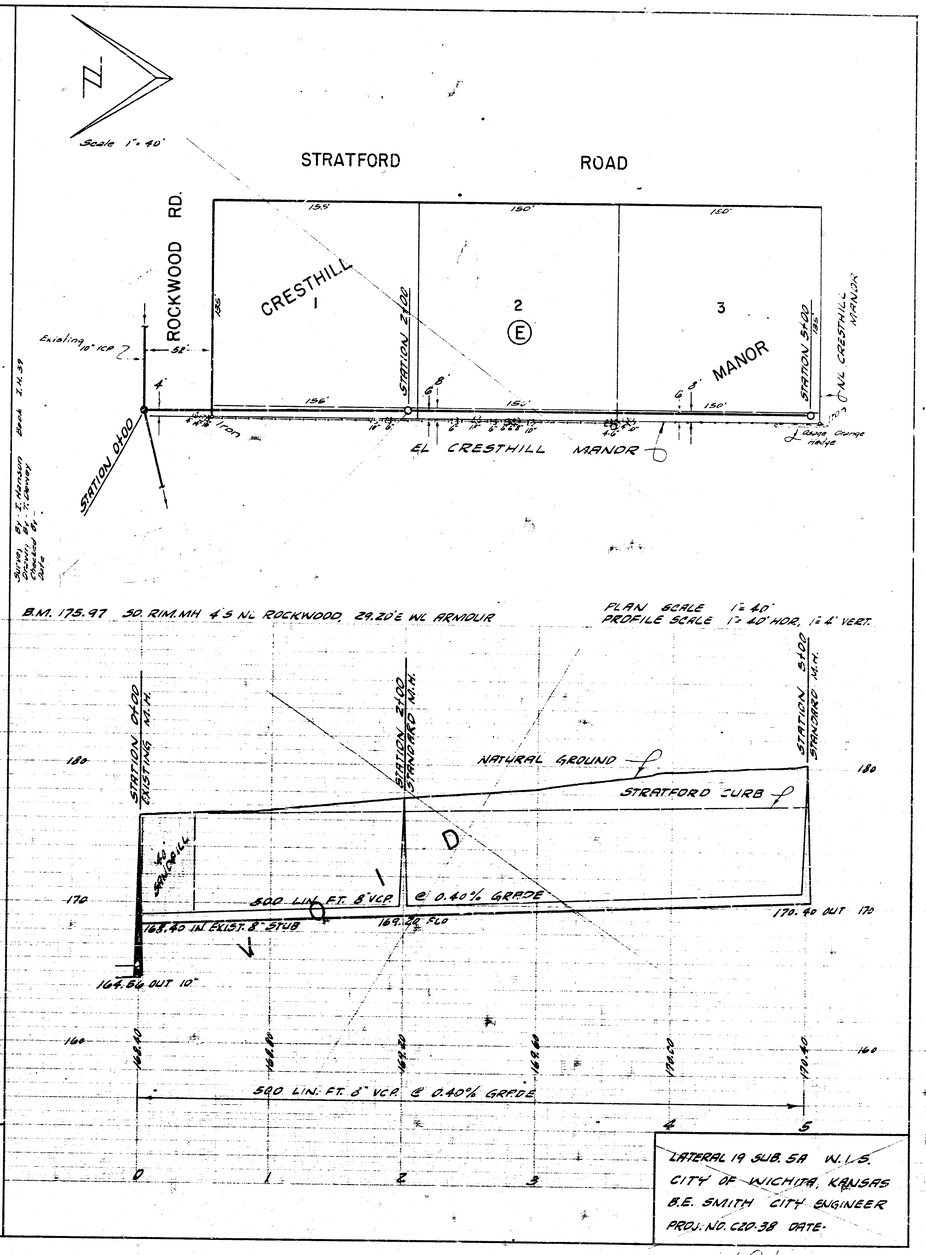

B.M. 175.97 SQ. RIM. M.H. 4'S NL ROCKWOOD, 29.20' E WL ARMOUR

PLAN SCALE 1"=40'
PROFILE SCALE 1"=40' HOR, 1"=4' VERTICAL

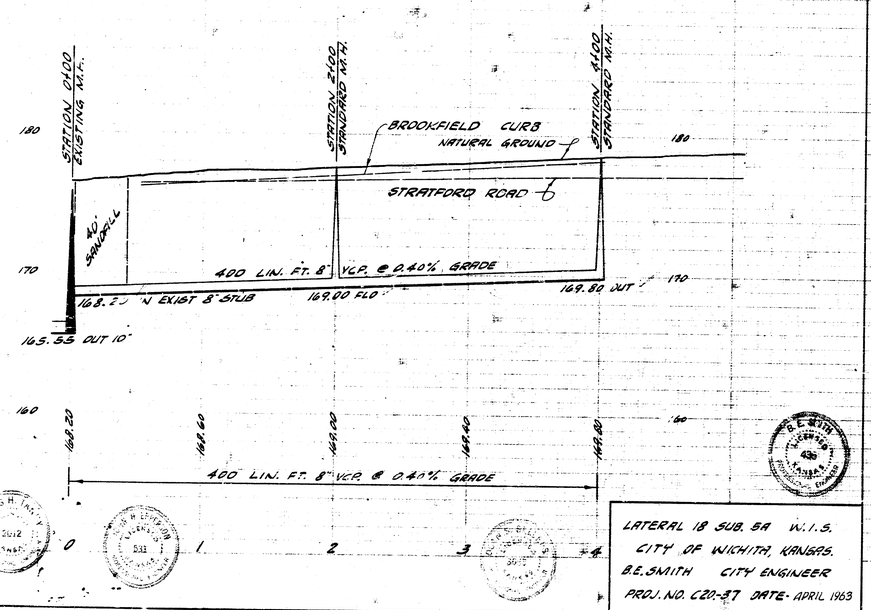

LATERAL 18 SUB. SA W.I.S.
CITY OF WICHITA, KANSAS.
B.E. SMITH CITY ENGINEER
PROJ. NO. C20-37 DATE- APRIL 1963

B.M. 175.97 SQ. RIM. MH 4'S NL ROCKWOOD, 29.20'E WL ARMOUR

PLAN SCALE 1"=40'
PROFILE SCALE 1"=40' HOR, 1"=4' VERT.

LATERAL 19 SUB. SA W.I.S.
CITY OF WICHITA, KANSAS
B.E. SMITH CITY ENGINEER
PROJ. NO. C20-38 DATE-