

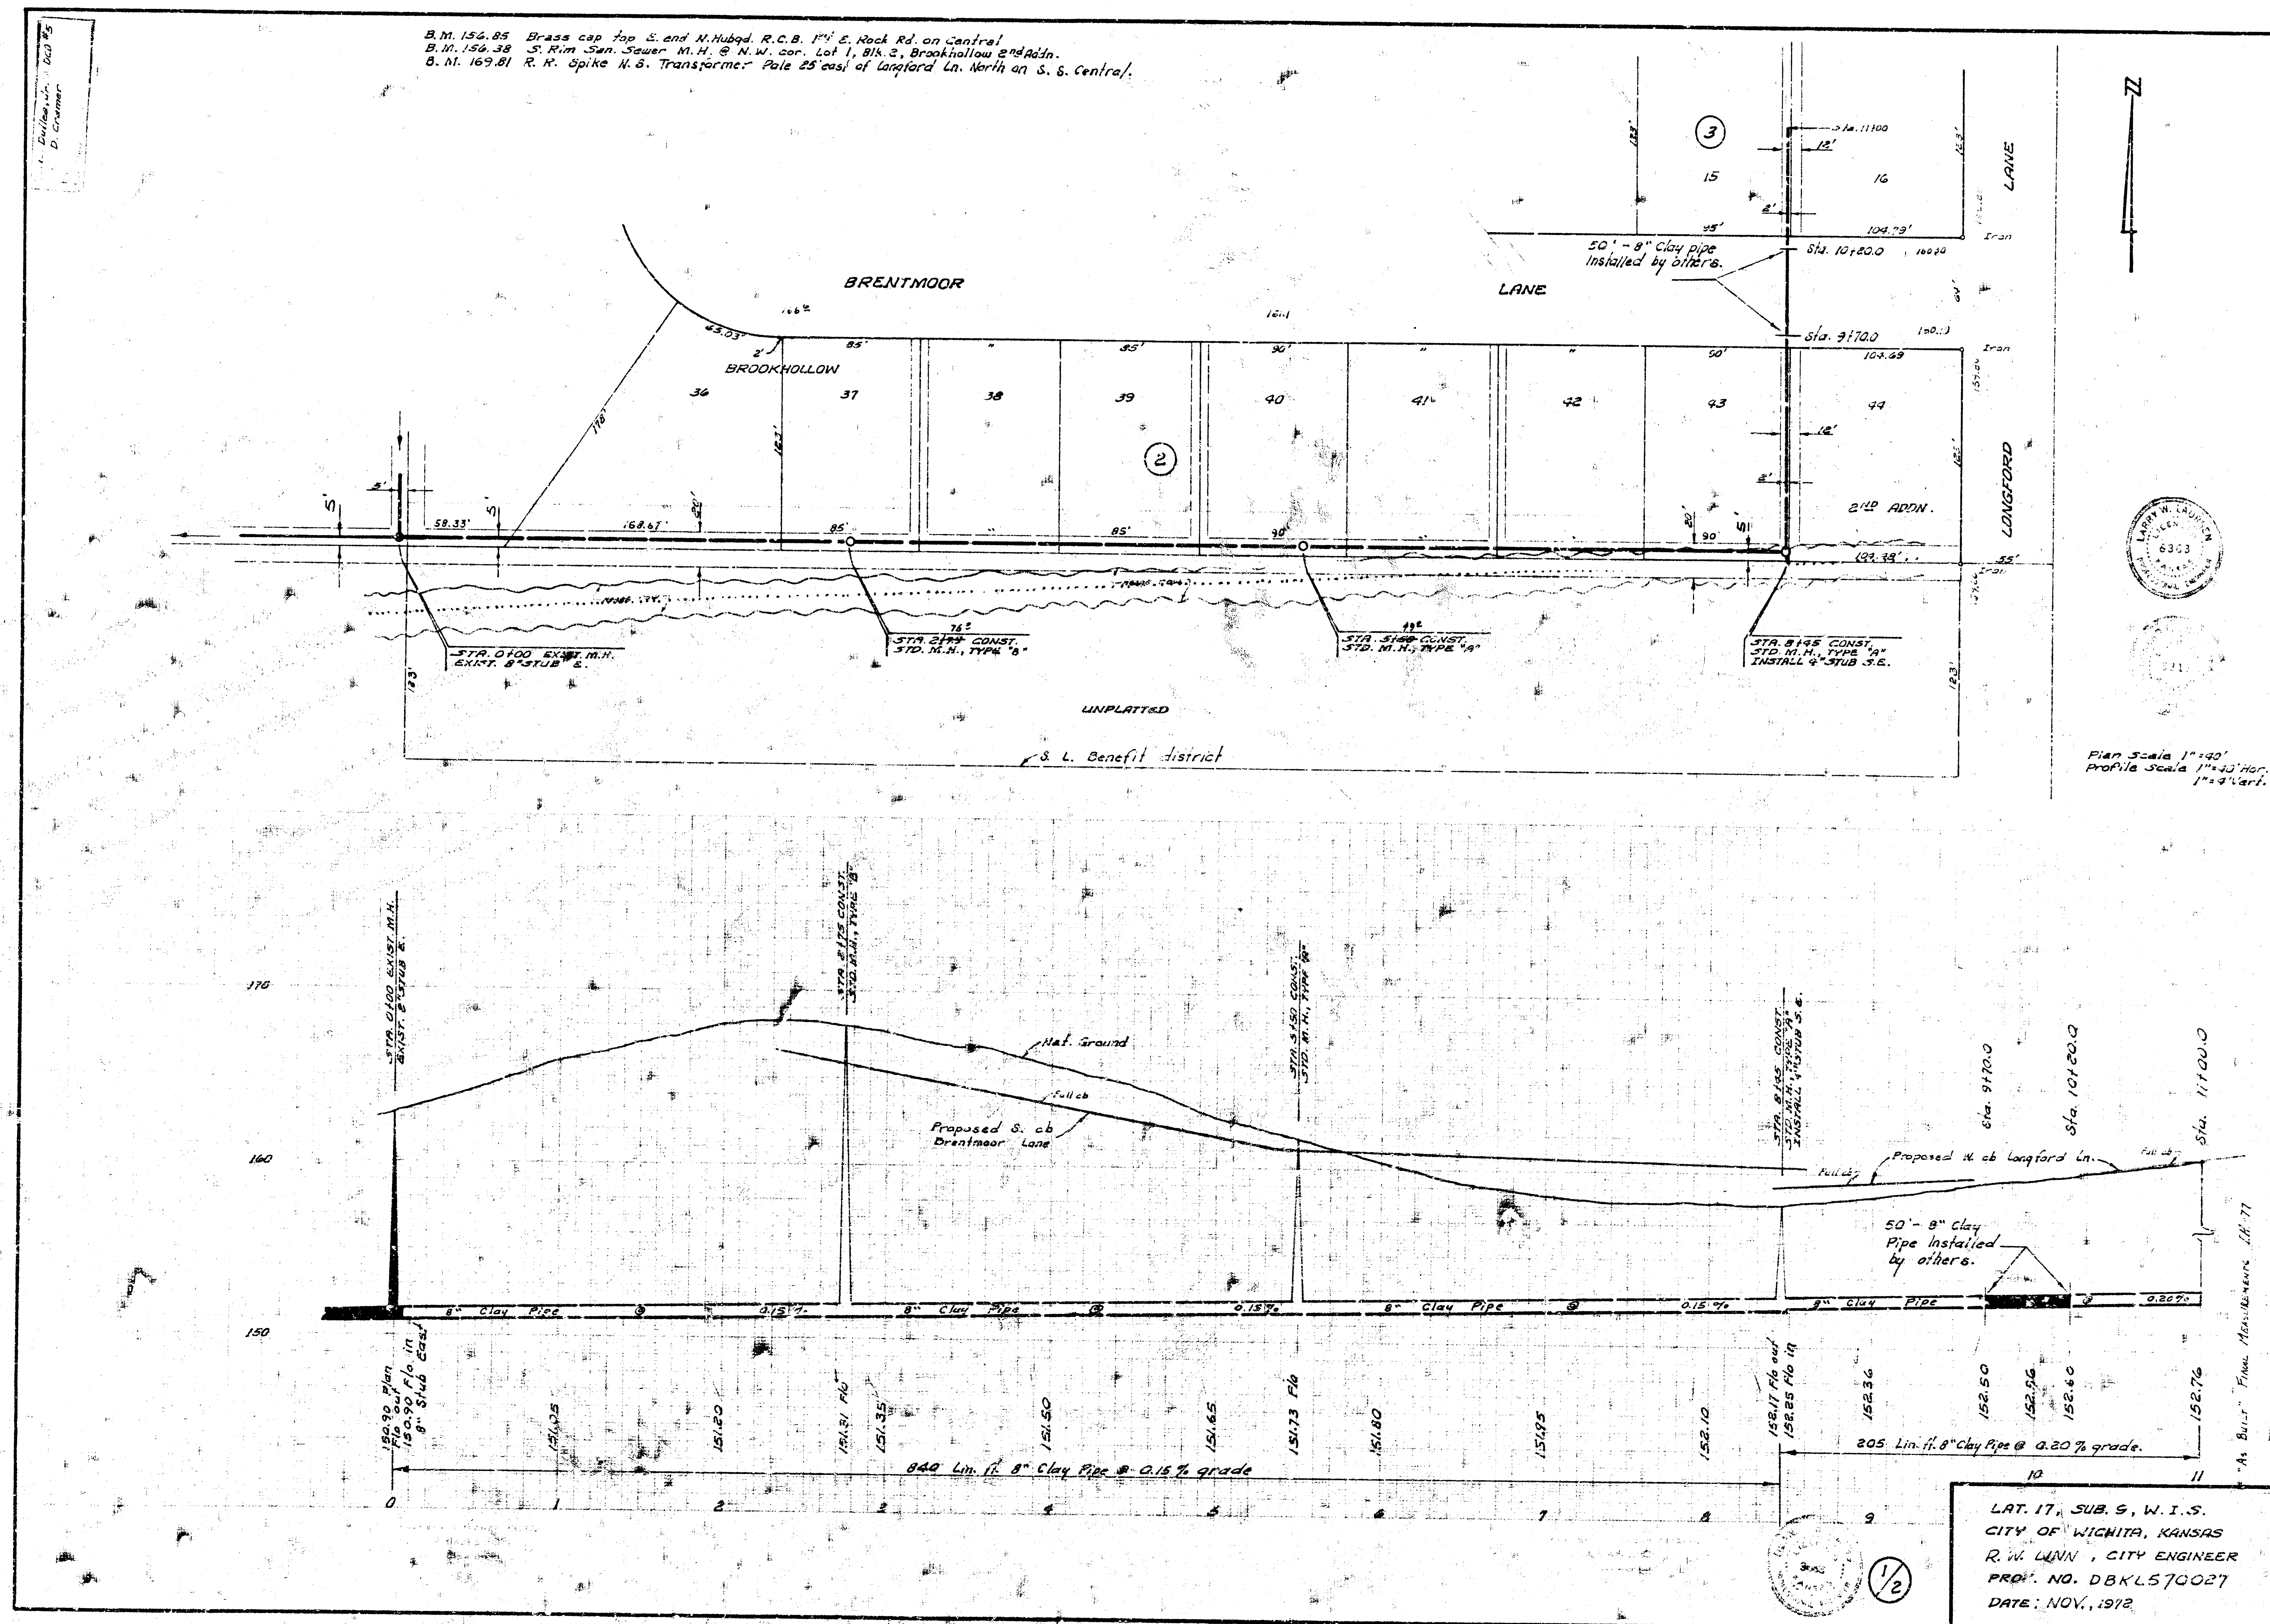


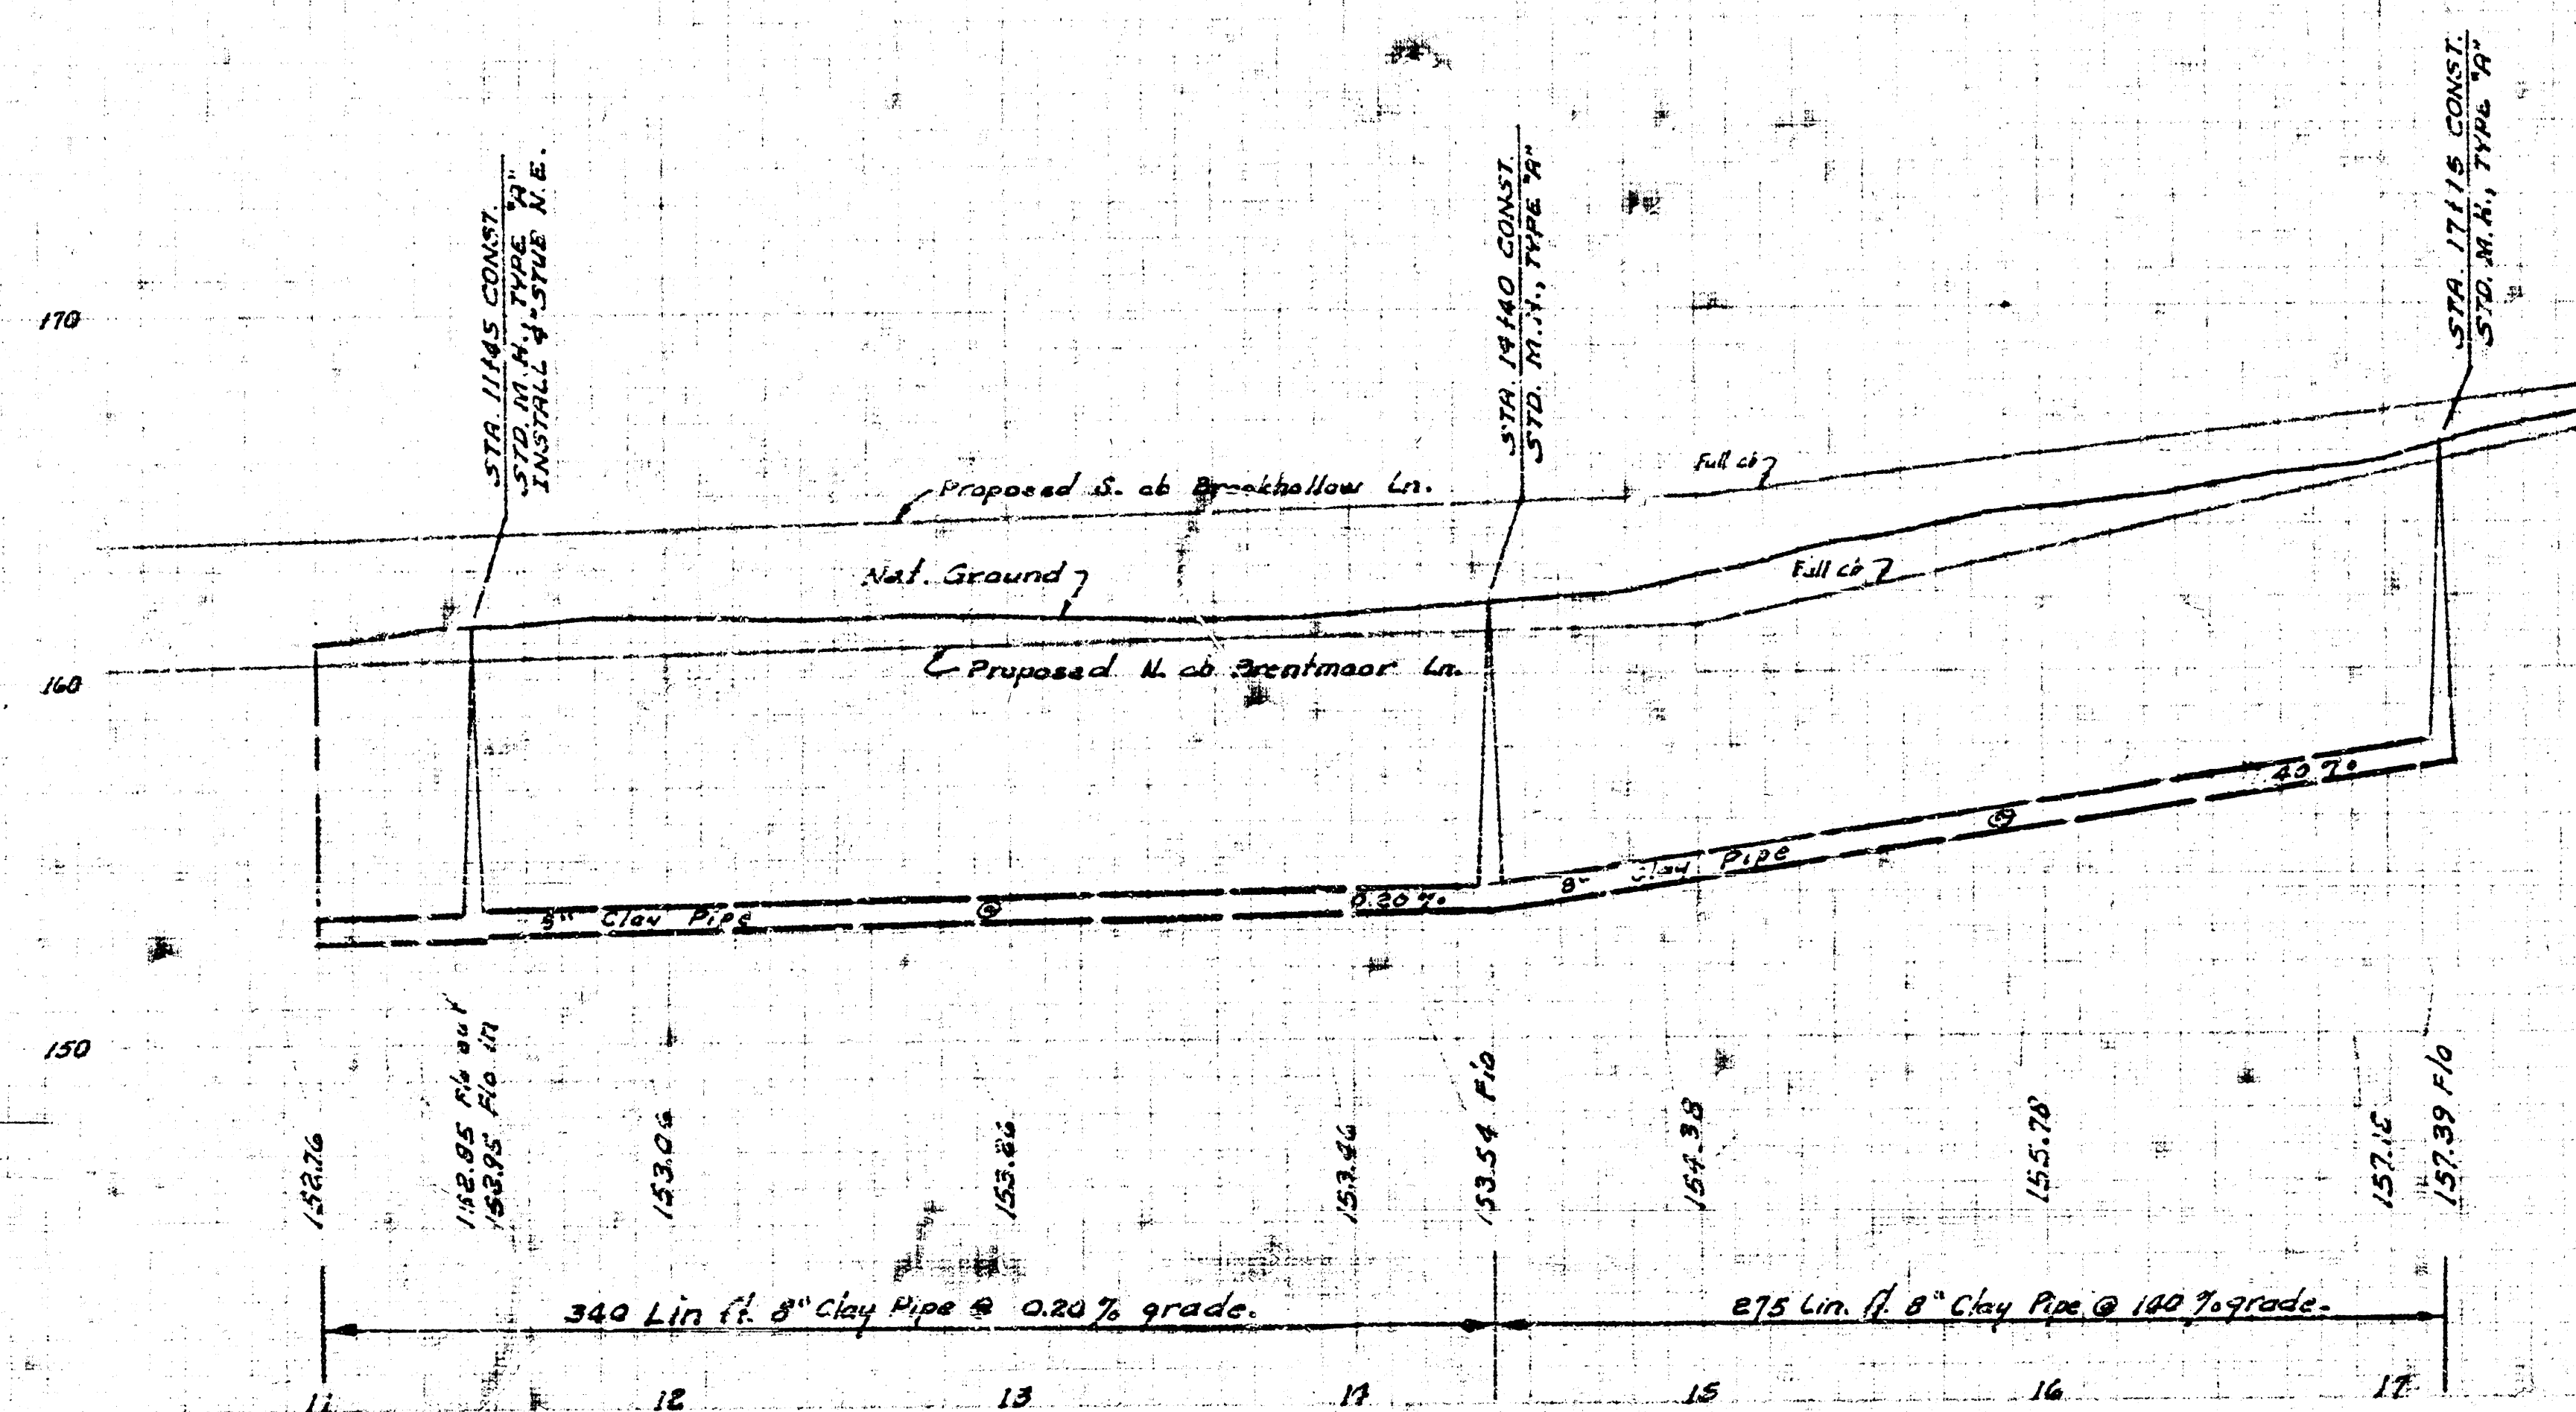

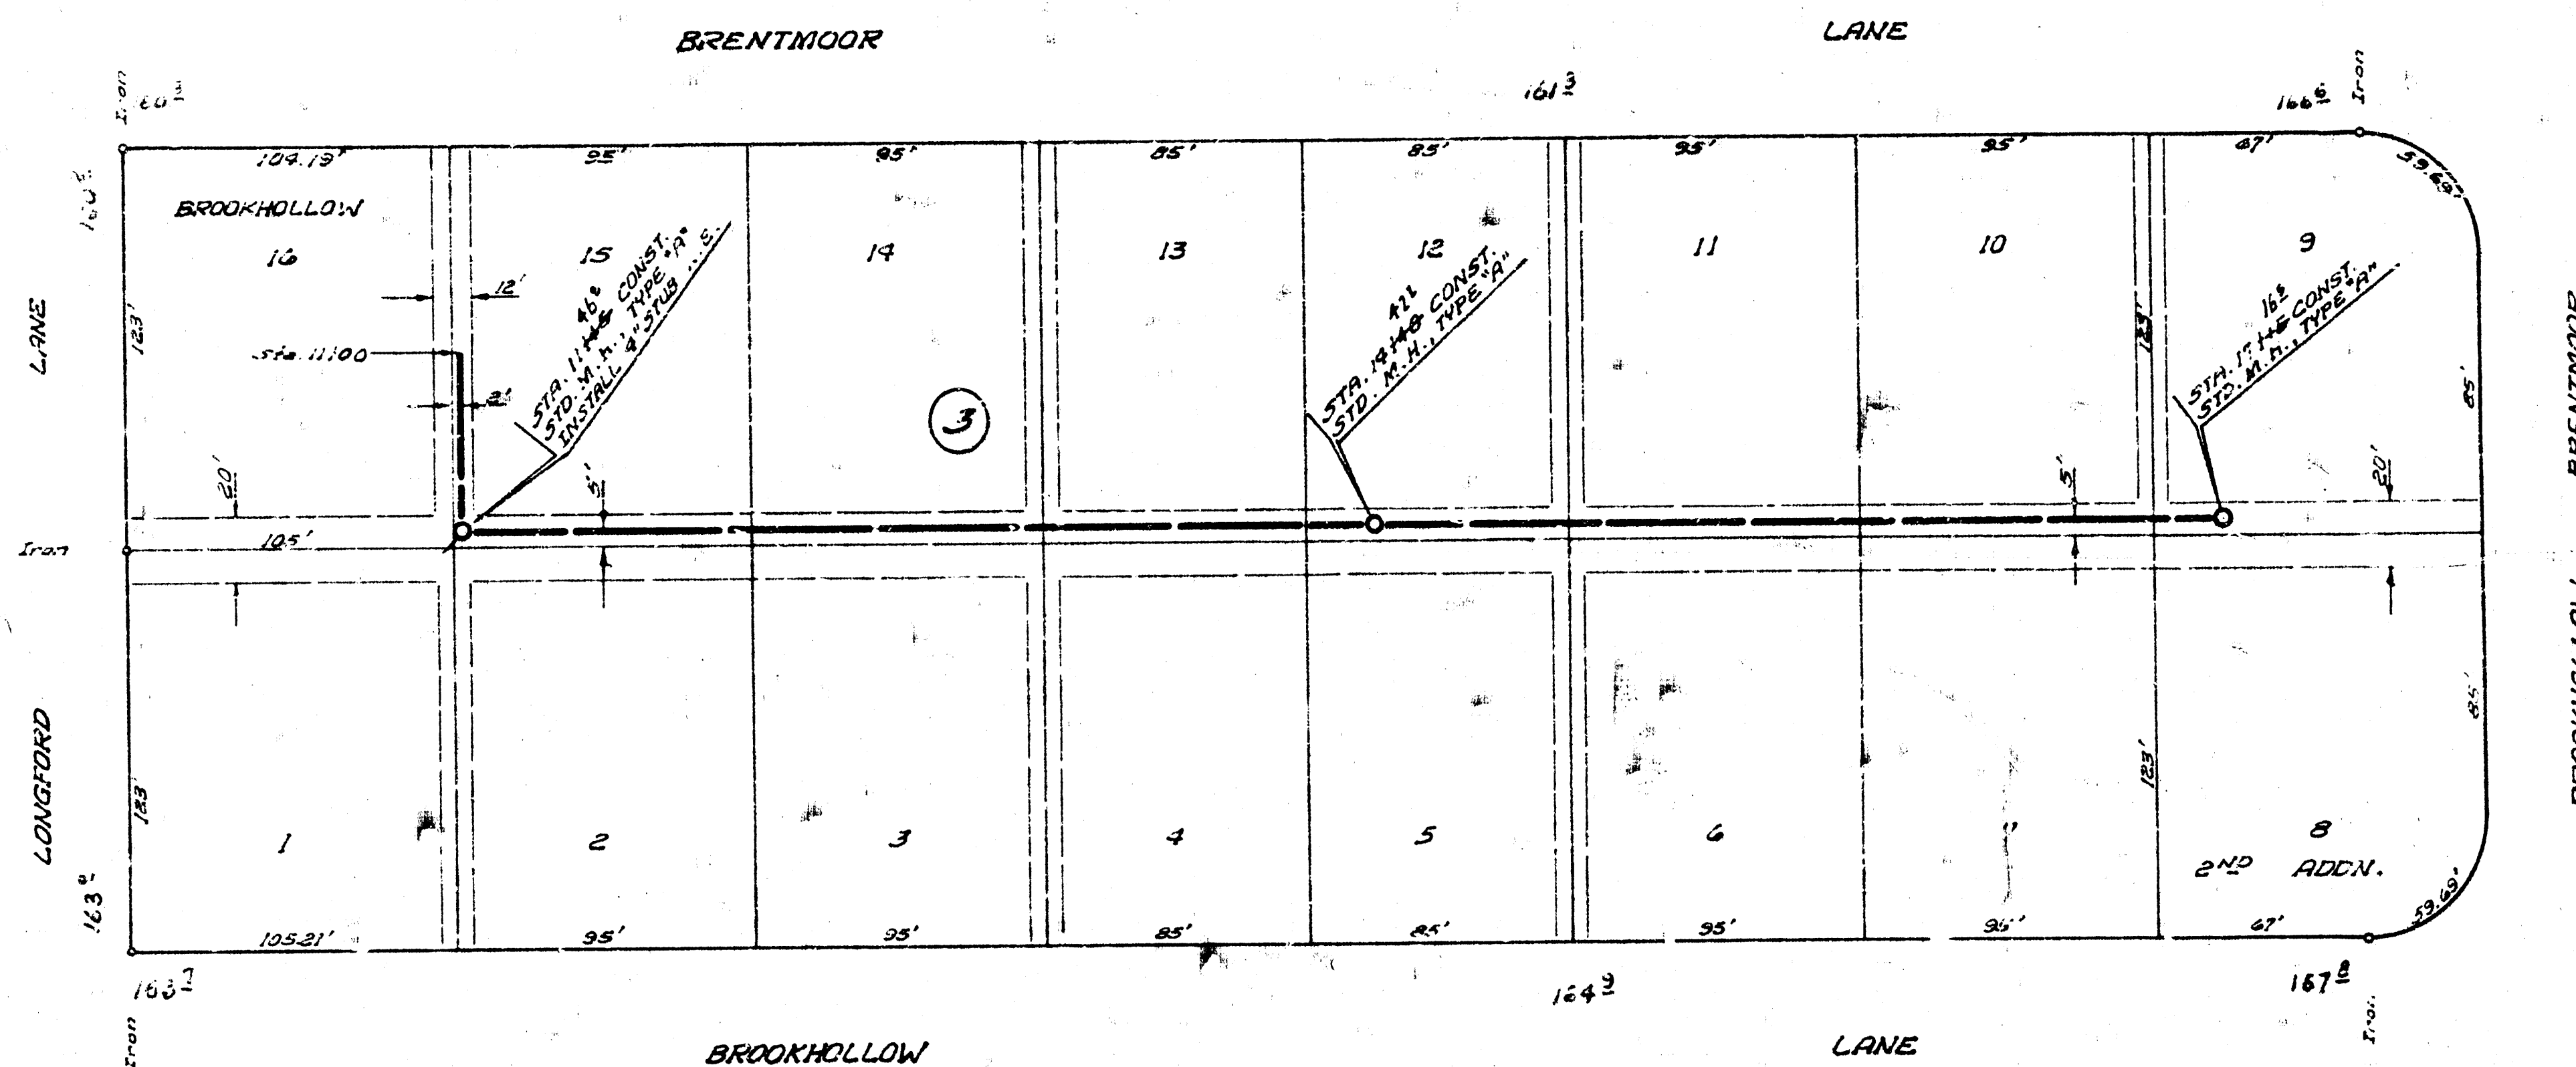

2/2

LAT. 17, SUB. 9, W. I. S.
PROJ. NO. DBKLS70027