
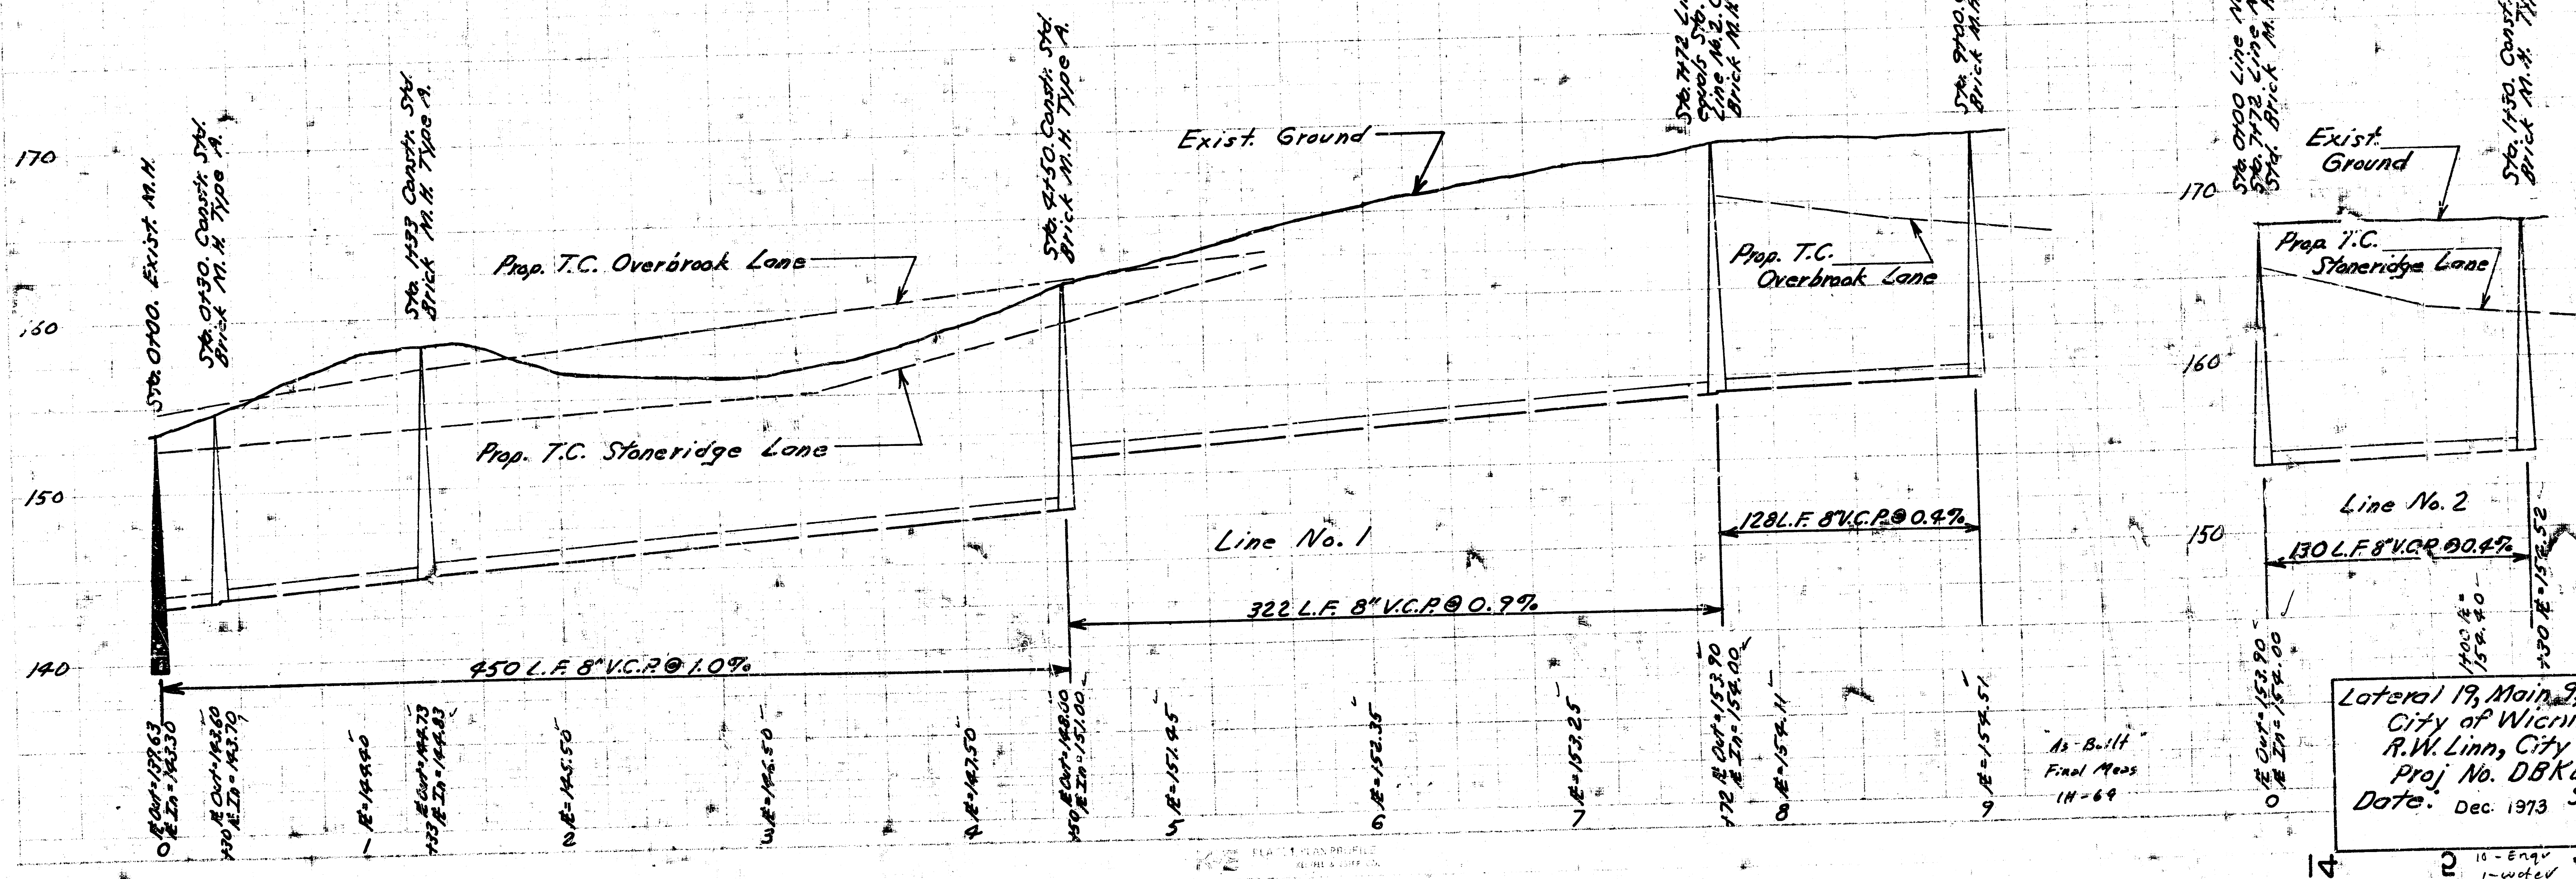


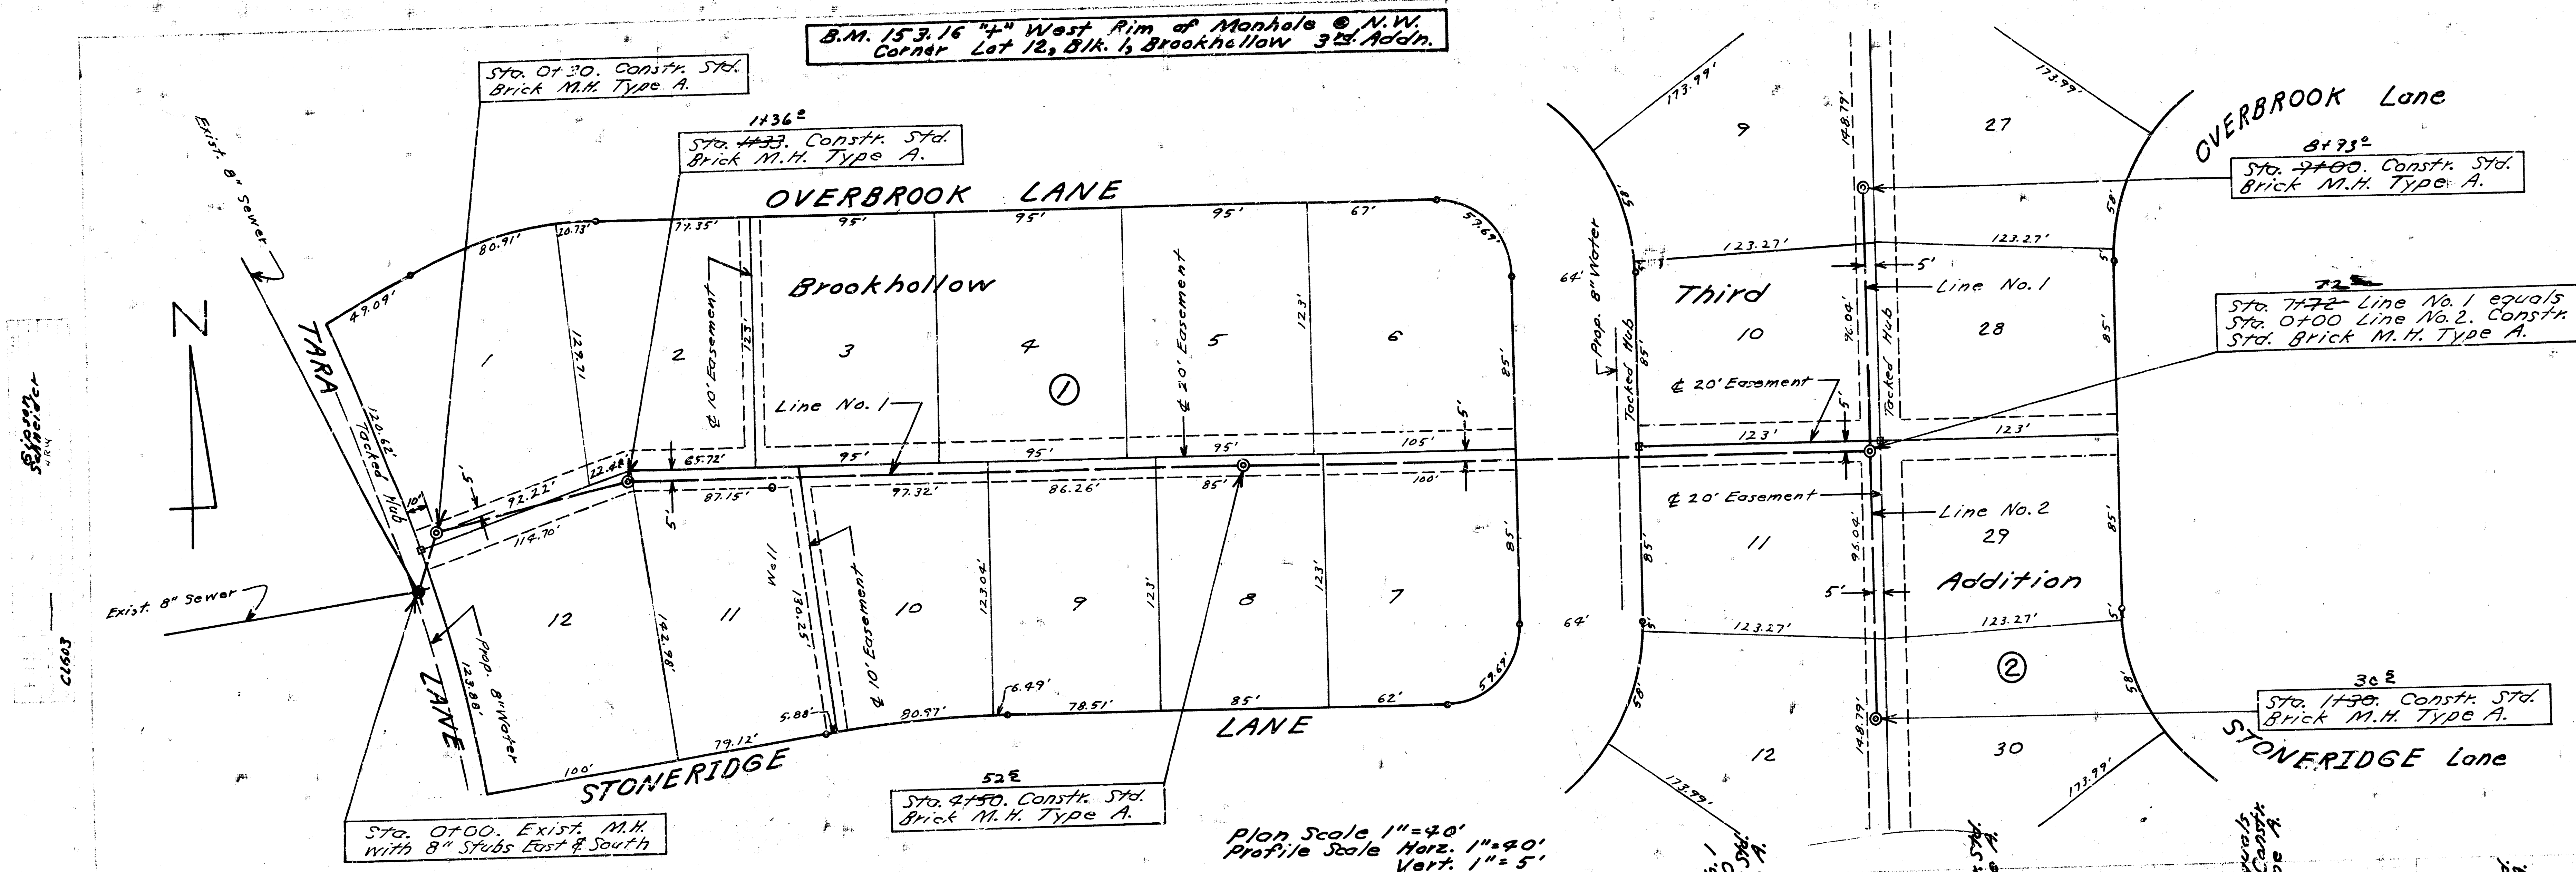

Lateral 19, Main 9, War Ind. Sew.  
 City of Wichita, Kansas  
 R.W. Linn, City Engineer  
 Proj. No. DBKL573049  
 Date: Dec. 1973 Spt. No. 1 of 1

FILMED FROM THE BEST AVAILABLE COPY....