



R.D. 117
R. Loomis




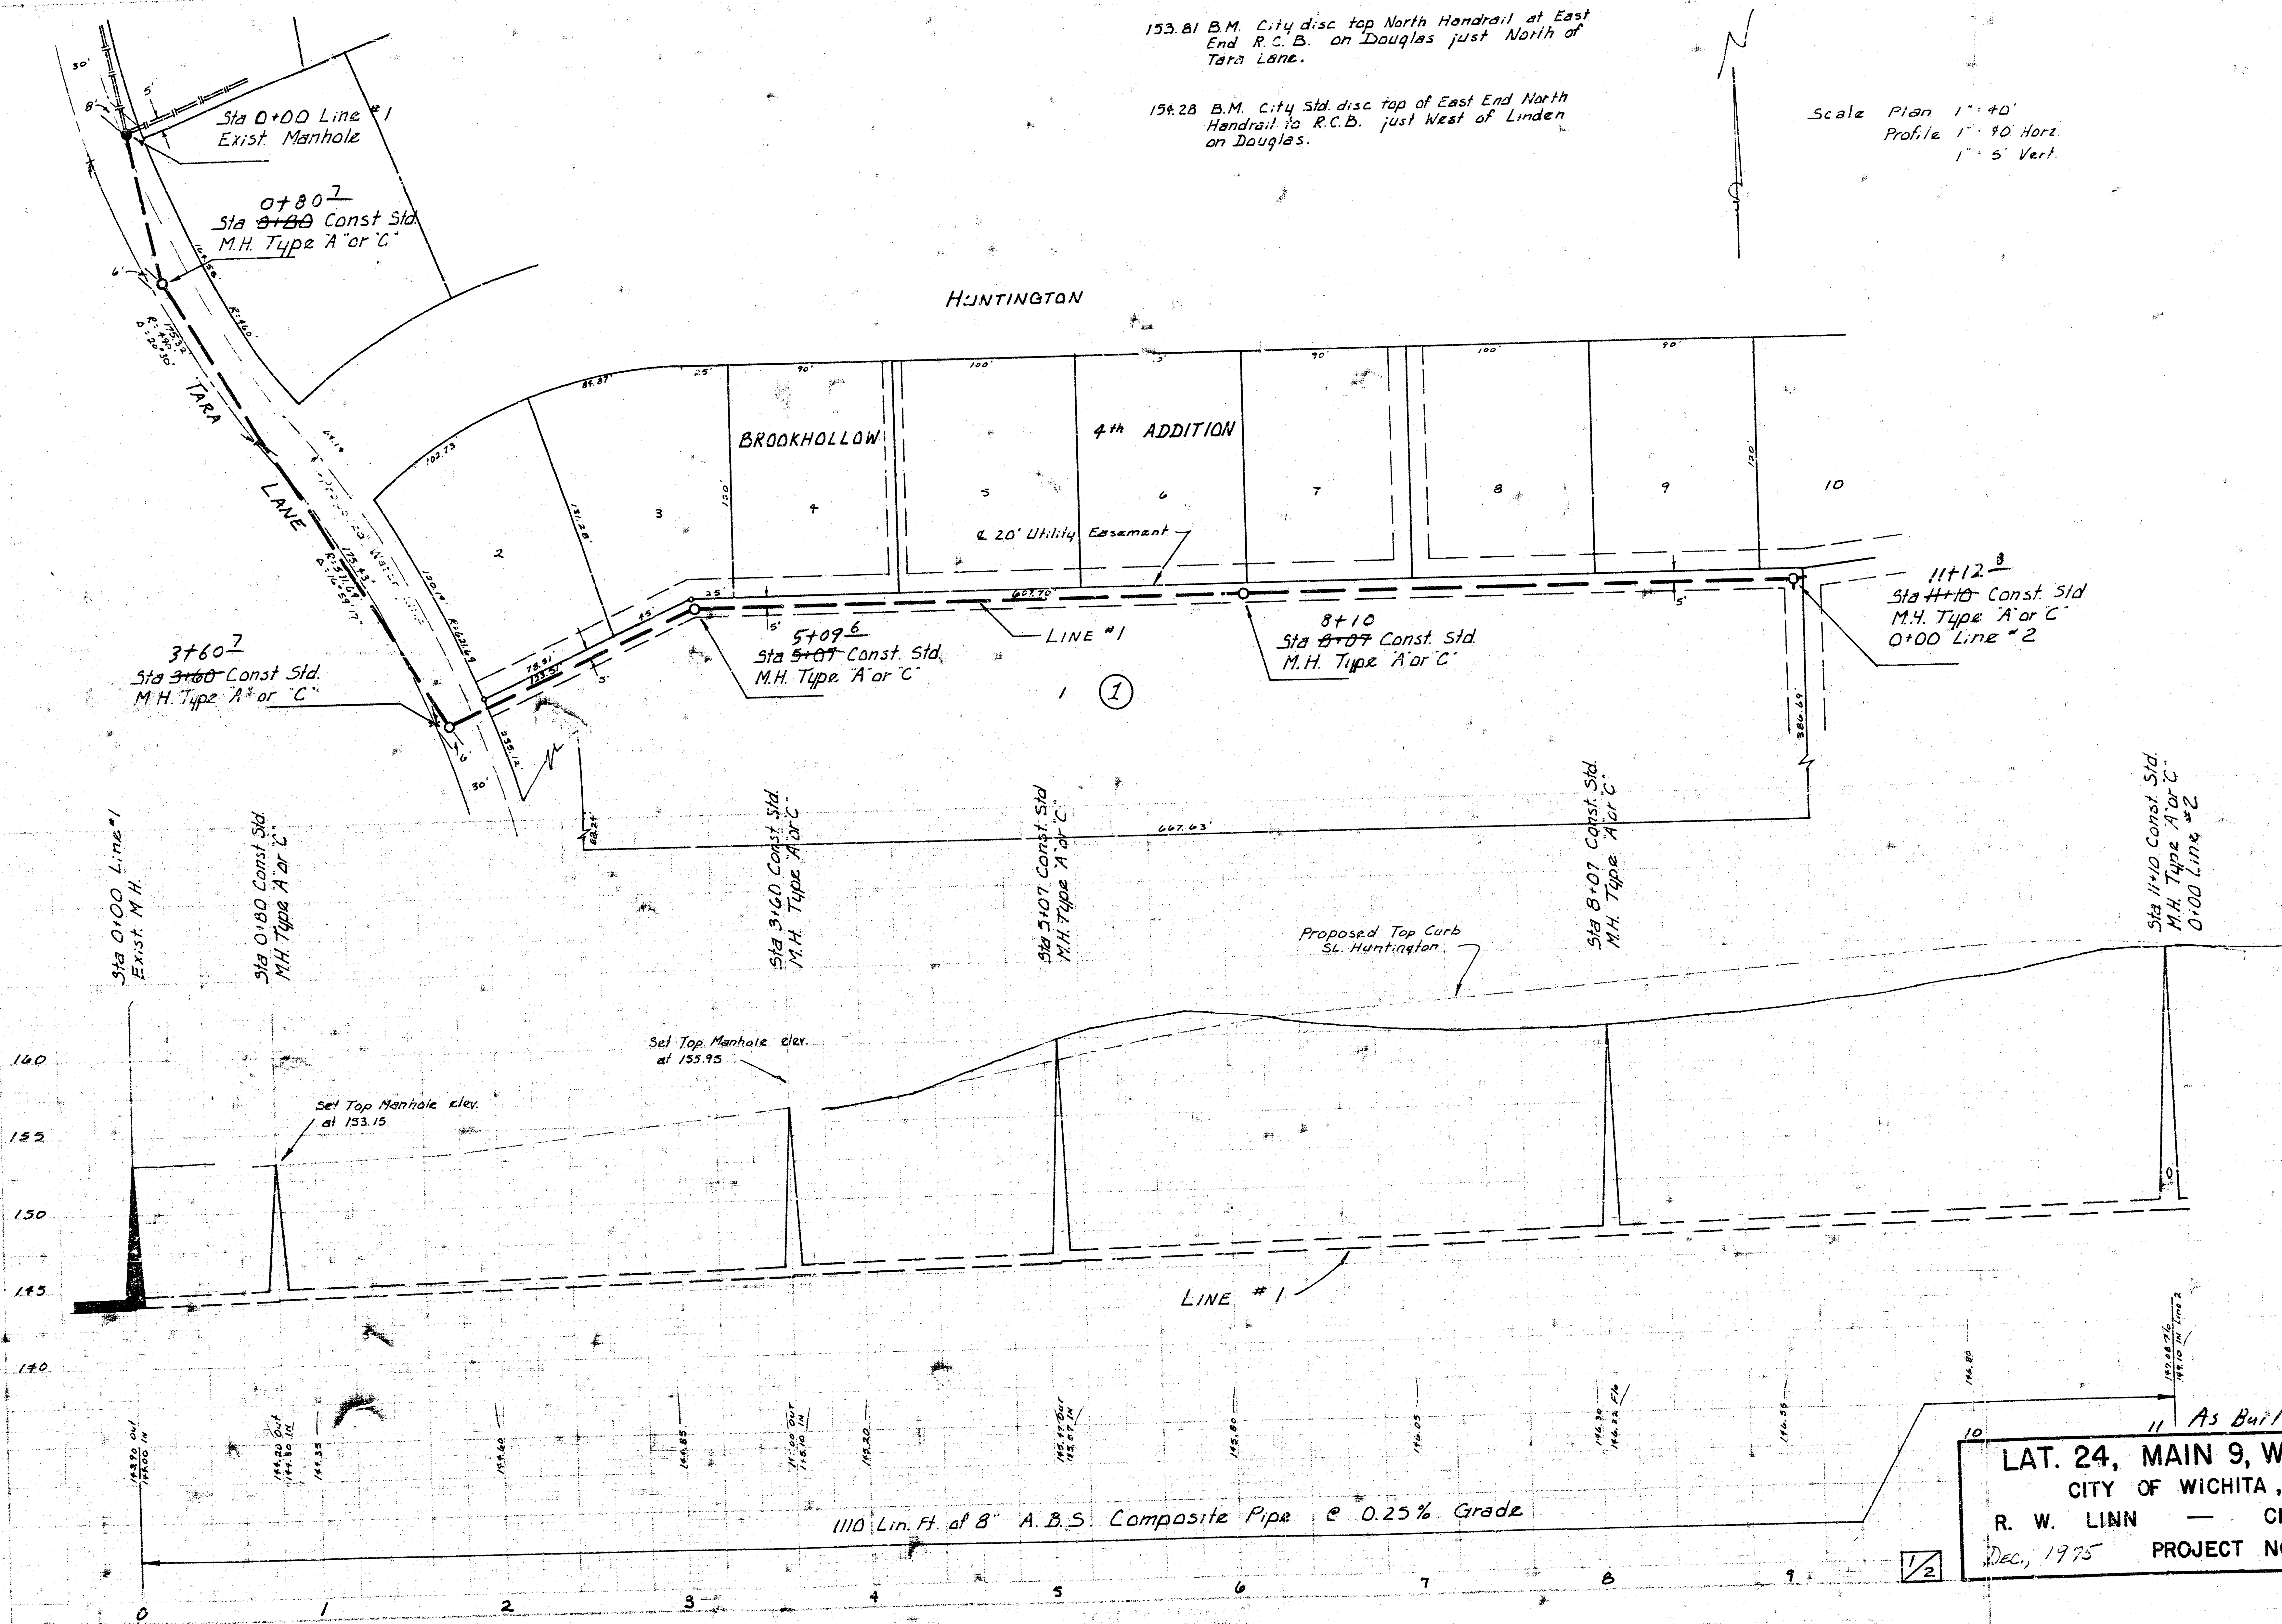


153.81 B.M. City disc top North Handrail at East End R.C.B. on Douglas just North of Tara Lane.
154.28 B.M. City Std. disc top of East End North Handrail to R.C.B. just West of Linden on Douglas.

Scale Plan 1" = 40'
Profile 1" = 40' Horiz.
1" = 5' Vert.

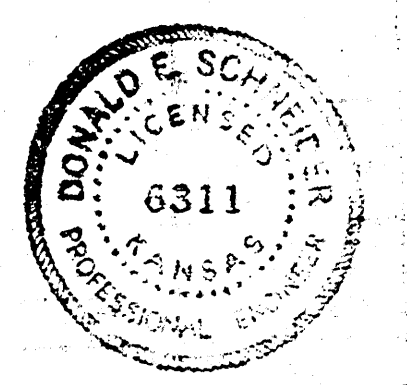

As Buplt 3-12-76
LAT. 24, MAIN 9, WAR IND. SEW.
CITY OF WICHITA, KANSAS
R. W. LINN — CITY ENGINEER
Dec, 1975 PROJECT NO. DBKL575077

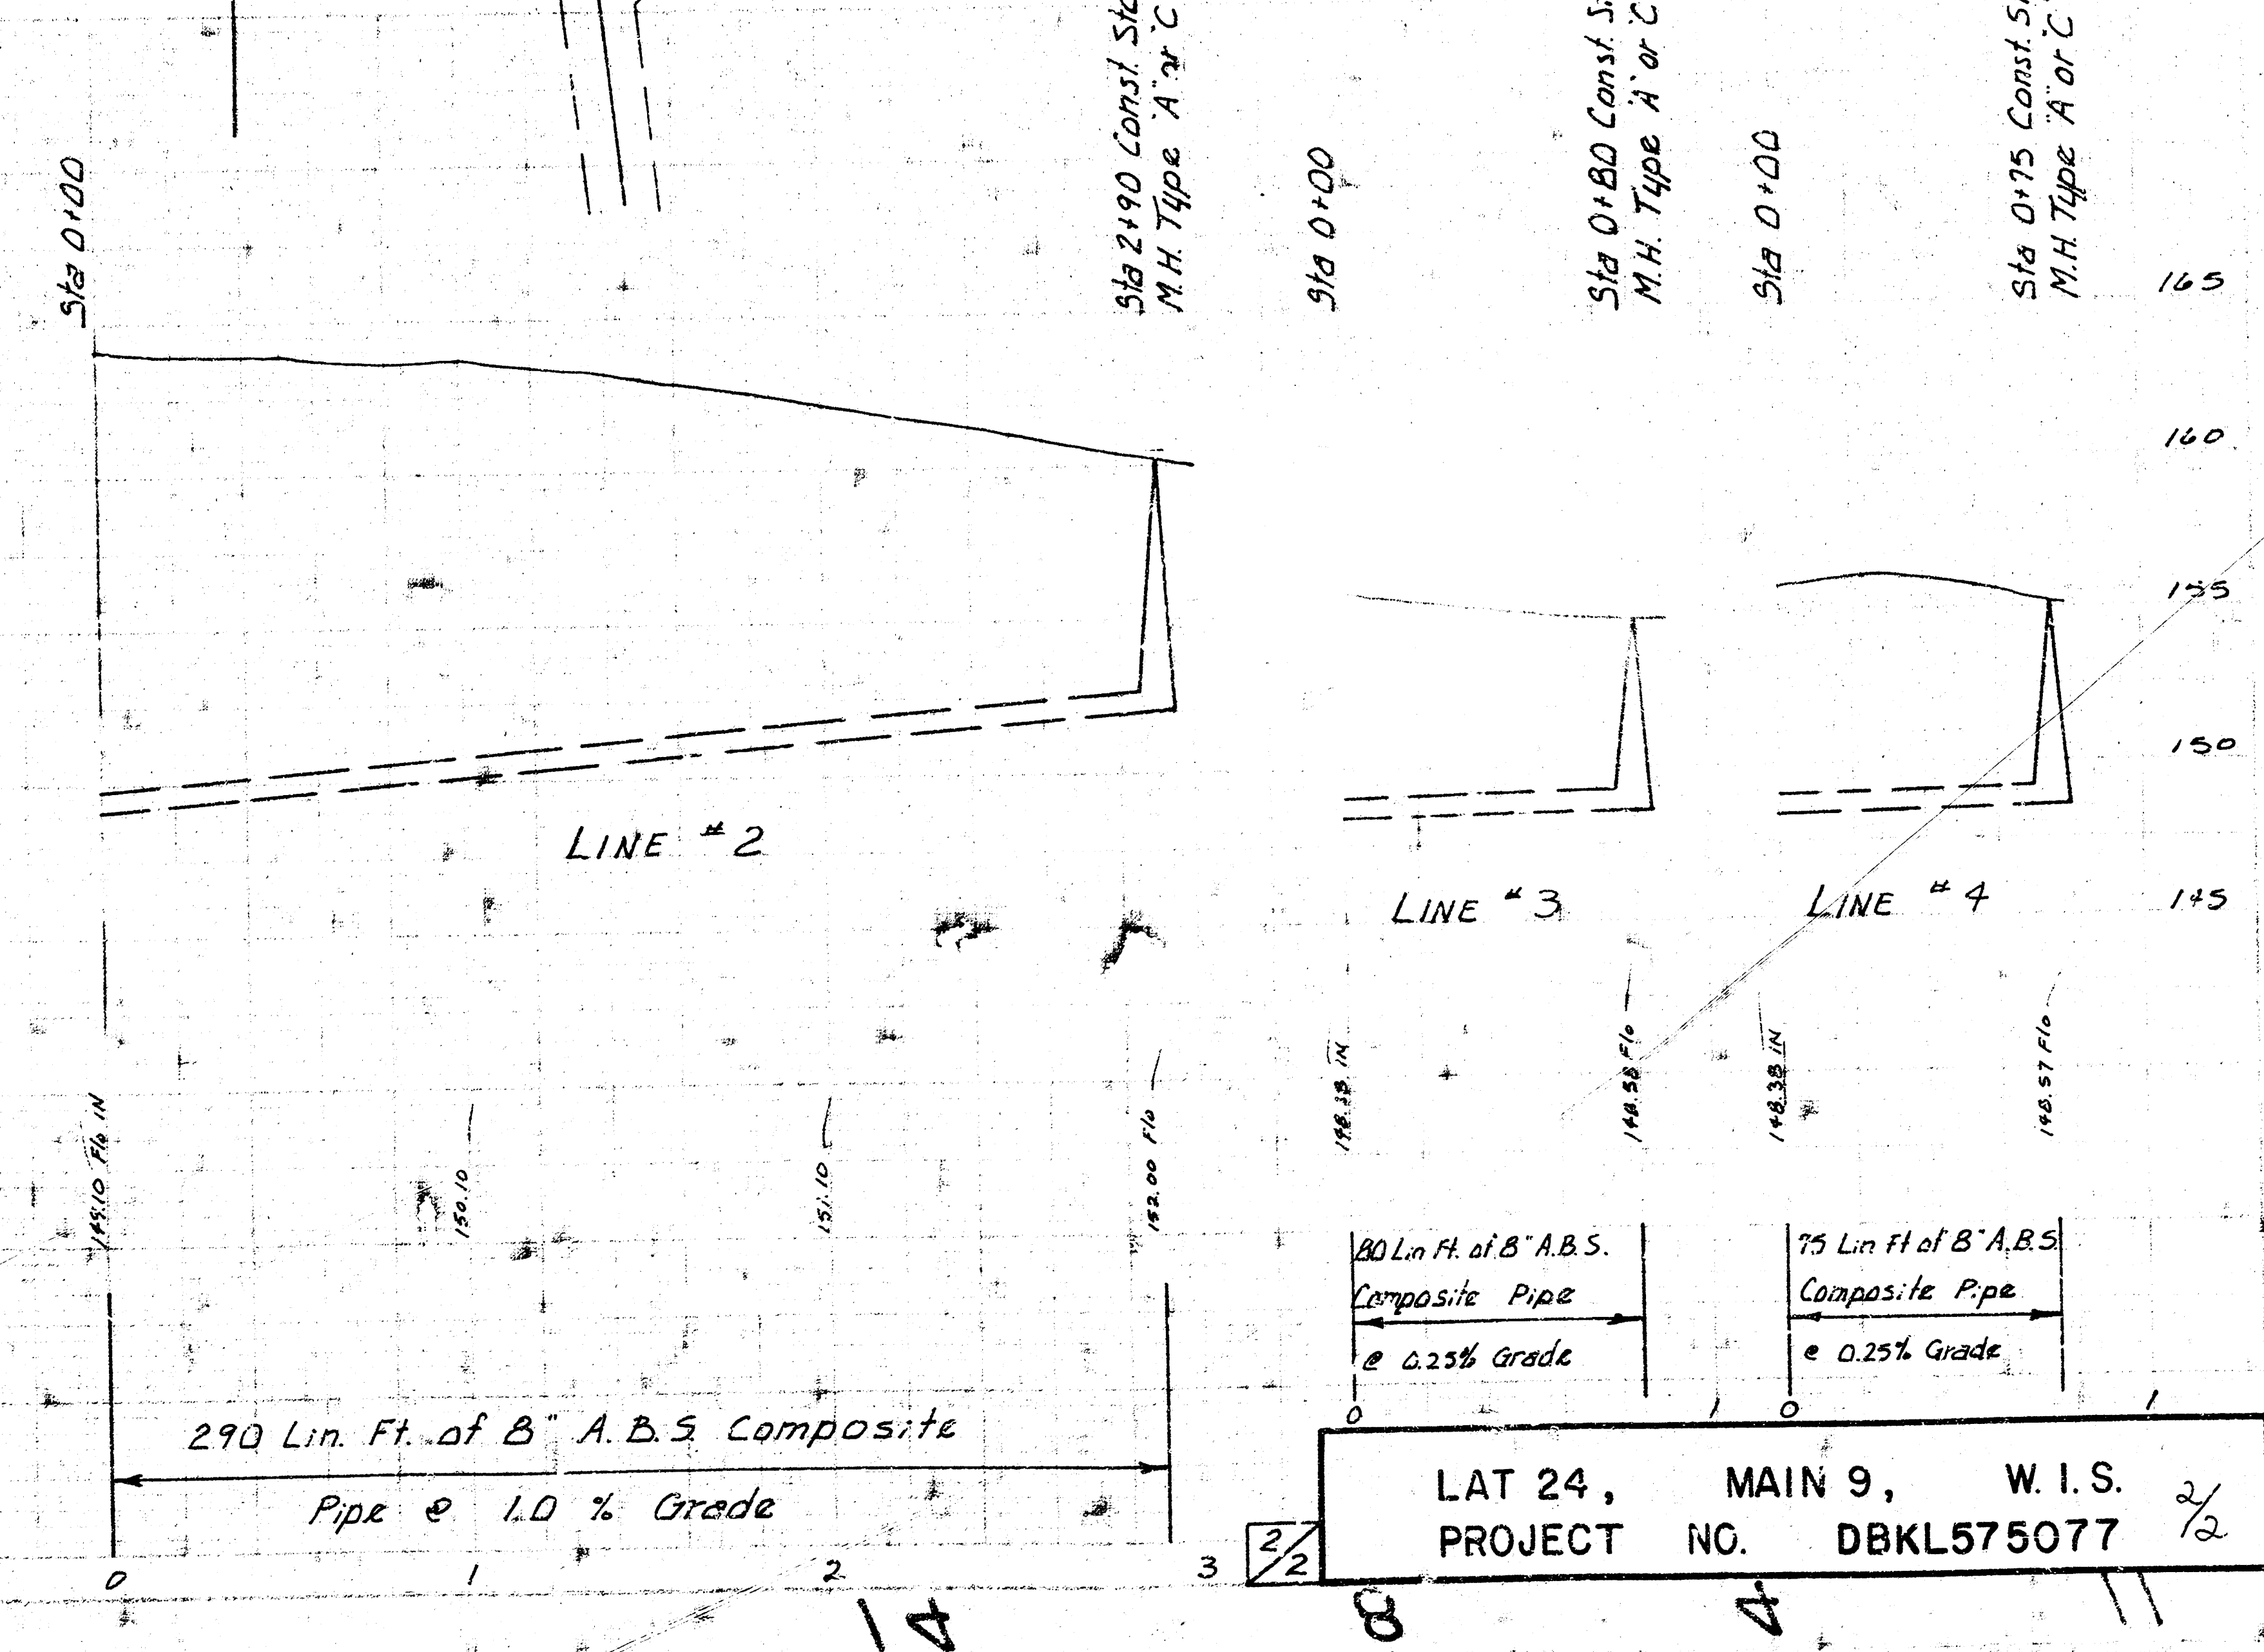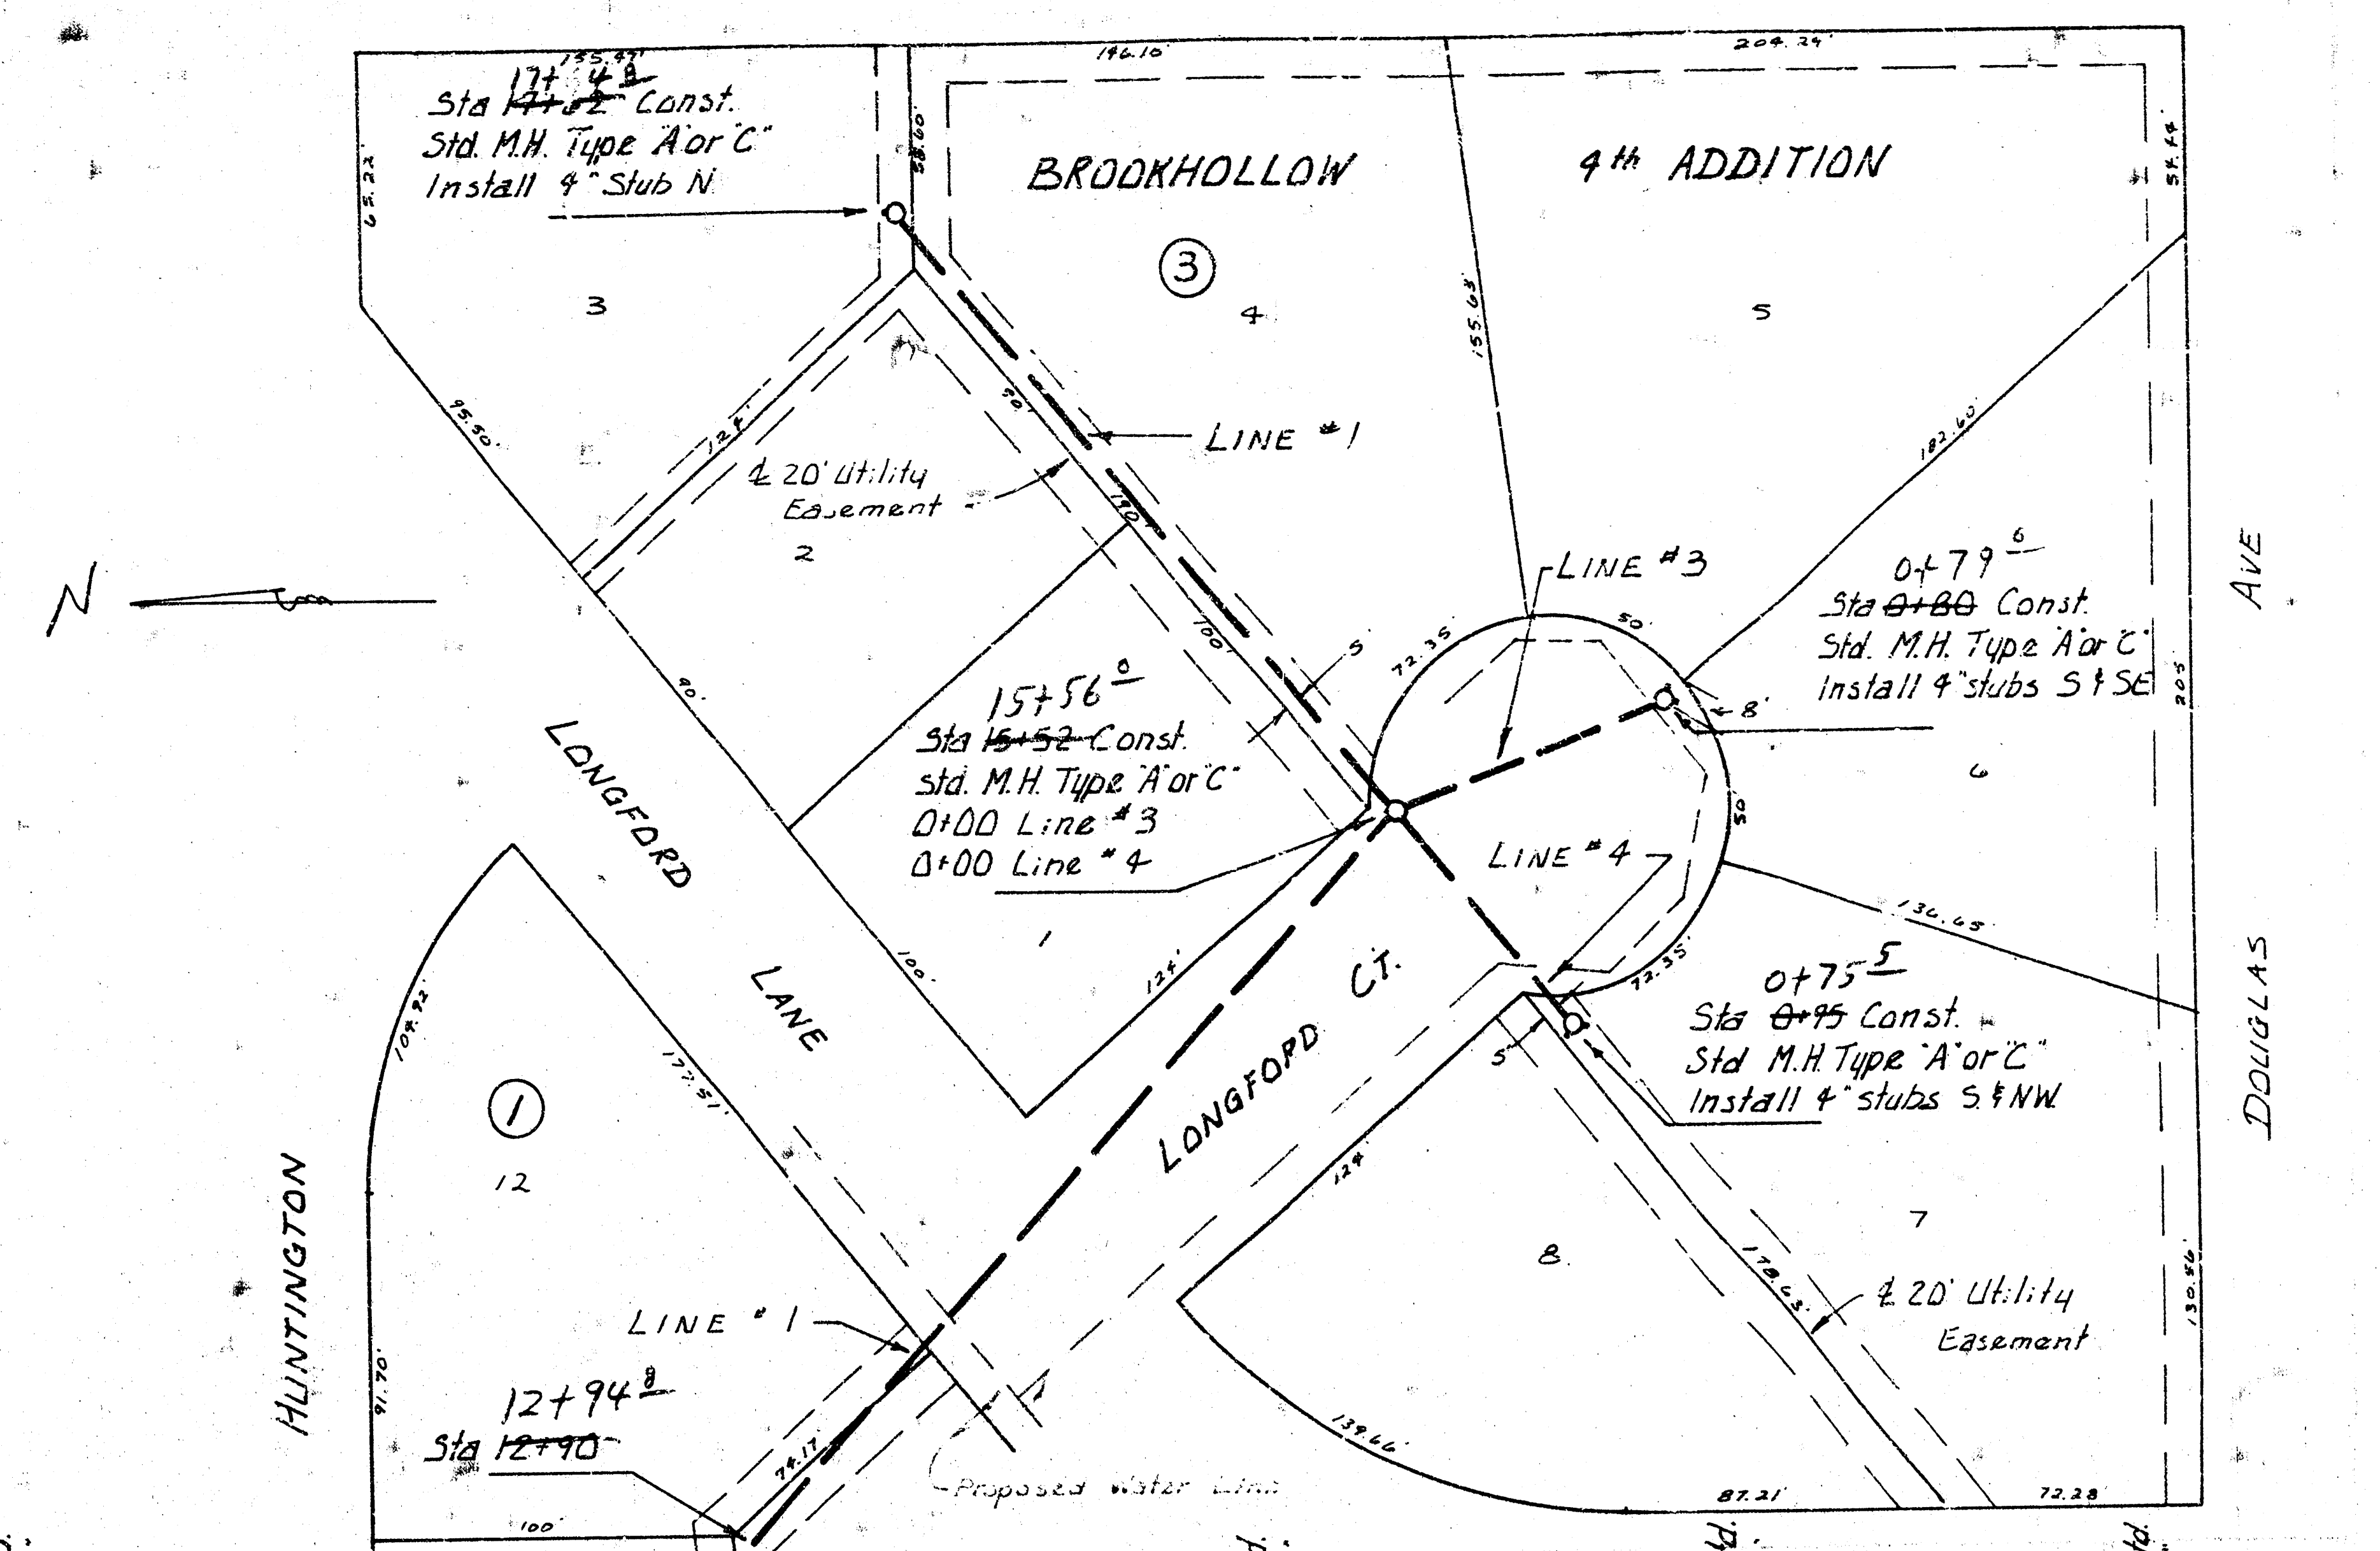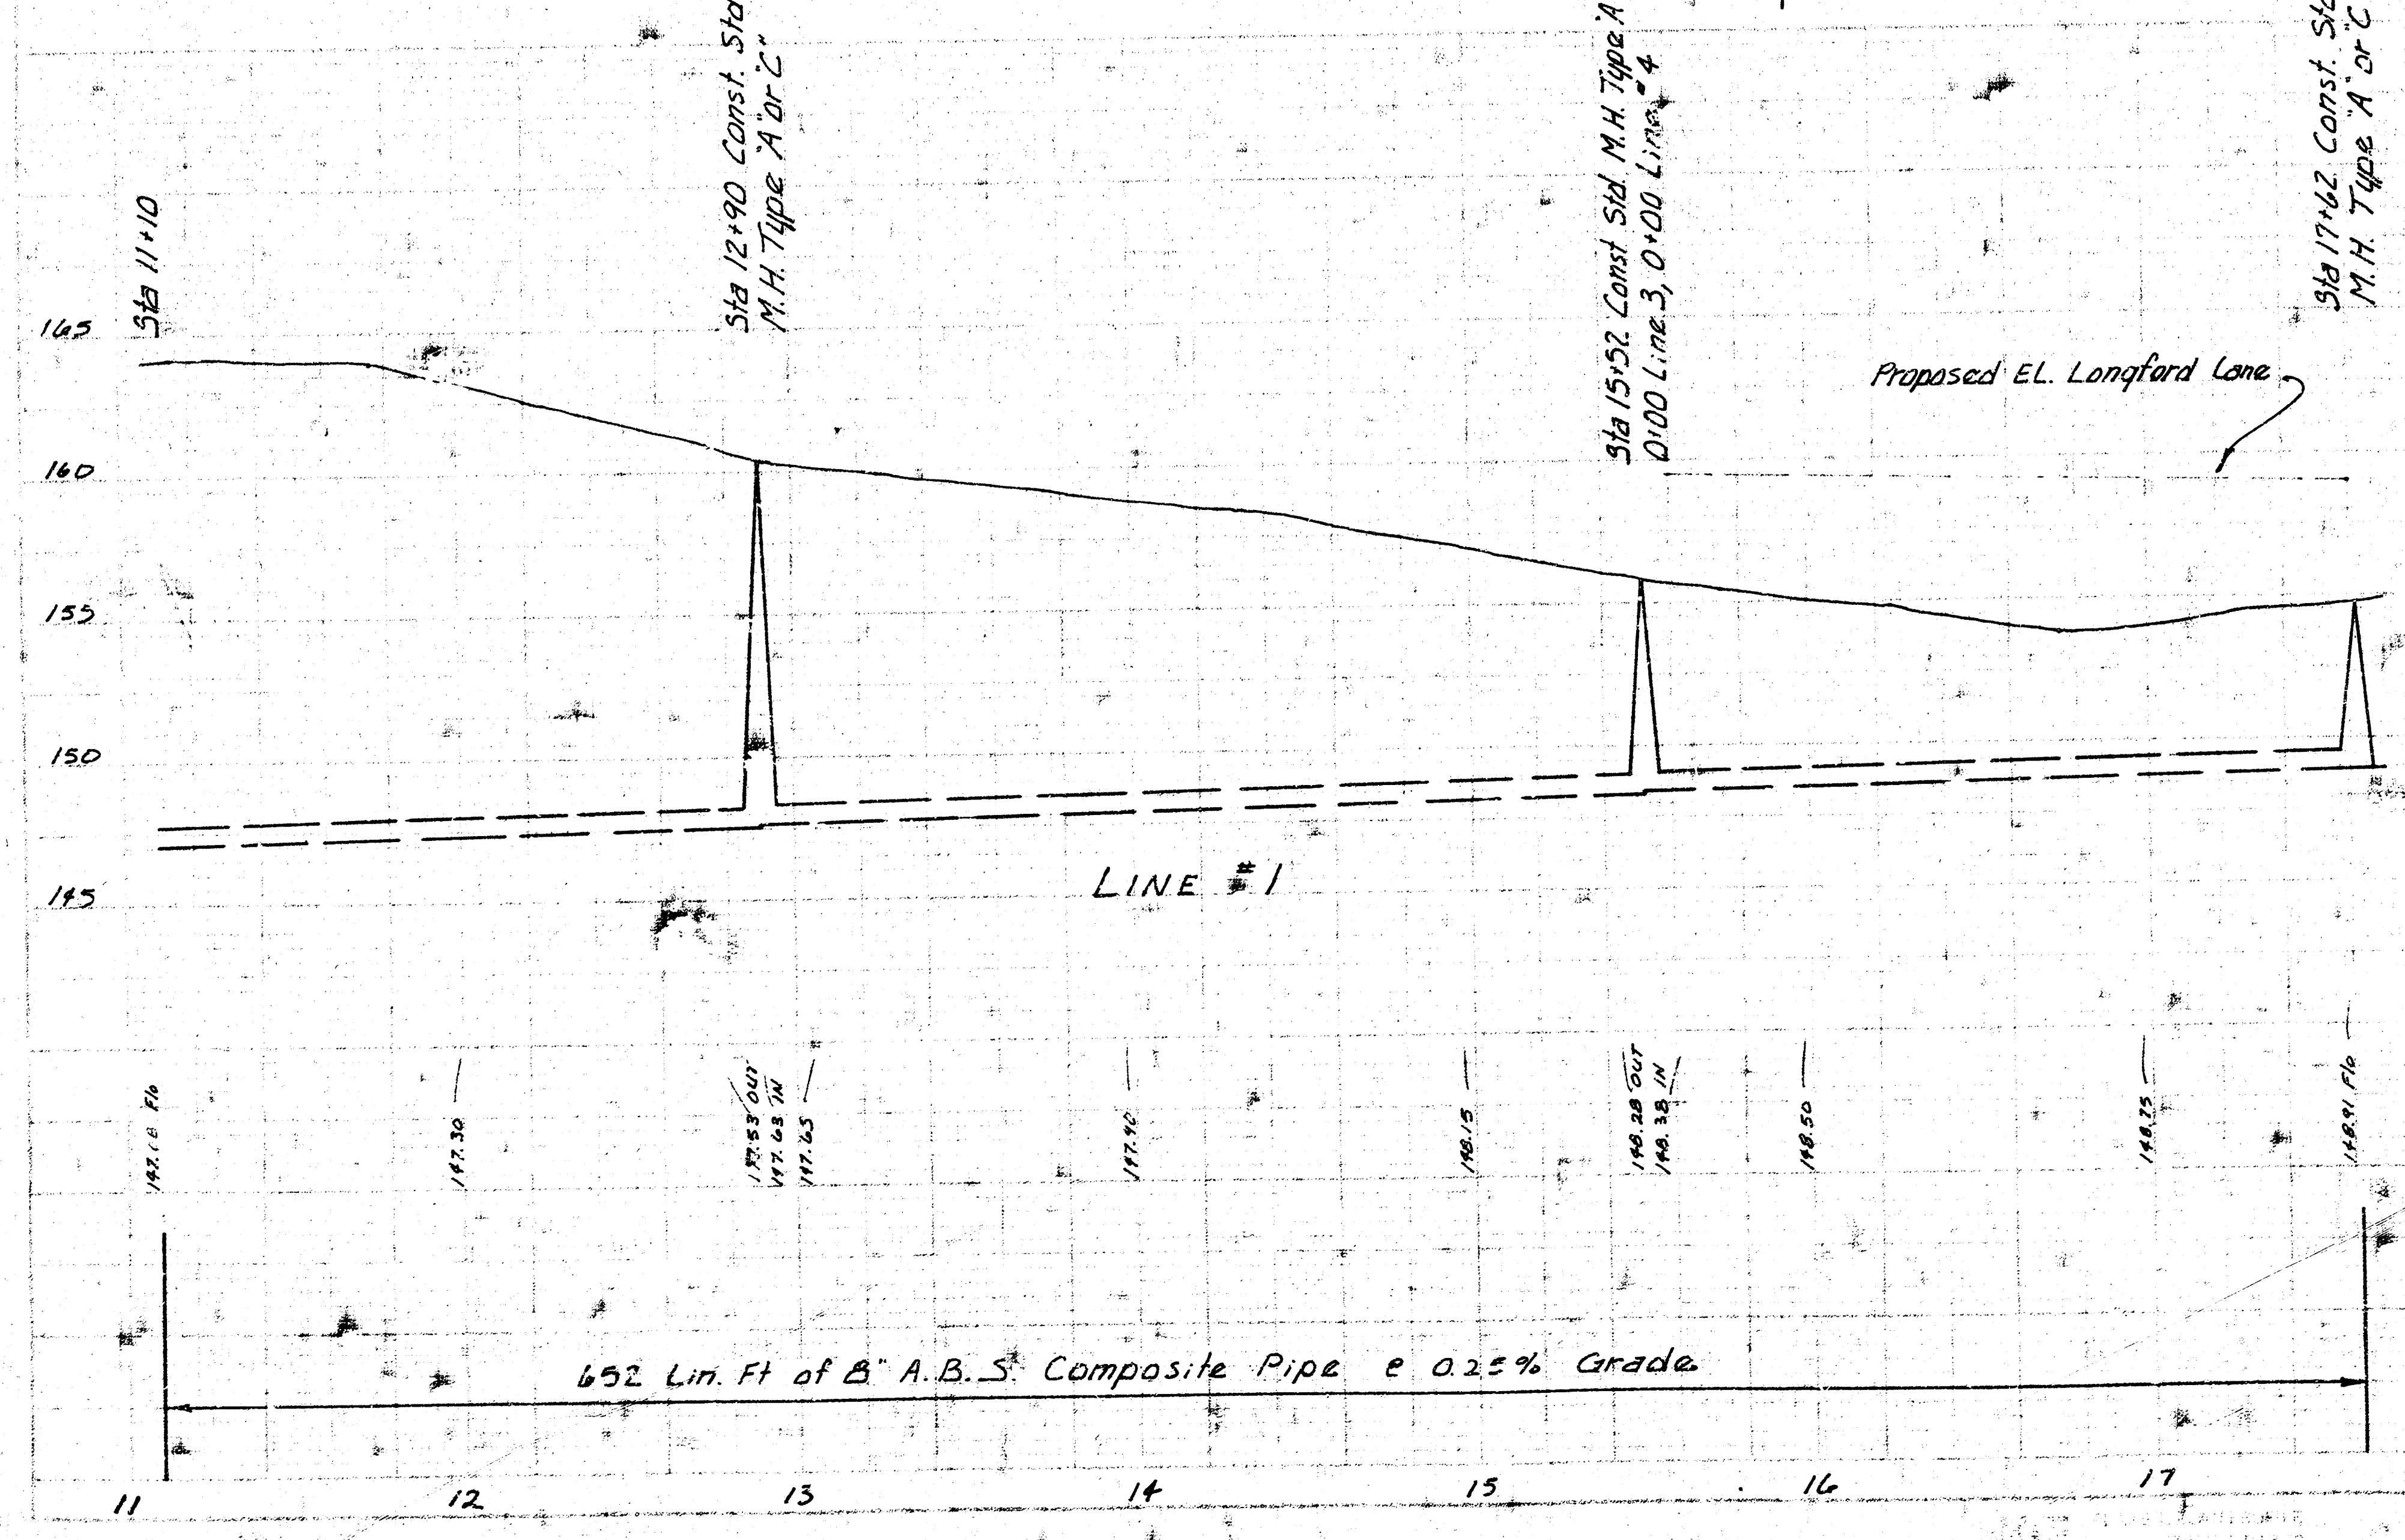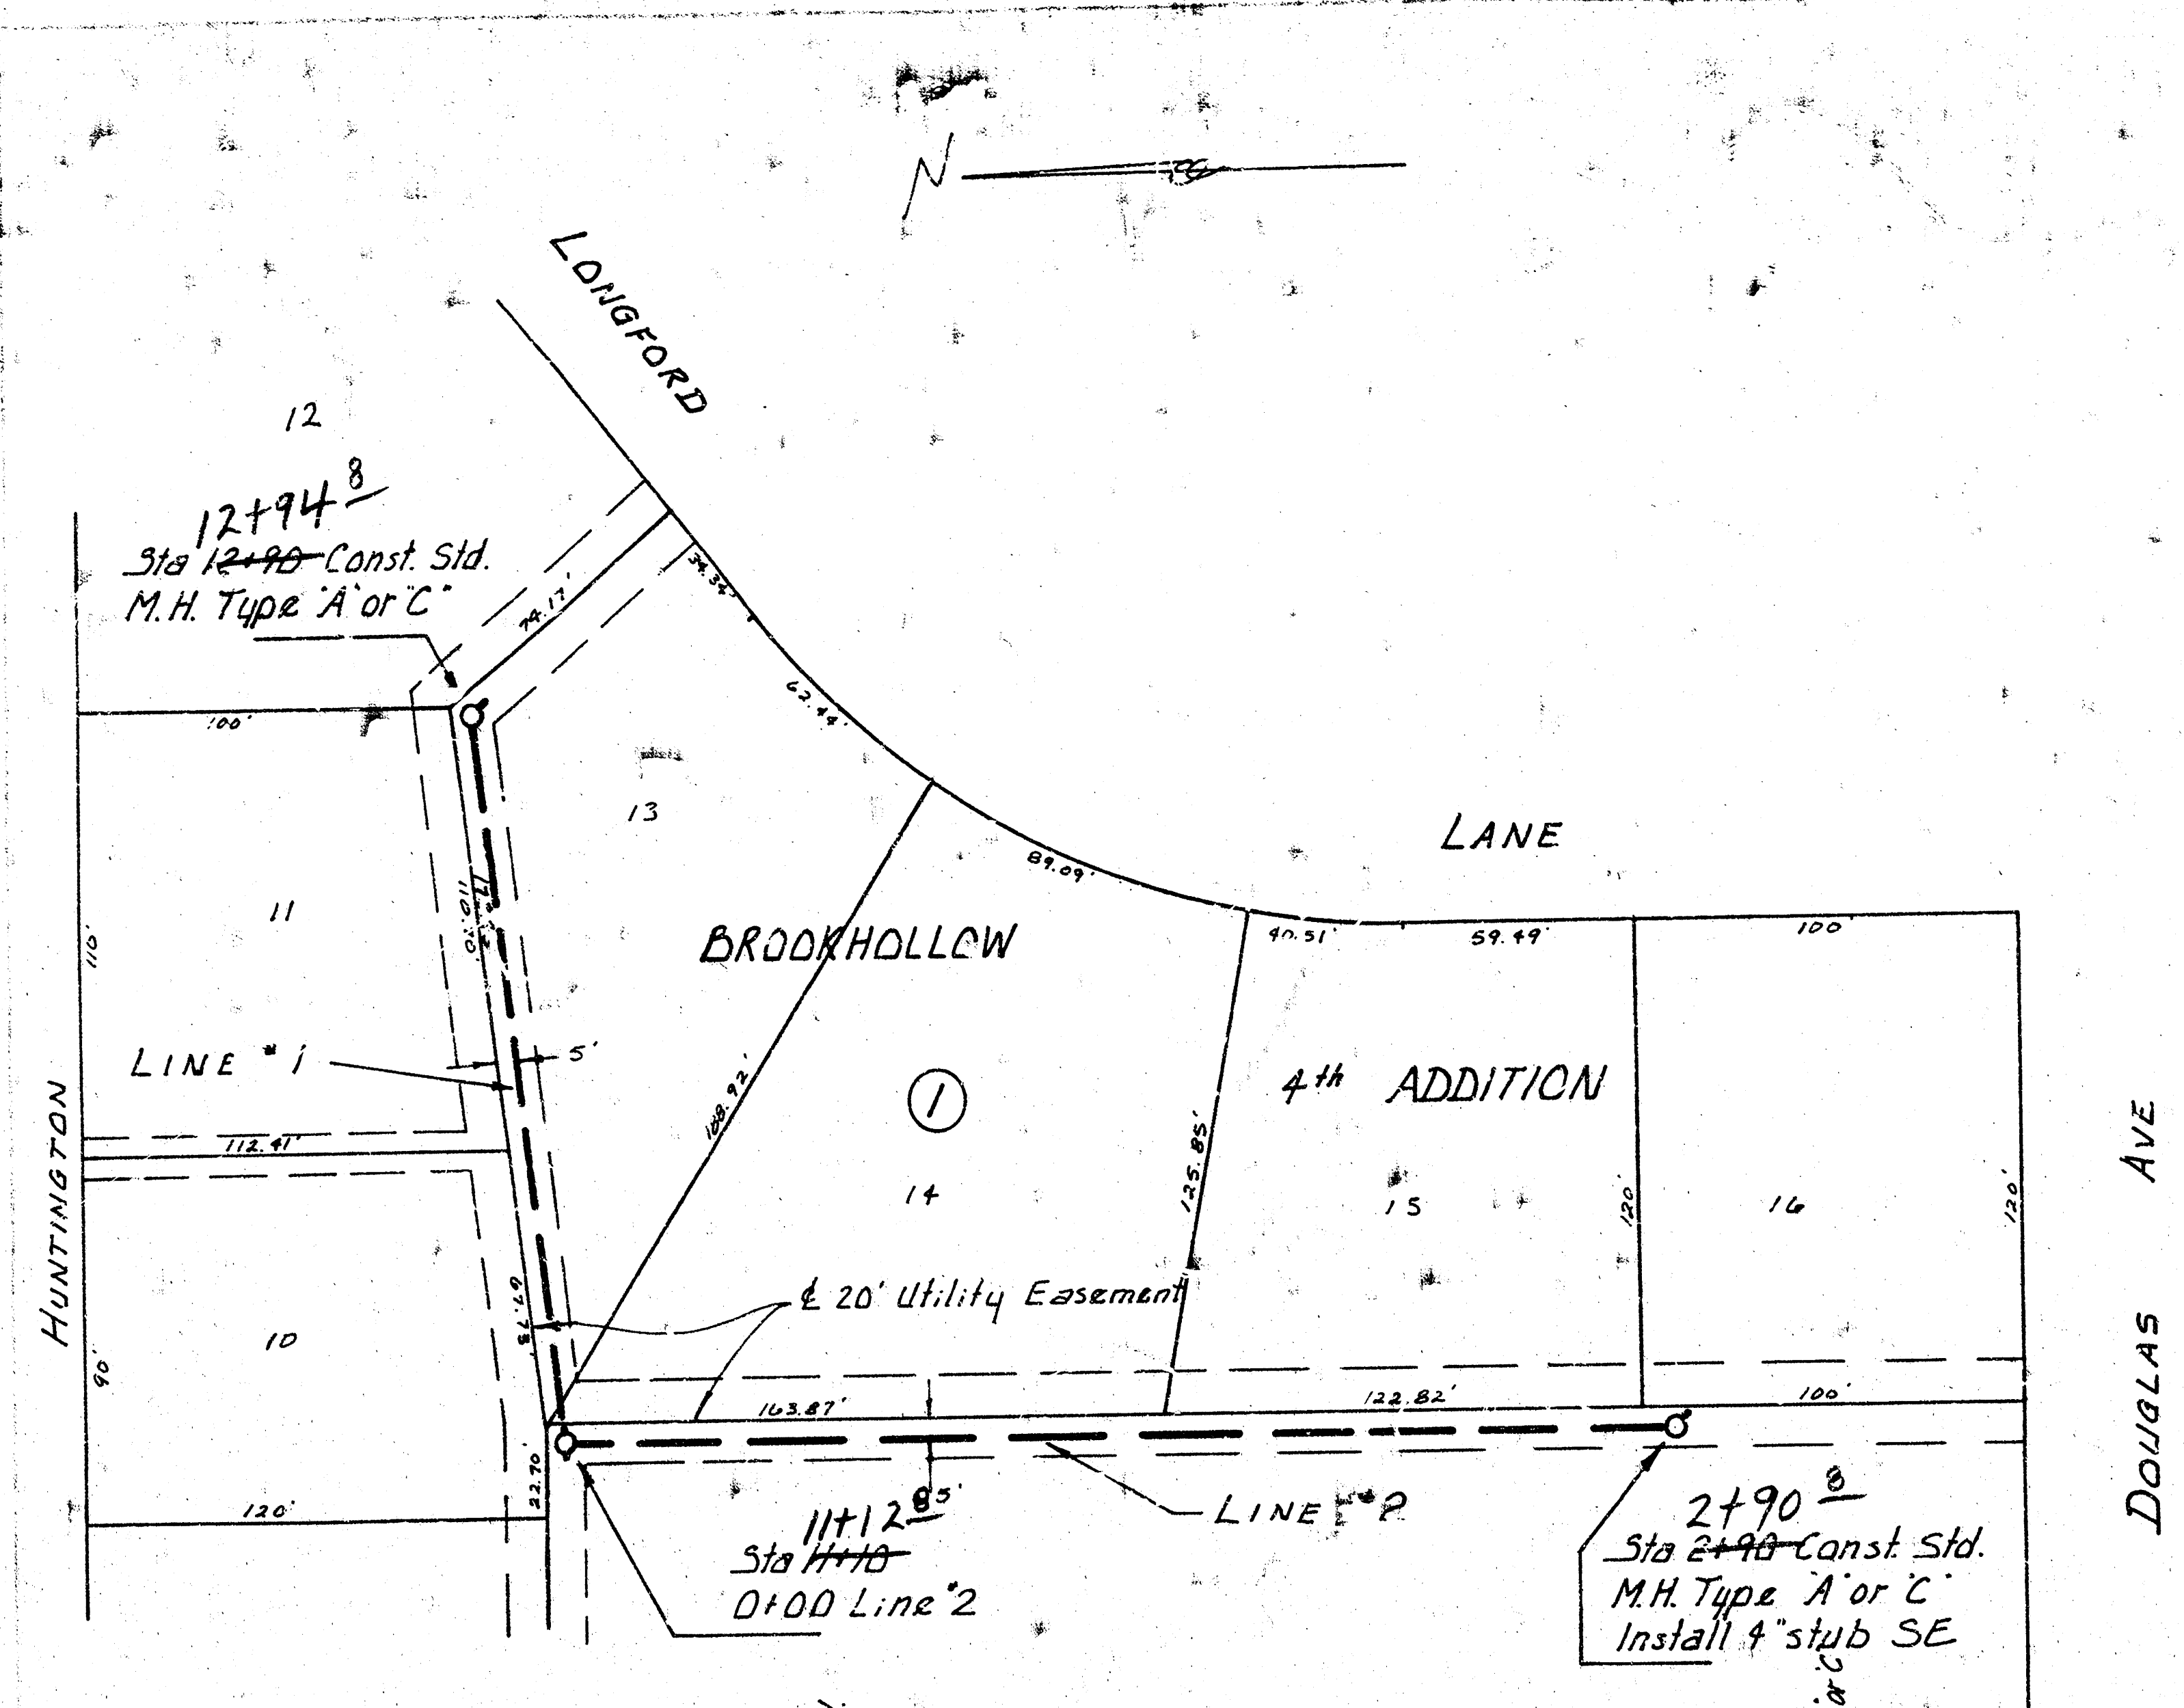

80 Lin. Ft. of 8" A.B.S. Composite Pipe @ 0.25% Grade	75 Lin. Ft. of 8" A.B.S. Composite Pipe @ 0.25% Grade
LAT 24, MAIN 9, W.I.S. PROJECT NO. DBKL575077 2/2	