

NOTE:
Contractor to uncover exist.
pipe at Sta. 1107.0 to verify
Flo. elev. prior to construction.

NOTE TO CONTRACTOR
This project will be constructed under
the supervision of the CITY ENGINEER
and conforming to the SPECIFICATIONS
of the CITY OF WICHITA. The CONTRACTOR
will reimburse the City of
Wichita for all cost of Engineering, Plans,
and Inspection.



CAUTION:
Tells underground
Cable, Serv. Box

CAUTION:
Tells underground
Cable, Serv. Box


Sta. 3169.8 Const.
Std. M. H. Type "A"
Sta. 0100.0 Line No. 2

Sta. 1190.0 Const.
Std. M. H. Type "A"

Sta. 1169.8 Const.
Std. M. H. Type "A"

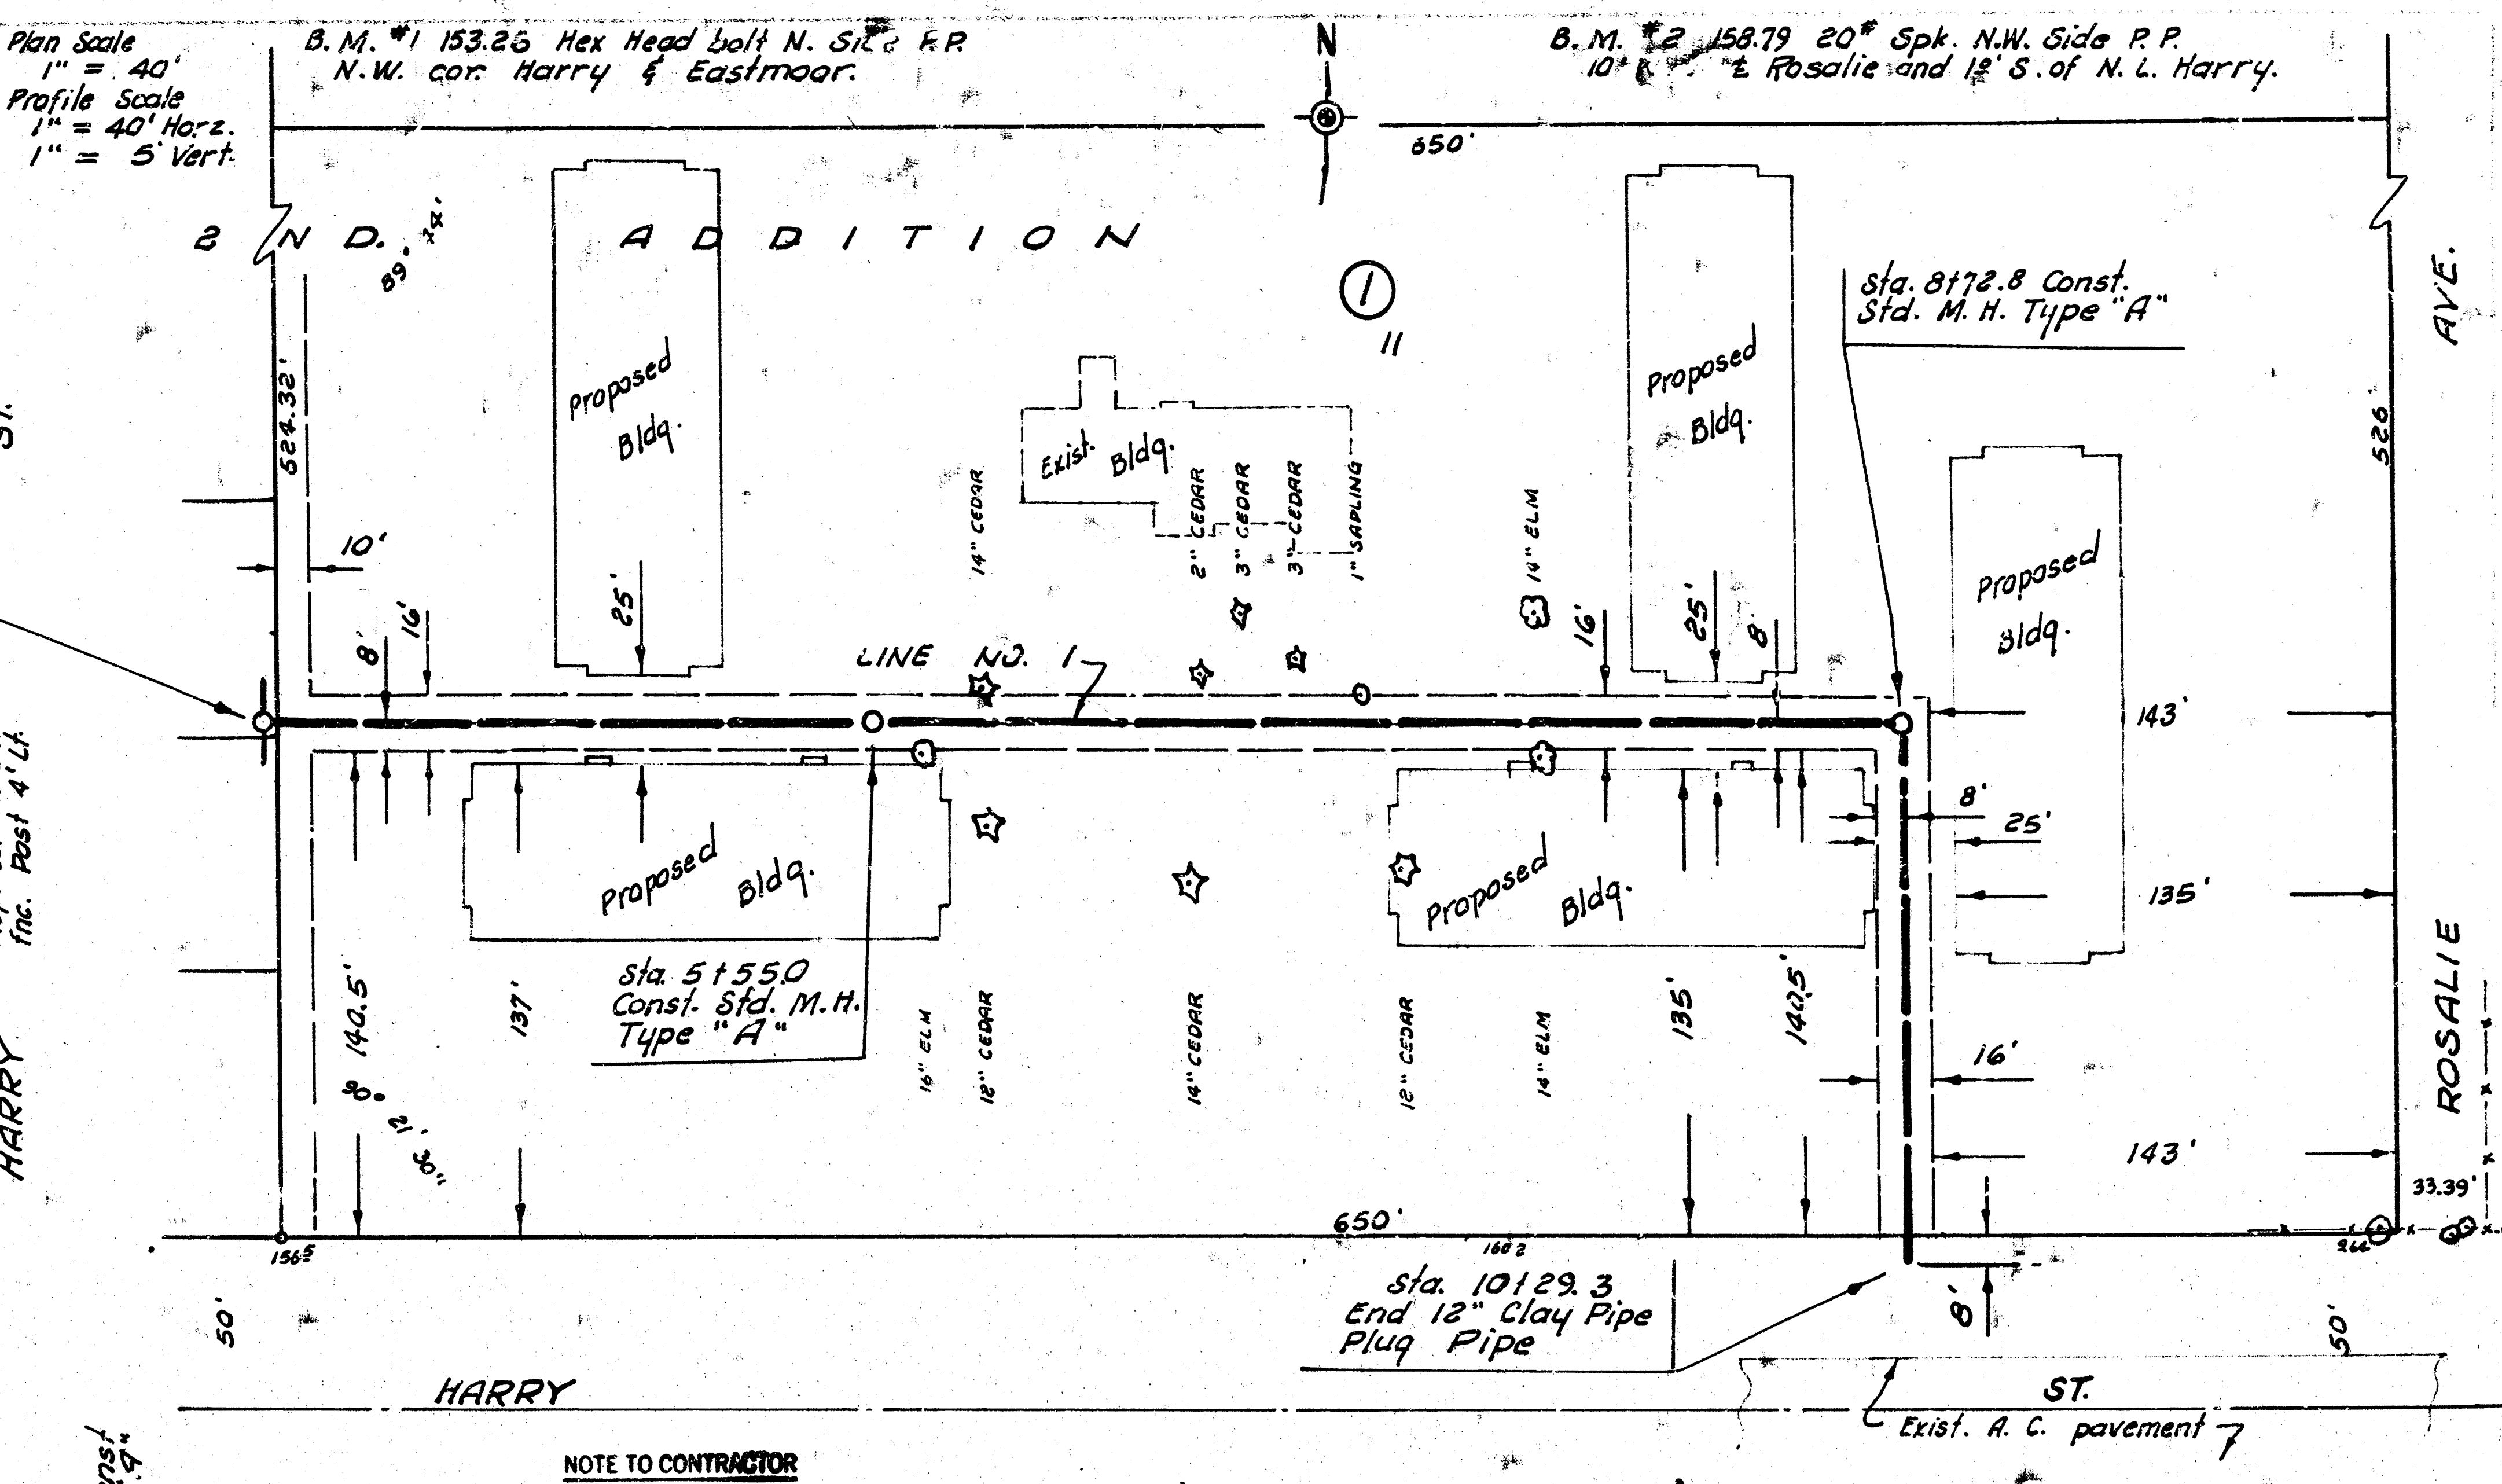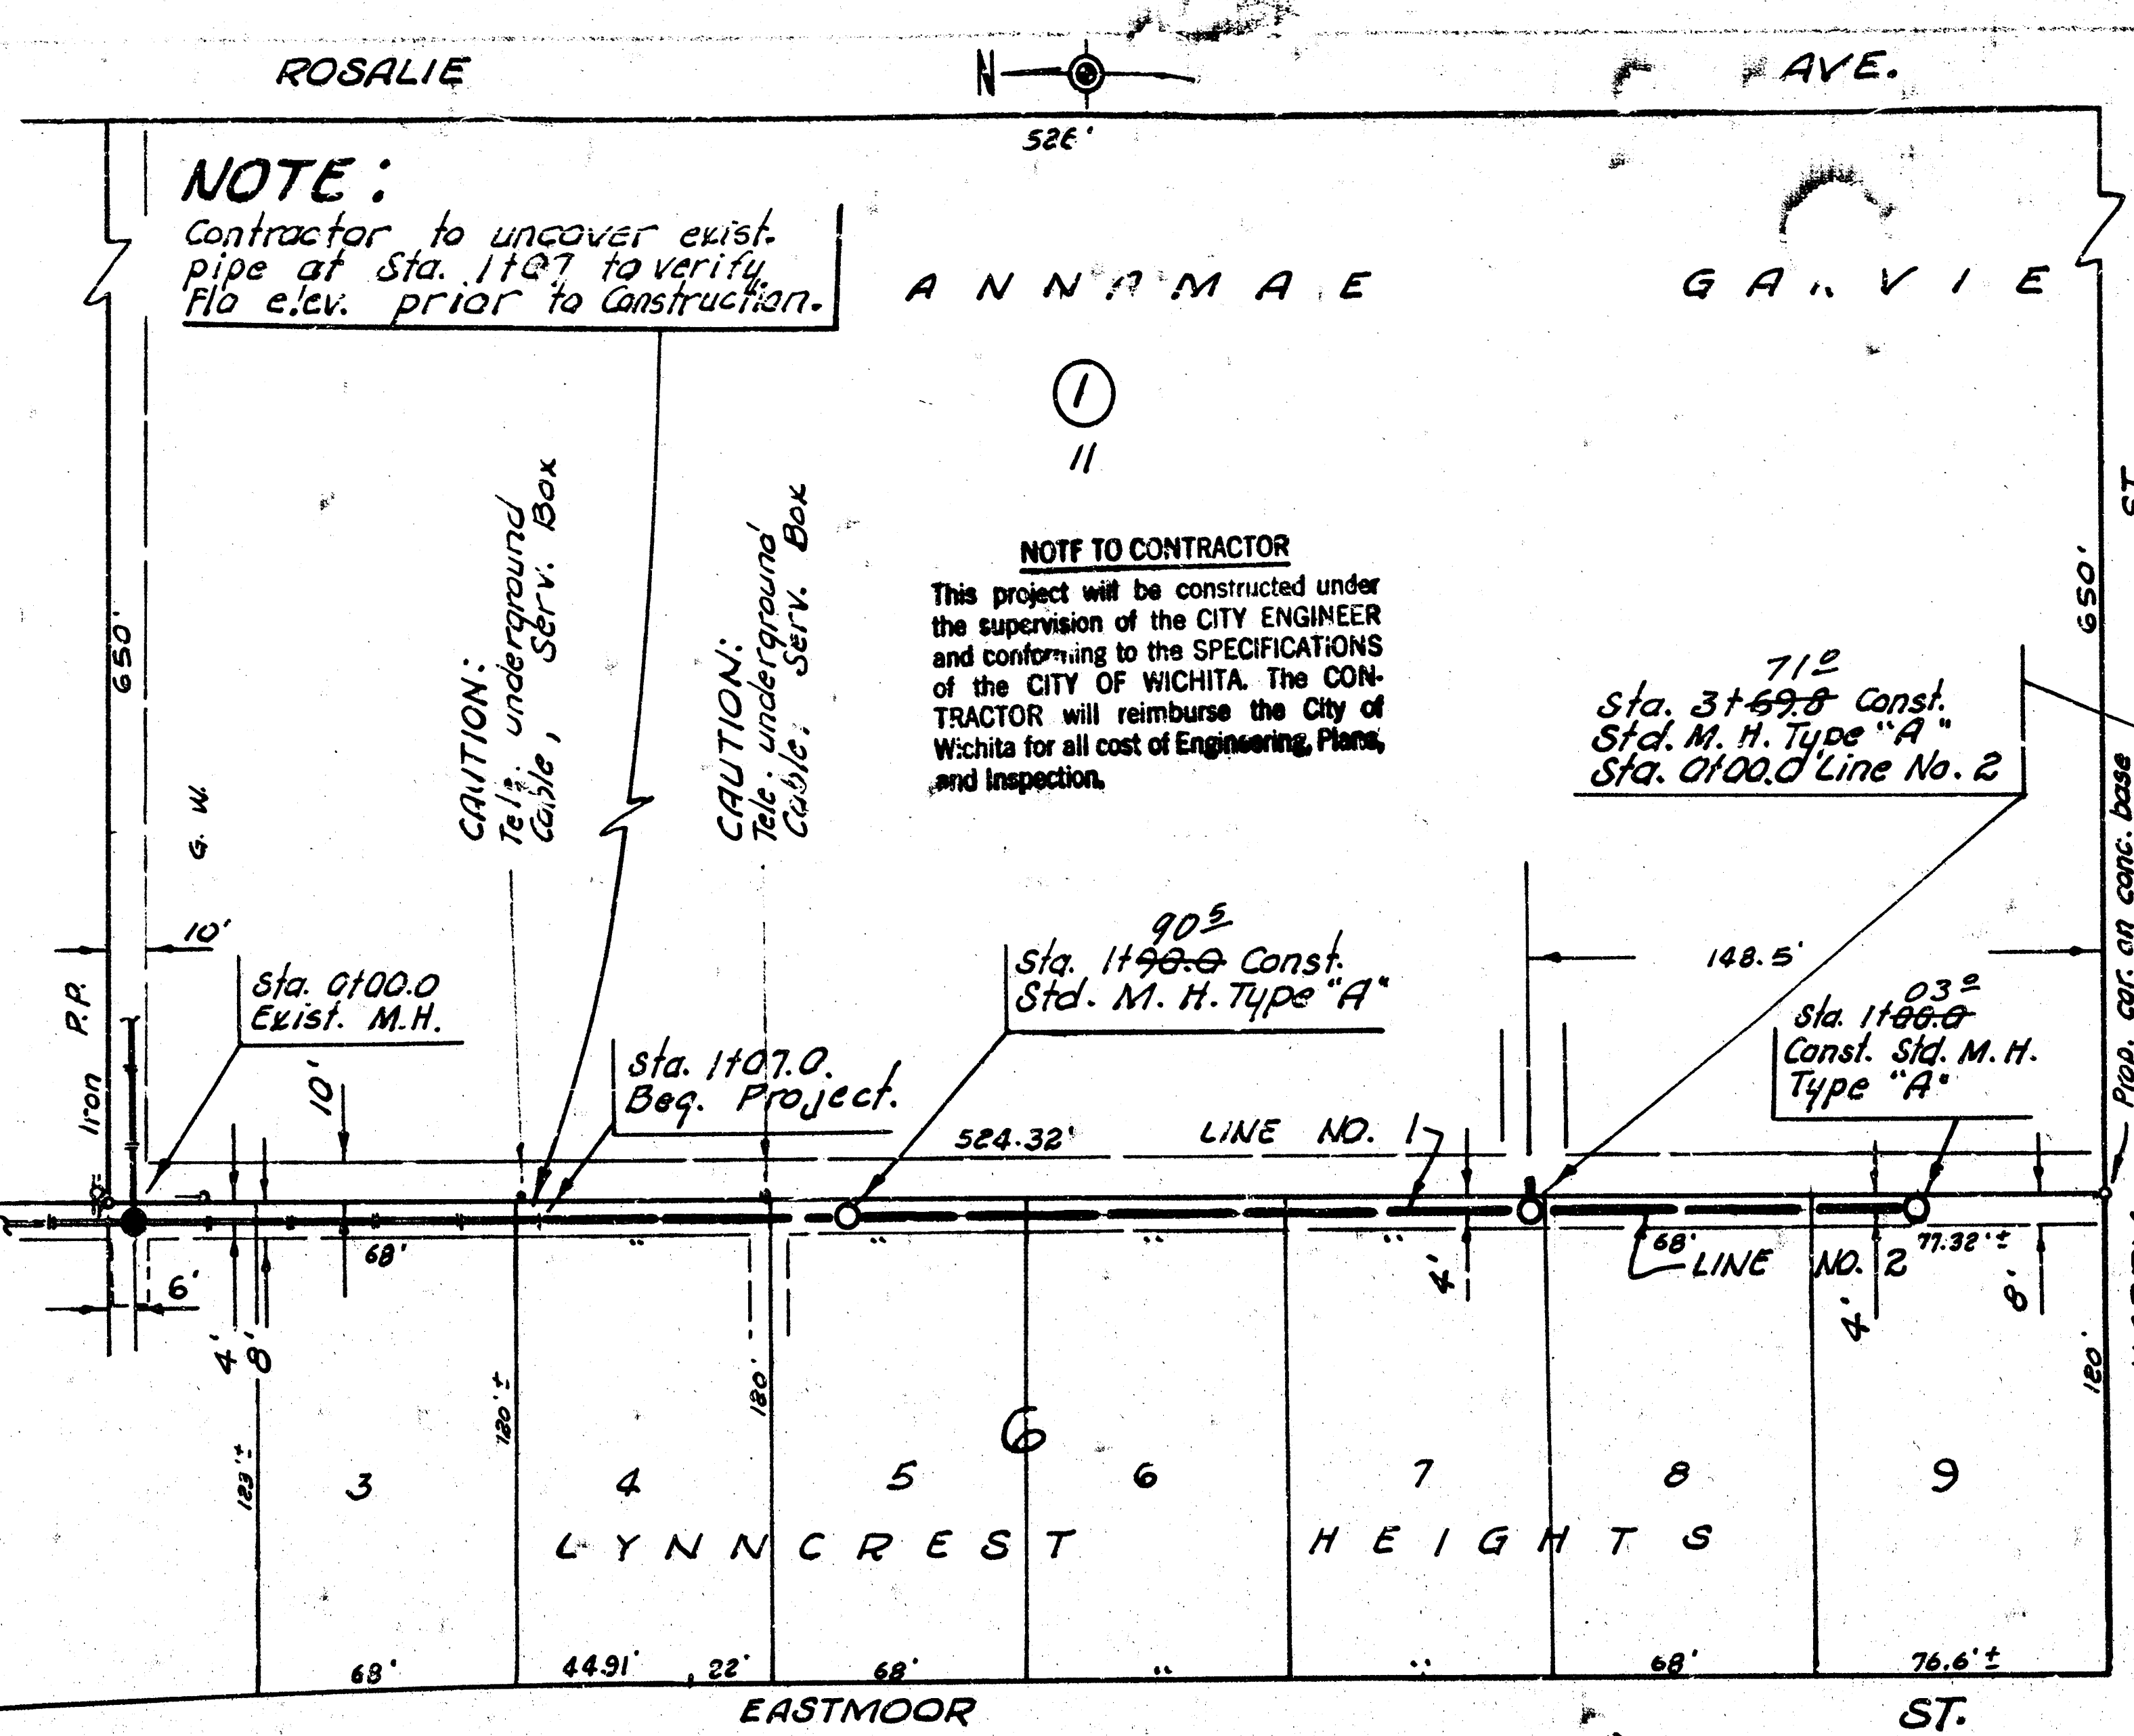

NOTE TO CONTRACTOR
This project will be constructed under
the supervision of the CITY ENGINEER
and conforming to the SPECIFICATIONS
of the CITY OF WICHITA. The CONTRACTOR
will reimburse the City of
Wichita for all cost of Engineering, Plans,
and Inspection.

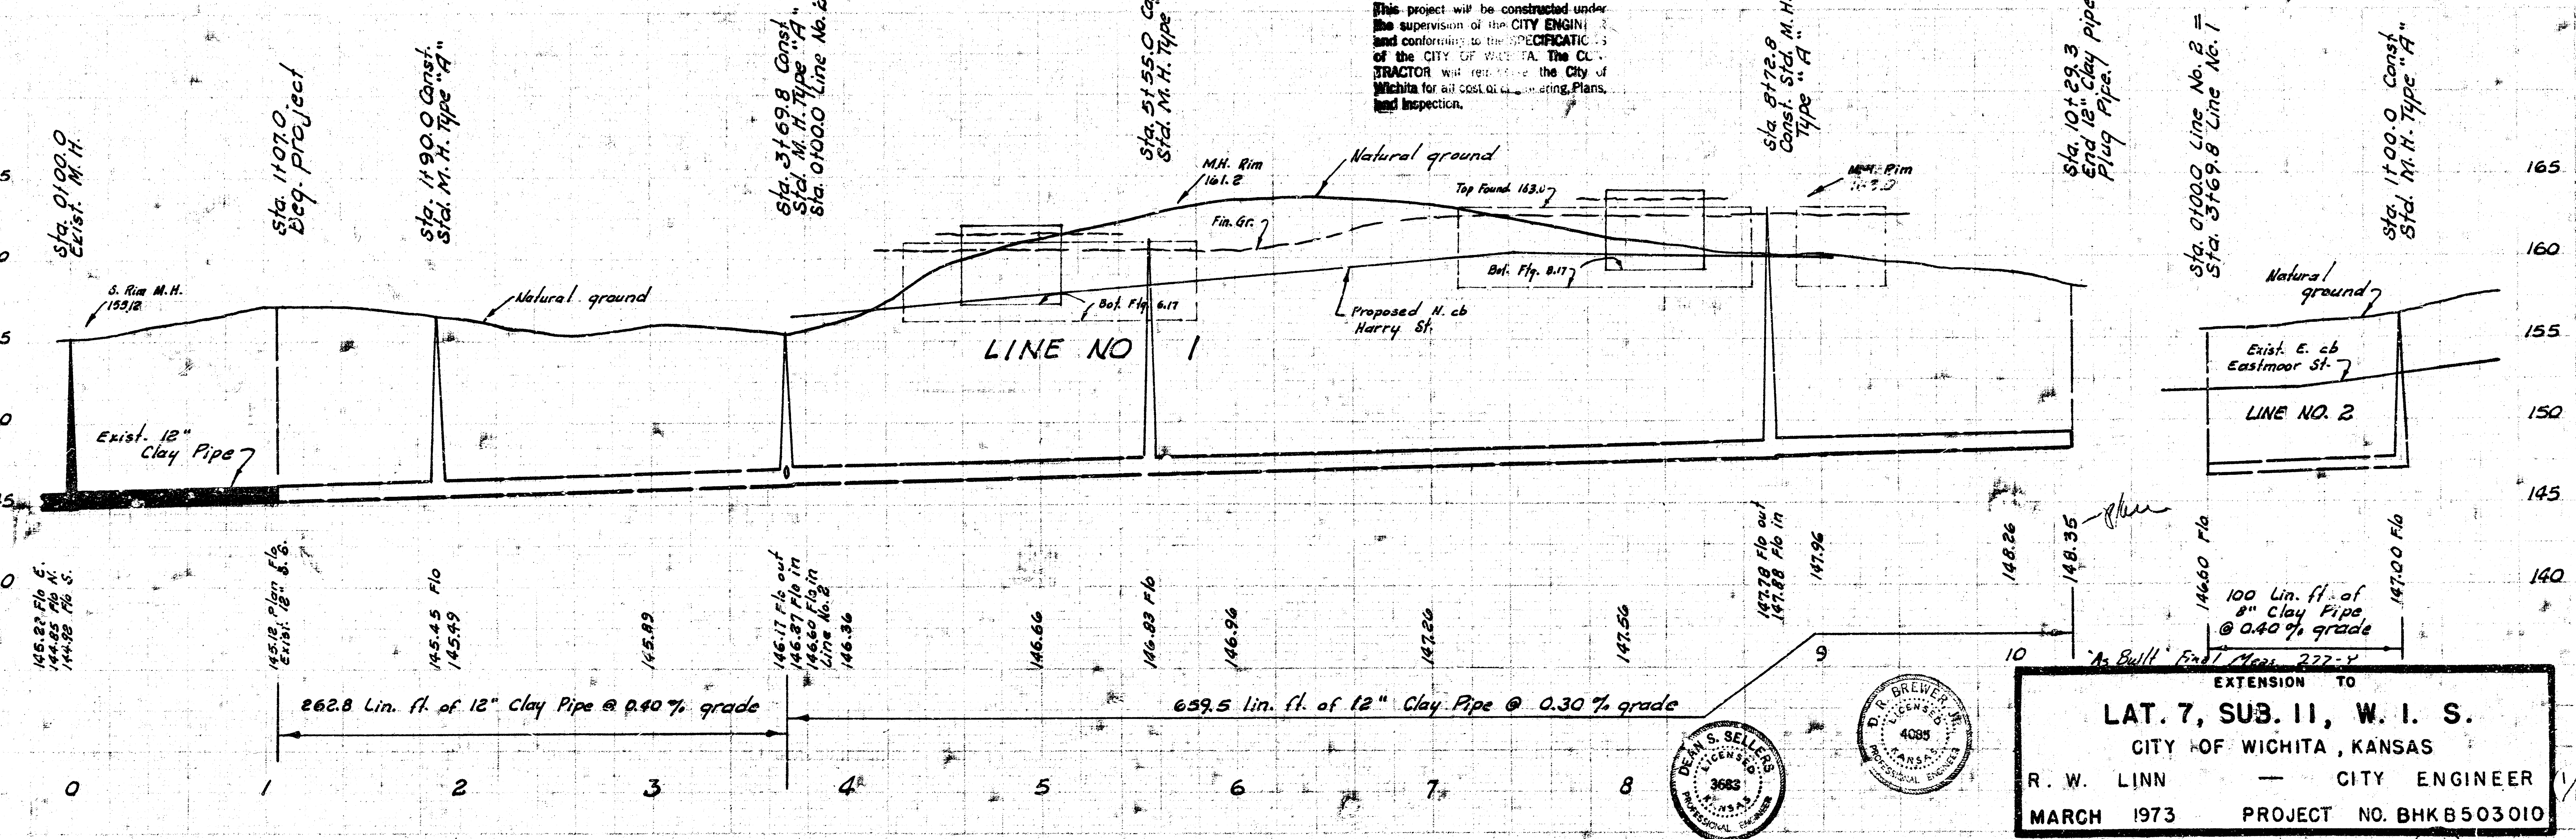

EXTENSION TO
LAT. 7, SUB. 11, W. I. S.
CITY OF WICHITA, KANSAS
R. W. LINN — CITY ENGINEER
MARCH 1973 PROJECT NO. BHK B503010