Survey By V. Traylor Book K-78
Extent By O. Stanley Date
Checked By J. Lange Date

PAGENT LANE

ROCKWOOD SECOND

19

STA. 2+90 CONST. STD. M.H.

STA. 5+80 CONST. STD. M.H.

STA. 8+72 CONST. STD. M.H. CONST. STUB S.

ROAD

POSTOAK


STA. 0+00 EXIST. DROP M.H. EXIST. STUB

11 12 13 14 15 16 17 ADDN. 18

ROCKWOOD ROAD

PLAN SCALE 1"=40'
PROFILE SCALE 1"=40' HOR.
1"=40' VERT.

B. M. 166.65 "R" IN RITCHIE W. END RAD. N. S. TANGLEWOOD W. L. PLAZA LANE
B.M. 159.80 CITY B.M. DISC. S. E. COR. R.C.B.C. CENTRAL

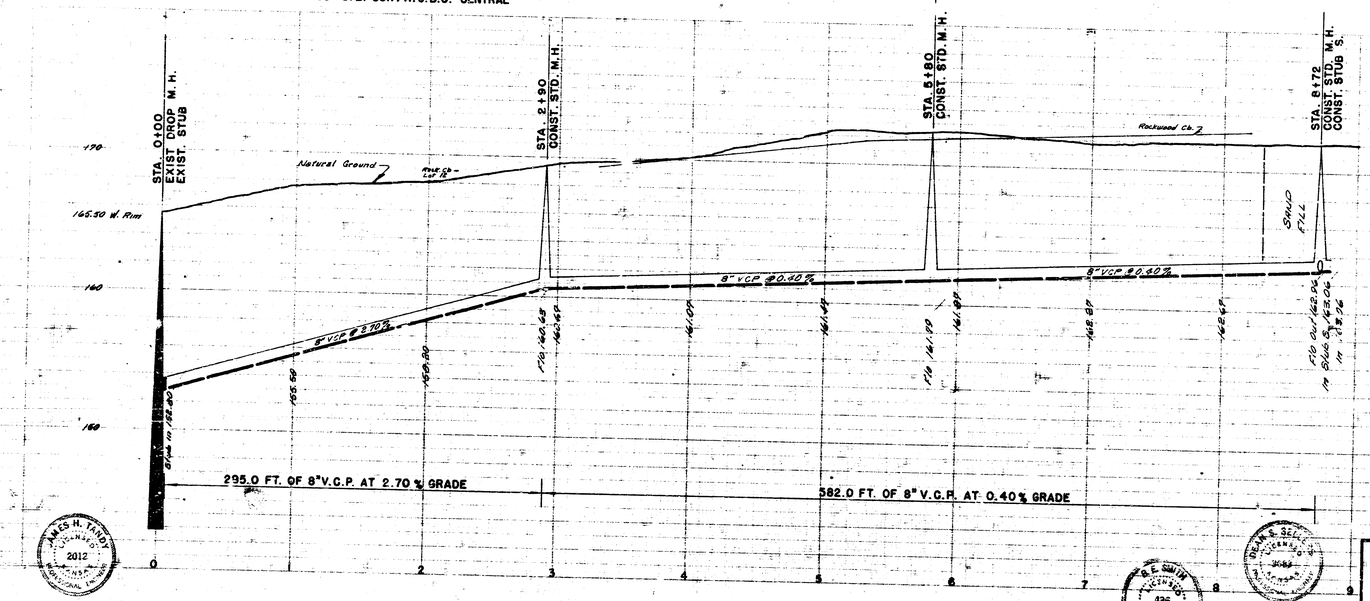


JAMES H. TANEY NUMBER 2012 REGISTERED PROFESSIONAL ENGINEER


P. E. SMITH NUMBER 436 KANSAS REGISTERED PROFESSIONAL ENGINEER

DEAN S. SELL NUMBER 3582 REGISTERED PROFESSIONAL ENGINEER

1/2

LAT. 1, SUB. 12, W.I.S.
CITY OF WICHITA, KANSAS
S.E. SMITH, CITY ENGINEER
PROJ. NO. C23-20 DATE MAY 1963

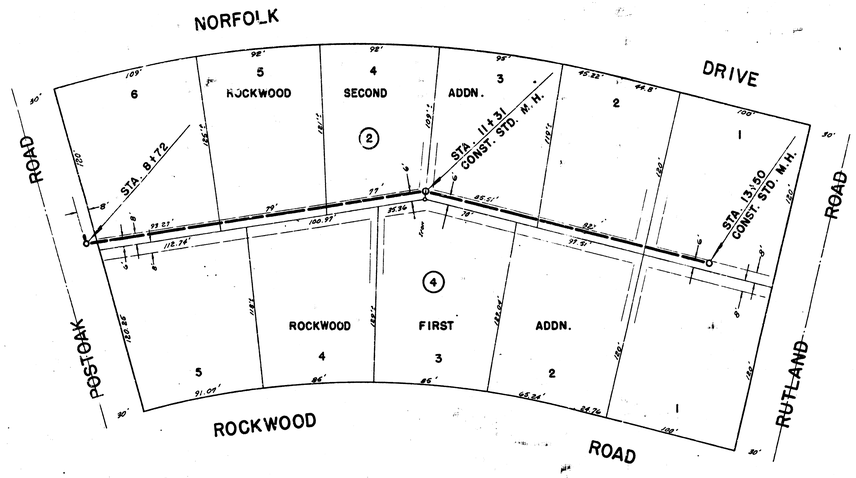

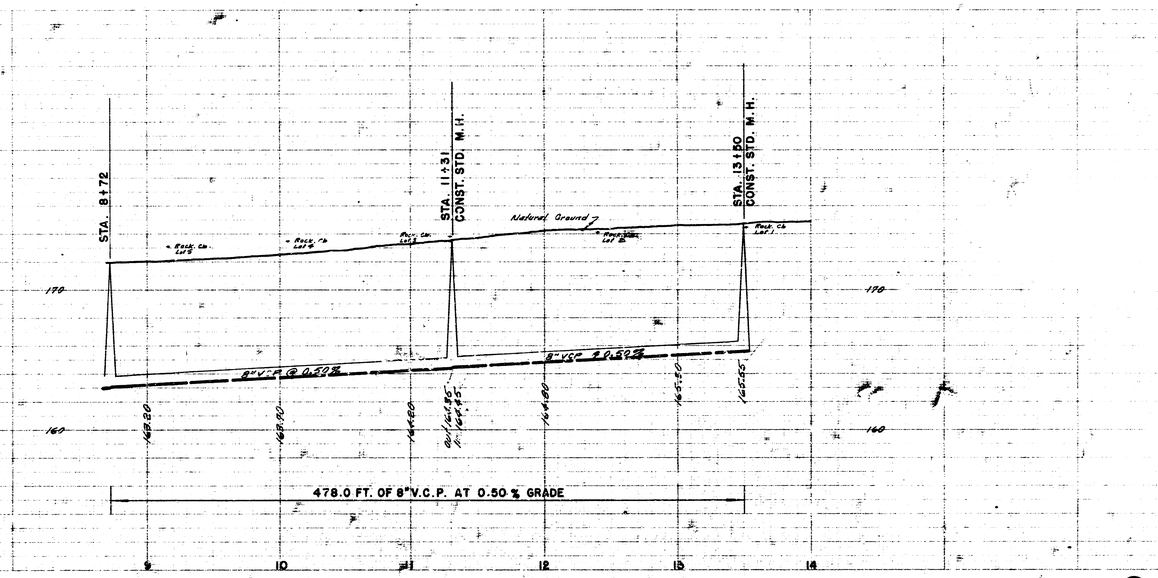

LAT. 1, SUB. 12, W.I.S.

5 6 6 (13)