

Survey By V. Kimper Book K-78
Drawn By O. Cramer
Checked By A. Young Date

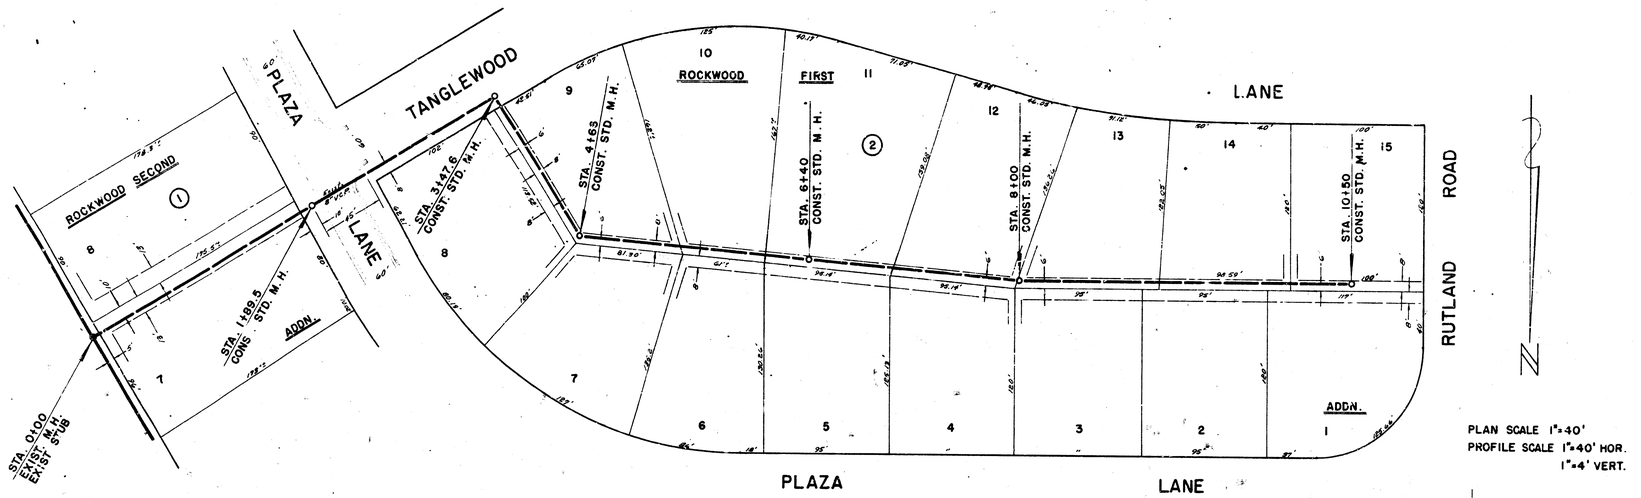

PLAN SCALE 1"=40'
PROFILE SCALE 1"=40' HOR.
1"=4' VERT.

B.M. 166.65 "R" IN RITCHIE W. END RAD. N. SIDE TANGLEWOOD W.L. PLAZA LANE
B.M. 159.80 CITY B.M. DISC S.E. COR. R.C.B.C. CENTRAL

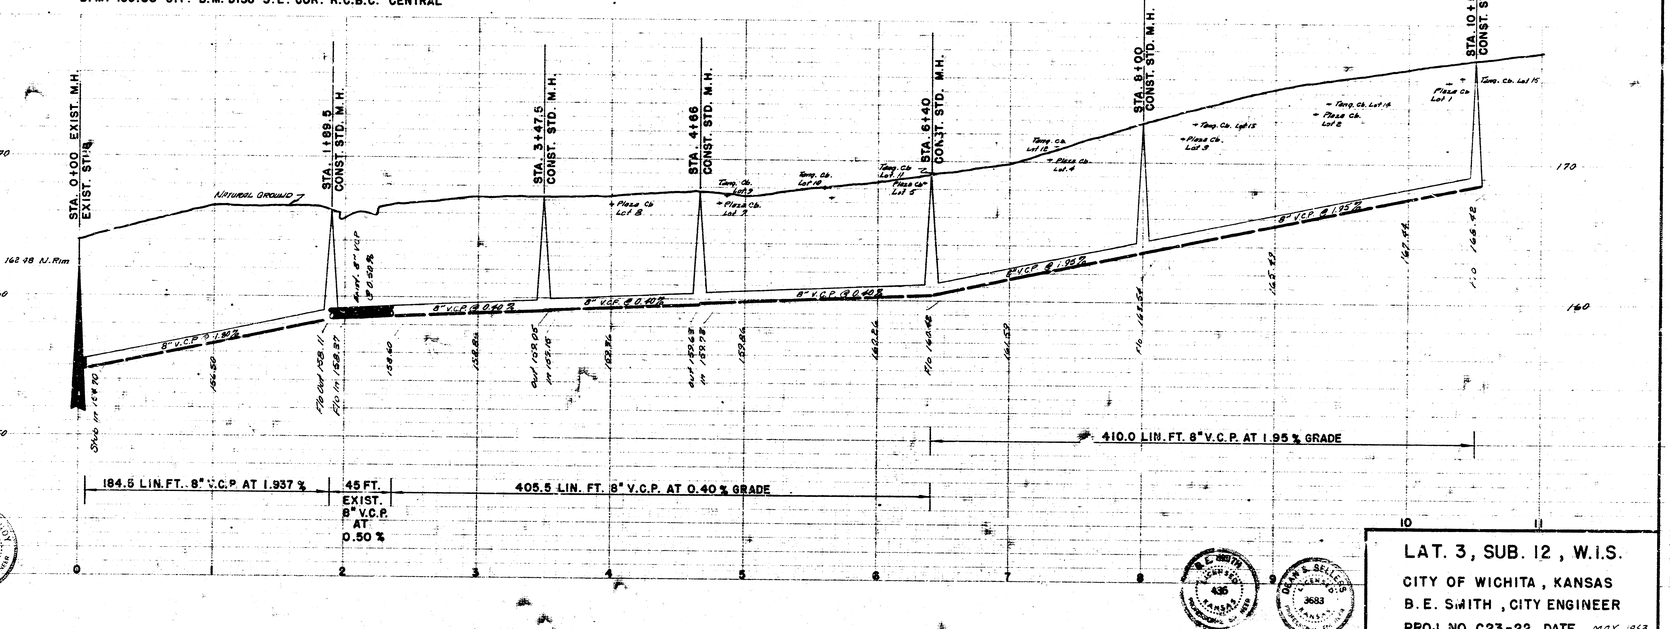

LAT. 3, SUB. 12, W.I.S.
CITY OF WICHITA, KANSAS
B. E. SMITH, CITY ENGINEER
PROJ. NO. C23-22 DATE MAY 1953

9 9 5 (50)