





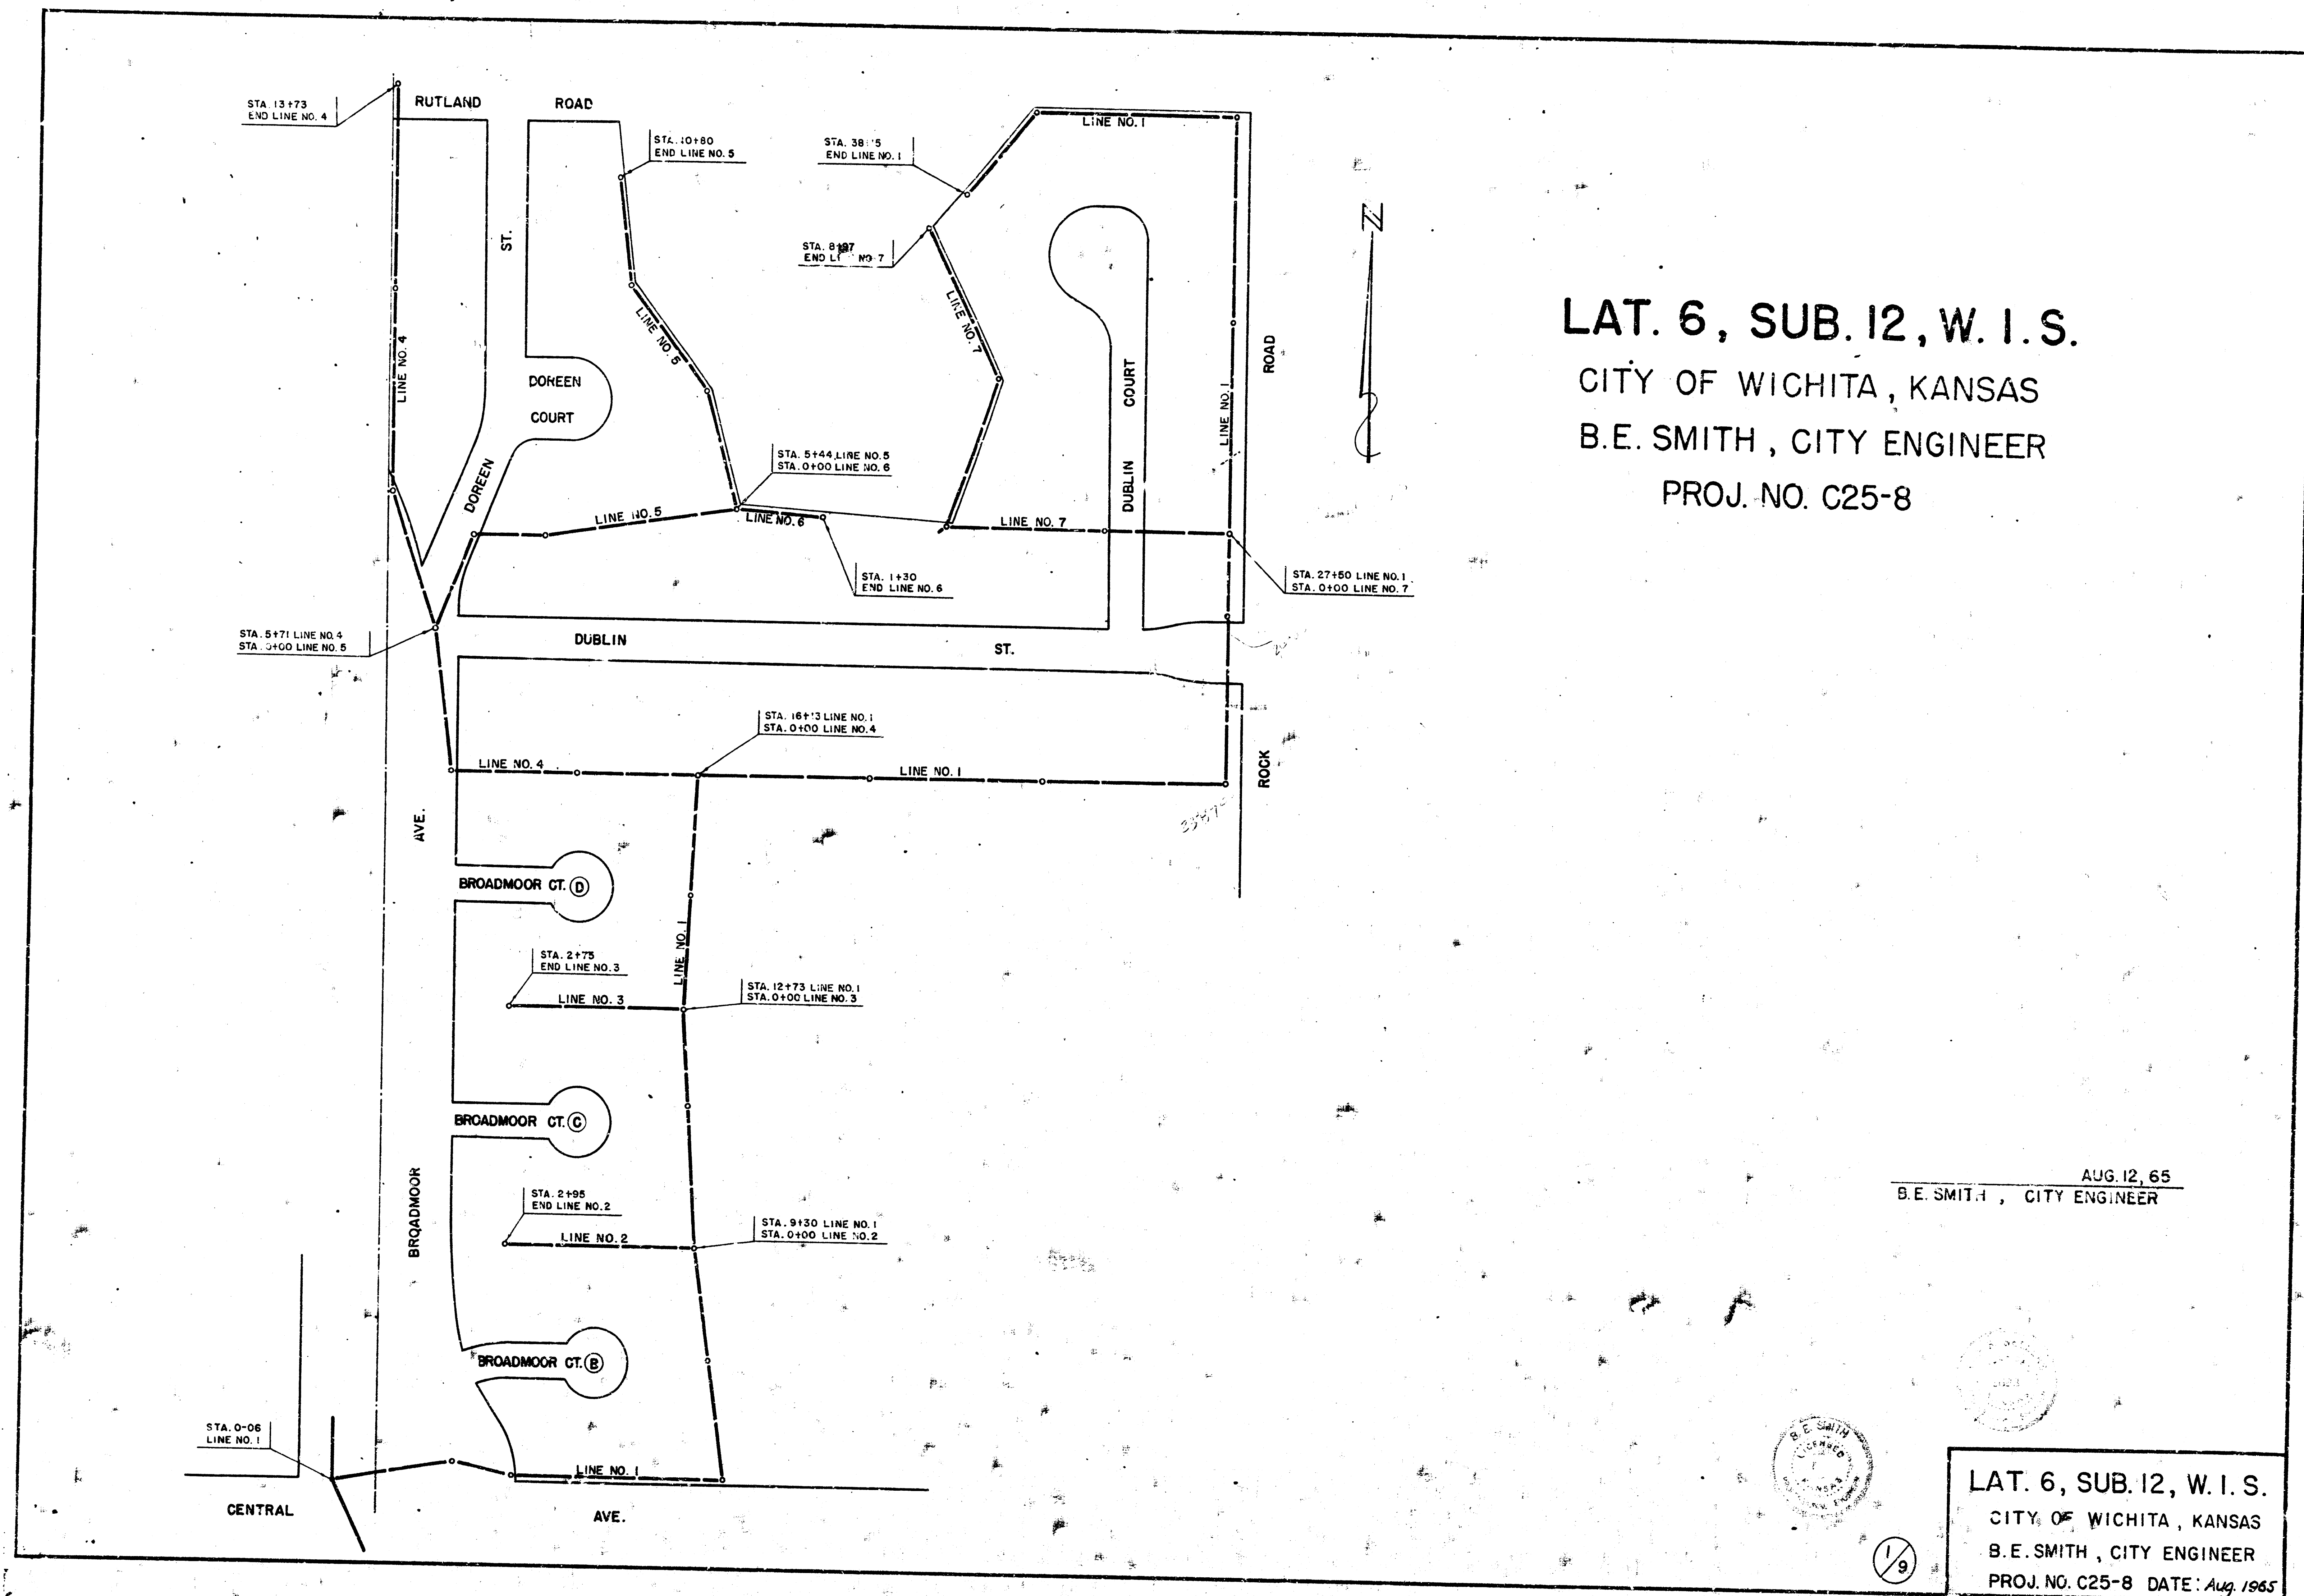


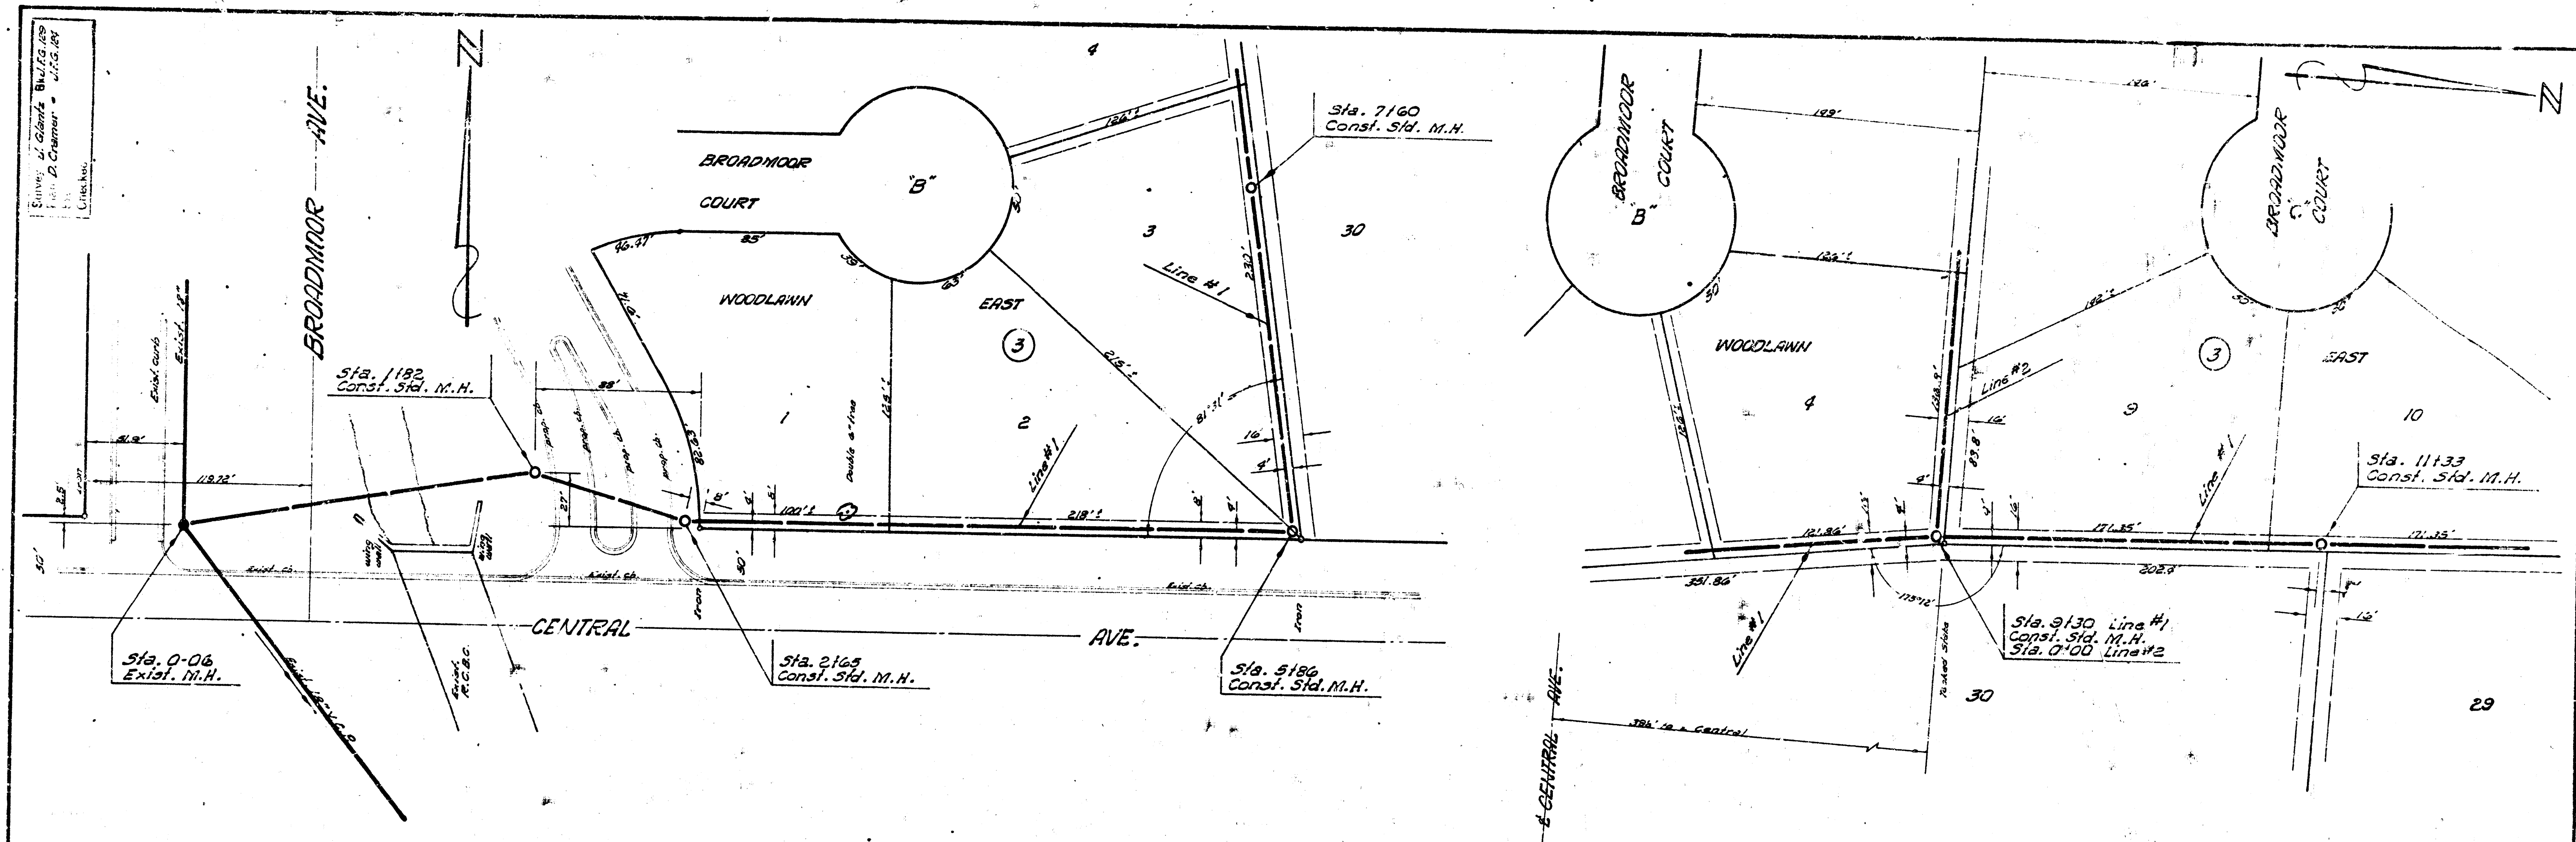


B. M. 159.92 City B. M. Disc. top hub guard E. end of S. Rail on R.C.B., E. of Broadmoor on Central


Plan Scale 1" = 40'
Profile Scale 1" = 40' Hor.
1" = 4' Vert.

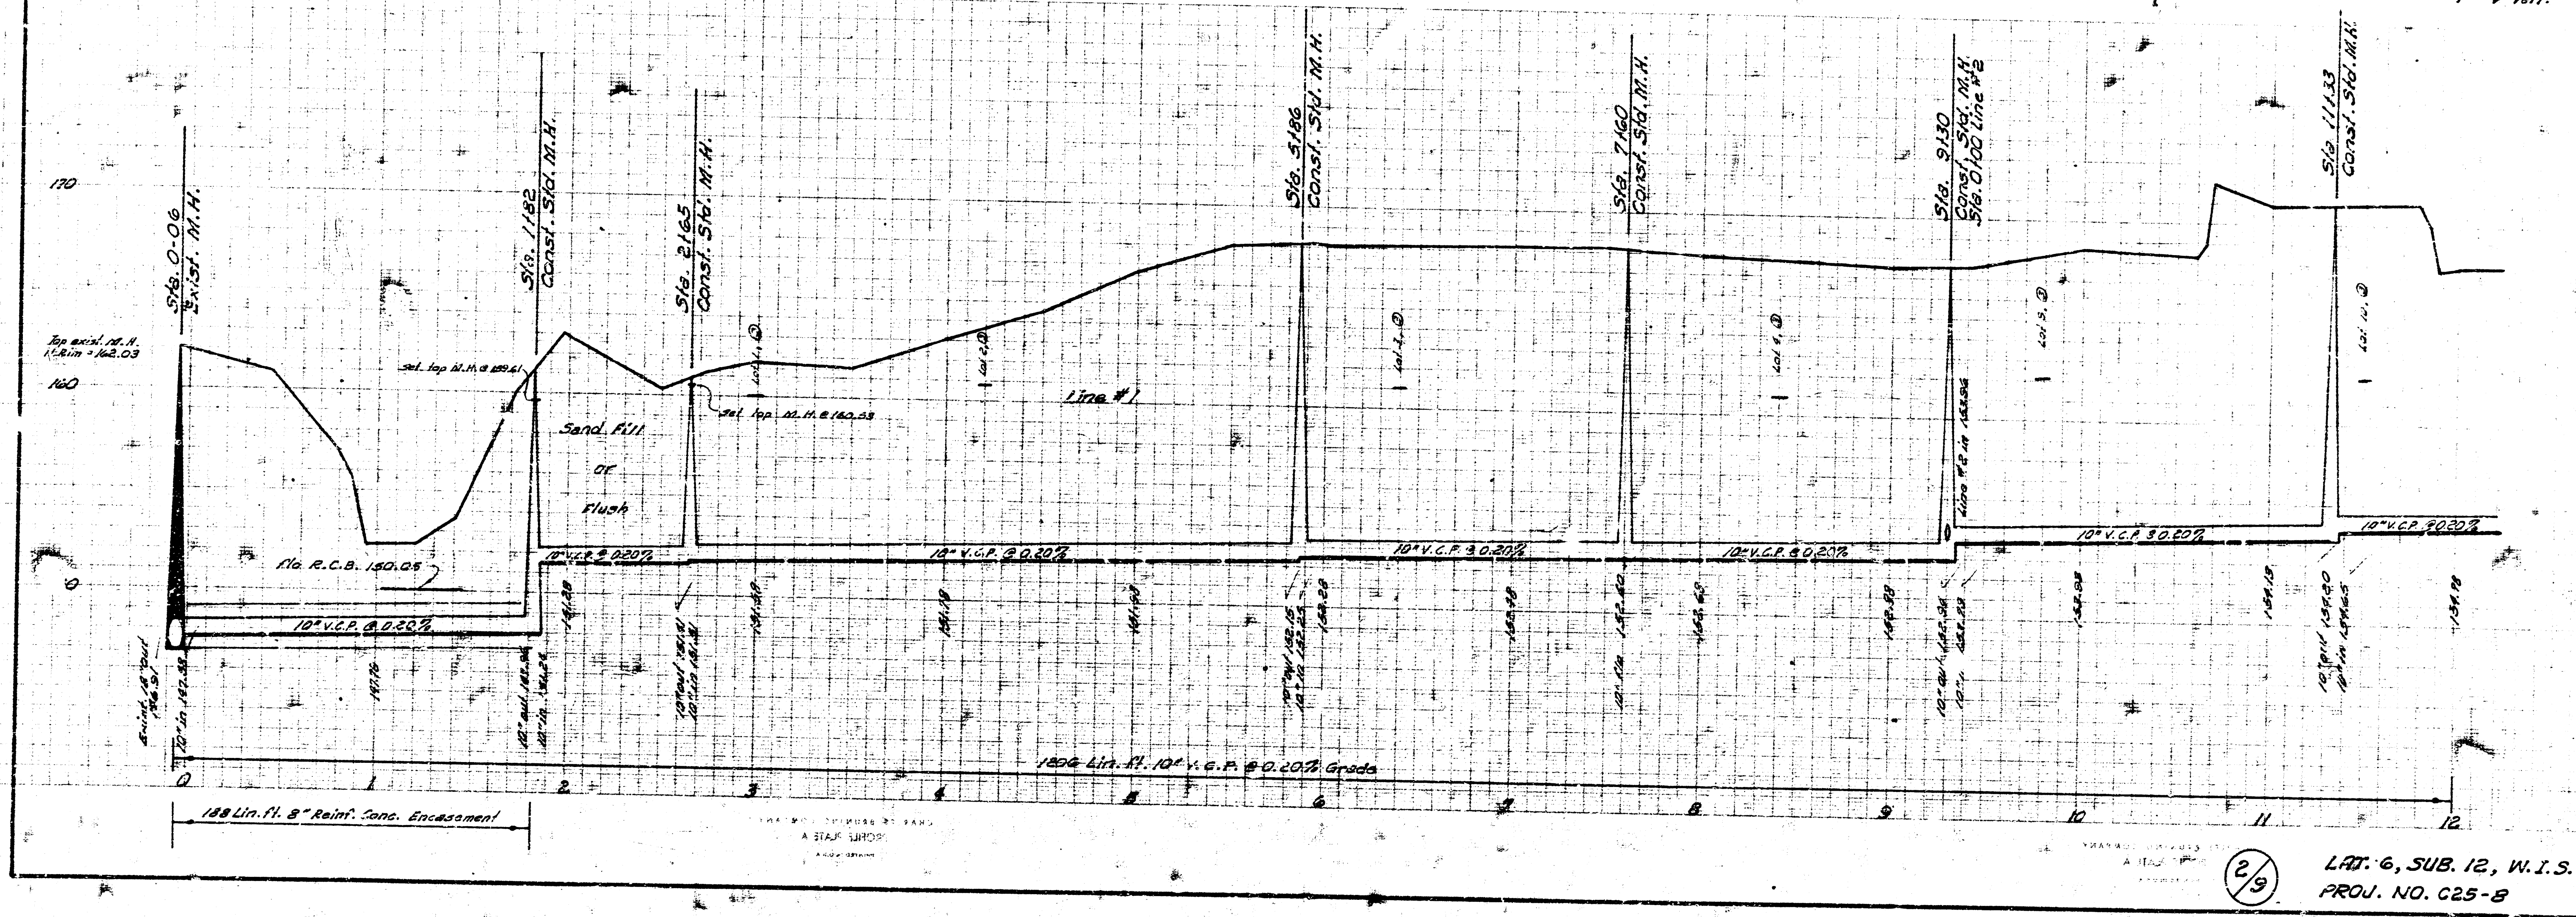


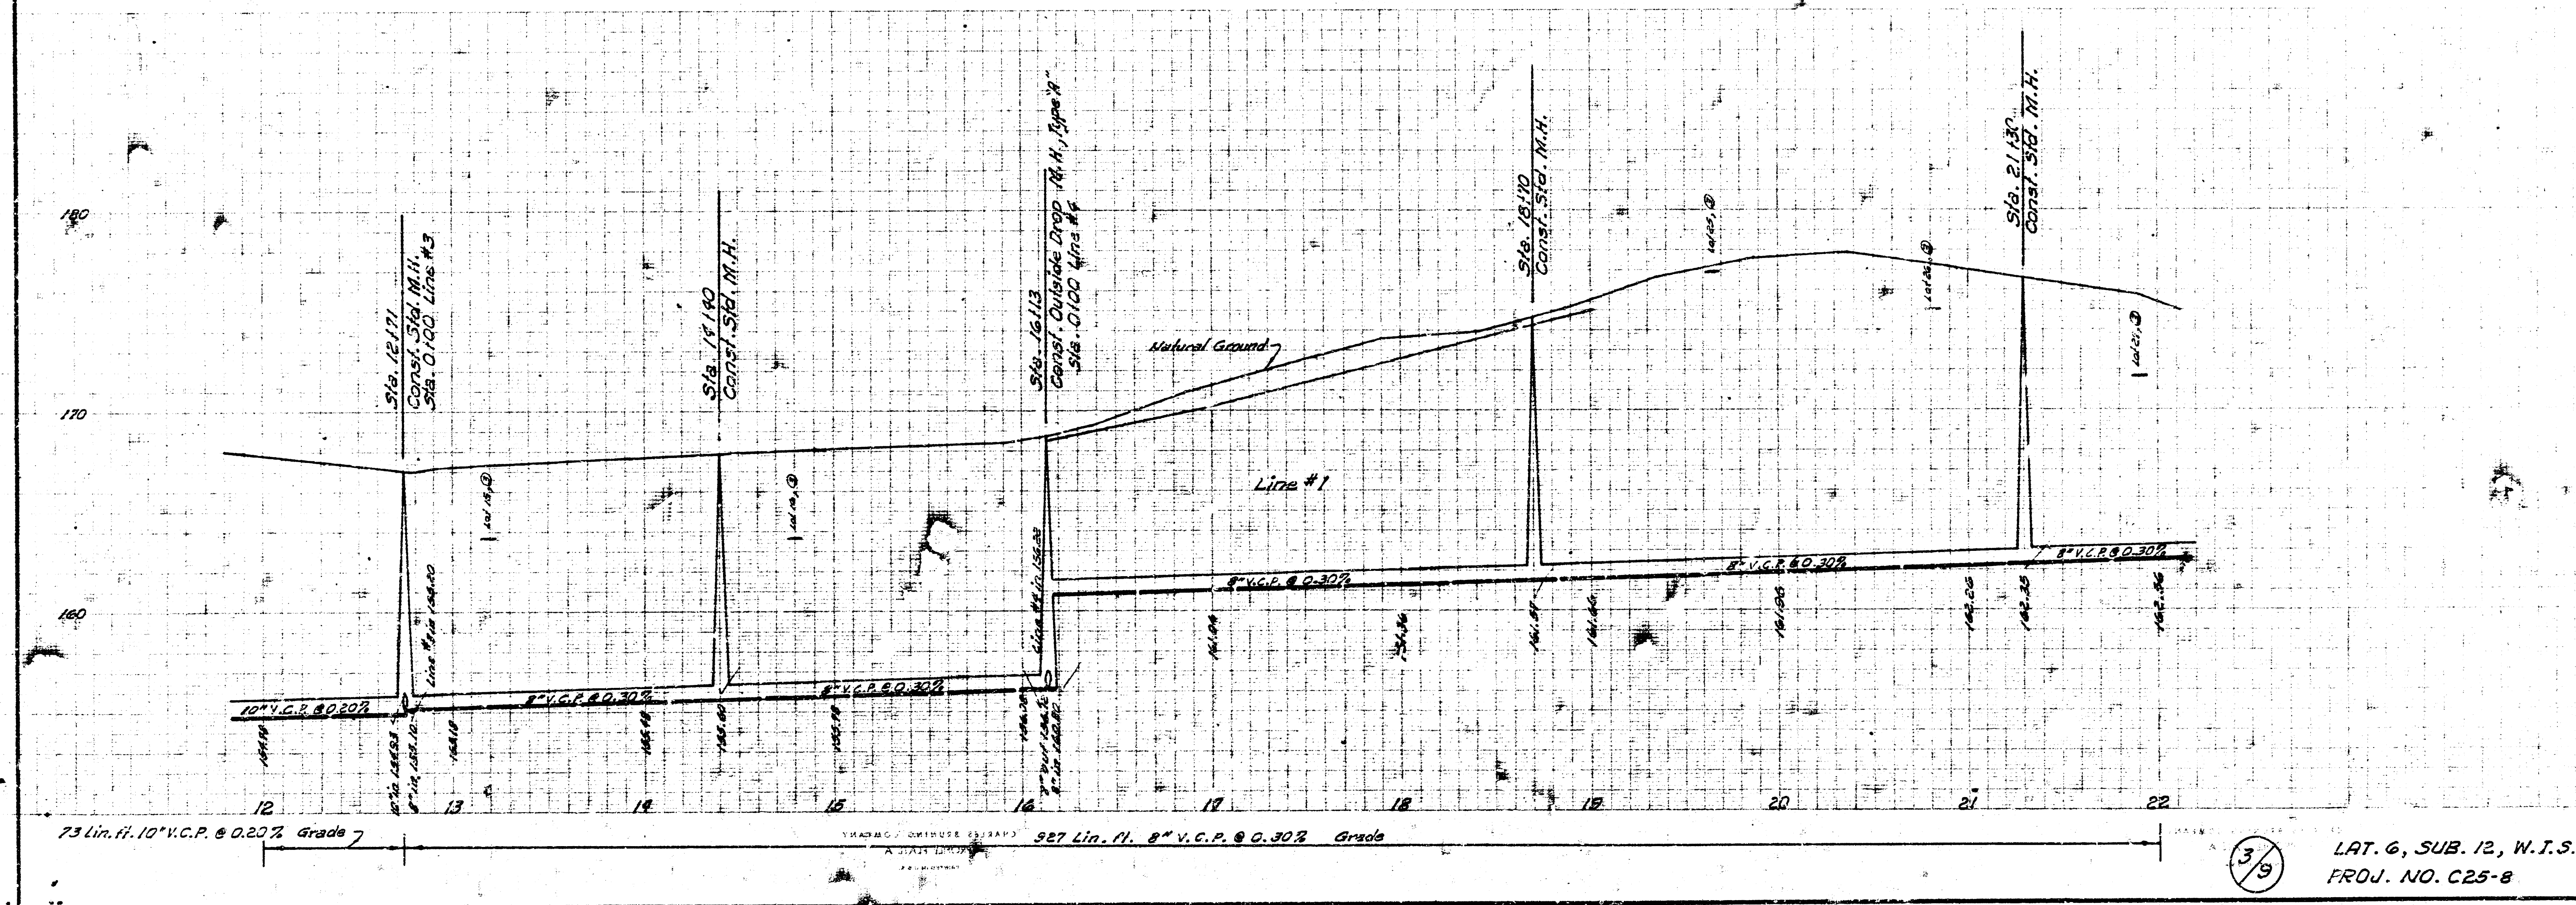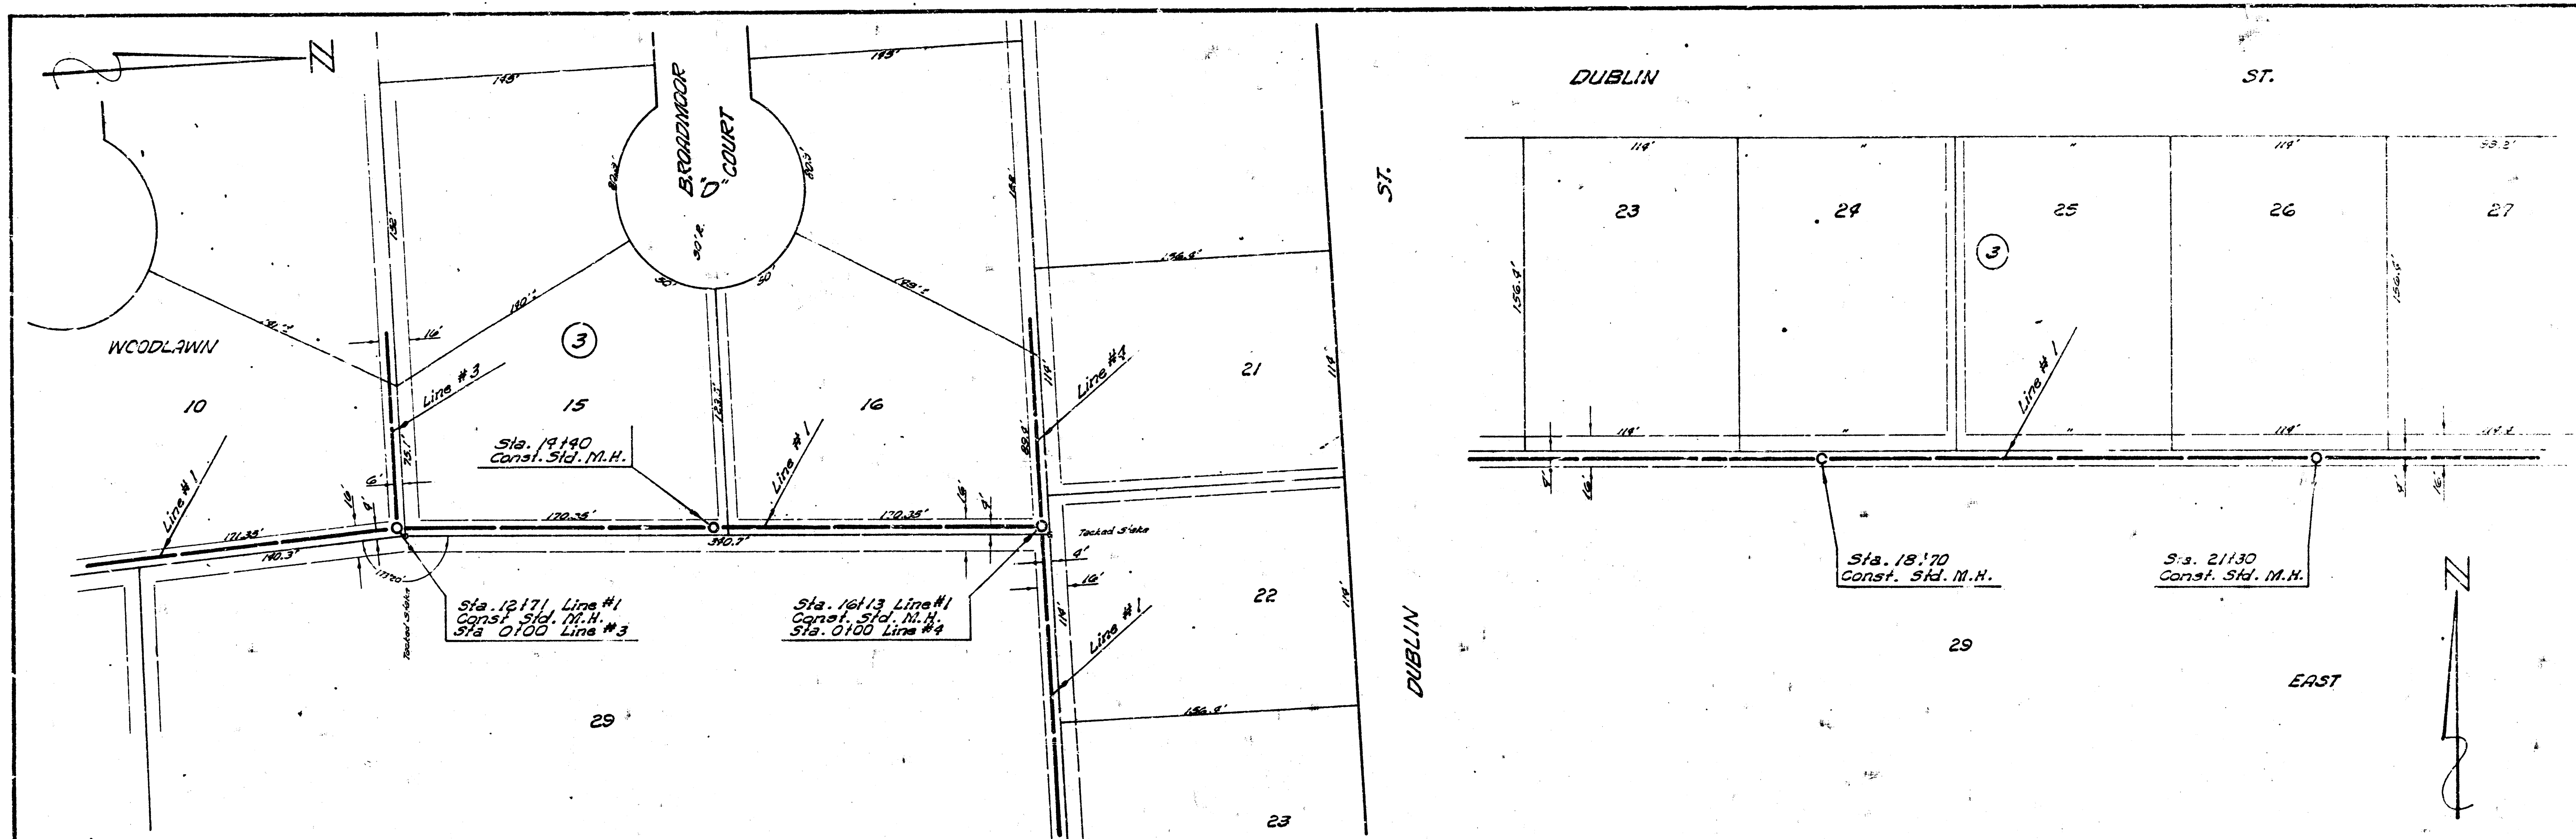



39
LAT. 6, SUB. 12, W.T.S.
PROJ. NO. C25-8

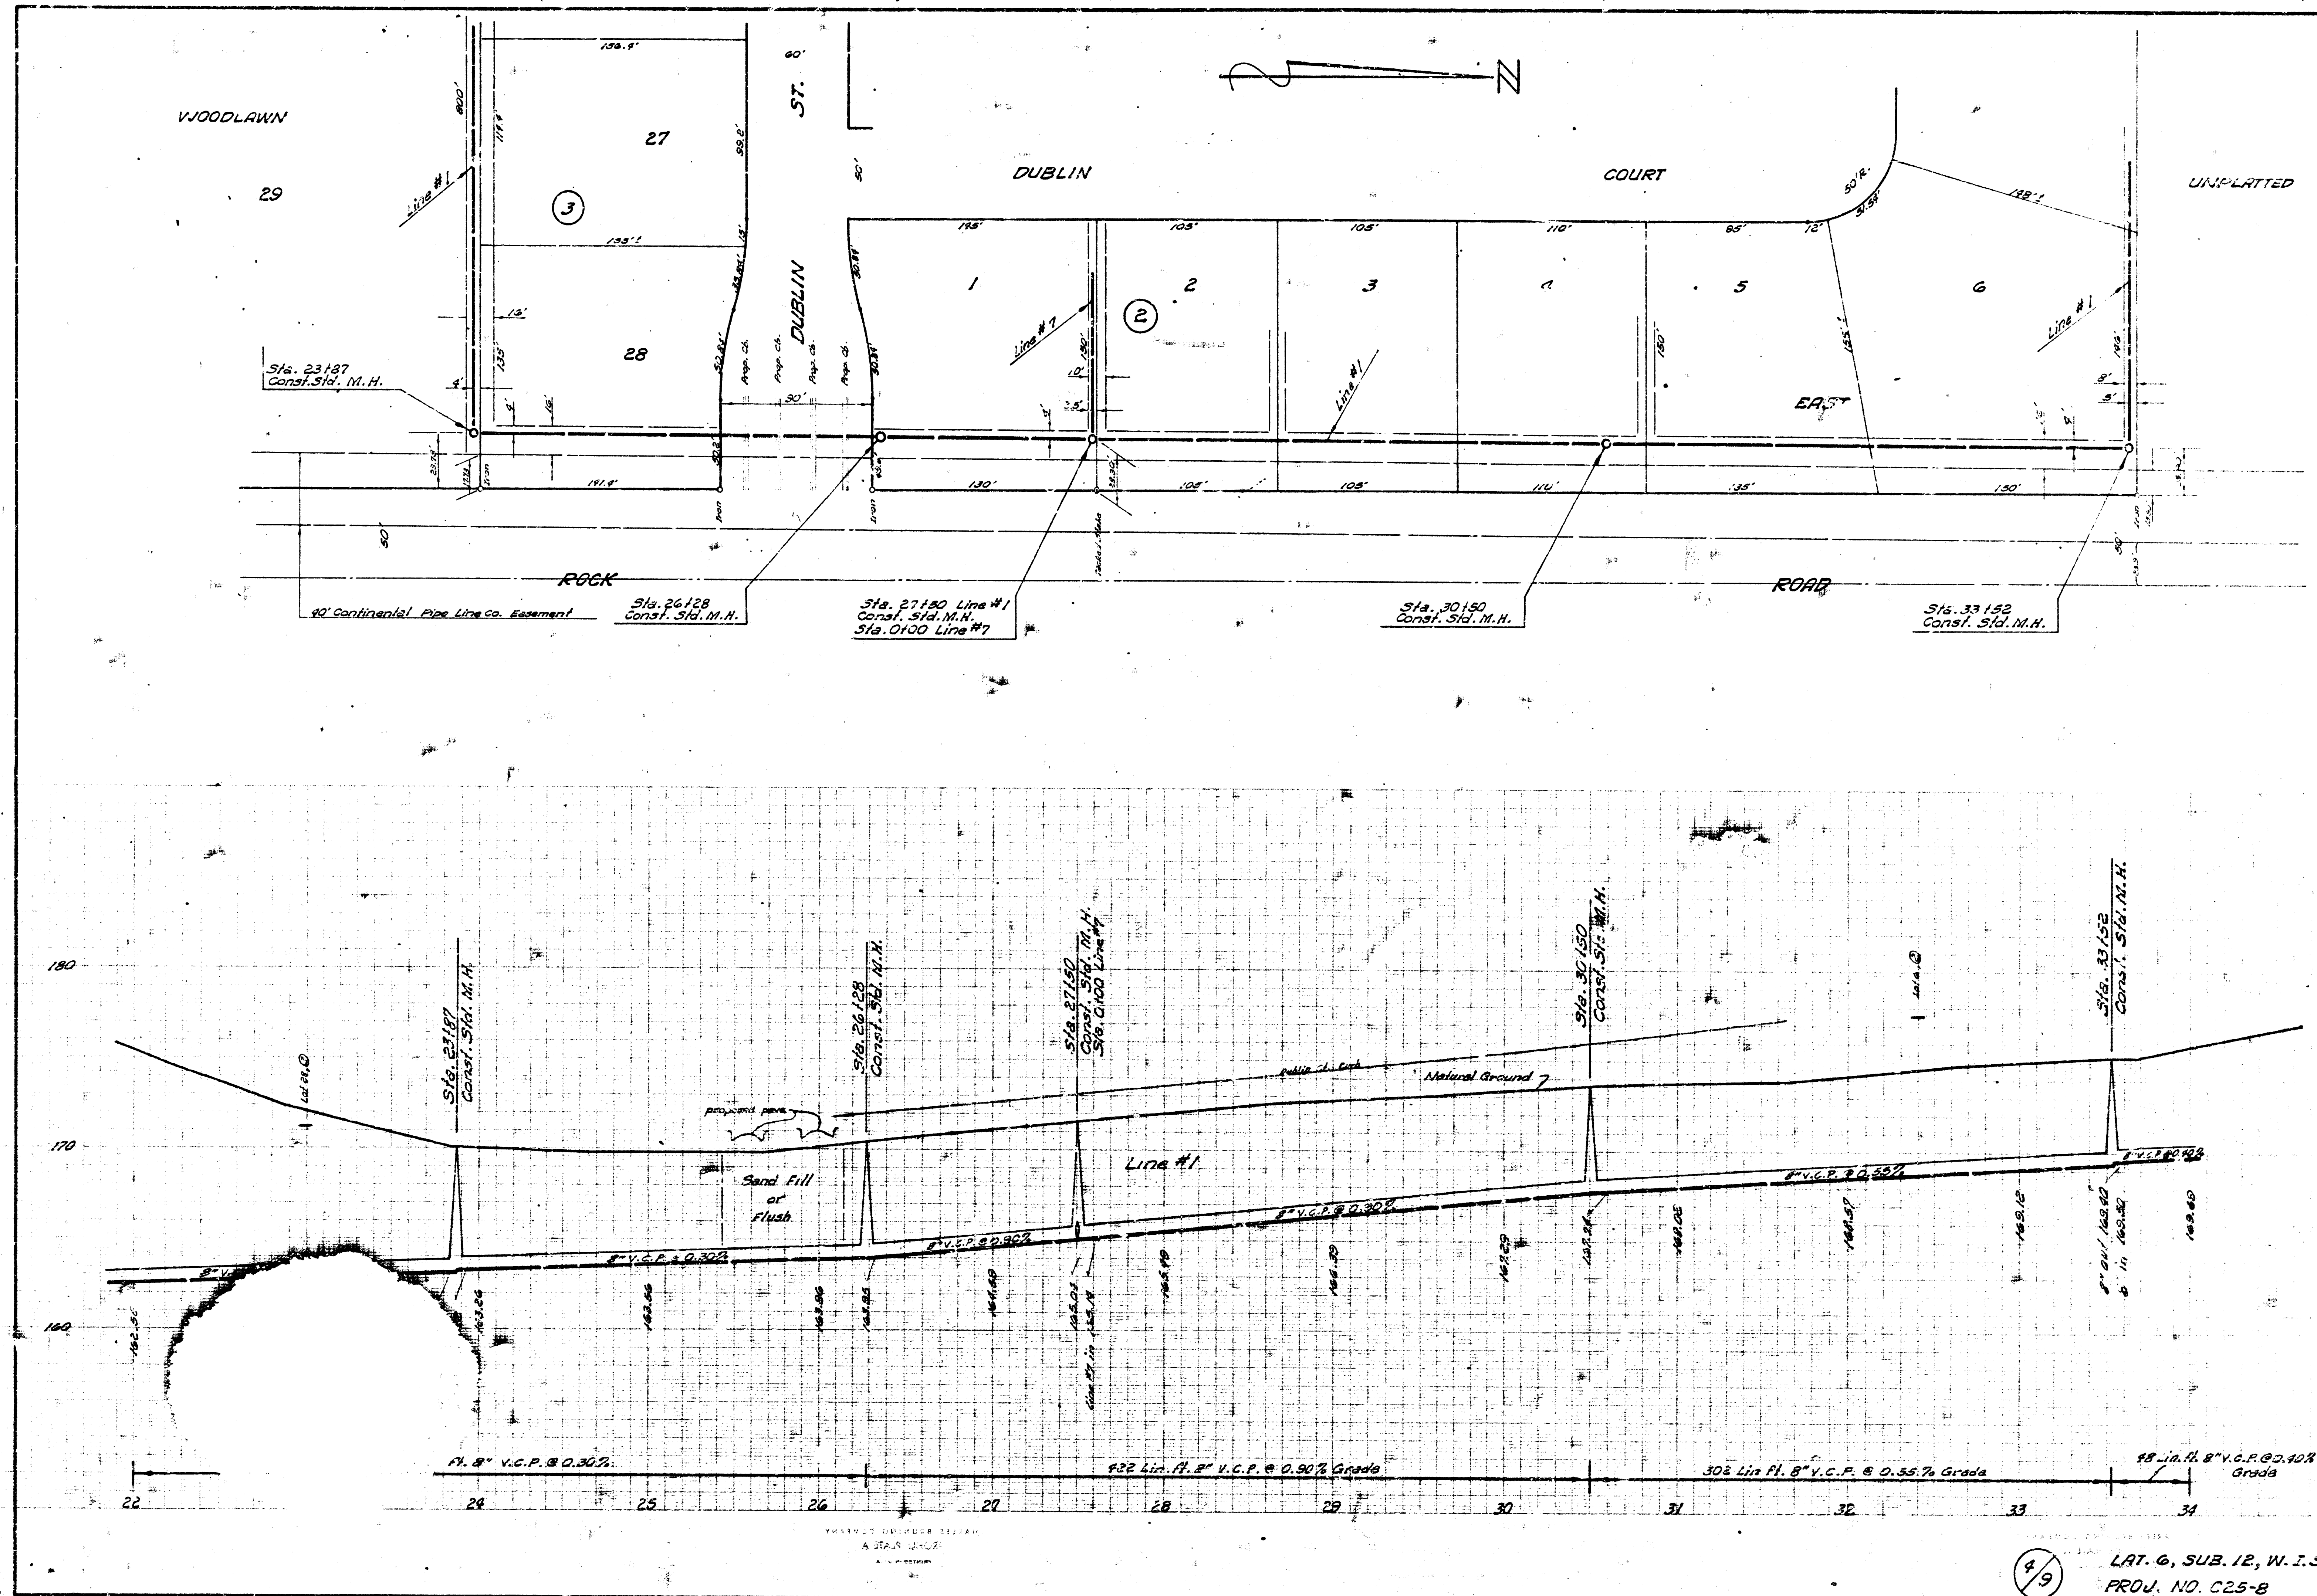


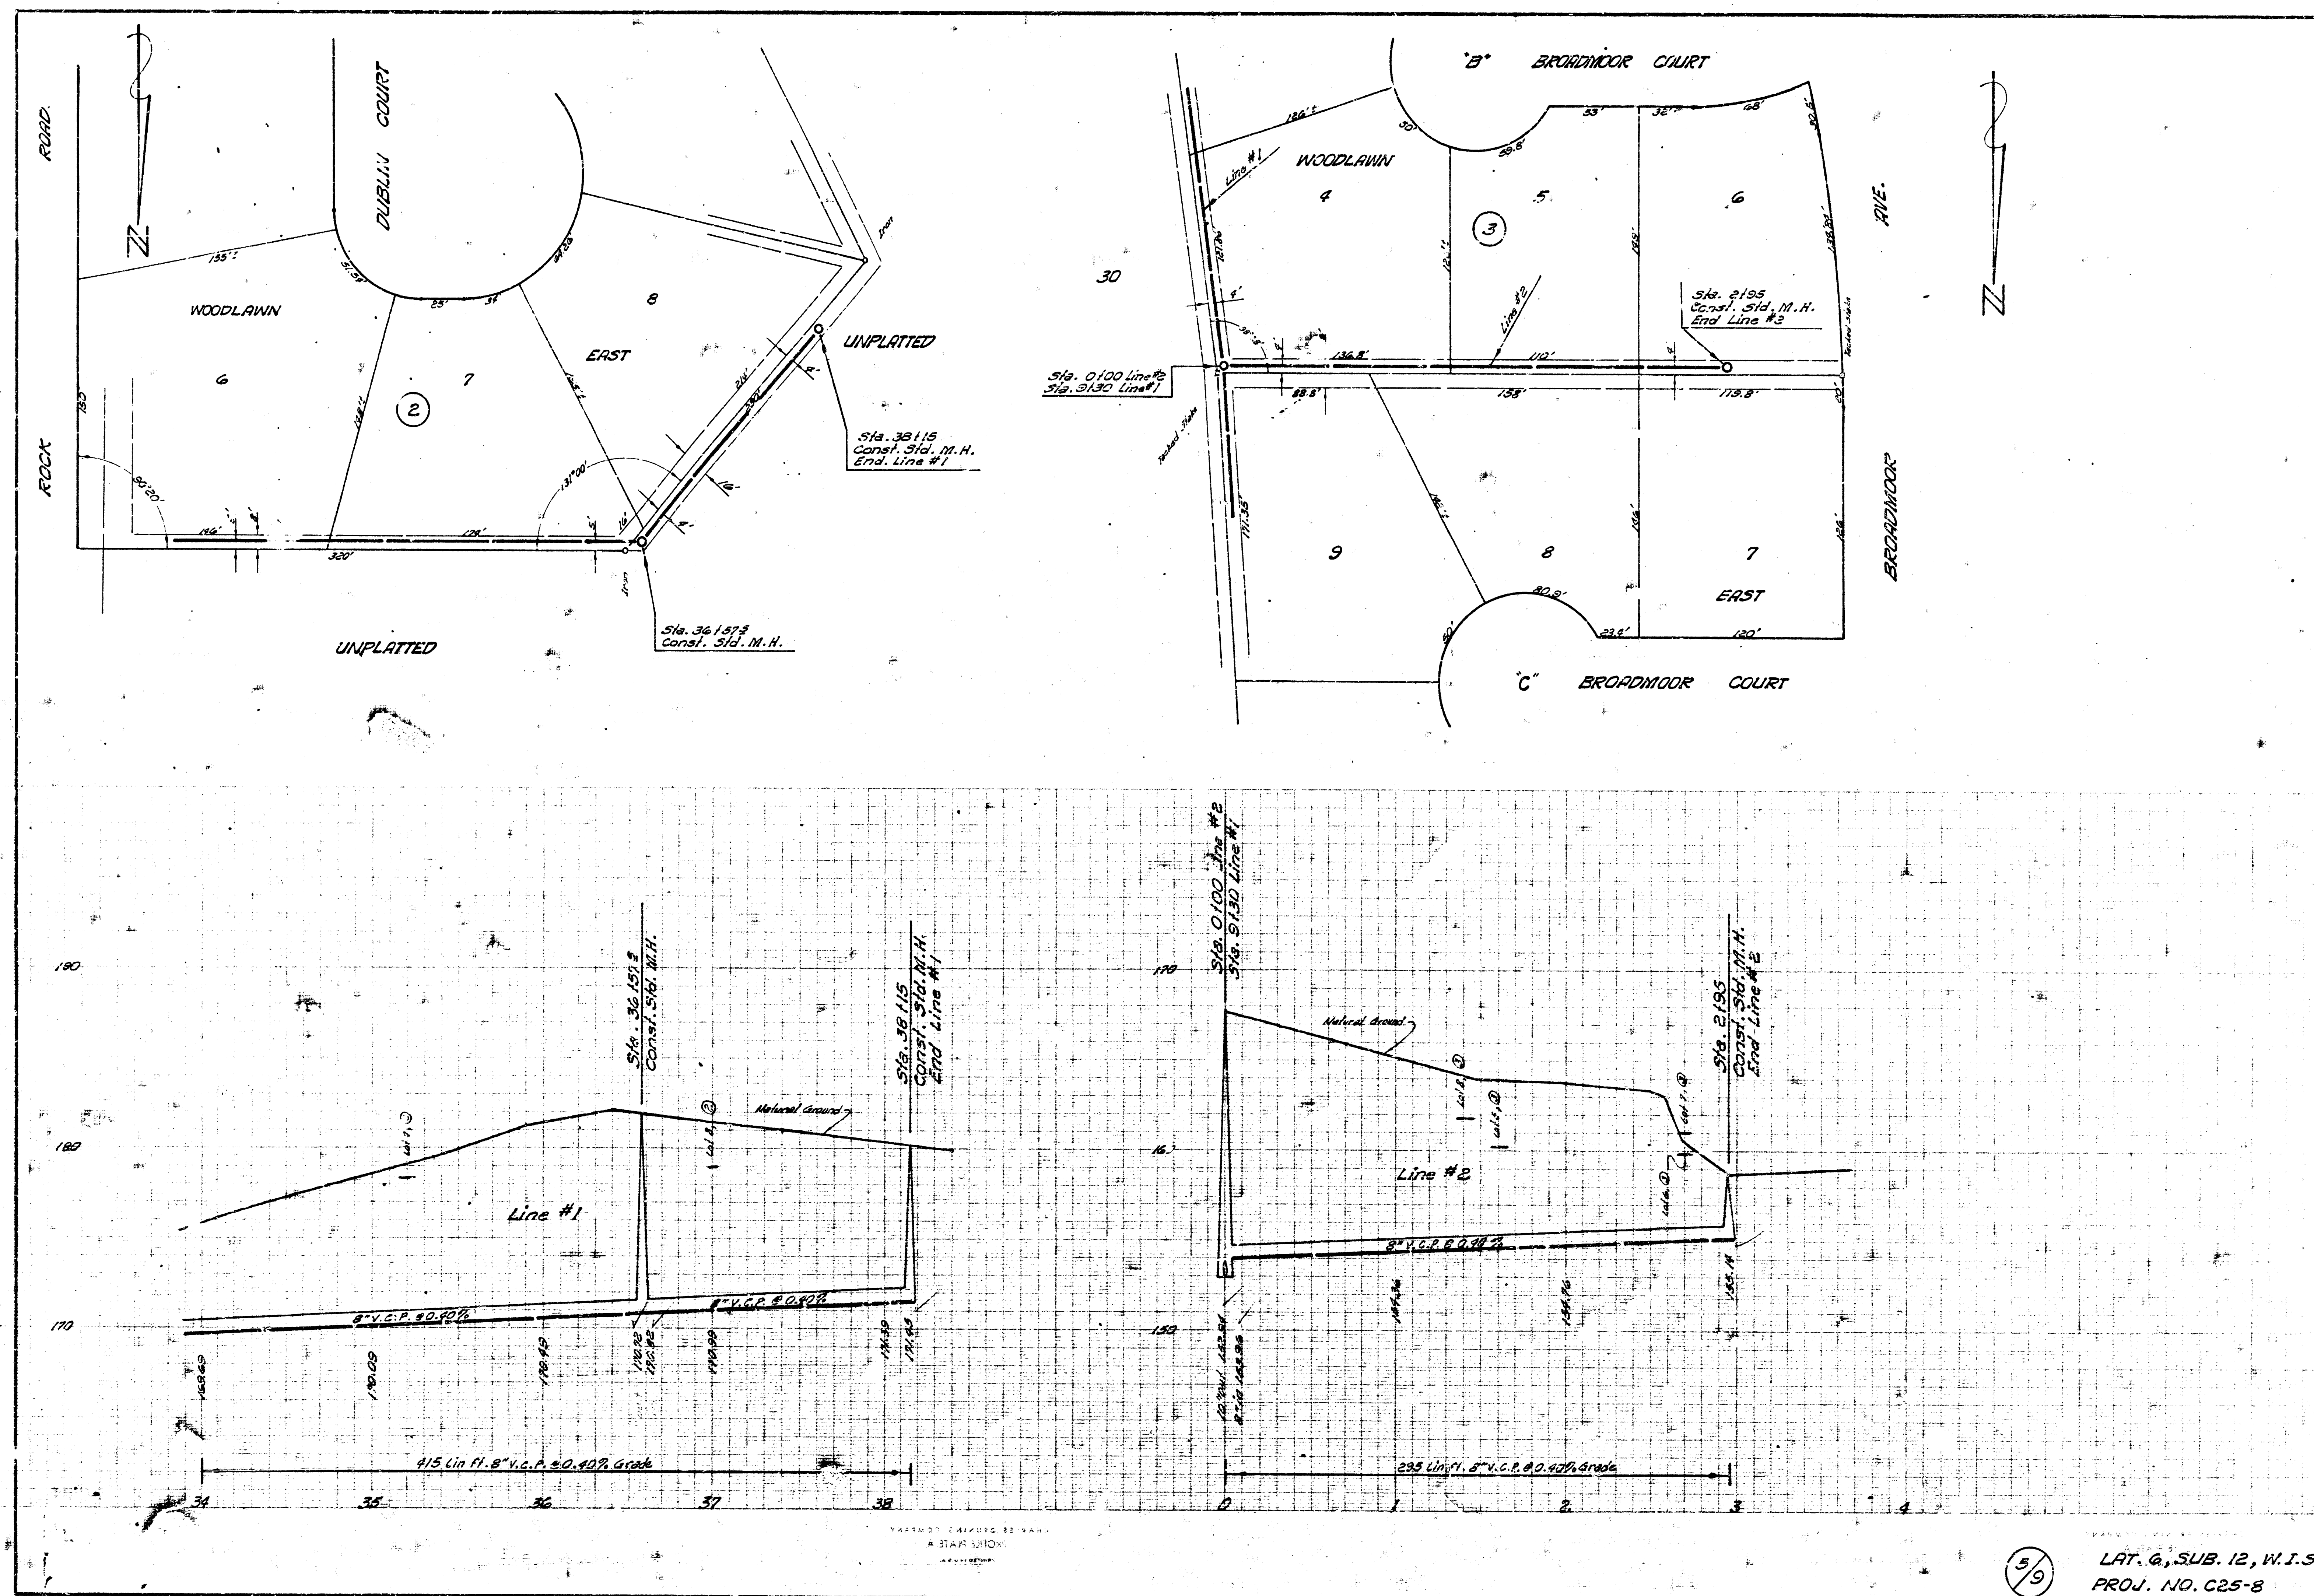

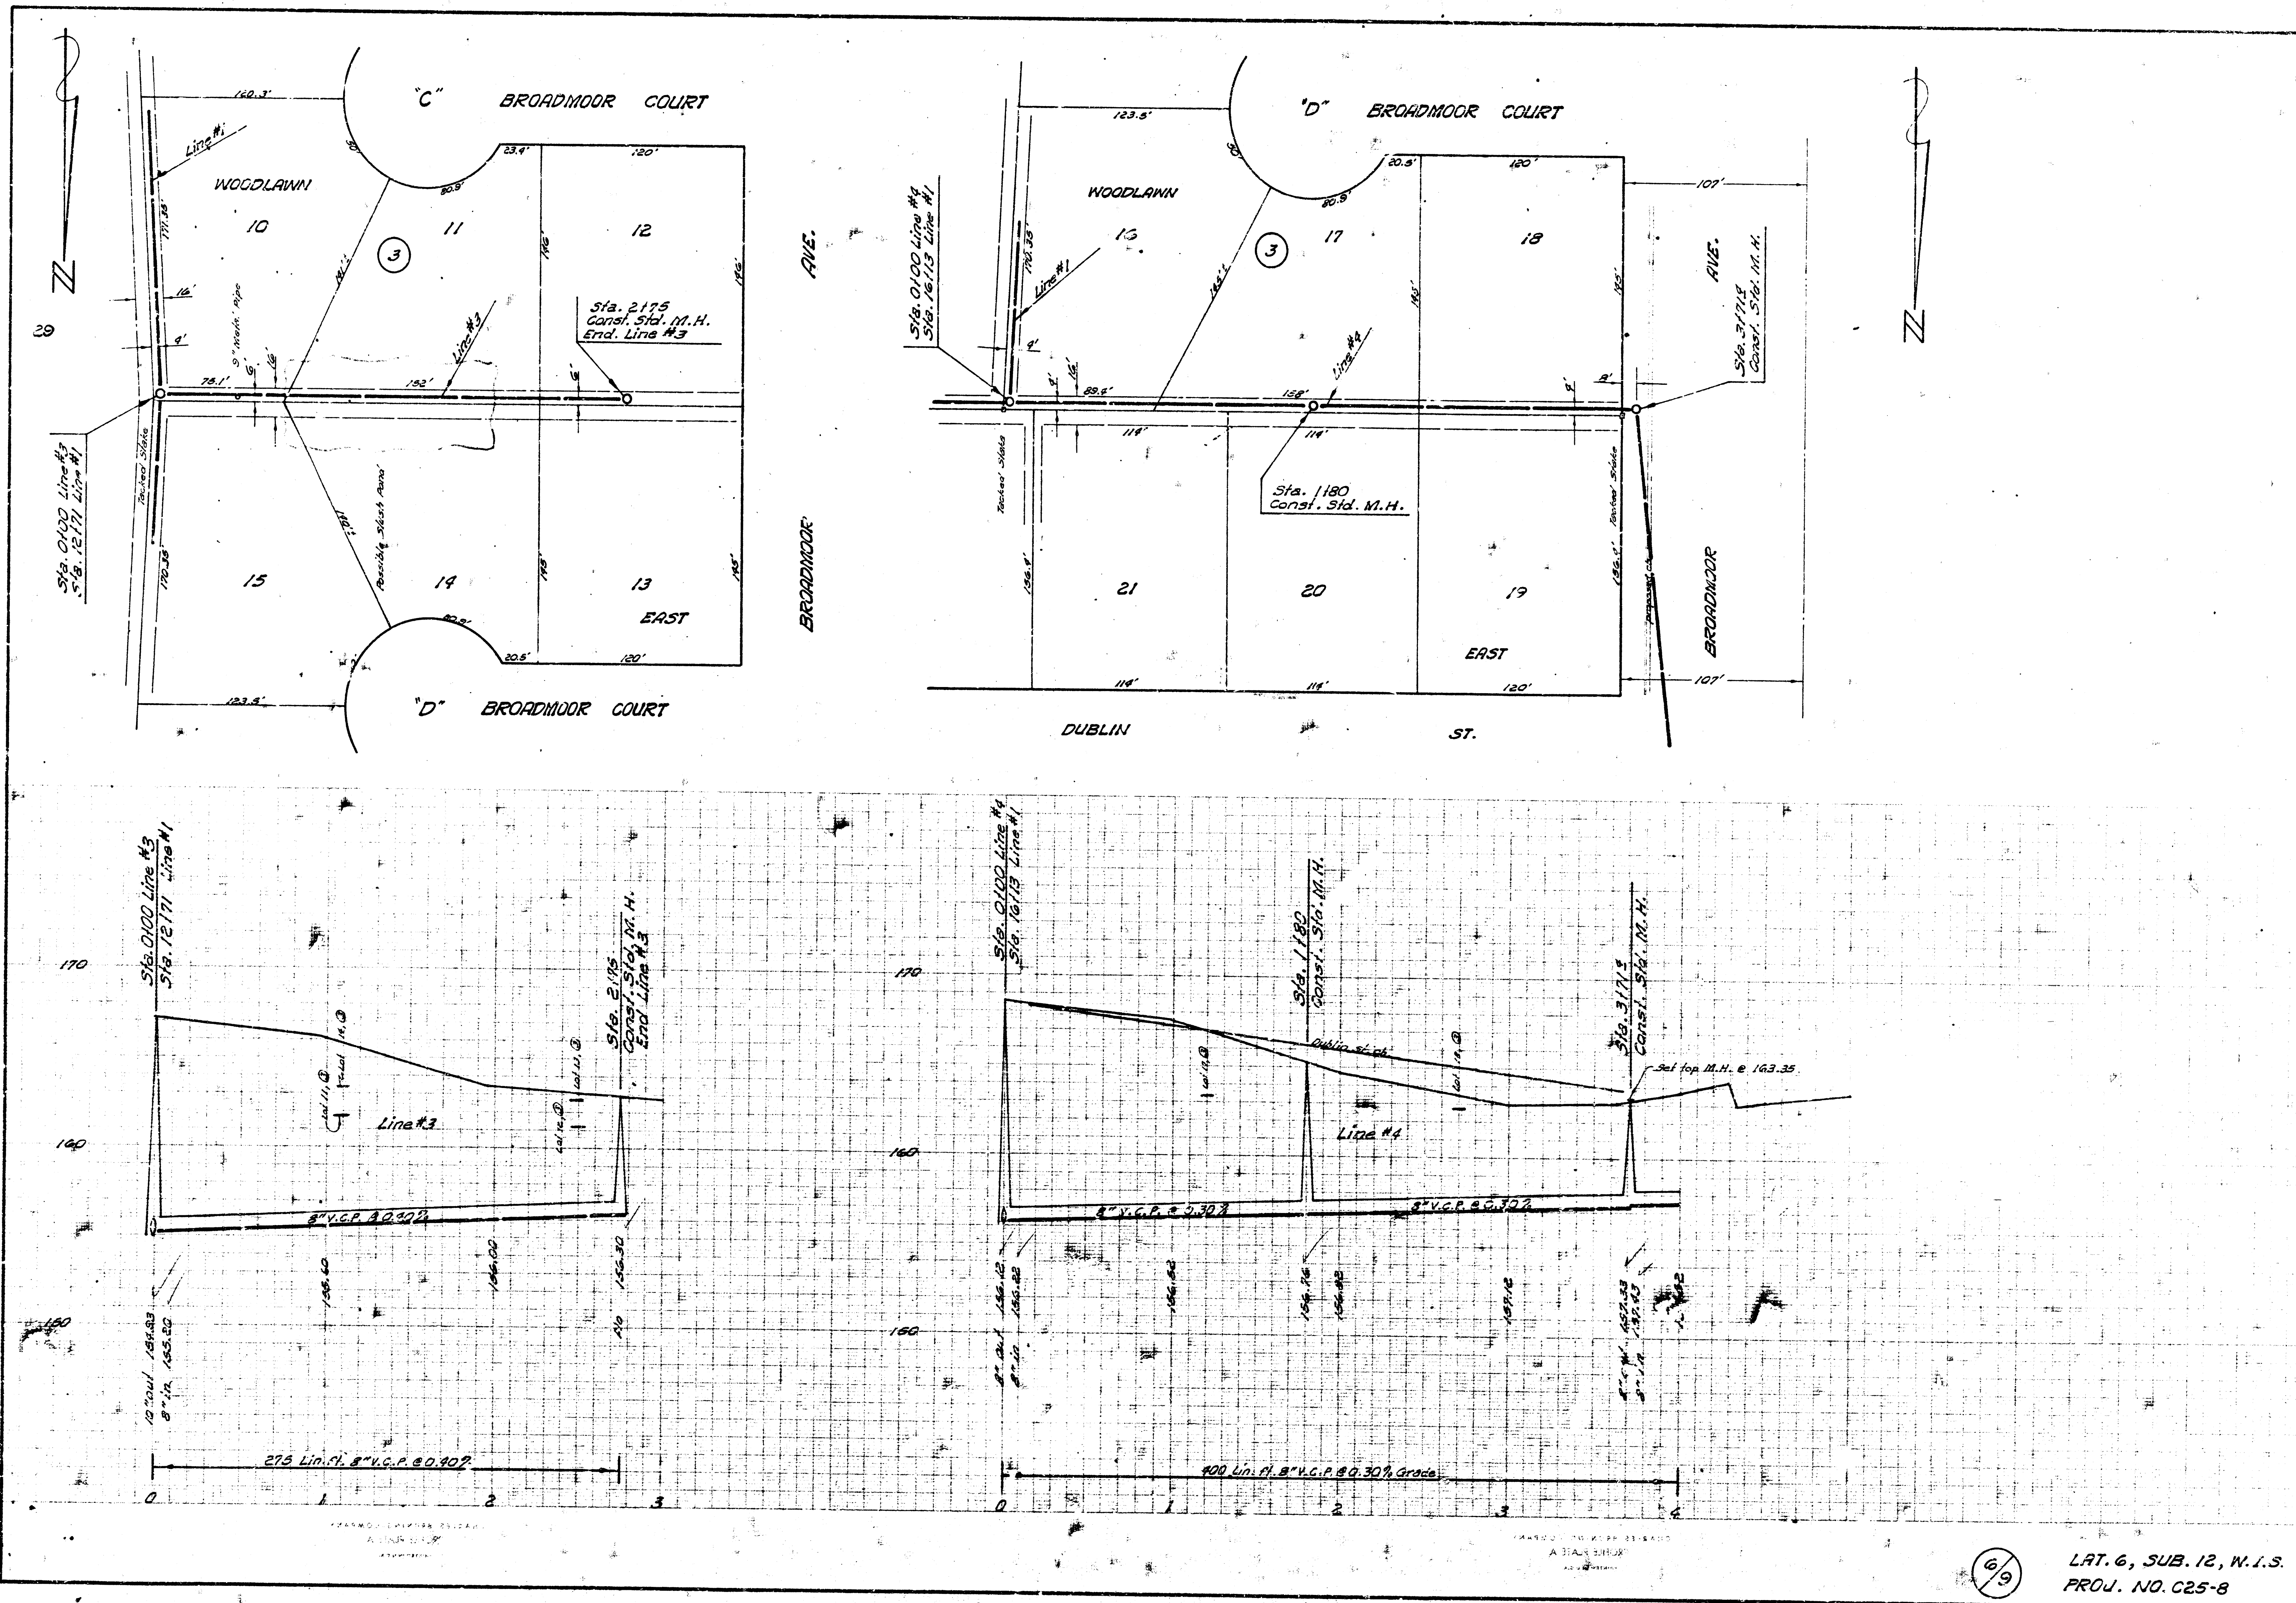

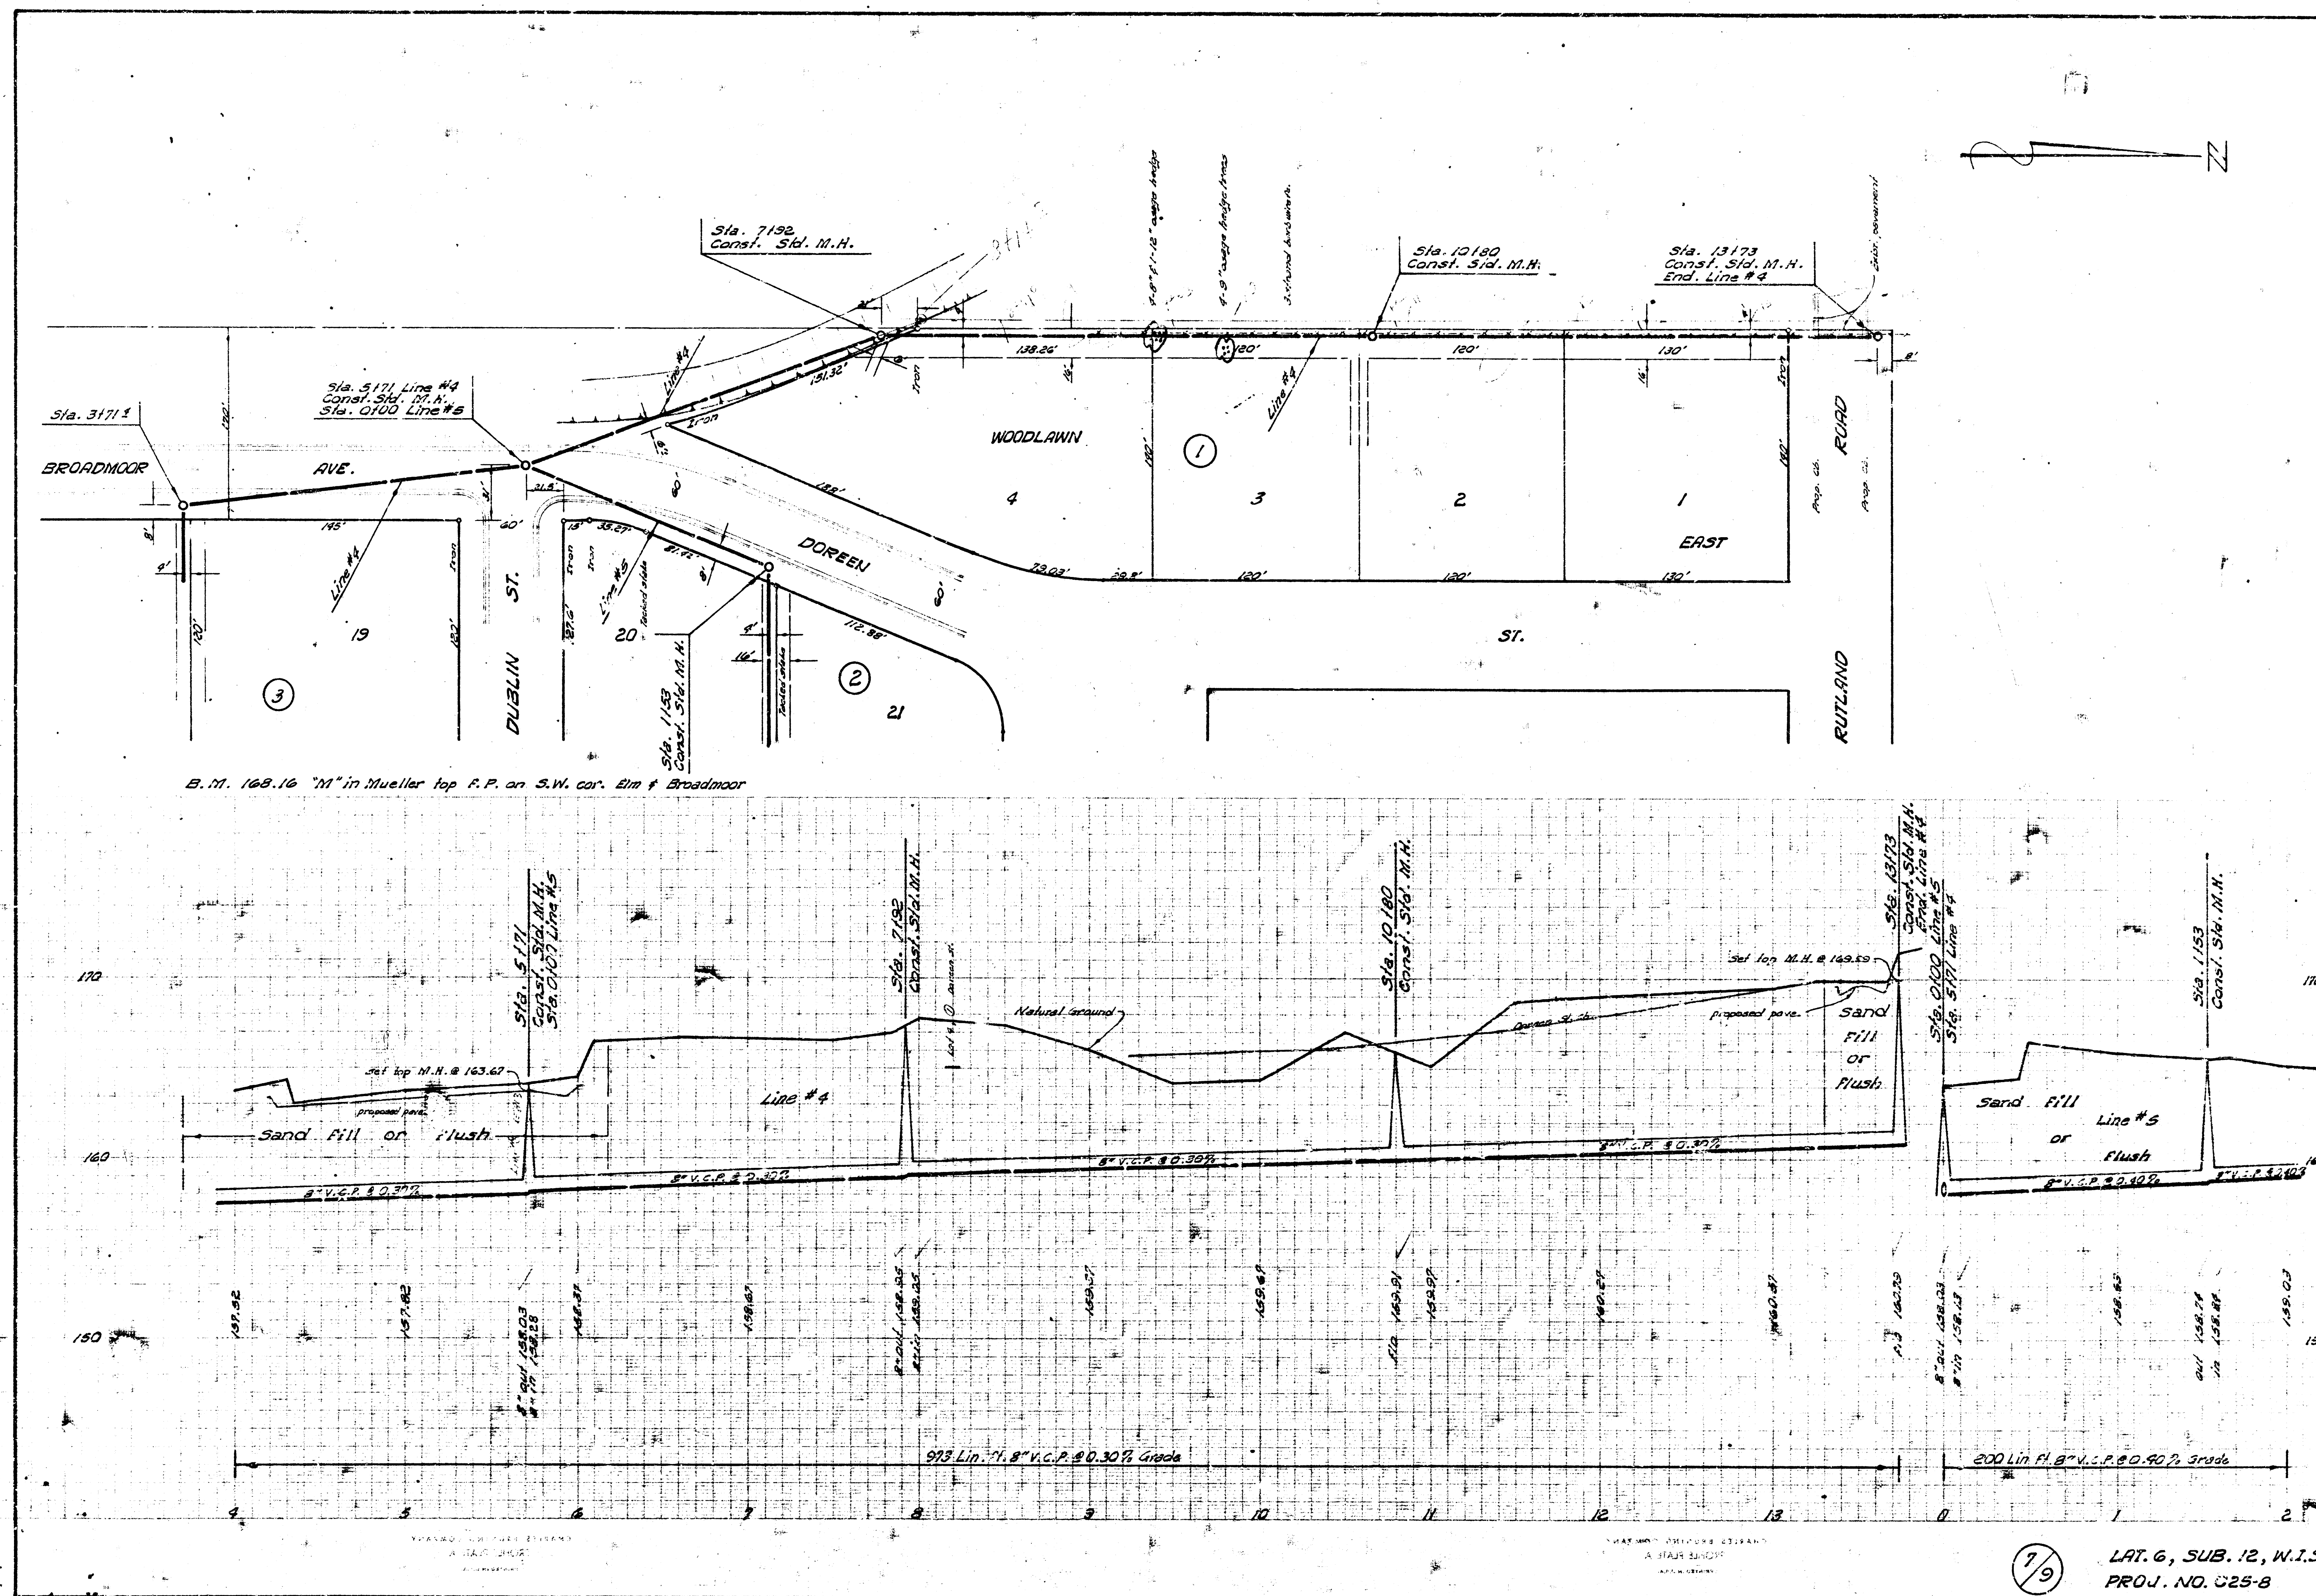

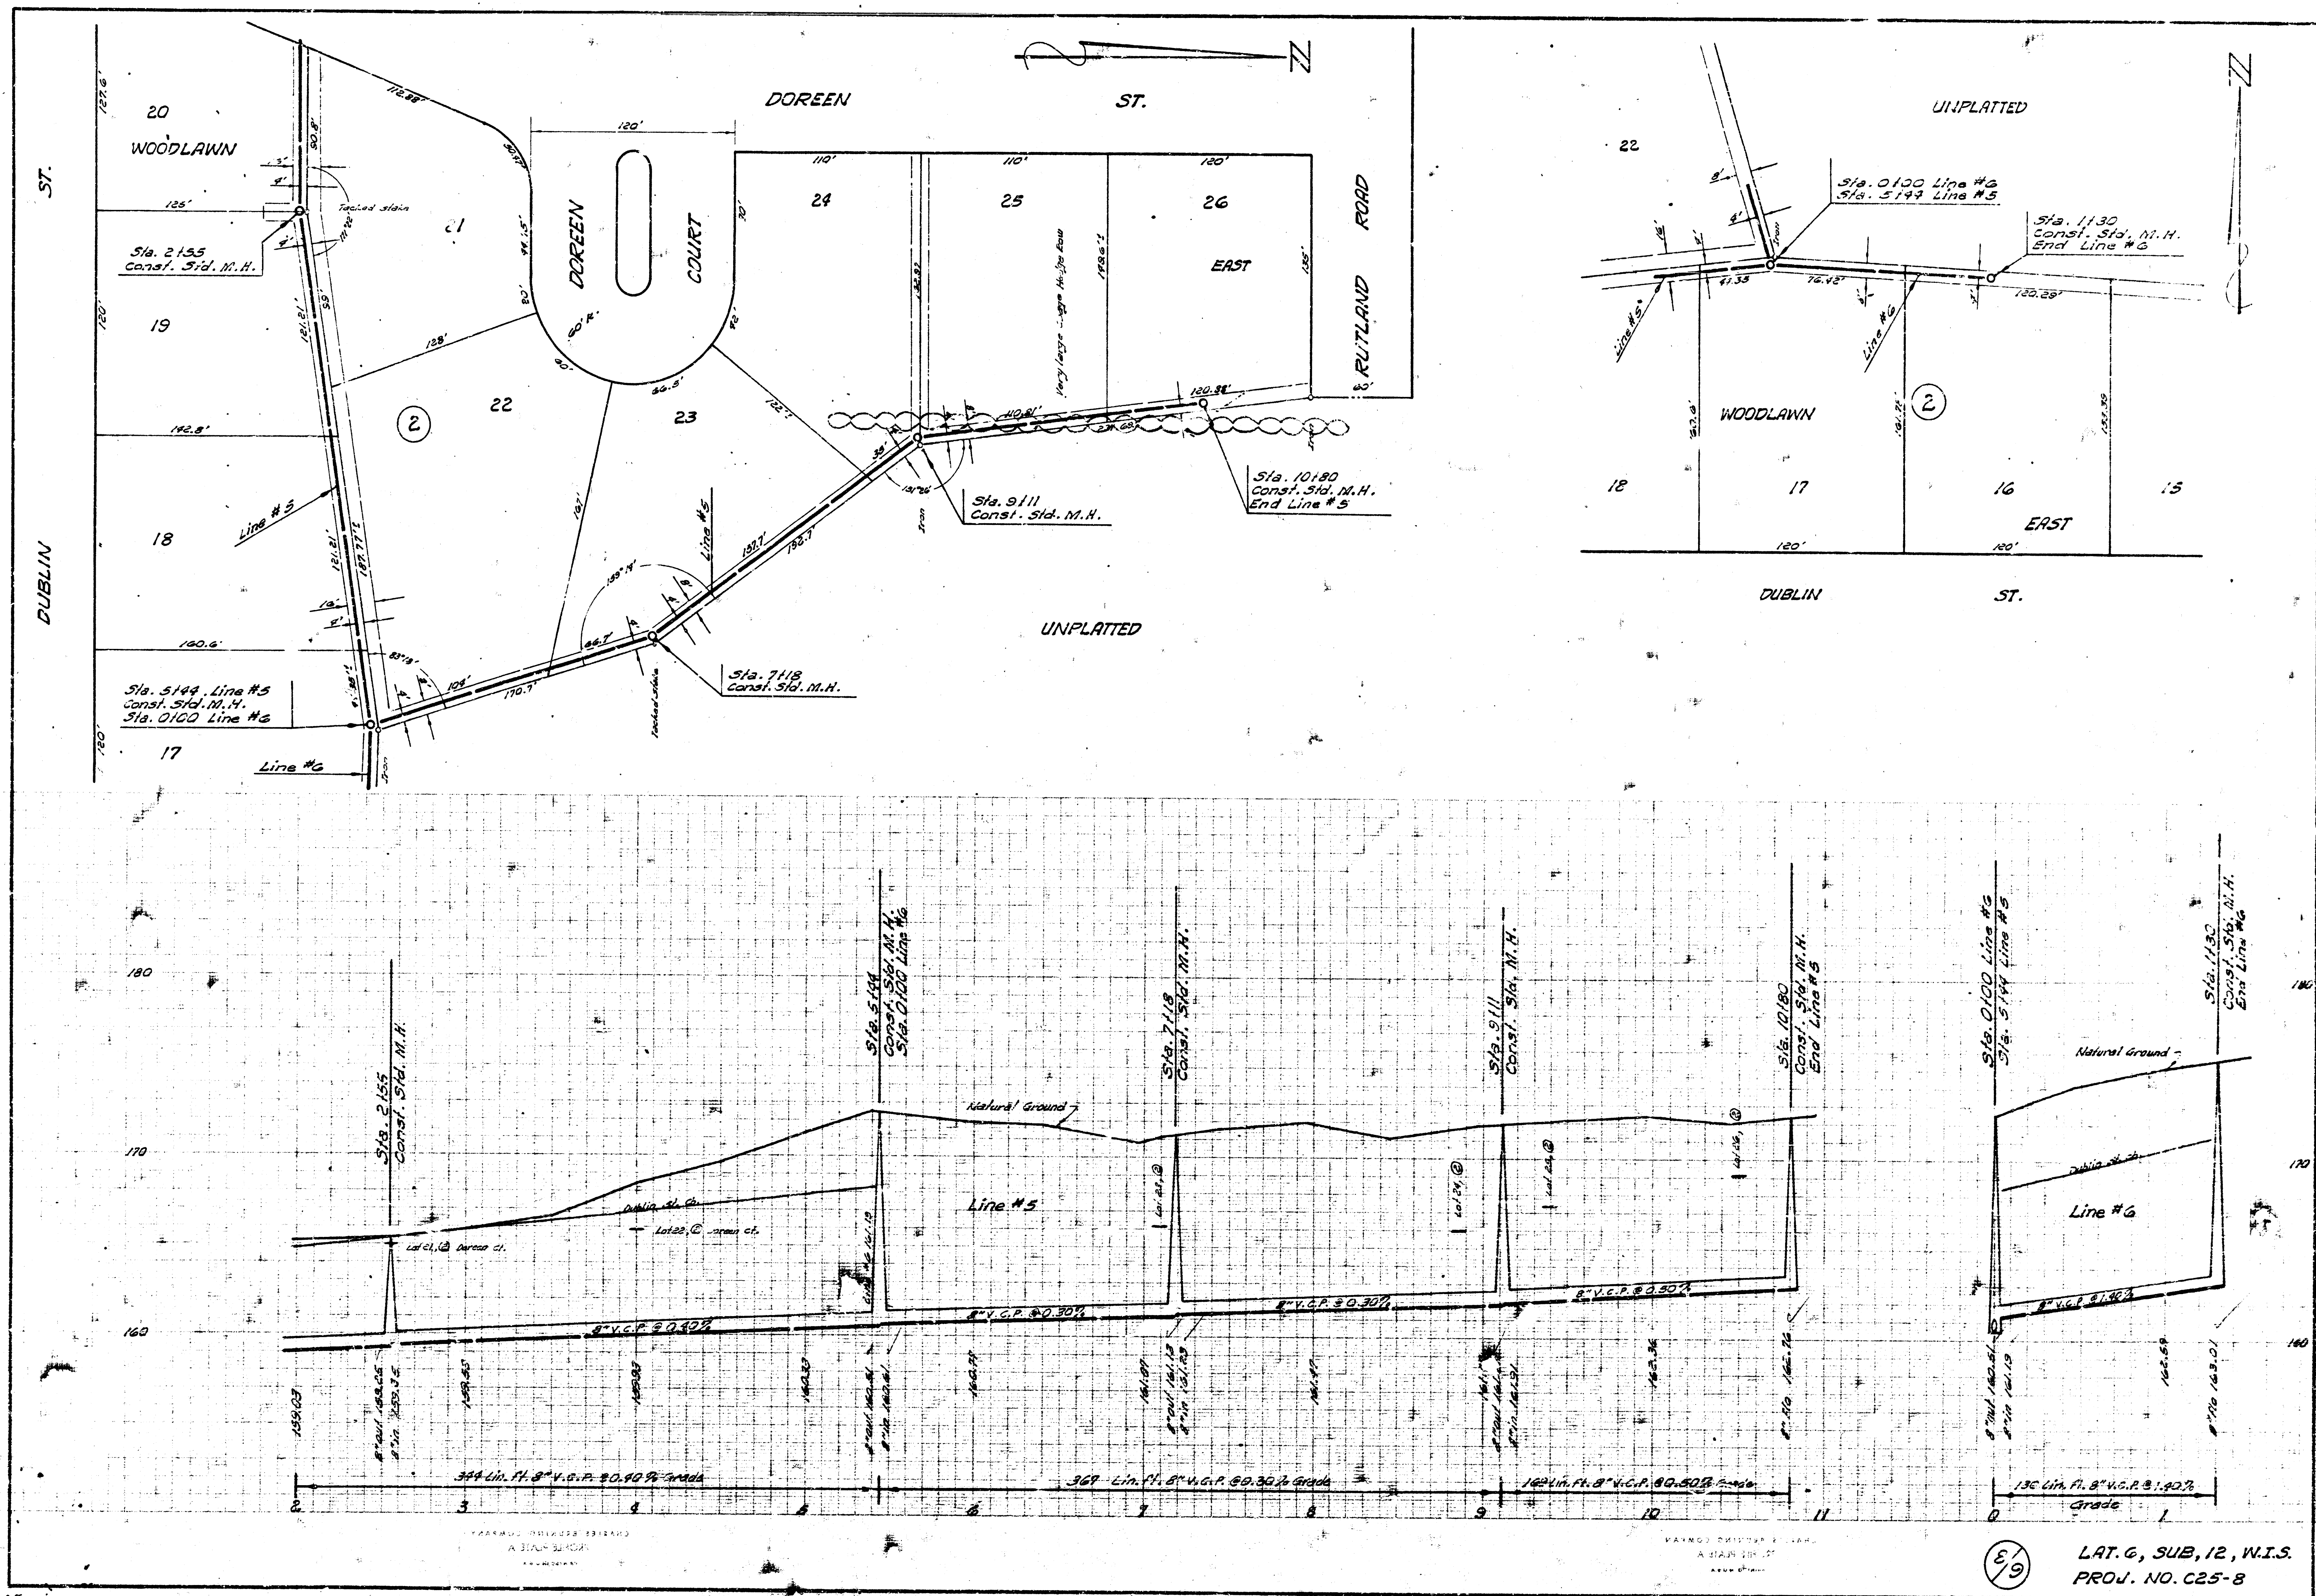

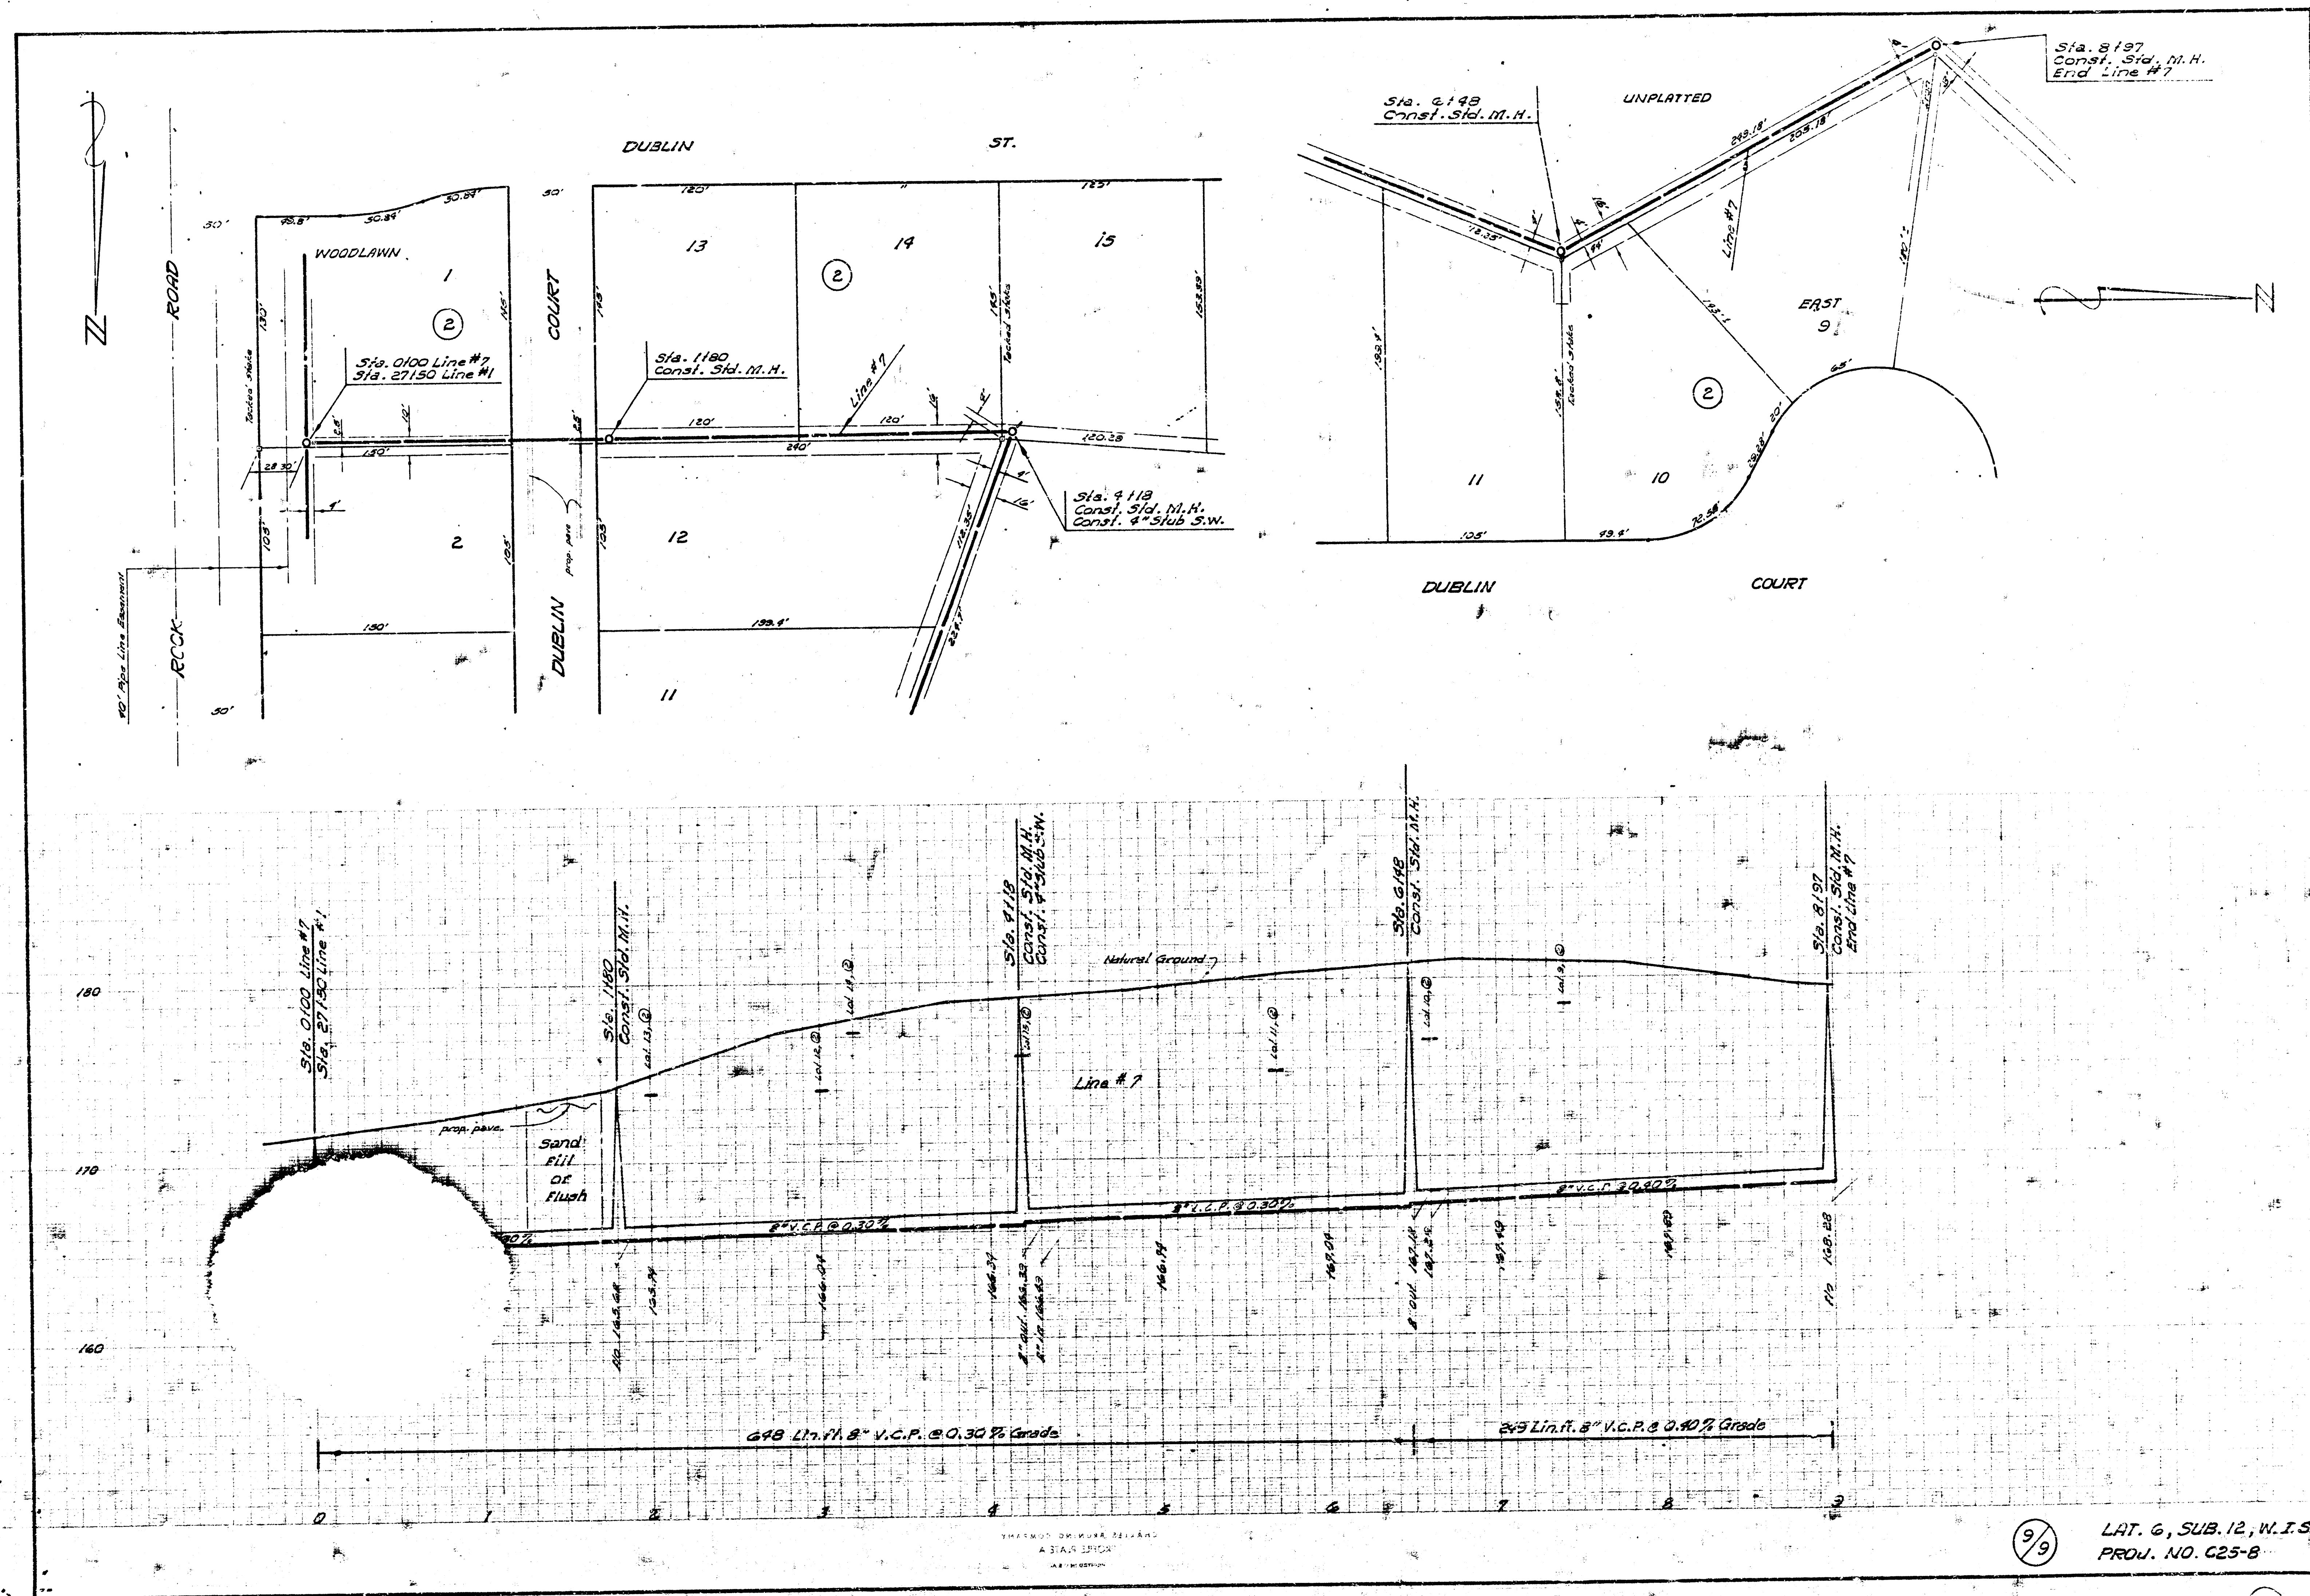

9/9

8 11 5 15