
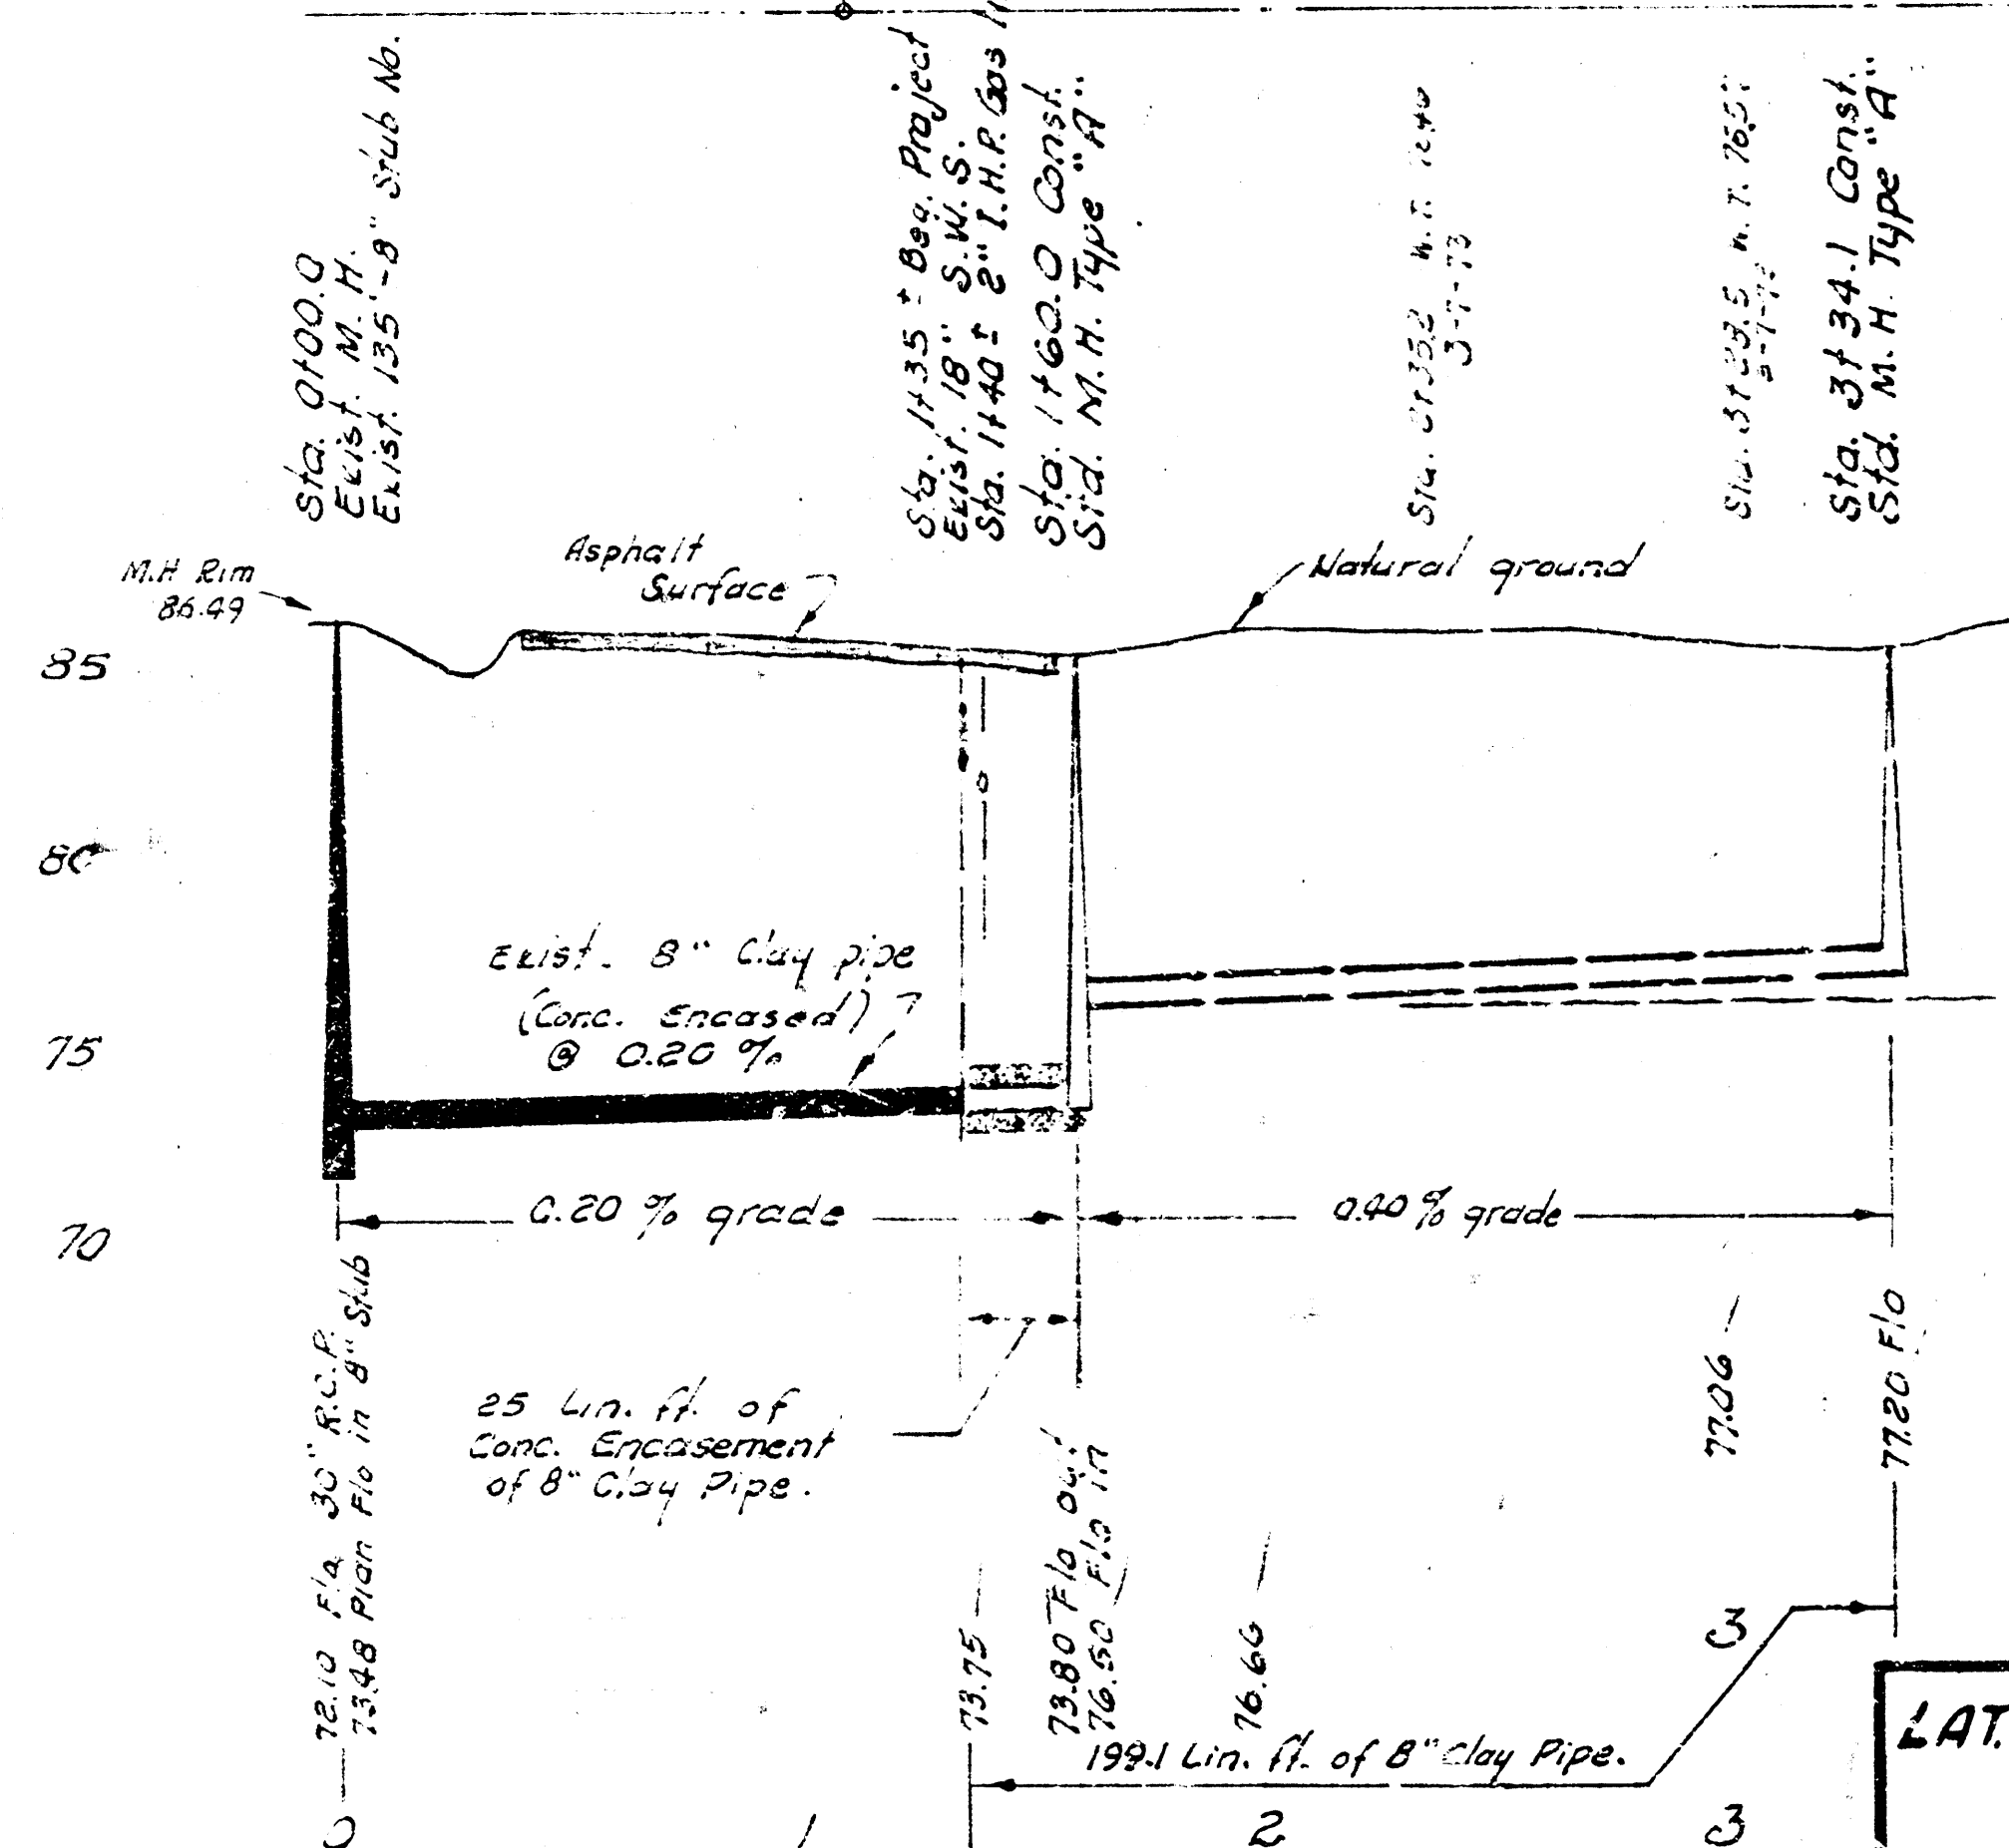




B.M. 86.90 "T" cut in S.W. cor. conc. Po. Auto Parts Store.

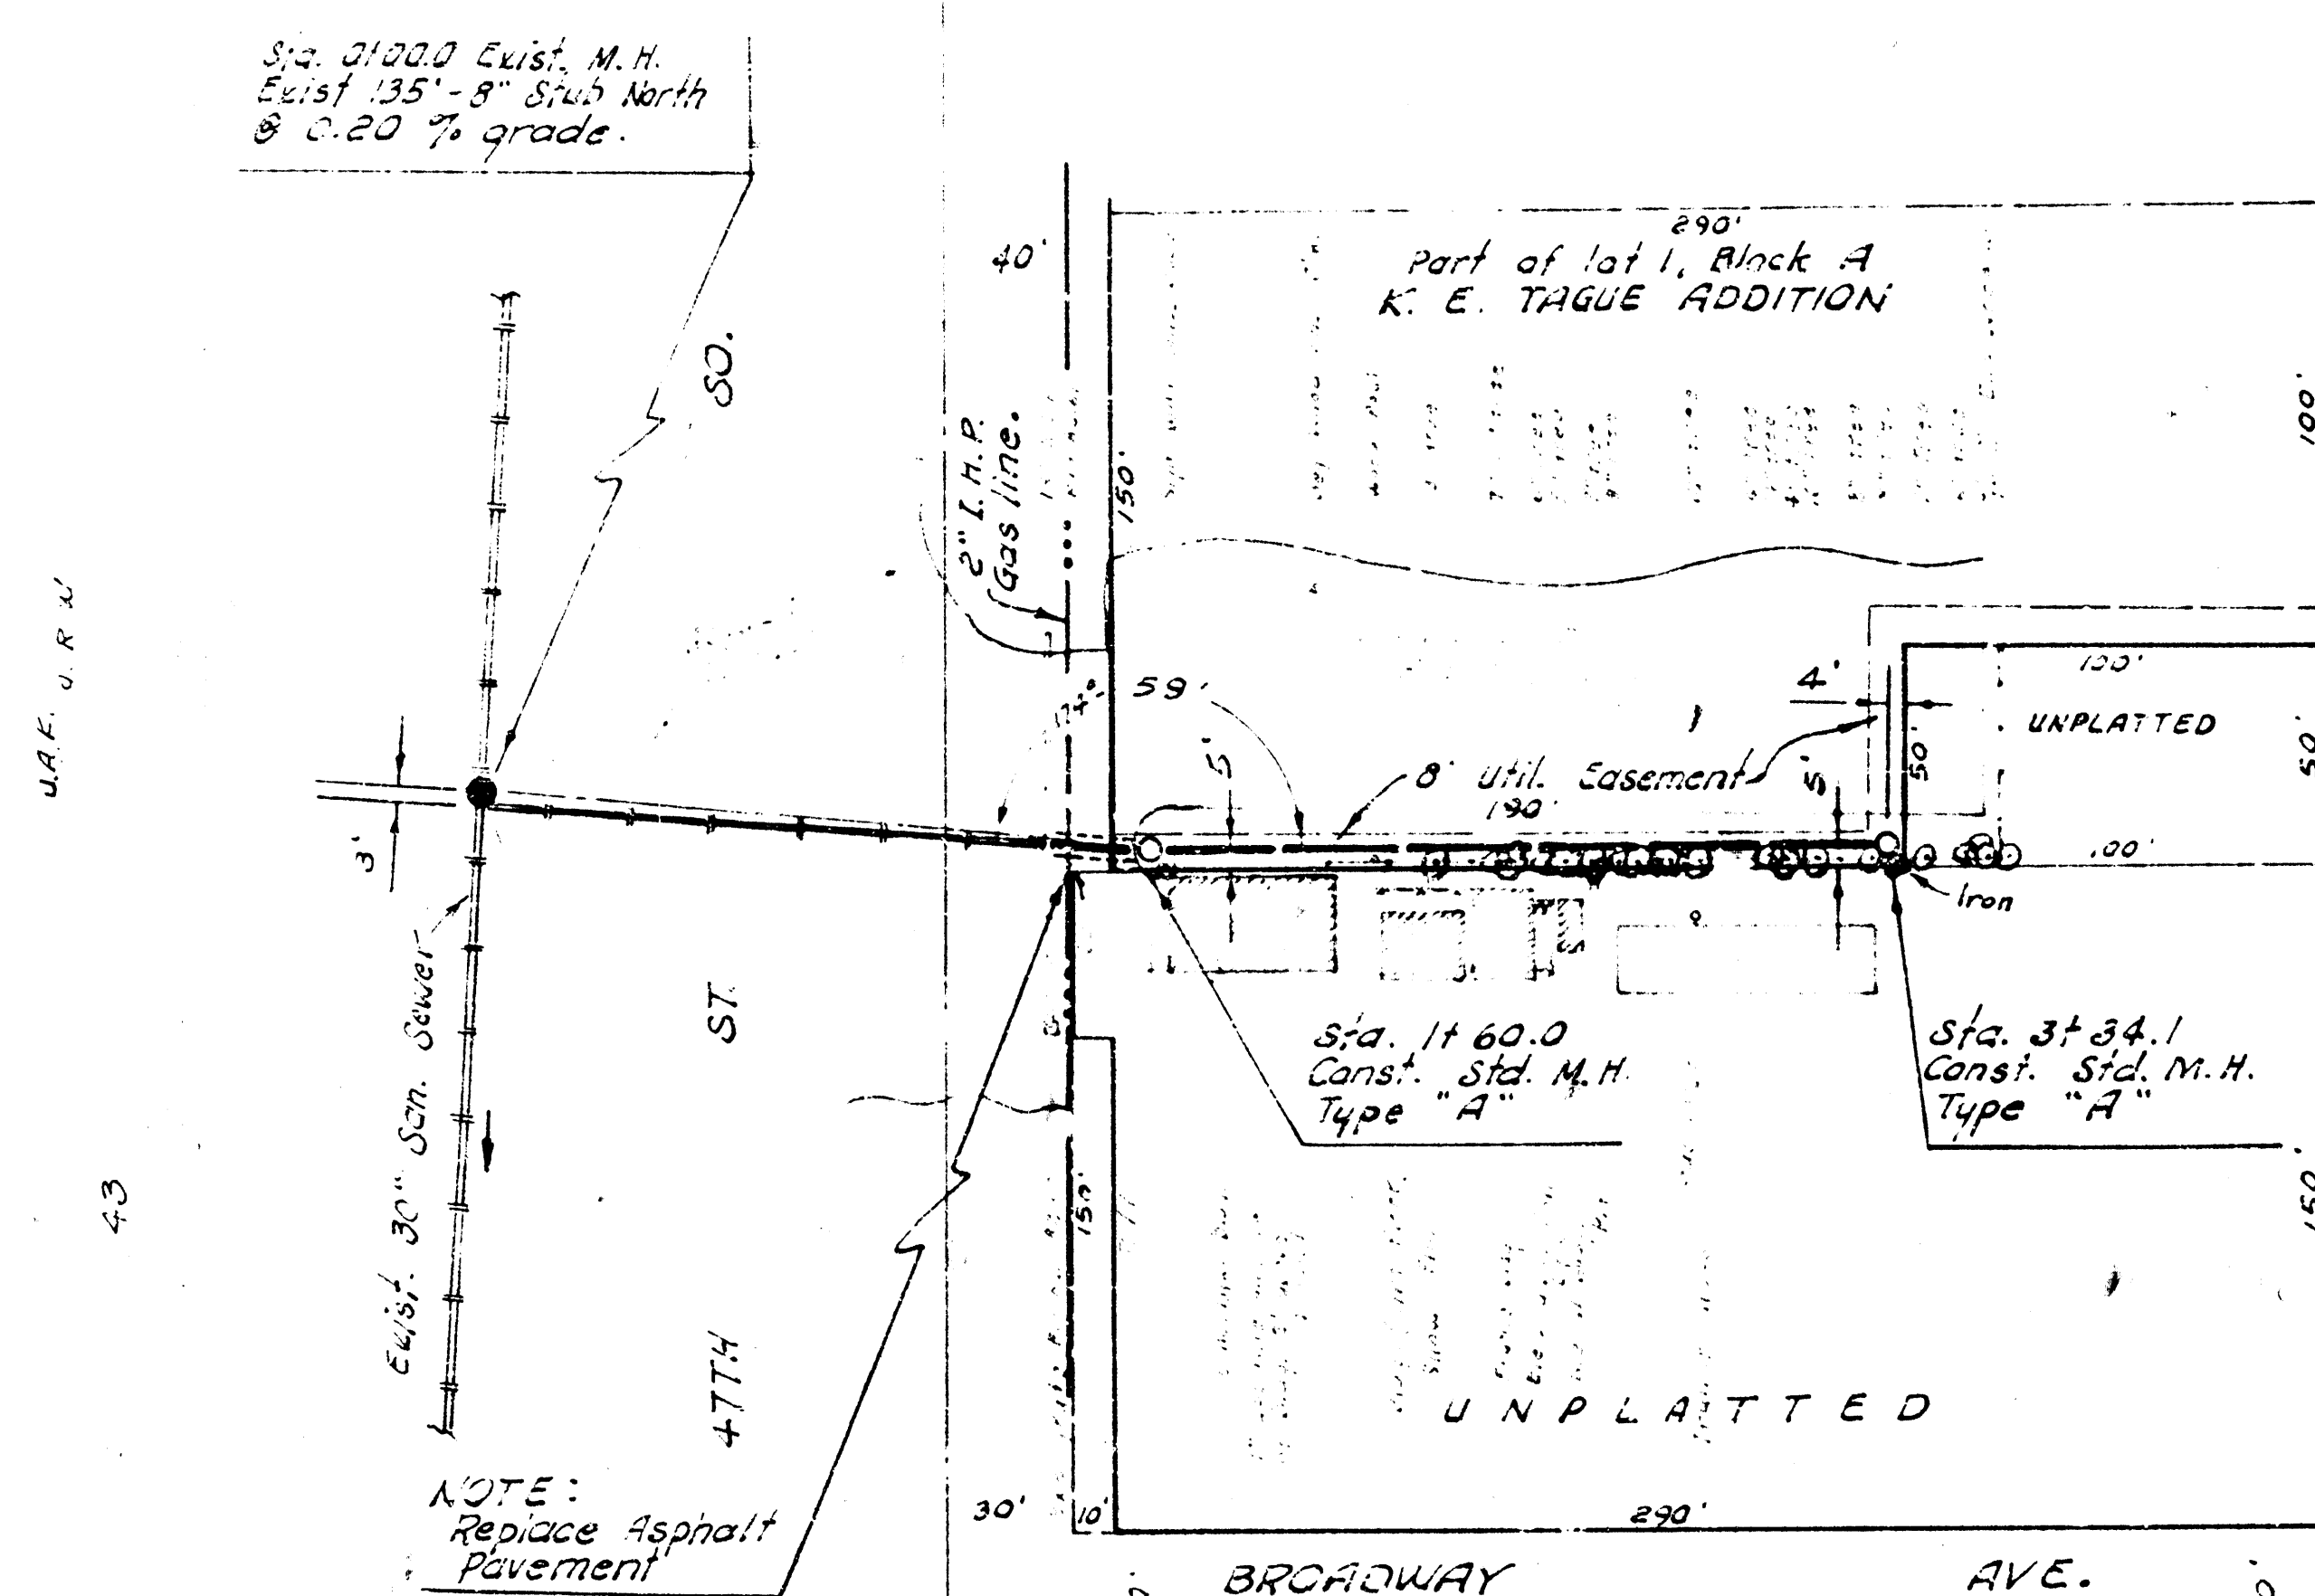

**LAT. 7, MAIN 2, S.W. INTERCEPT SEWER**  
CITY OF WICHITA, KANSAS  
R. W. LINN - CITY ENGINEER  
APRIL 1973 PROJECT NO. DBK L 512081

B.M. 145.38 "T" top W-End Handrail  
R.C.B.C. on Harry 238' E. of Rock Rd.  
B.M. 145.79 "M" in Mueller Fire Hydrant N.W.  
cor. Rock Rd. & Harry.  
B.M. 149.87 SE cor. bottom conc. Step at S.E.  
cor. Bldg. 7820 E. Harry.

Survey by D.L.K. Bk. D.L.K. 123  
Plan by U.R.W.  
Checked by

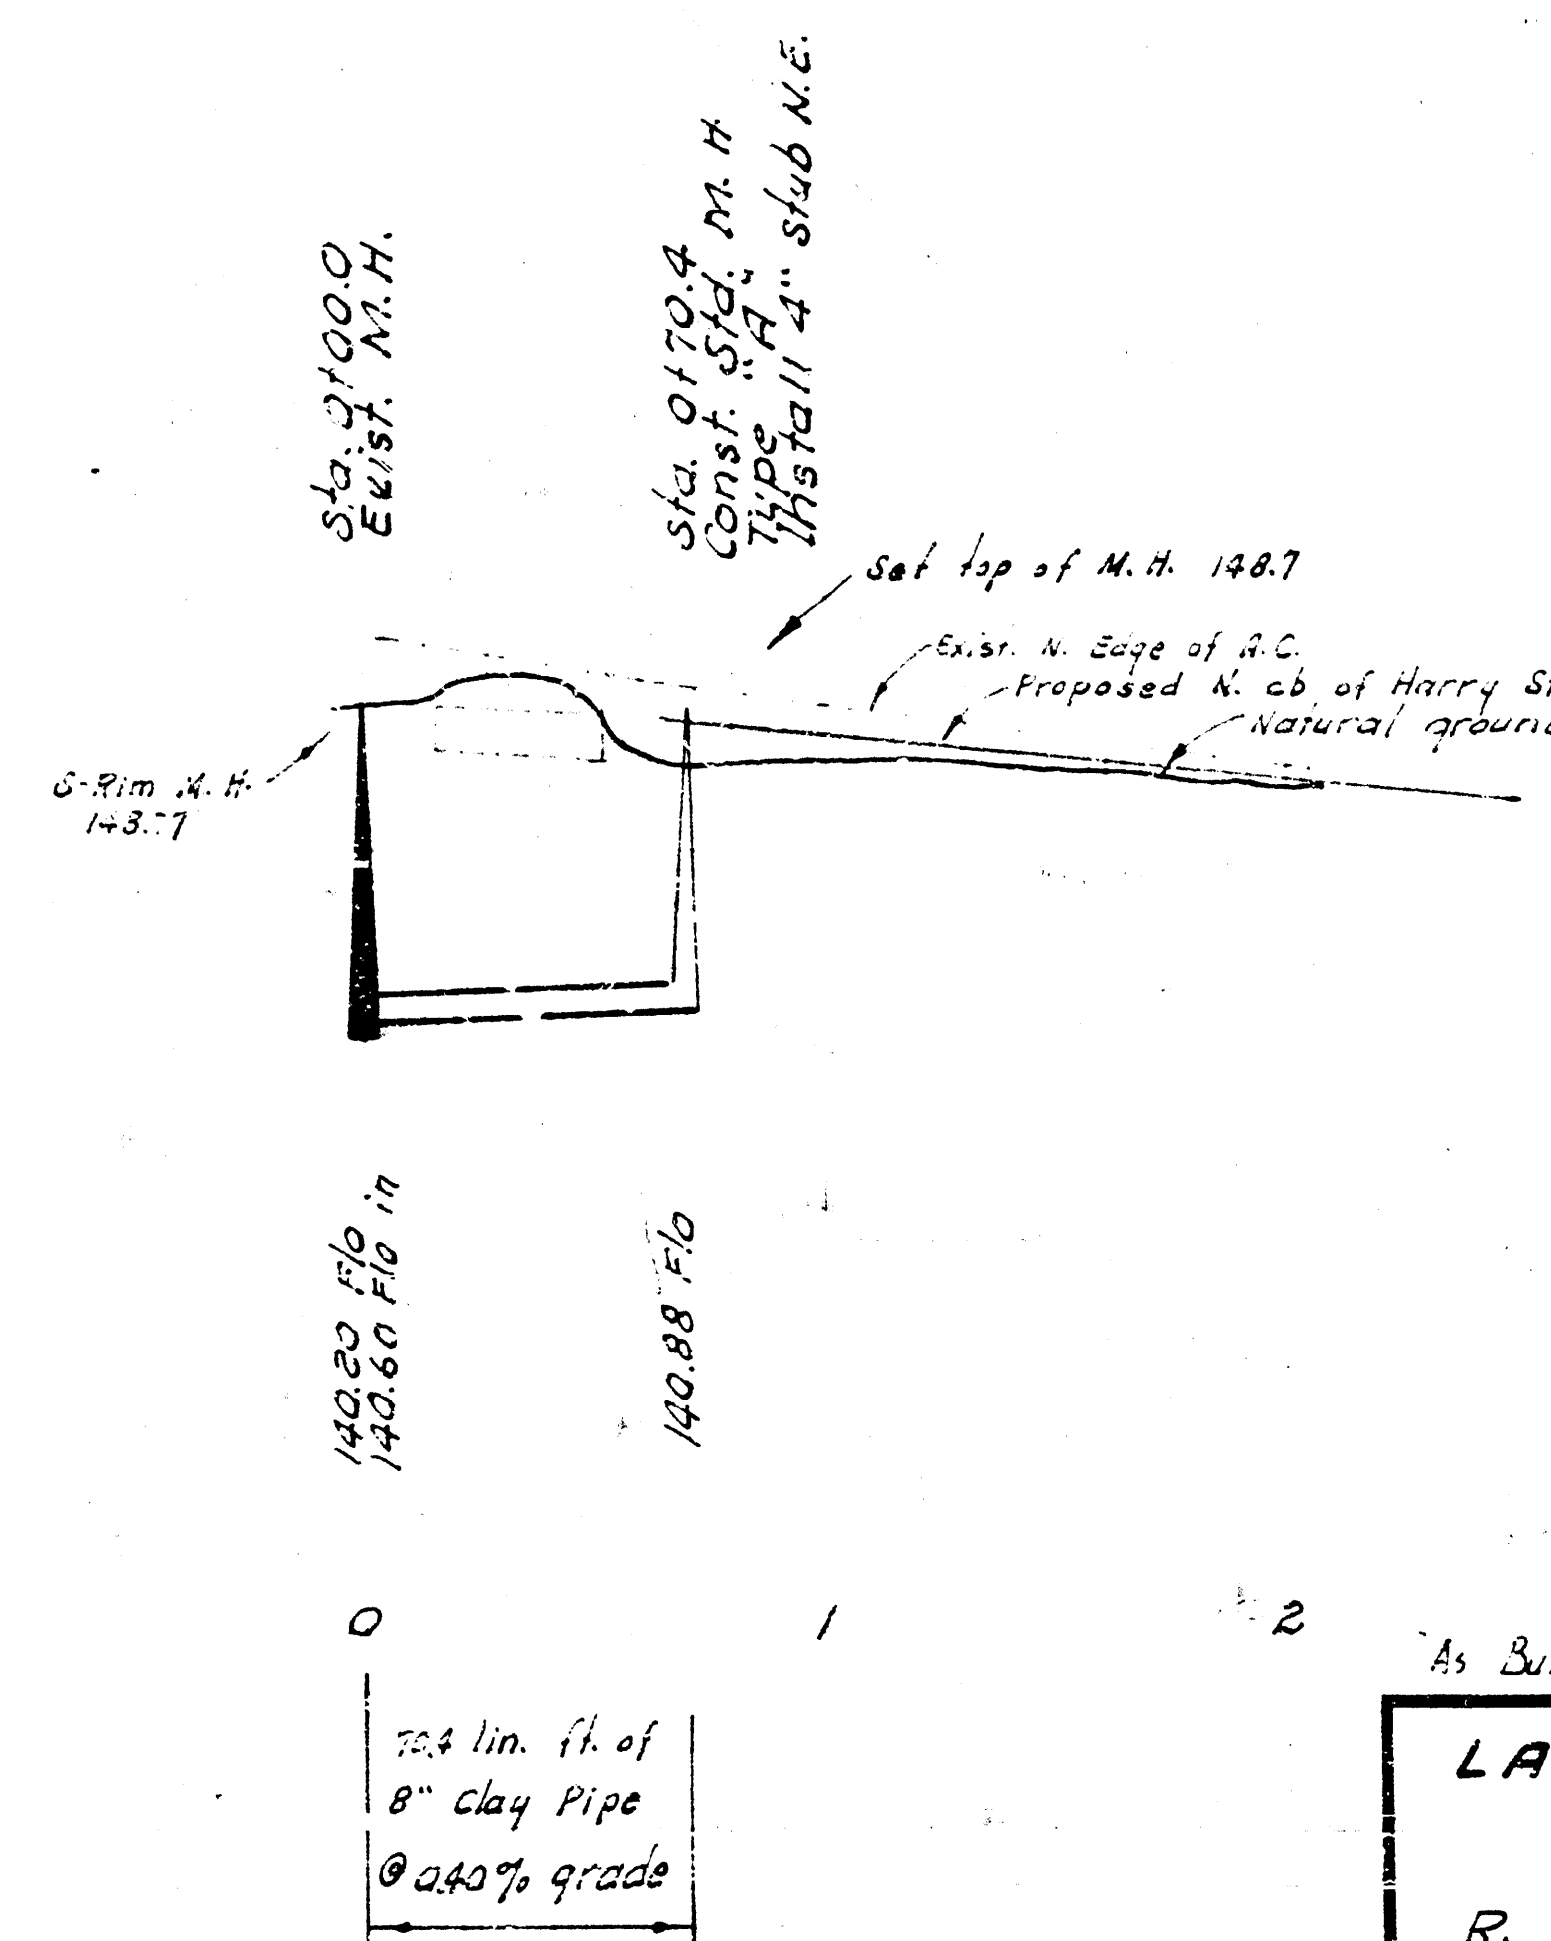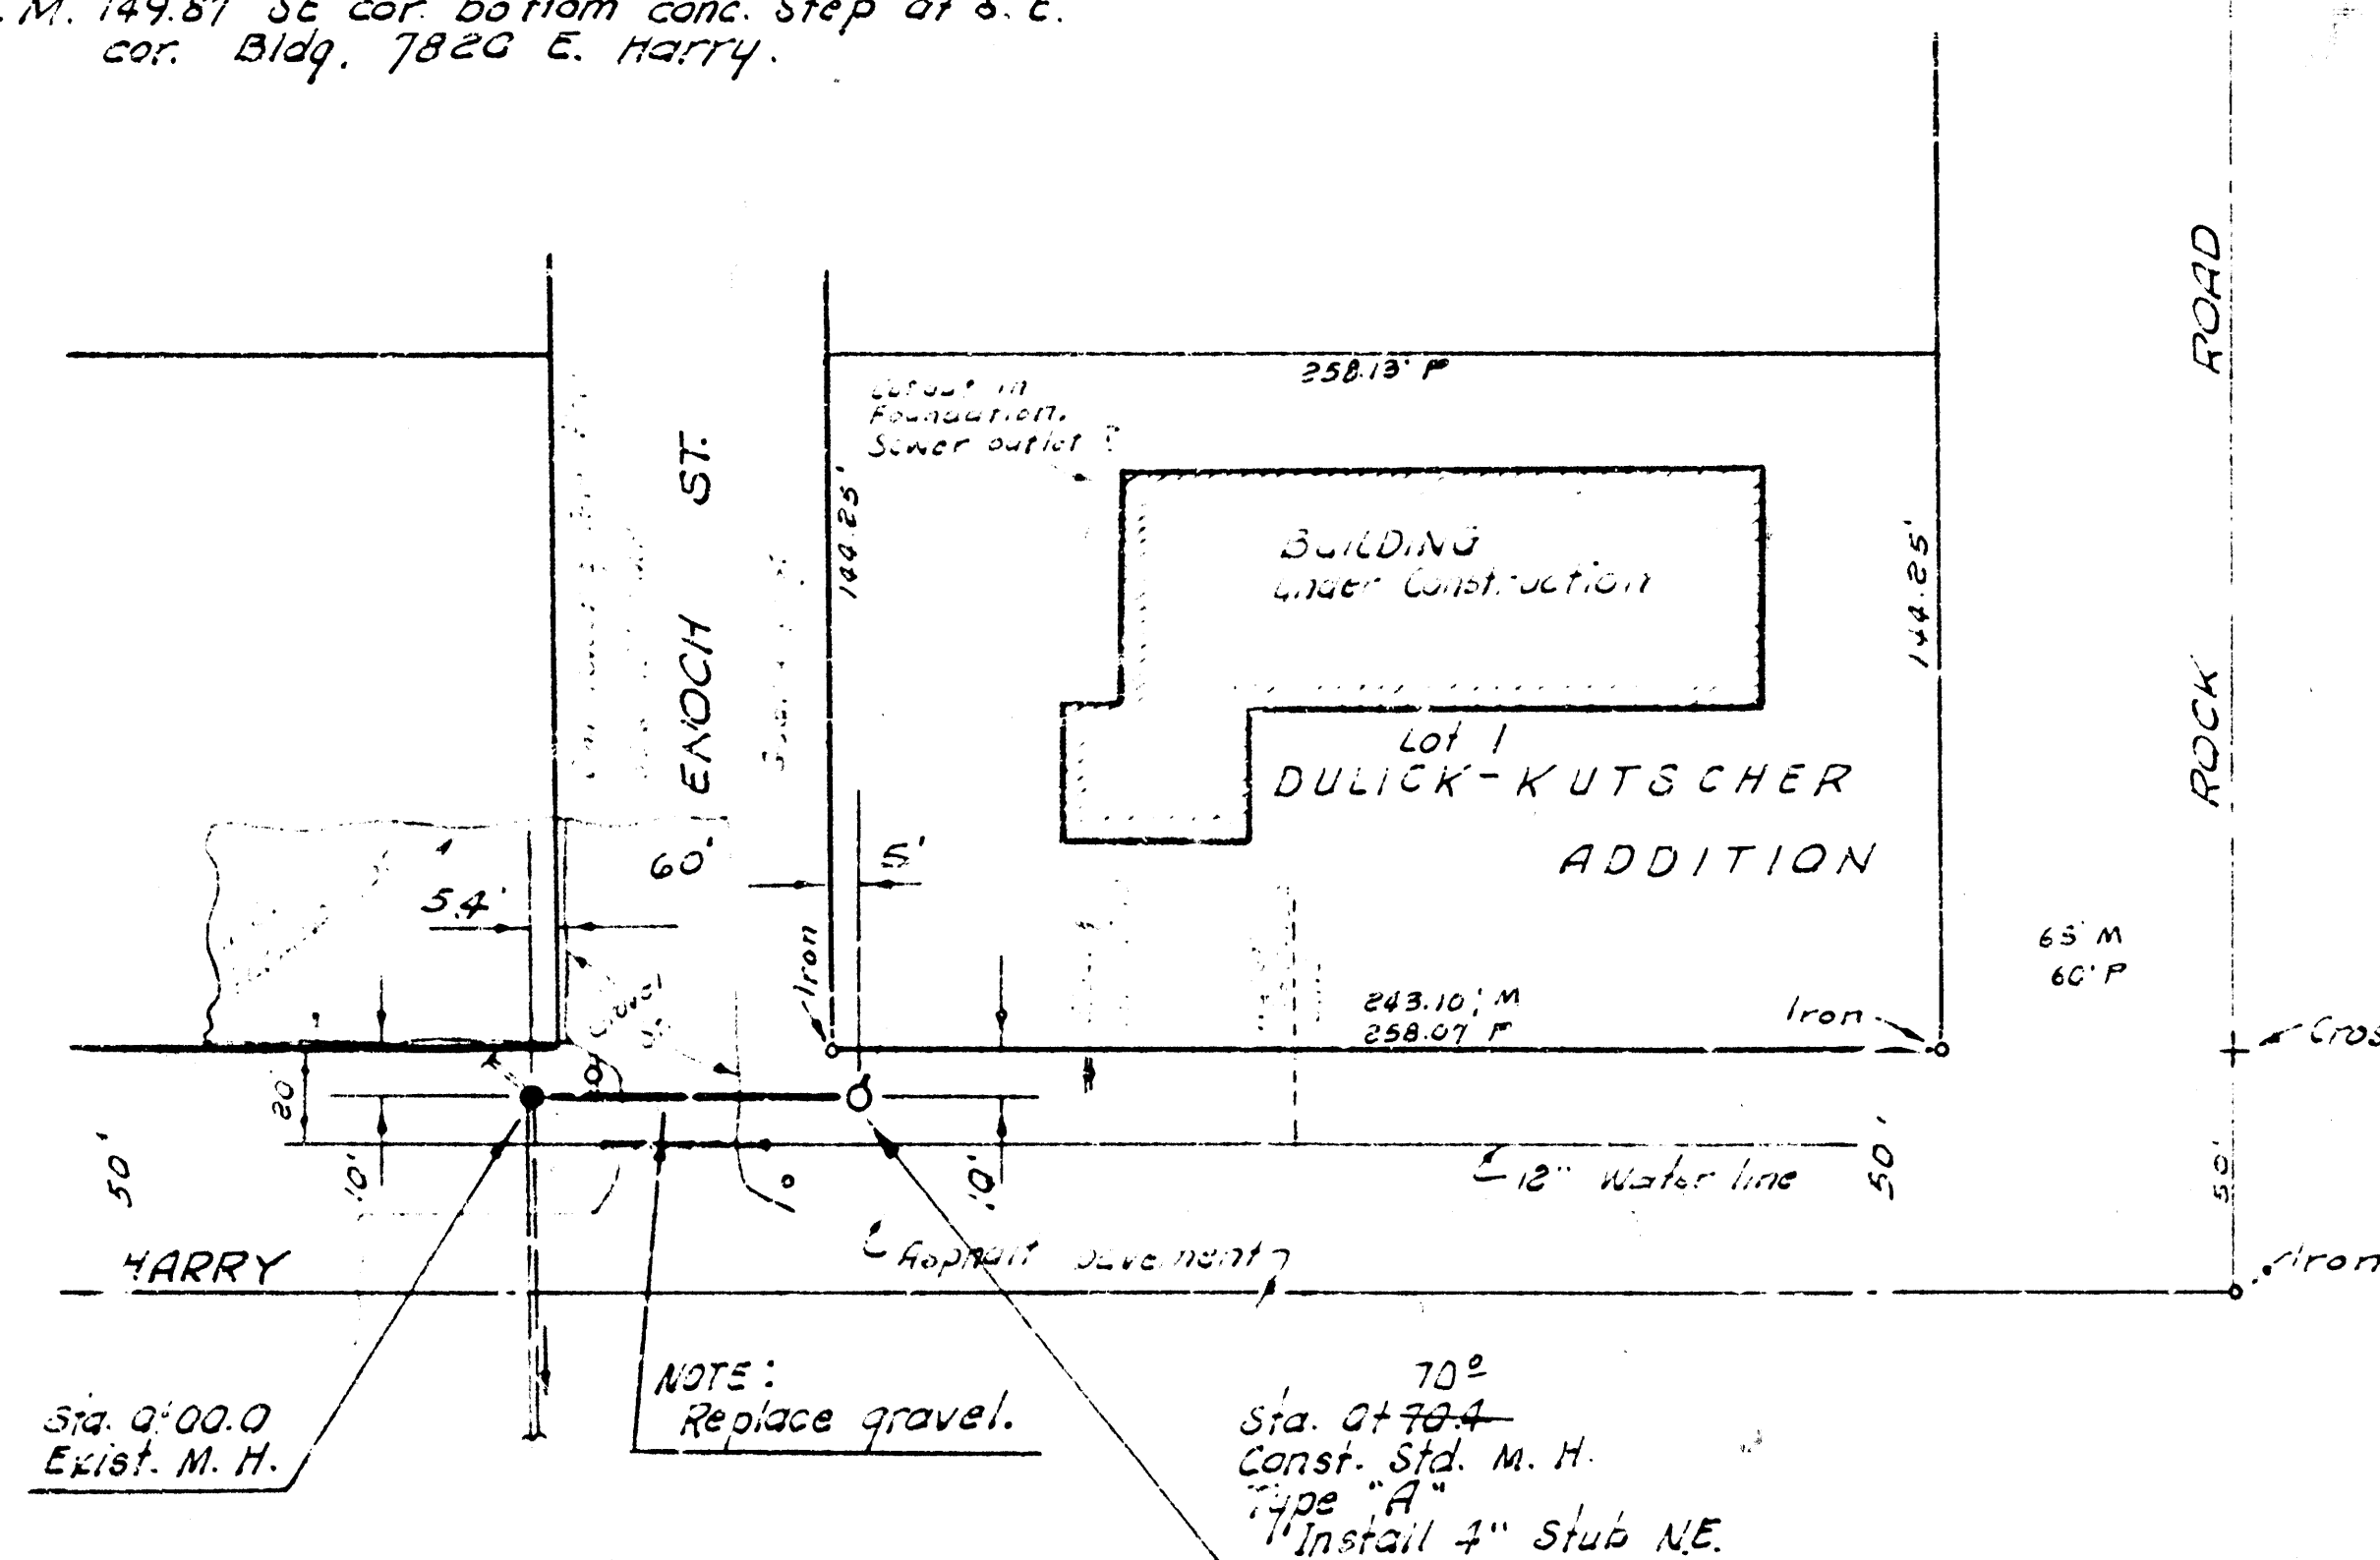

**LAT. 8, MAIN 16, WAR INDUSTRIES SEWER**  
CITY OF WICHITA, KANSAS  
R. W. LINN - CITY ENGINEER  
FEB. 1973. PROJECT NO. DBK L 512077