


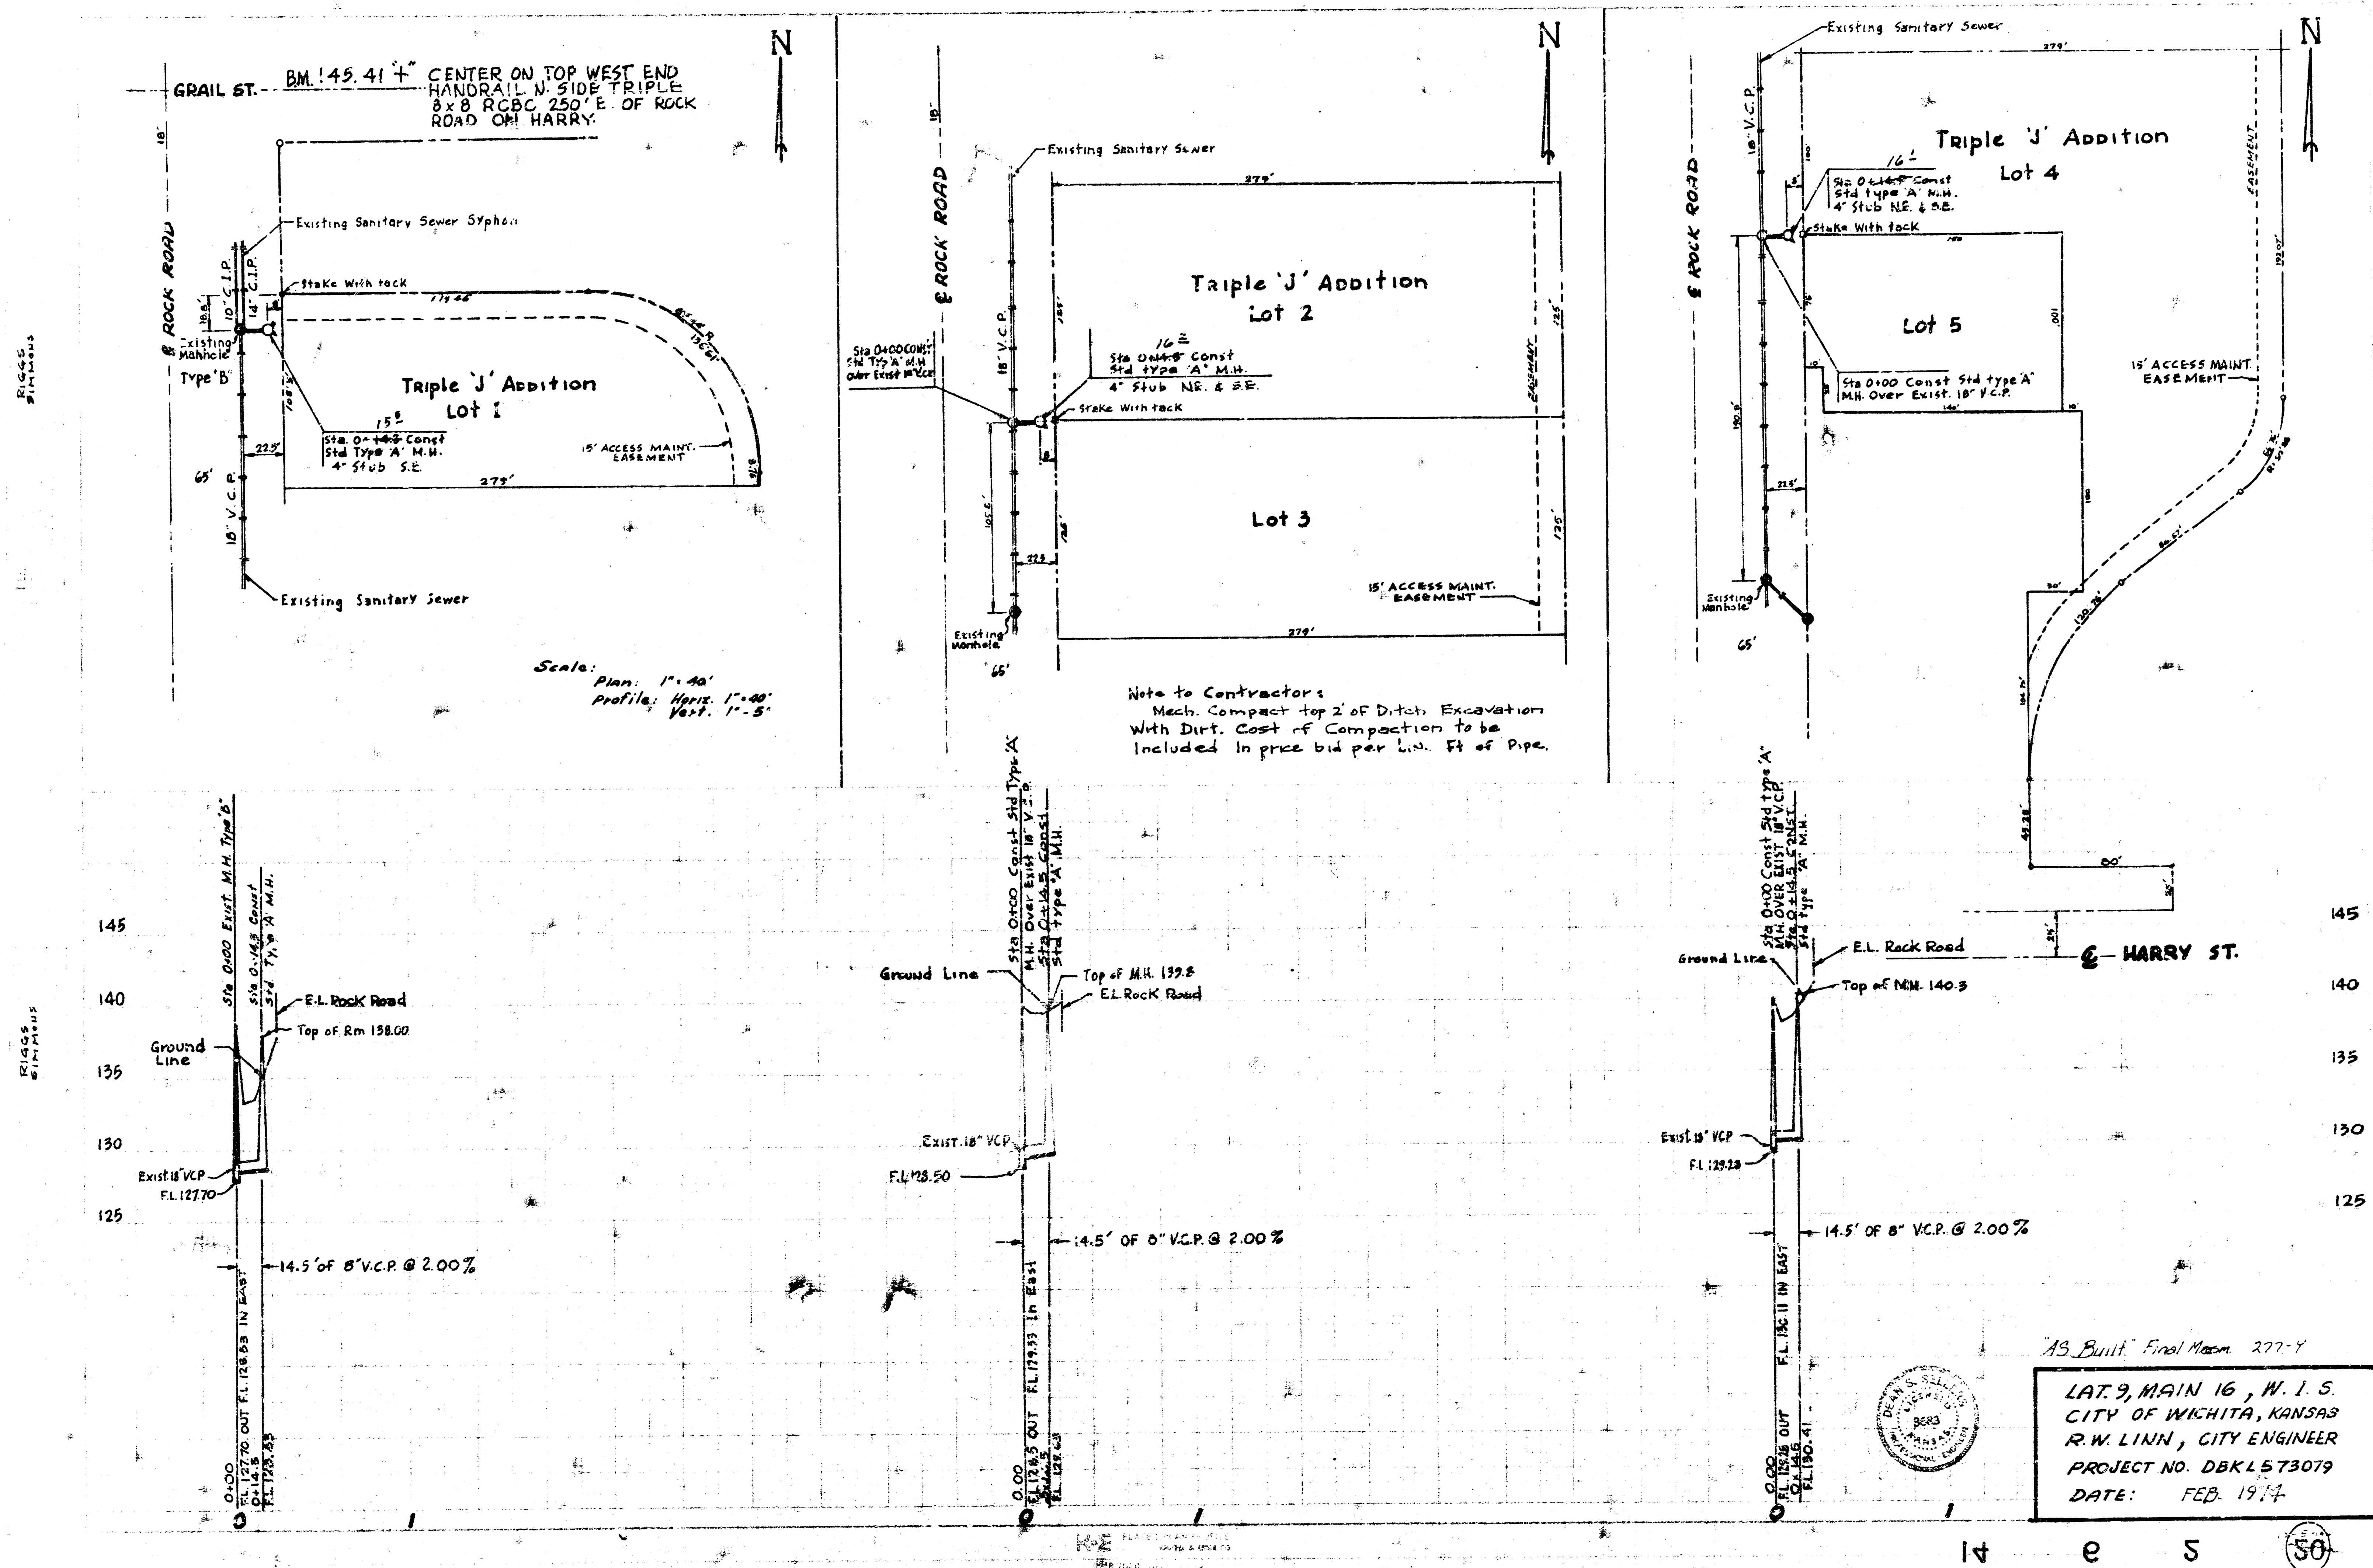

LAT. 9, MAIN 16, W. 1 S.
CITY OF WICHITA, KANSAS
R.W. LINN, CITY ENGINEER
PROJECT NO. DBK 1573079
DATE: FEB. 1974