655' N. of ℄ of Harry

411.15'

Proposed 8"

Proposed P.O. 150' Utility Easement

Sta 5+42.5

Const Std. Type 'A' or 'C' Manhole

Install 8" Stub So.

Sta 2+70.5

Const Std. Type 'A' or 'C' Manhole

IRON 30' LT. W.L. ENOCH VACATED

IRON 30' LT. S.L. BOSTON VACATED

IRON

IRON 30' LT. E.L. LONGFELLOW

8'

Sta 6+93.0

End 8" Pipe Plug Pipe

BOSTON

135'

20' Easement

Install 35 Lin. Ft. of 16" Steel Casing Use Boring & Jacking Method See Detail.

Sta 0+00 Exist Manhole

Exist. 18" Sewer

Casing Detail

16" Steel Casing 0.219" Wall

Casing to be Pumped full of Sand

Strap 8" Pipe to Creosoted Wood Blocks.

ROCK RD.

Lot 5

CAPTAIN'S

FIRST

ADDITION

B.M. 1454.1 Chiseled "X" in Ctr. of top W End Handrail N.S. Triple 8x8 R.C.B. 250' East of Rock Rd. on Harry.

Note

Pipe Plug to be Temporary Type. Cost Incidental to Project.


Scale

Plan 1"=40'

Profile

HORT. 1"=40'

VERT. 1"=5'

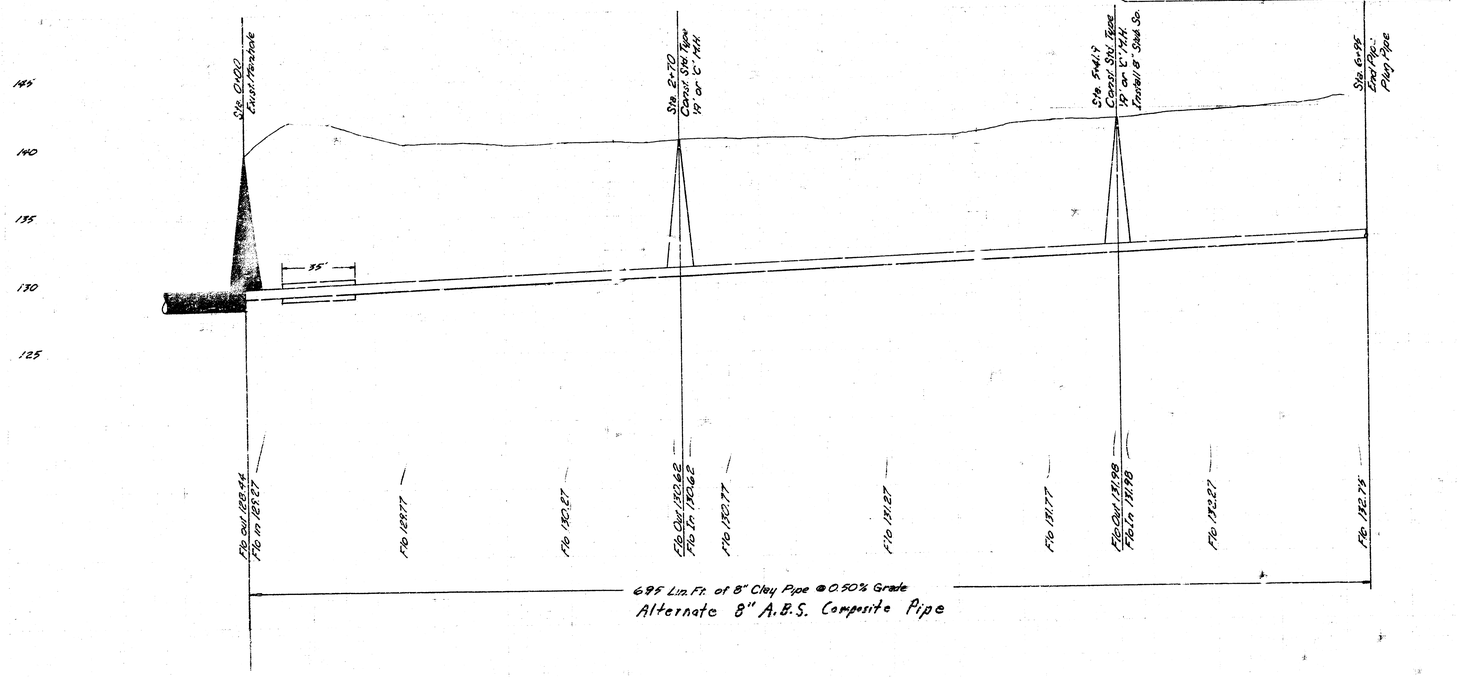

As Built 12-16-75

LAT. 12, MAIN 16, W.I.S.

CITY of WICHITA, KANSAS

R.W. LINN — CITY ENGINEER

Project DBKL575055

DATE Sept. 25, 1975