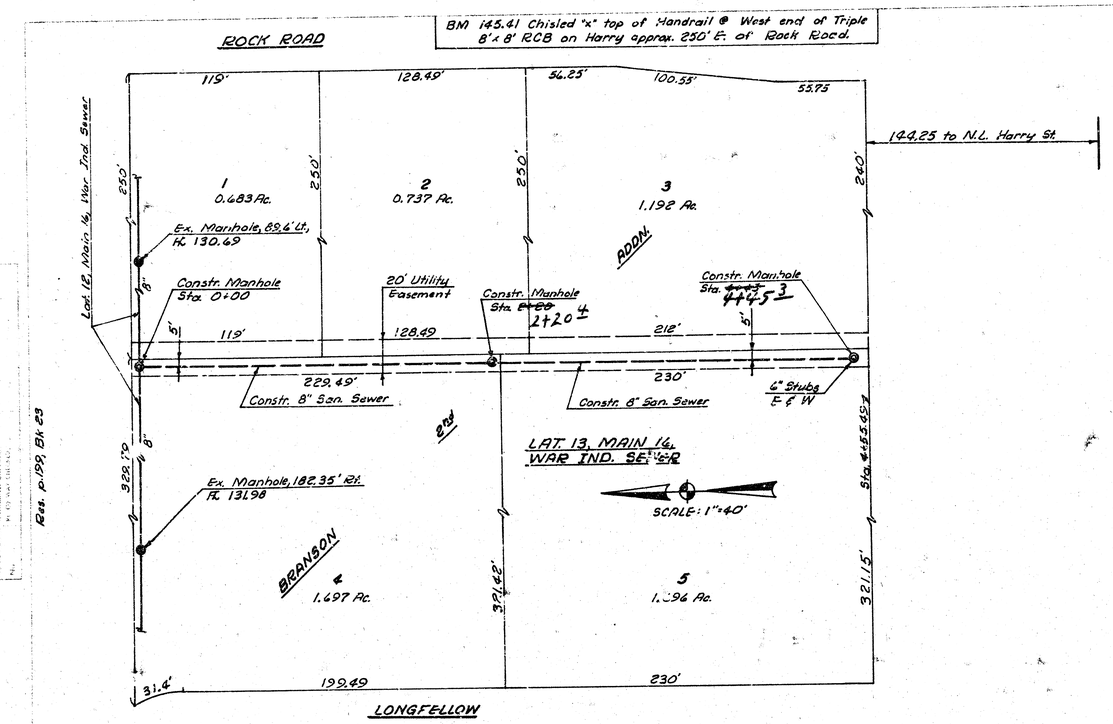

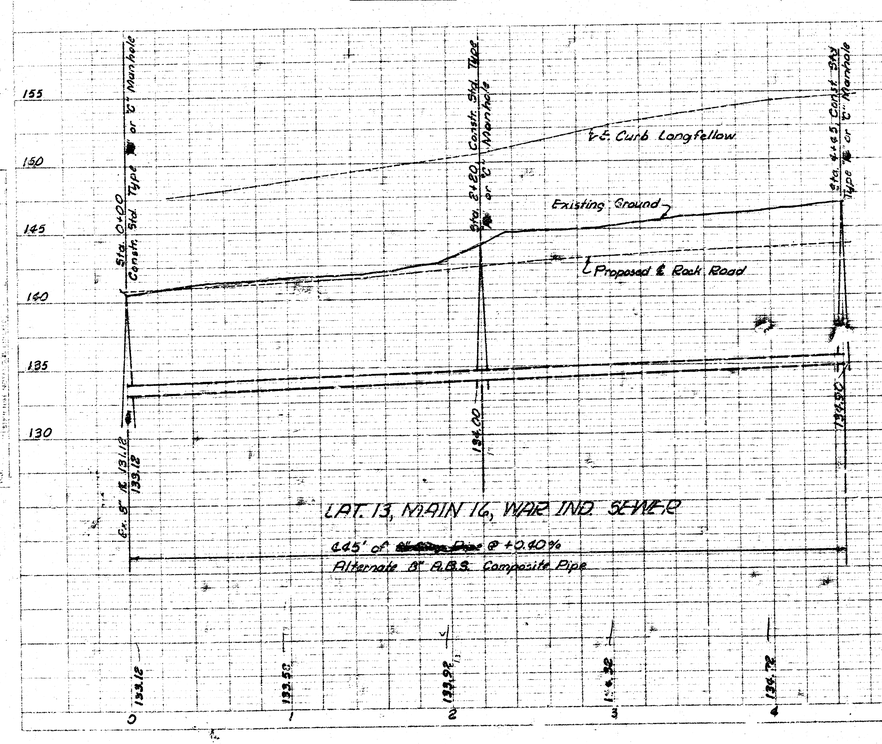

As built 6-28-77

LAT 13, MAIN 16, W.I.S.
CITY OF WICHITA, KANSAS
R.W. LINN-CITY ENGINEER
Project DBKL 575080
DATE June 1977 Sheet 1 of 1

Ref. p. 199, Bk 23

DOC. 112 (Lat 13) W.S.K.

PLAN

PROFILE

PLATE 1-SINGLE PLAN AND PROFILE E-FULL LINE
TELCOMP NATIONAL TRACING INKS
INDIANAPOLIS, INDIANA PRINTED IN U.S.A.

DONALD L. SCHNEIDER LICENSED 6311 KANSAS PROFESSIONAL ENGINEER

1/1 2 4 10 14