


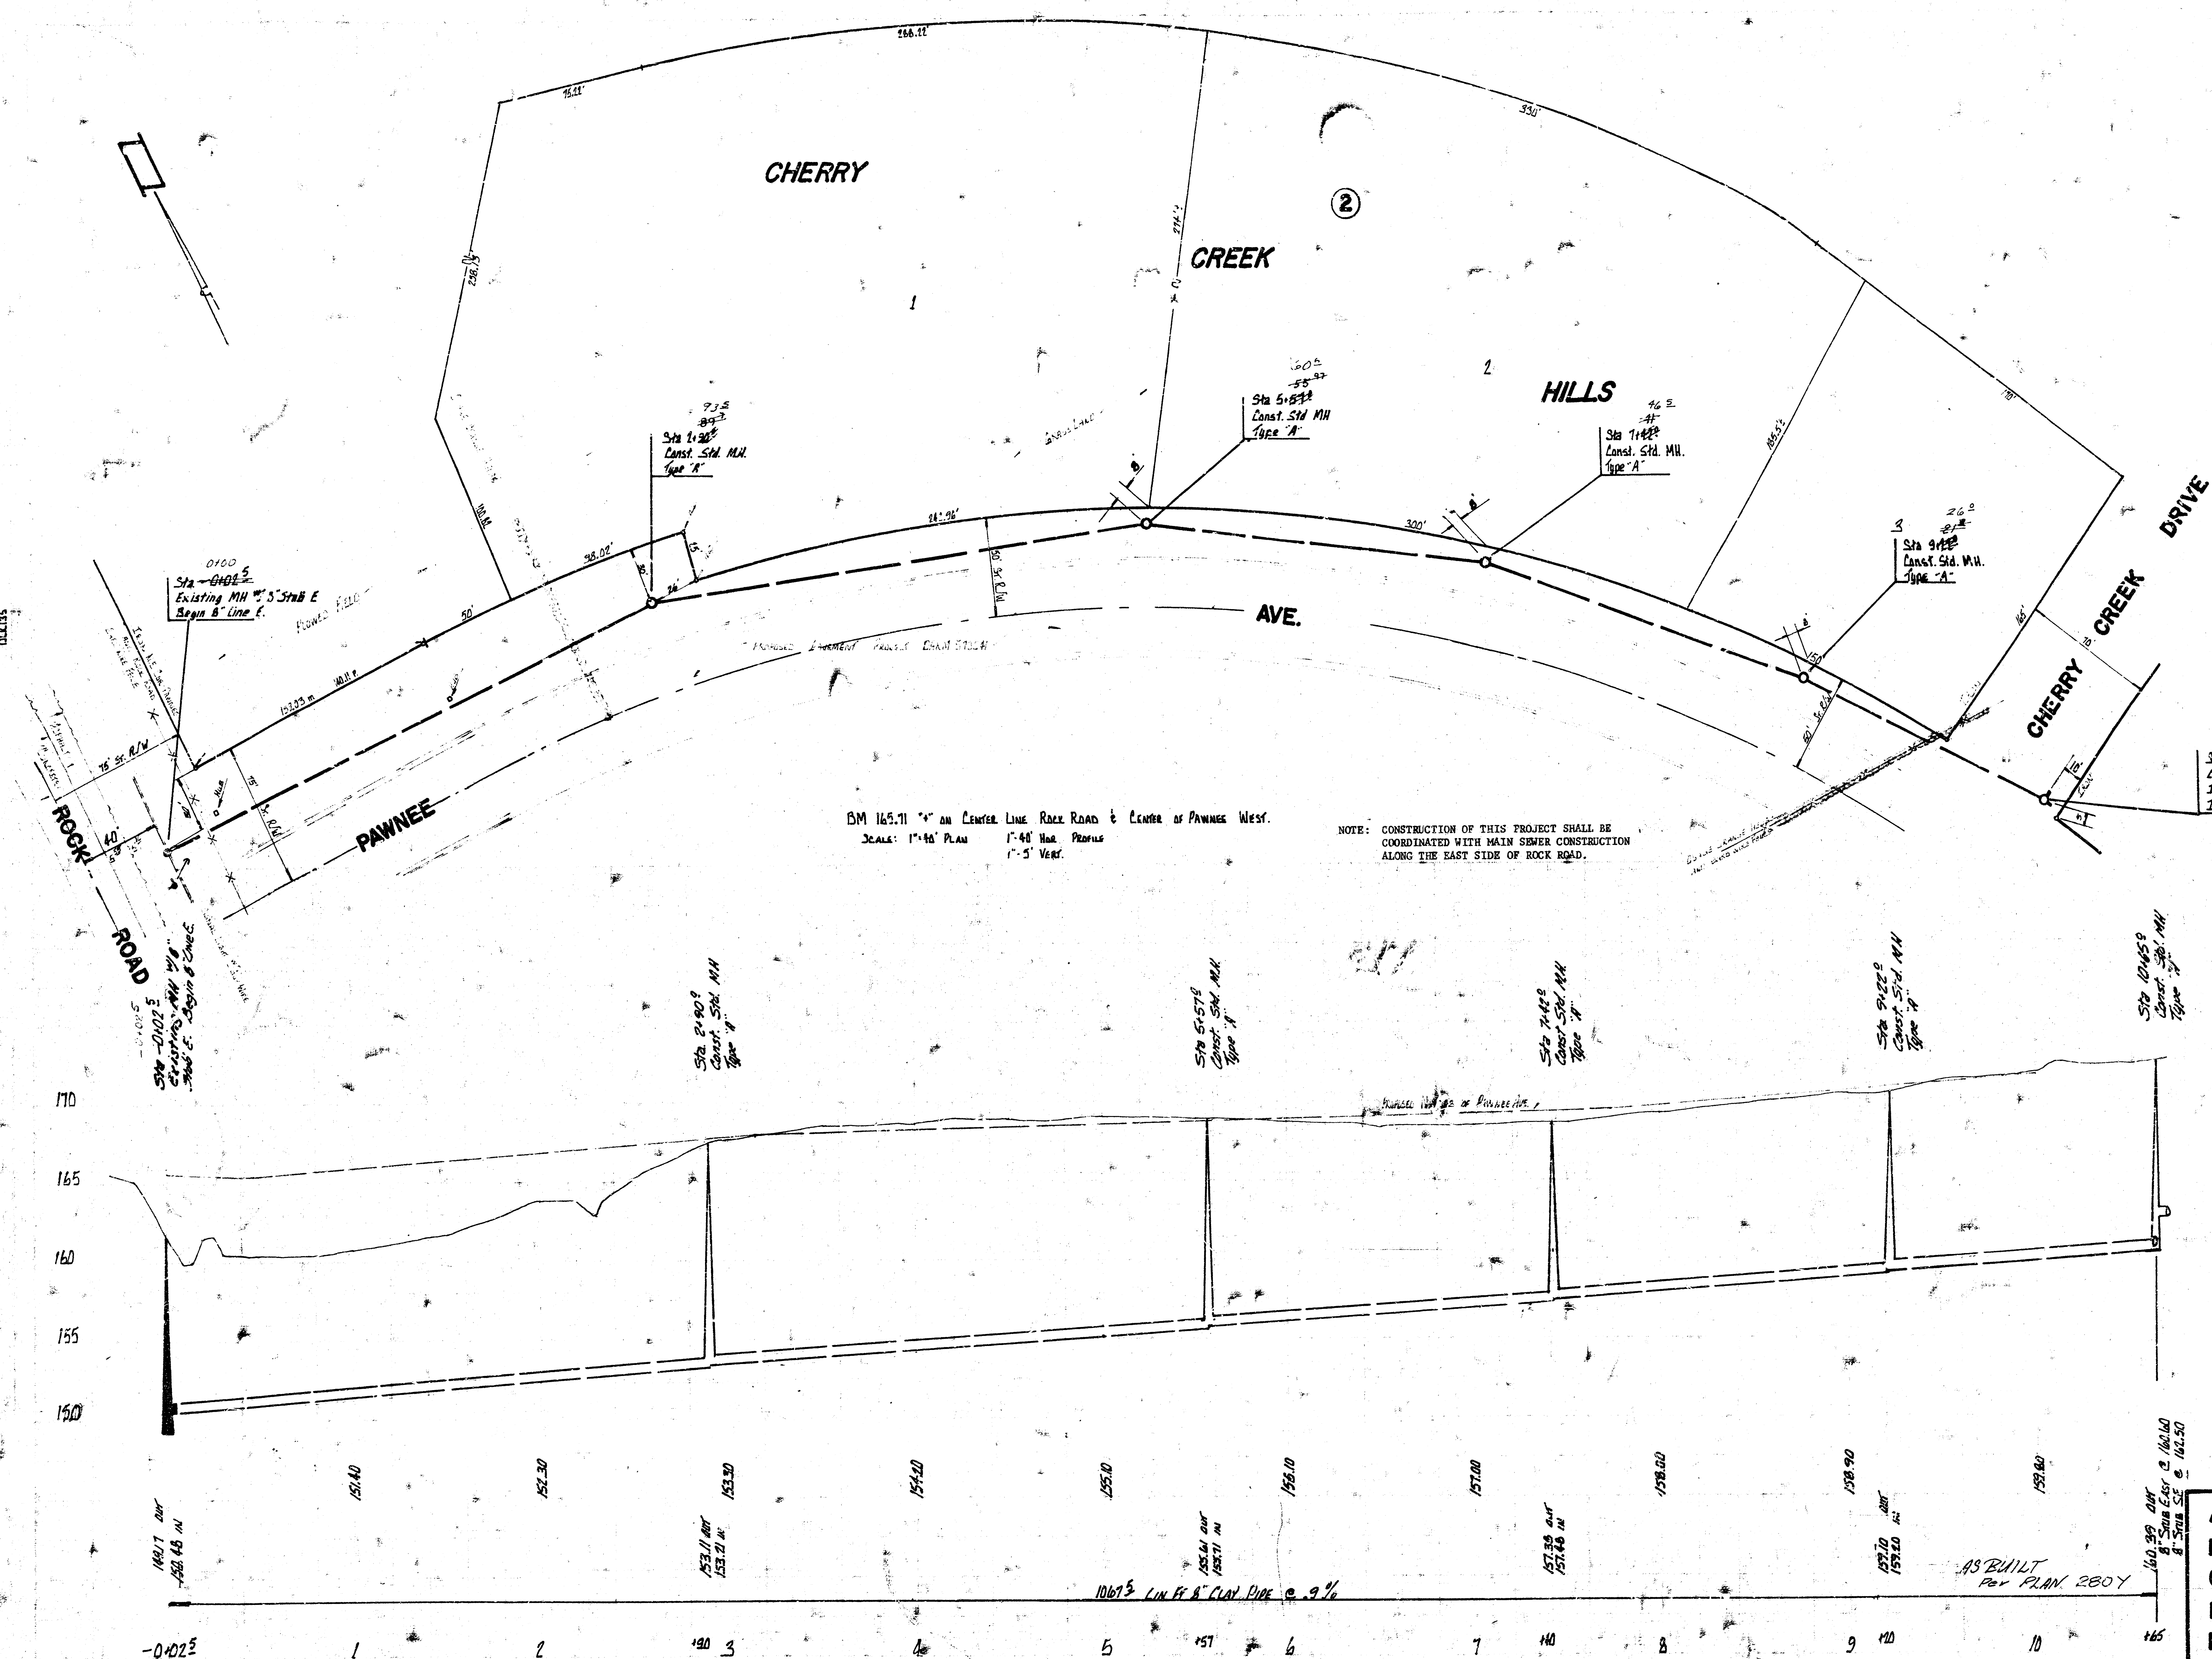

Lat. 1, Main 17, W.I.S.
 R.W. LINN City Engineer
 City of Wichita, Kansas
 Date: July 1973
 Project No. DBK1-573012