




B. M. 171.69 R. R. Spk. N. face
Osage Orange hedge SW cor.
Cherry Creek Dr. & Lori Ln.

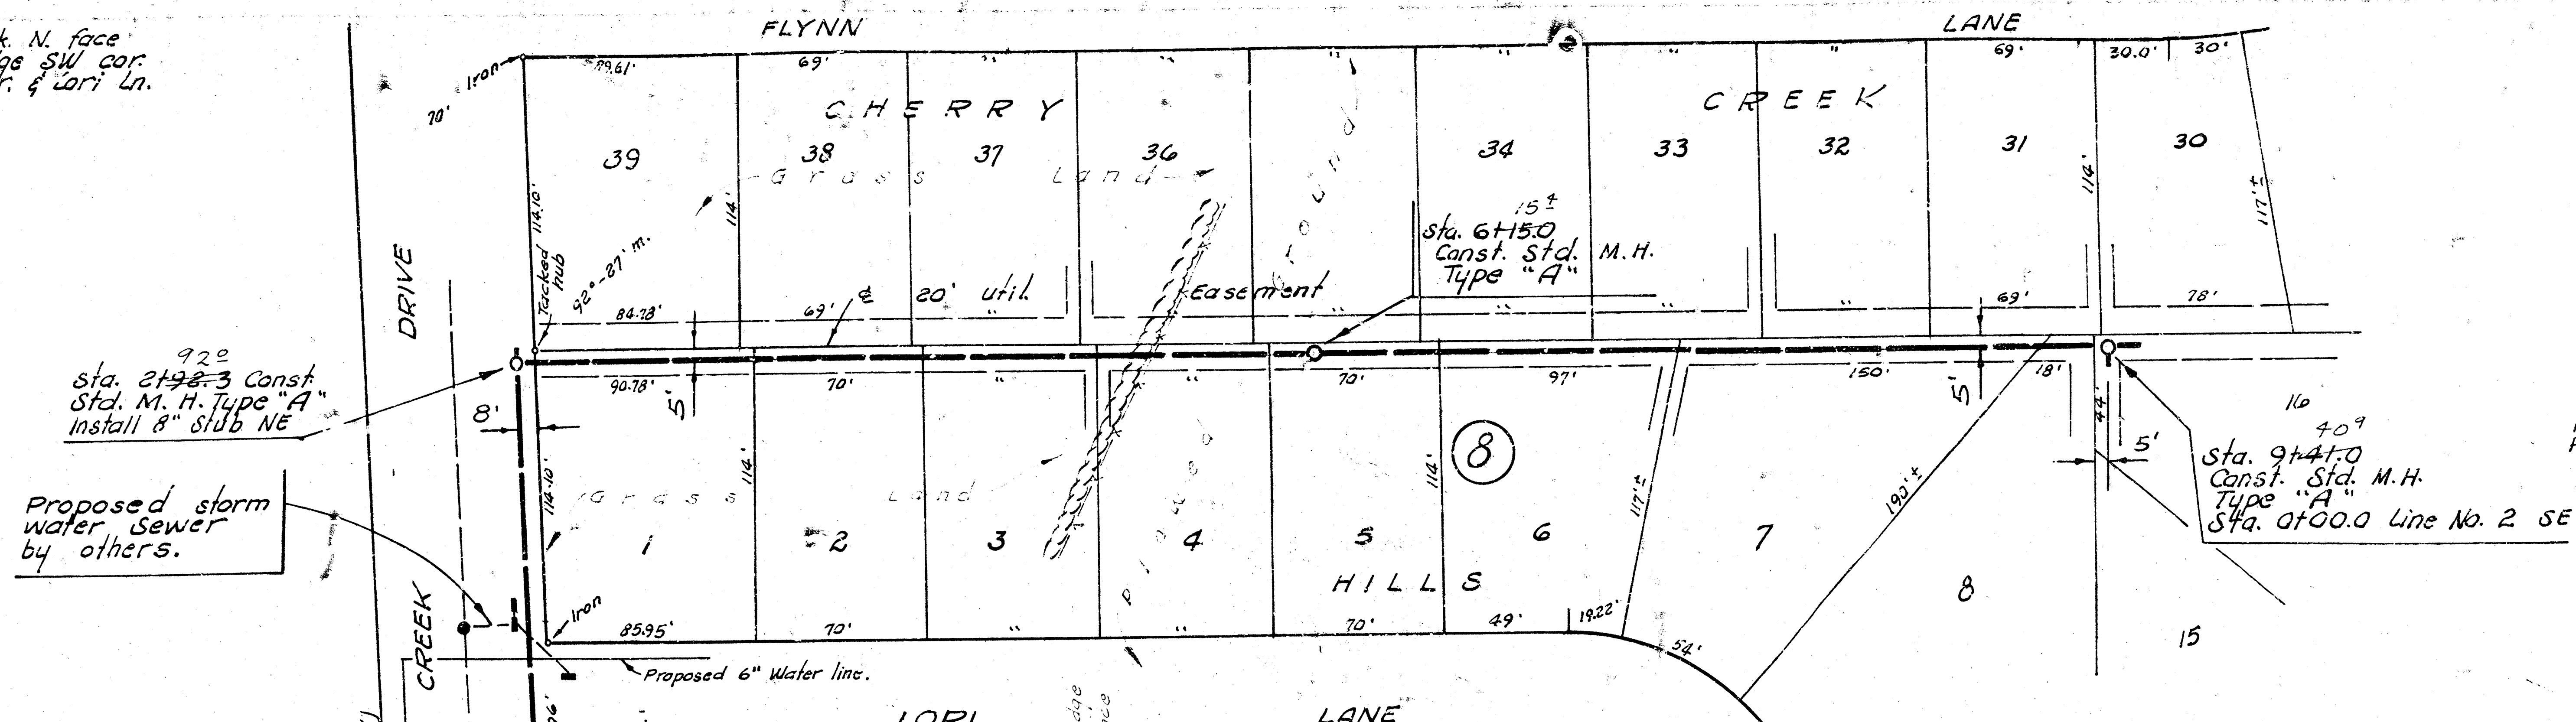

Plan Scale 1" = 40'
Profile Scale 1" = 40' Horiz.
1" = 5' Vert.

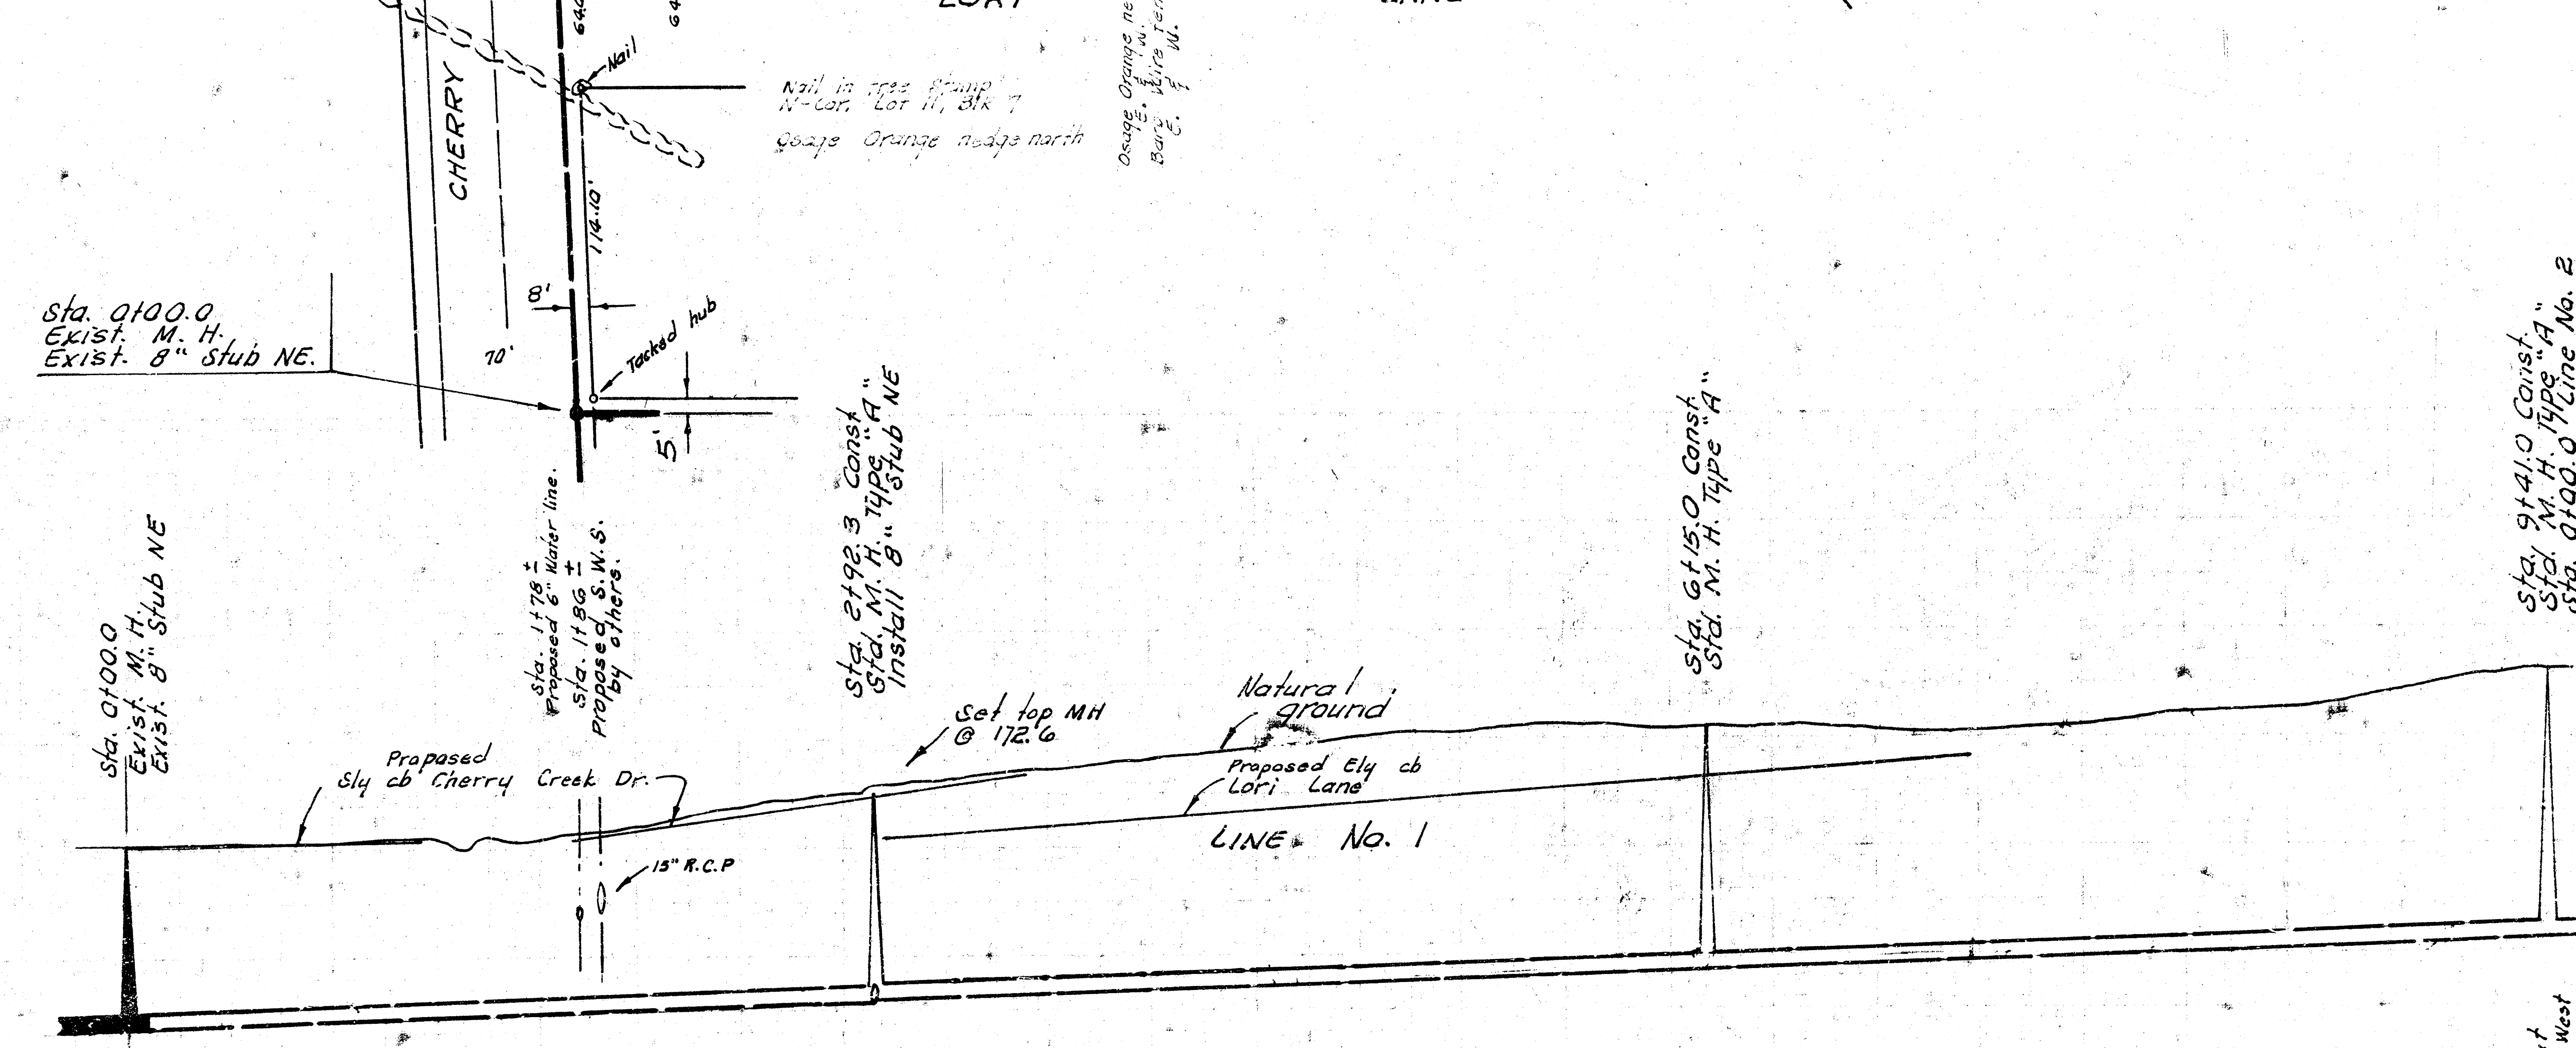


NOTE: CONSTRUCTION OF THIS PROJECT SHALL BE COORDINATED WITH MAIN SEWER CONSTRUCTION ALONG THE EAST SIDE OF ROCK ROAD.

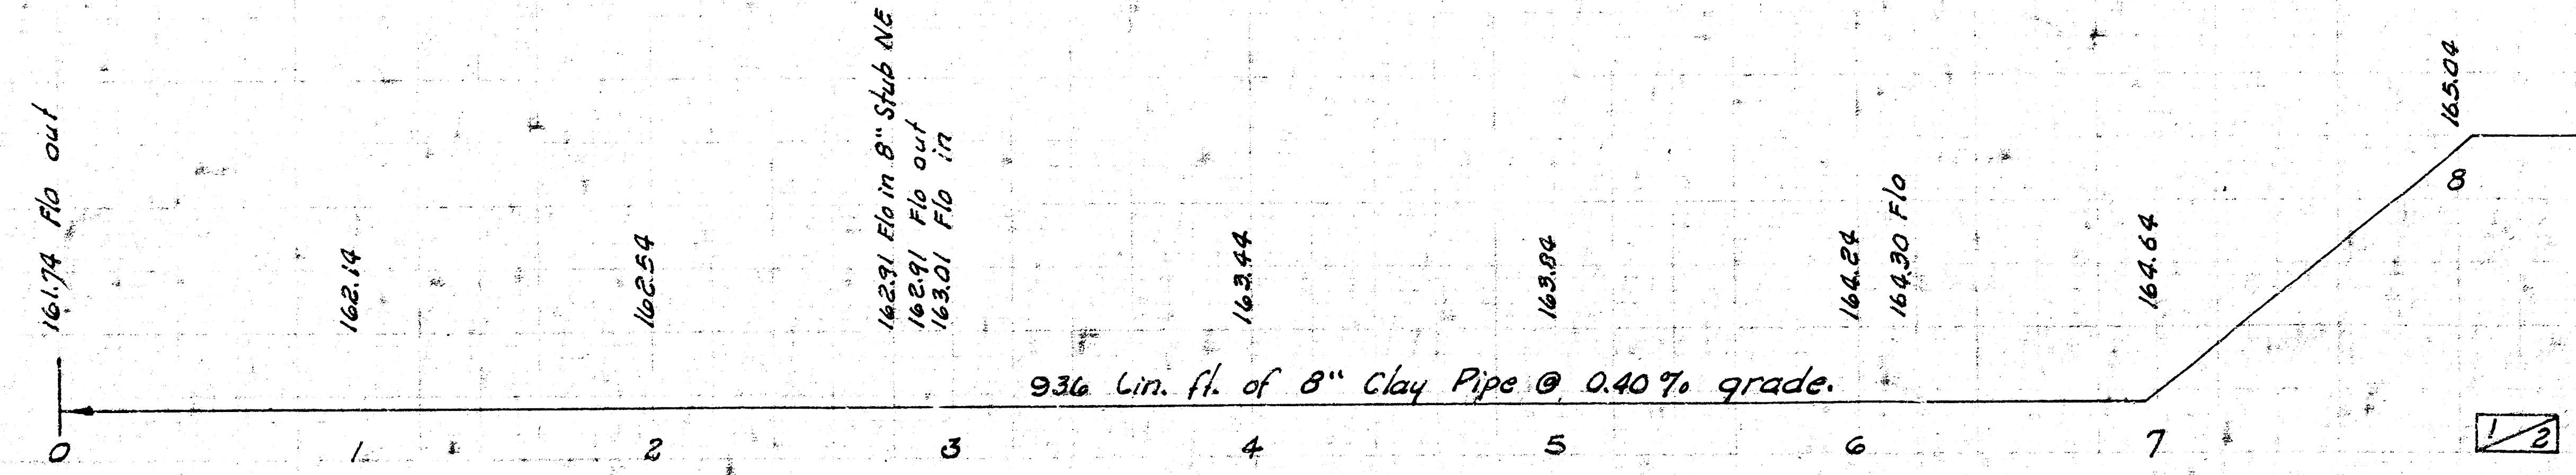

LAT. 4, MAIN 17, W. I. S.
CITY OF WICHITA, KANSAS
R. W. LINN — CITY ENGINEER
JULY 1973 PROJECT NO. DBKL573015



1/2

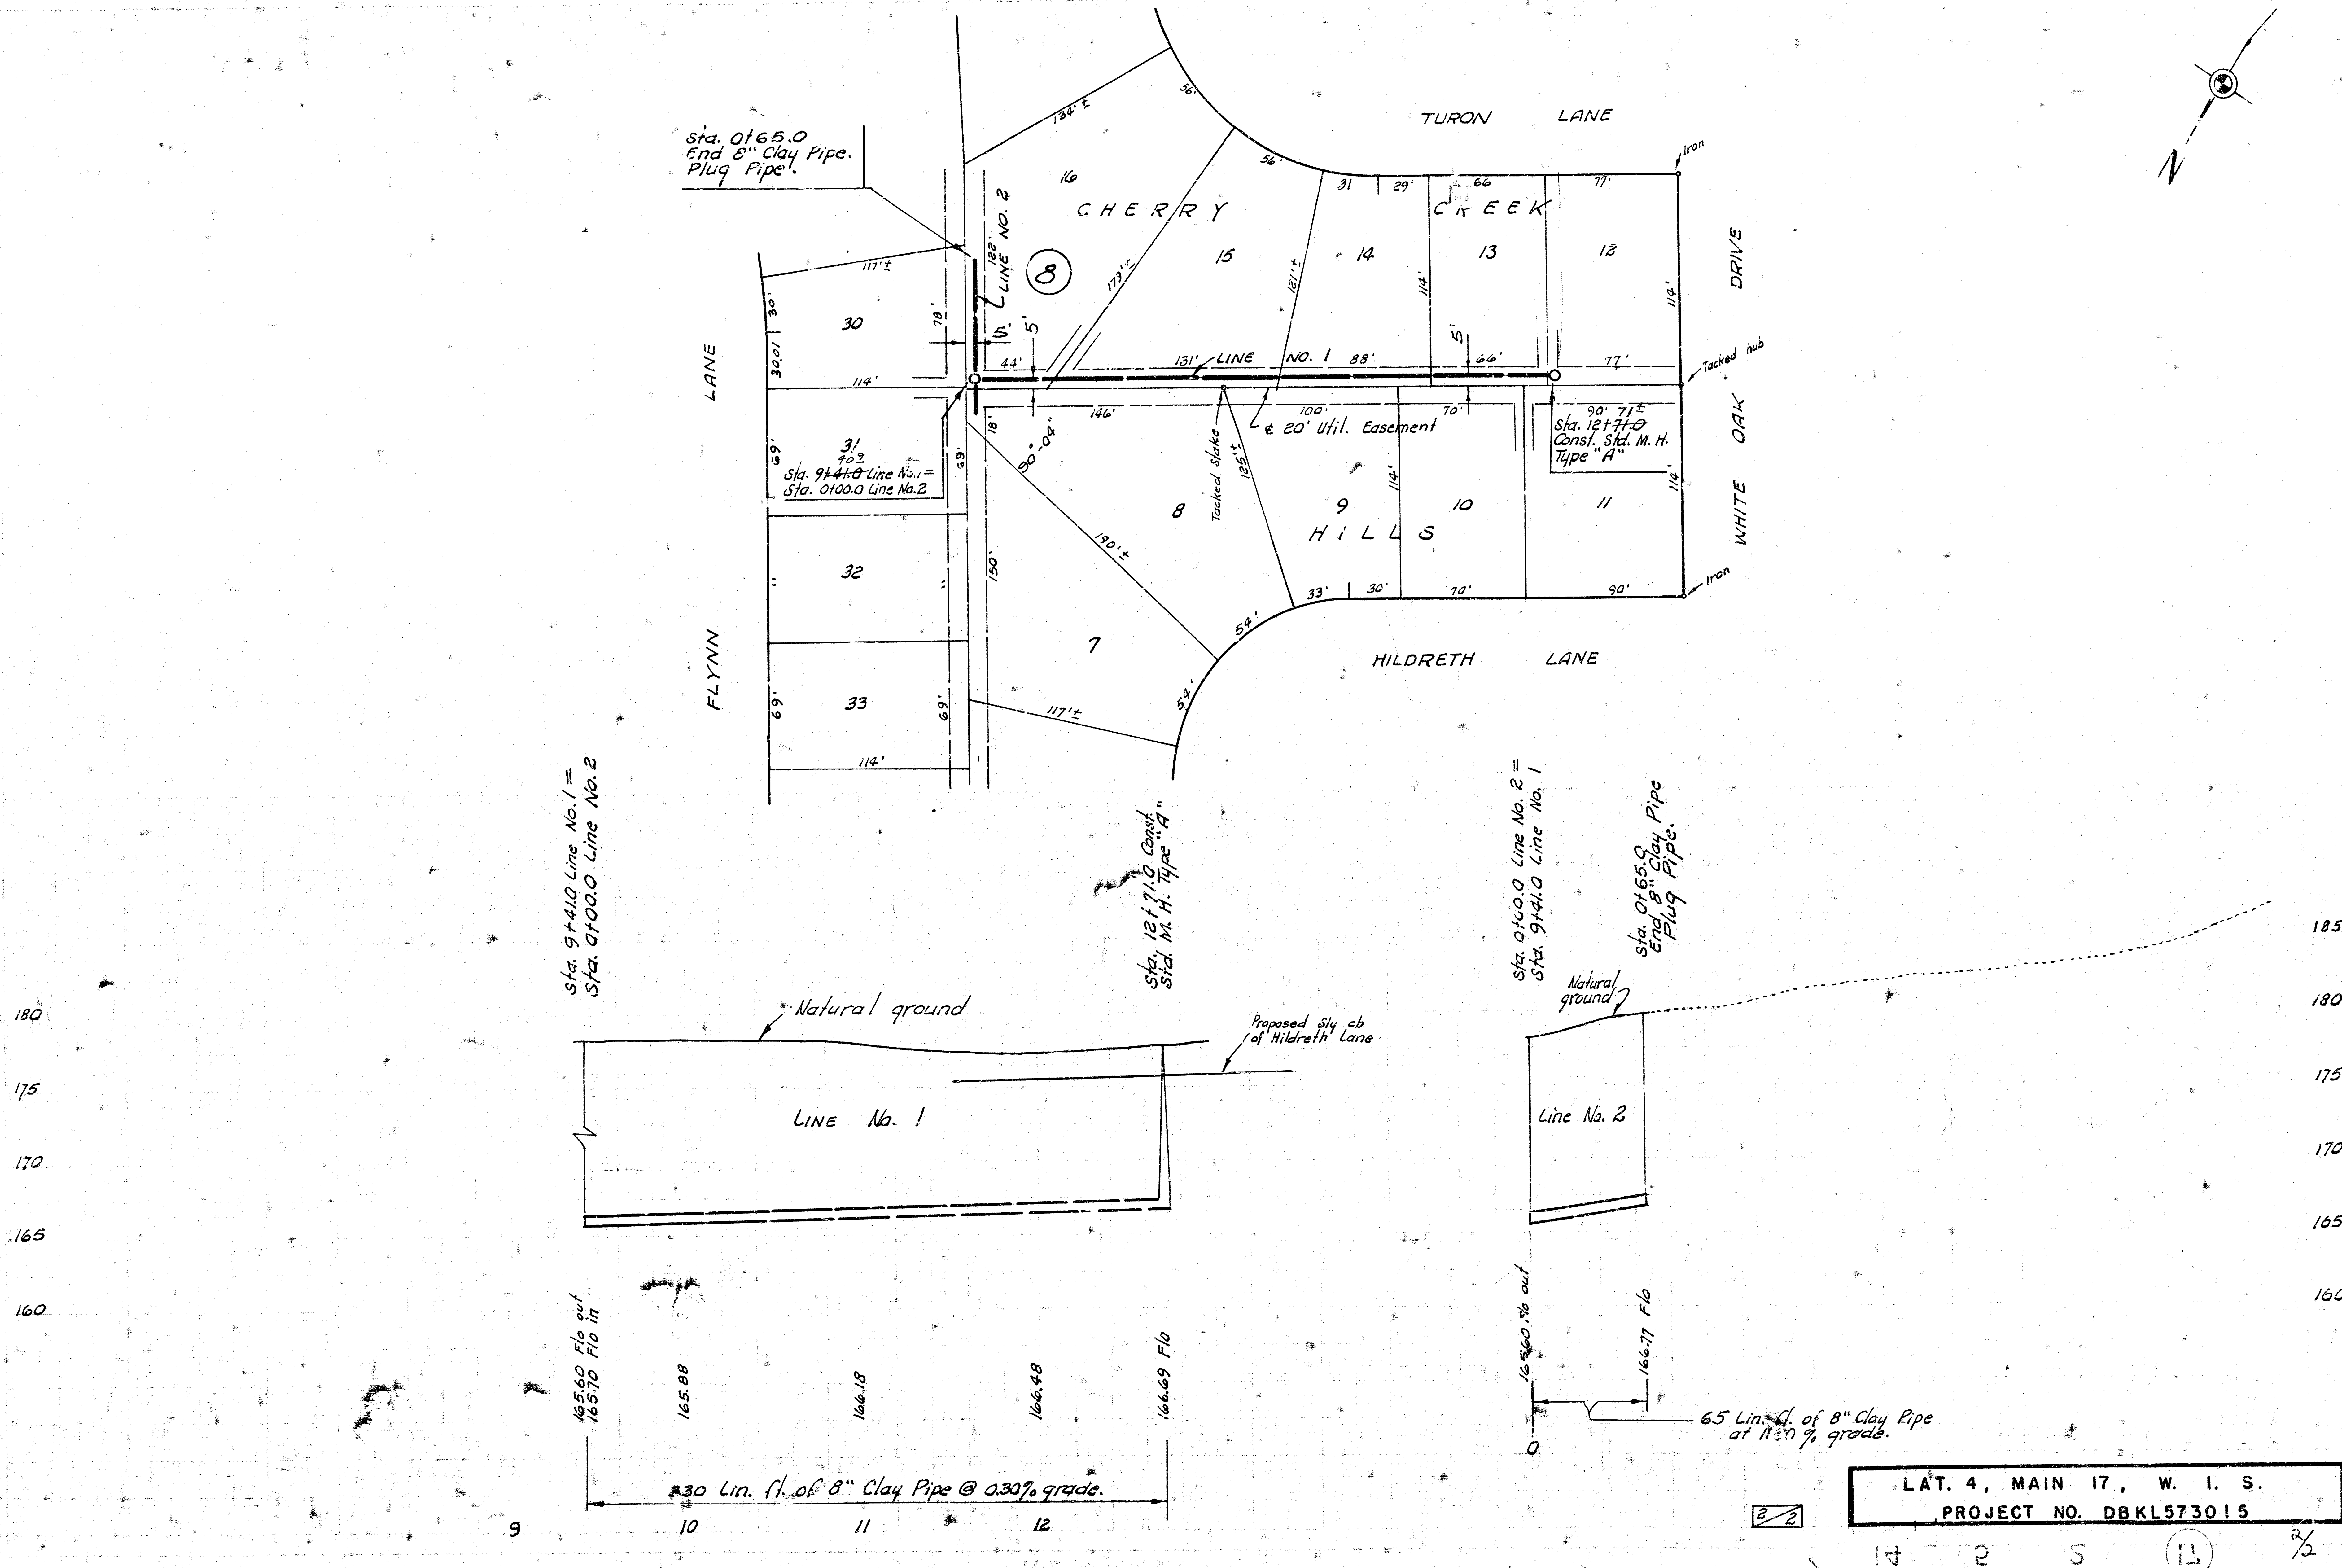

LAT. 4, MAIN 17, W. I. S.
PROJECT NO. DBKL573015

2/2

11

2/2