

3. M. 1.71.69 R. P. Spk. N. face
Osage Orange hedge SW cor.
Cherry Creek Dr. & Lori Ln.

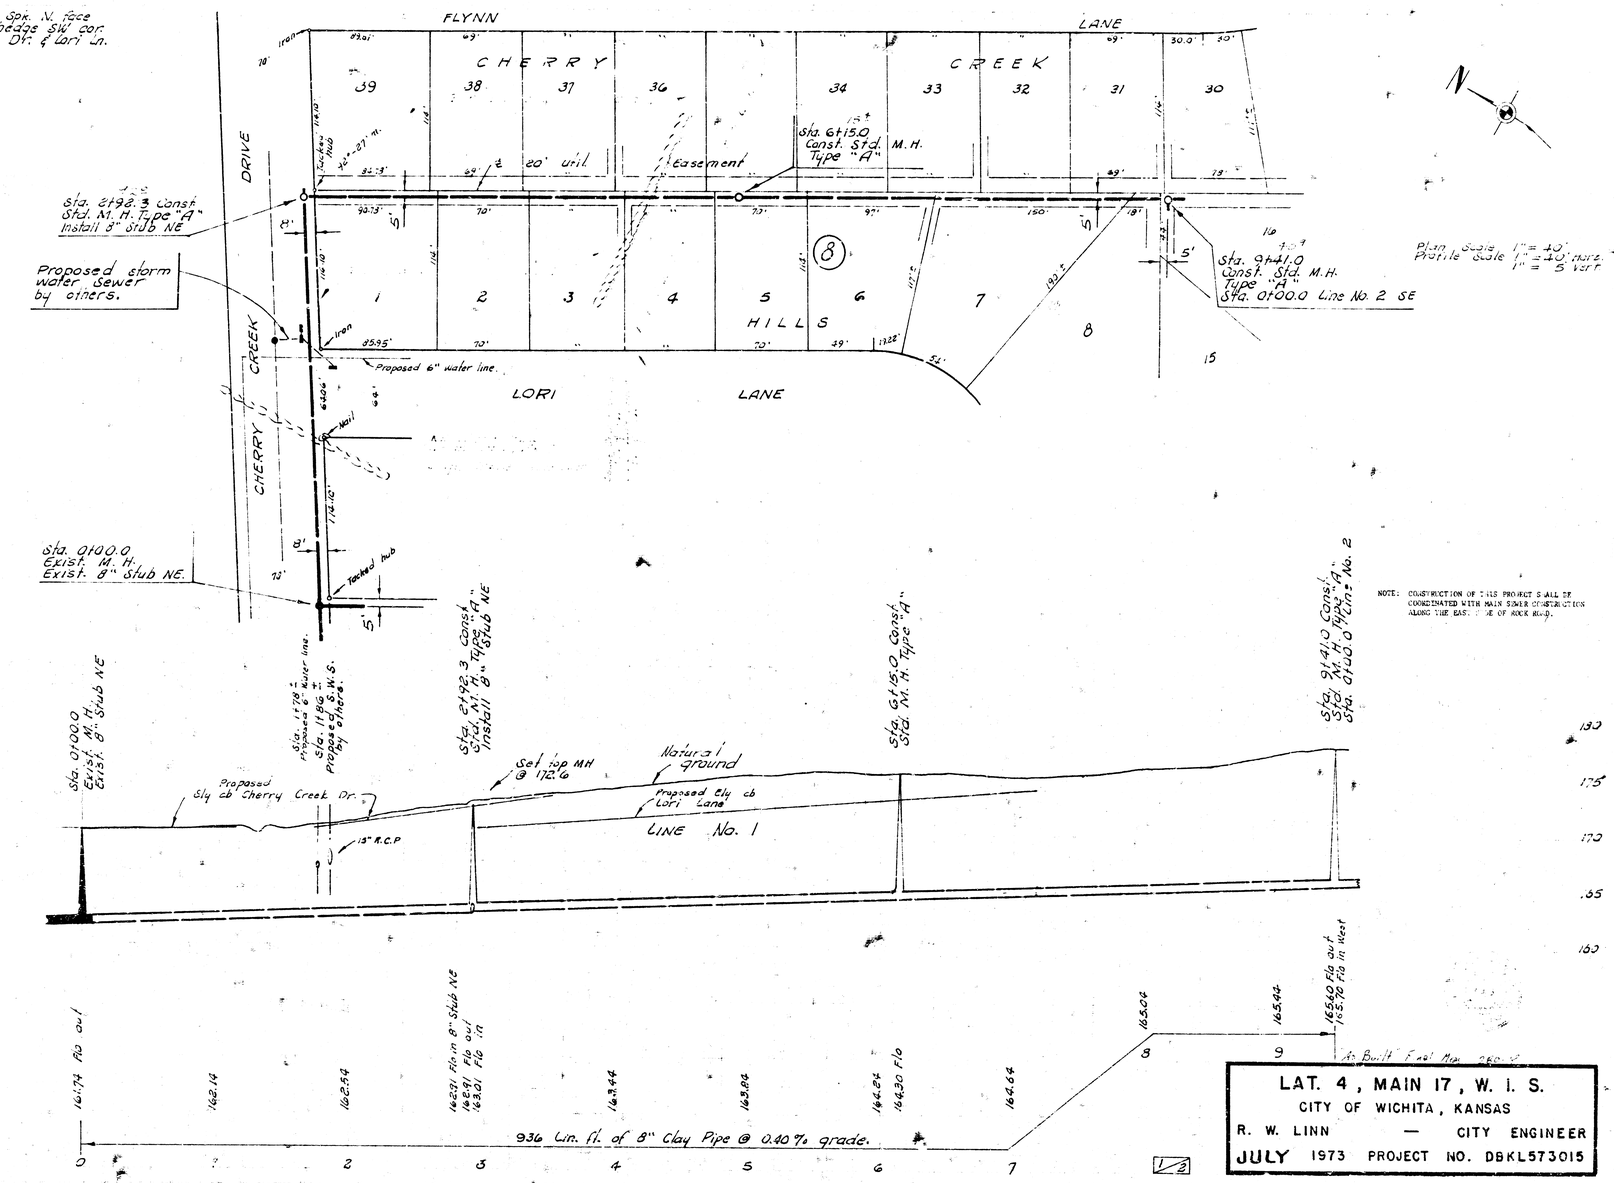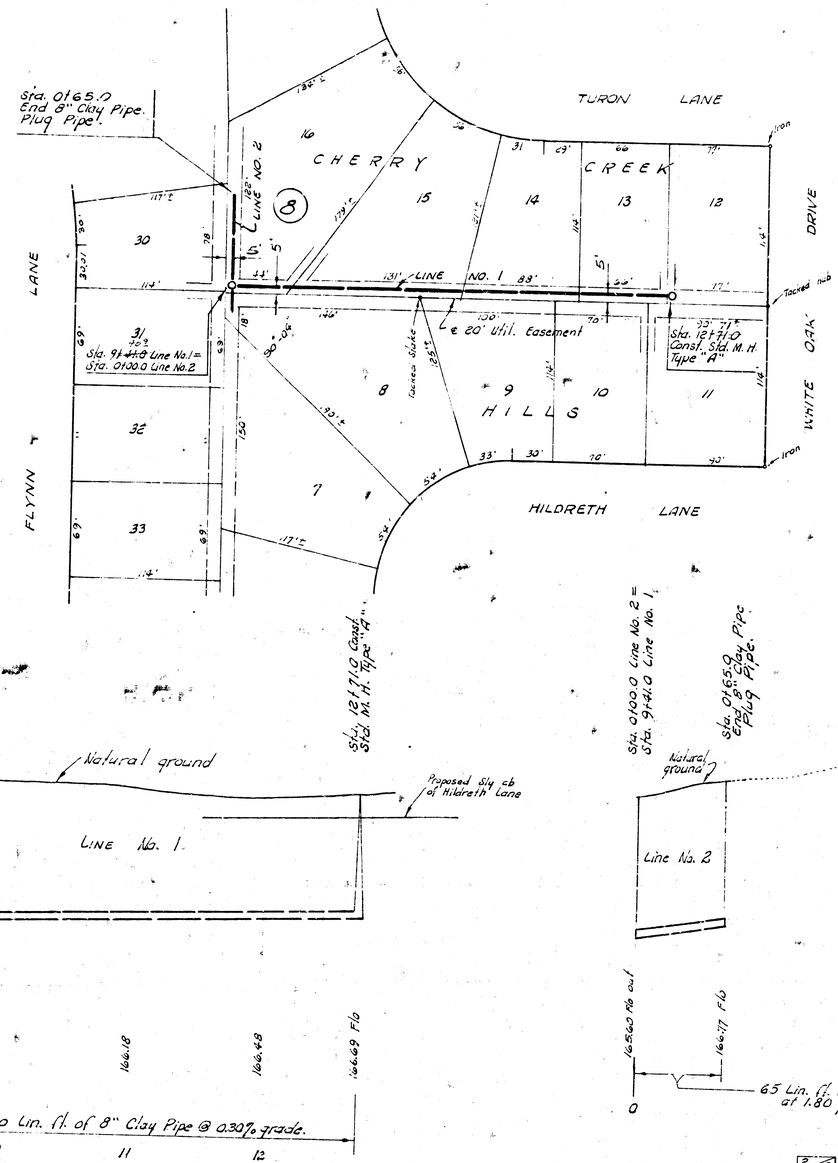

LAT. 4, MAIN 17, W. I. S.
CITY OF WICHITA, KANSAS
R. W. LINN — CITY ENGINEER
JULY 1973 PROJECT NO. DBKL573015



Sta. 0165.0
End 8" Clay Pipe
Plug Pipe.
TURON LANE
CHERRY CREEK DRIVE
FLYNN LANE
WHITE OAK
HILDRETH LANE
LINE NO. 1
LINE NO. 2
Tacked hub
Tacked Stake
Iron
Sta. 94+4.0 Line No.1 = Sta. 0100.0 Line No.2
Sta. 121+7.0 Line No.1
Const. Std. M.H. Type "A"
20' Util. Easement
Sta. 94+4.0 Line No.1 = Sta. 0100.0 Line No.2
Sta. 121+7.0 Const. Std. M.H. Type "A"
Natural ground
Proposed Sty cb of Hildreth Lane
LINE No. 1.
165.66 Flo out
165.70 Flo in
165.88
166.18
166.48
166.69 Flo
330 Lin. ft. of 8" Clay Pipe @ 0.30% grade.
Sta. 0100.0 Line No. 2 = Sta. 94+4.0 Line No. 1
Sta. 0165.0 End 8" Clay Pipe Plug Pipe.
Natural ground
Line No. 2
165.60 Flo out
166.17 Flo
65 Lin. ft. of 8" Clay Pipe at 1.80 % grade.
LAT. 4, MAIN 17, W. I. S.
PROJECT NO. DBKL573015