


3. M. 171.69 R. P. Spk. N. face
 Jesse Orange, nee & SW cor.
 Cherry Creek Dr. & Lori Ln.


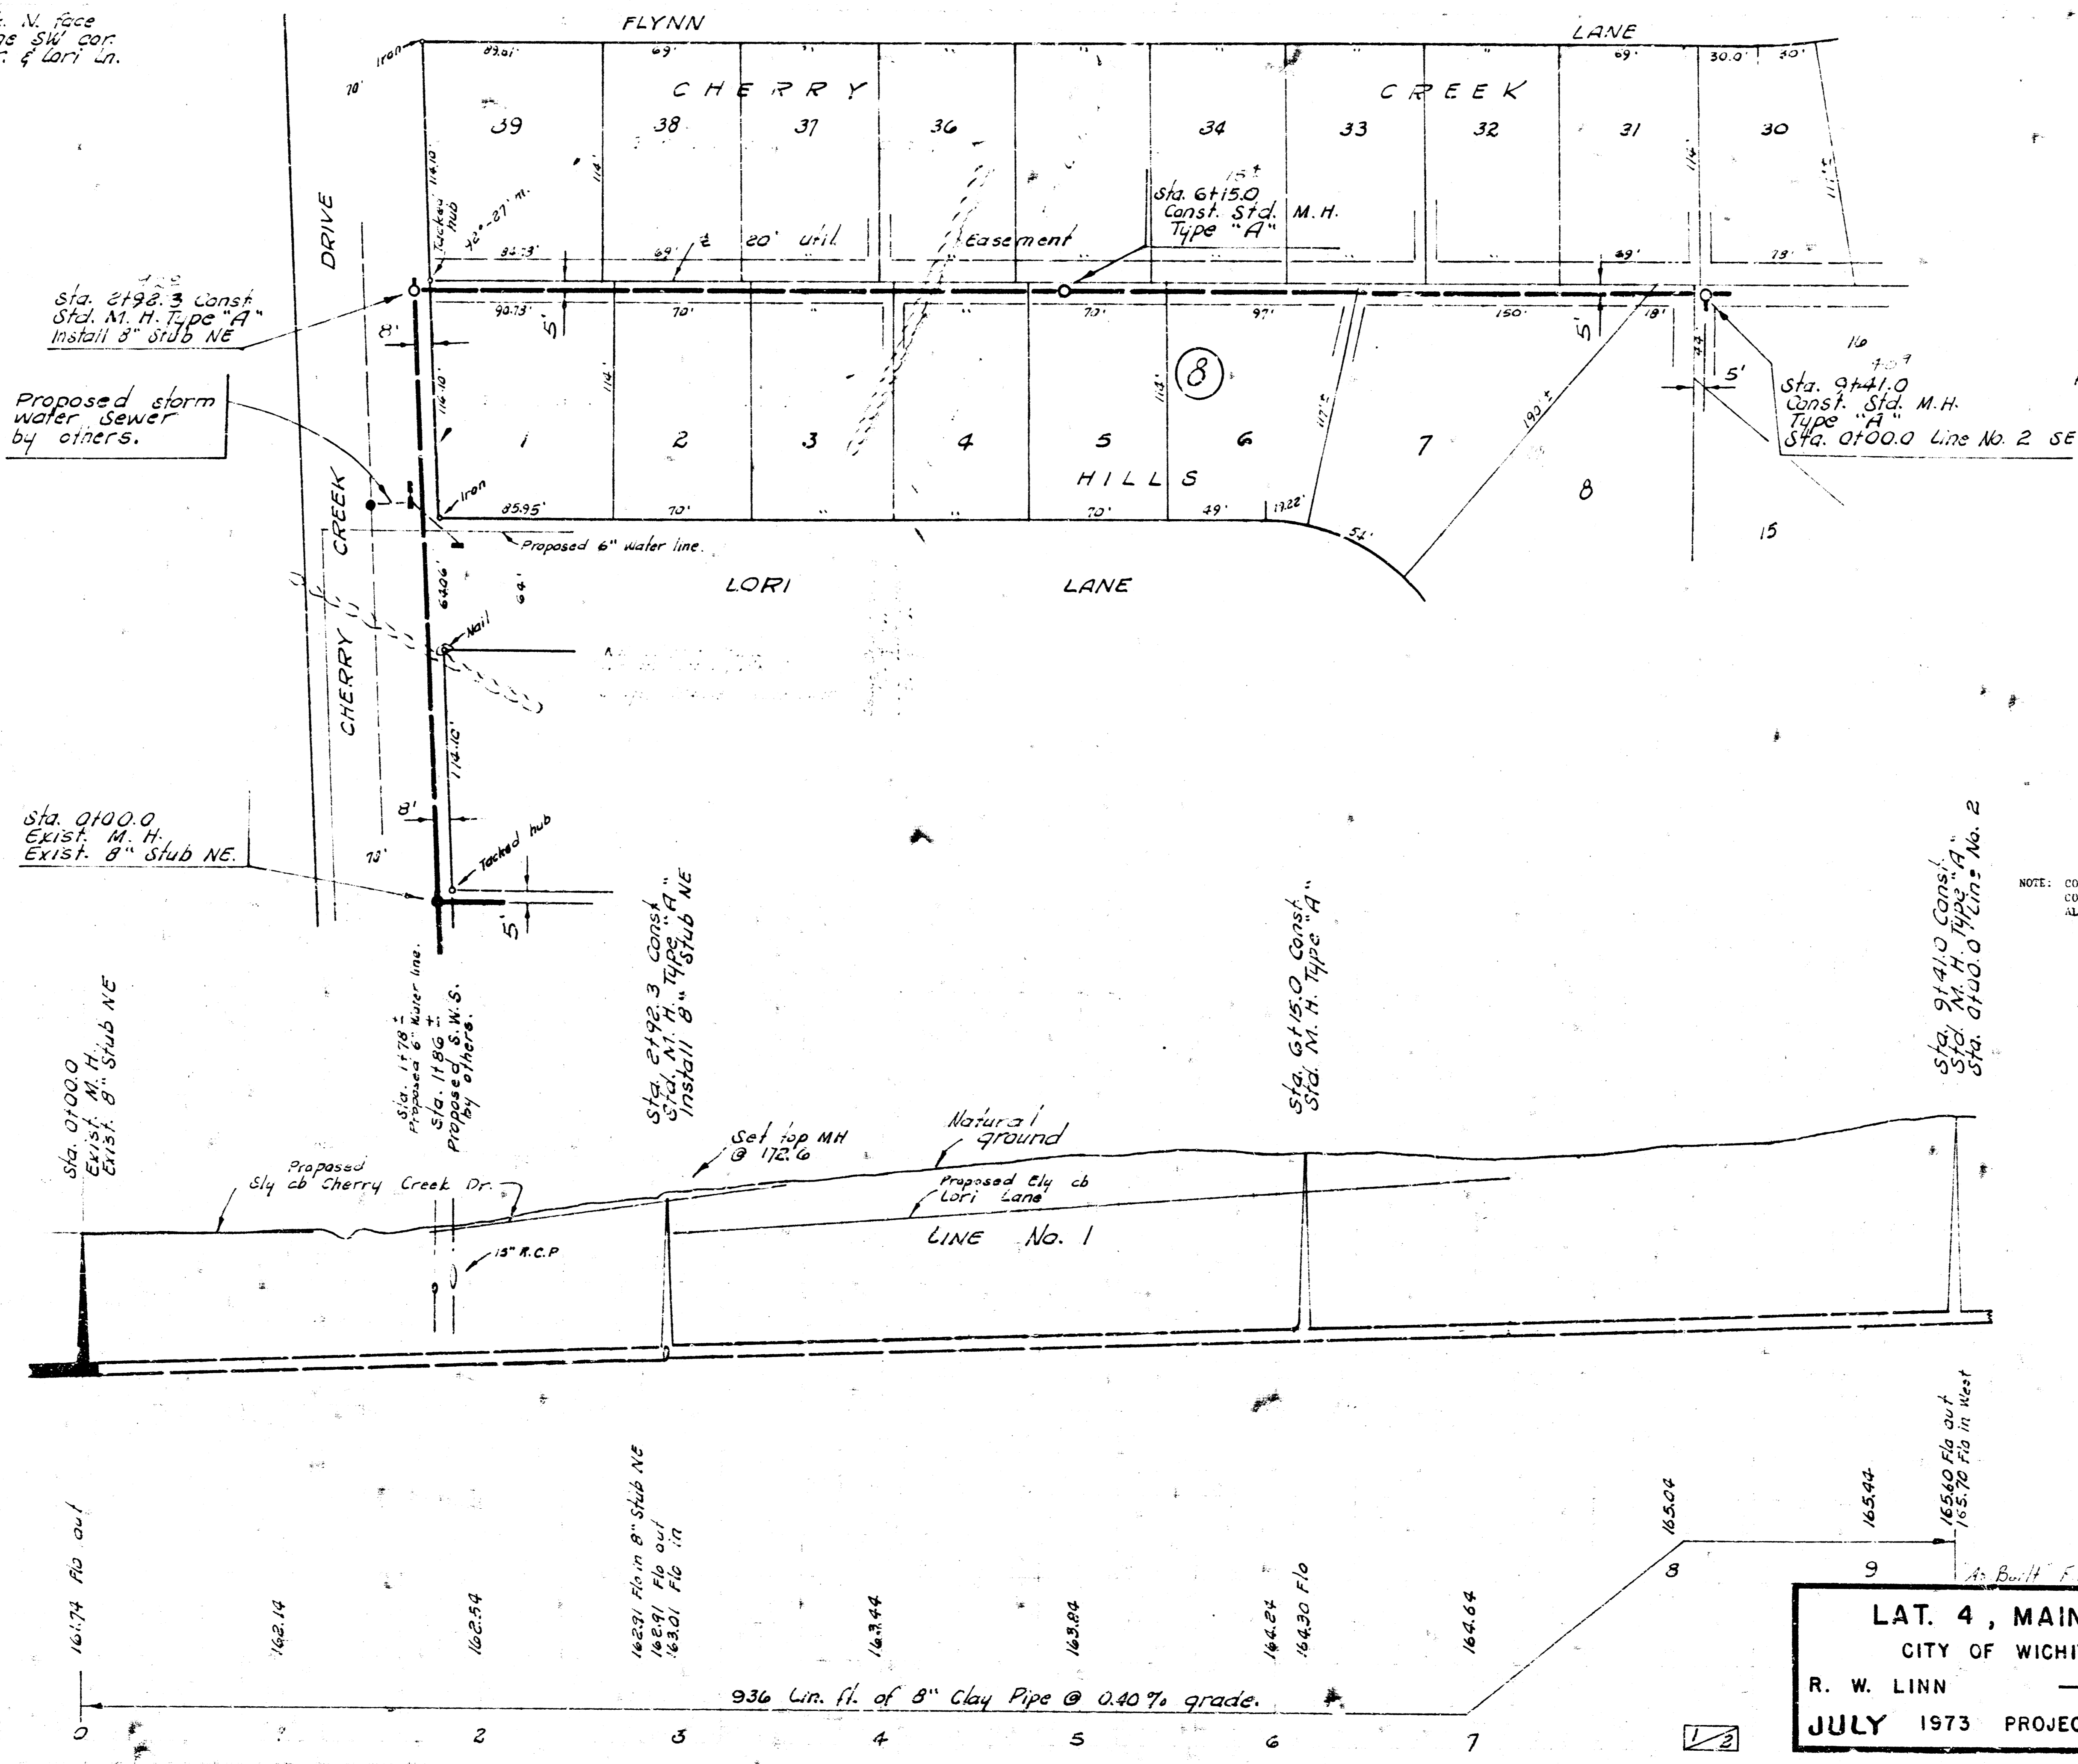


Plan Scale 1" = 10'
 Profile Scale 1" = 5' vert.





NOTE: CONSTRUCTION OF THIS PROJECT SHALL BE
 COORDINATED WITH MAIN SEWER CONSTRUCTION
 ALONG THE EAST SIDE OF ROCK BLVD.

LAT. 4, MAIN 17, W. I. S.
 CITY OF WICHITA, KANSAS
 R. W. LINN — CITY ENGINEER
 JULY 1973 PROJECT NO. DBKL573015

D.S. & W. 134

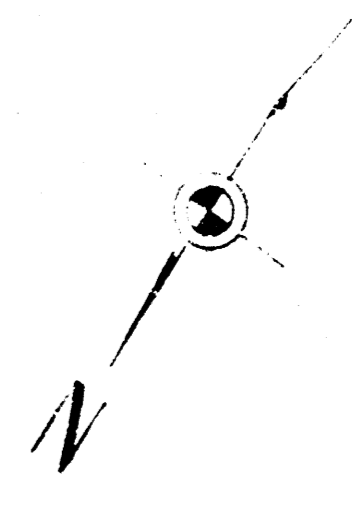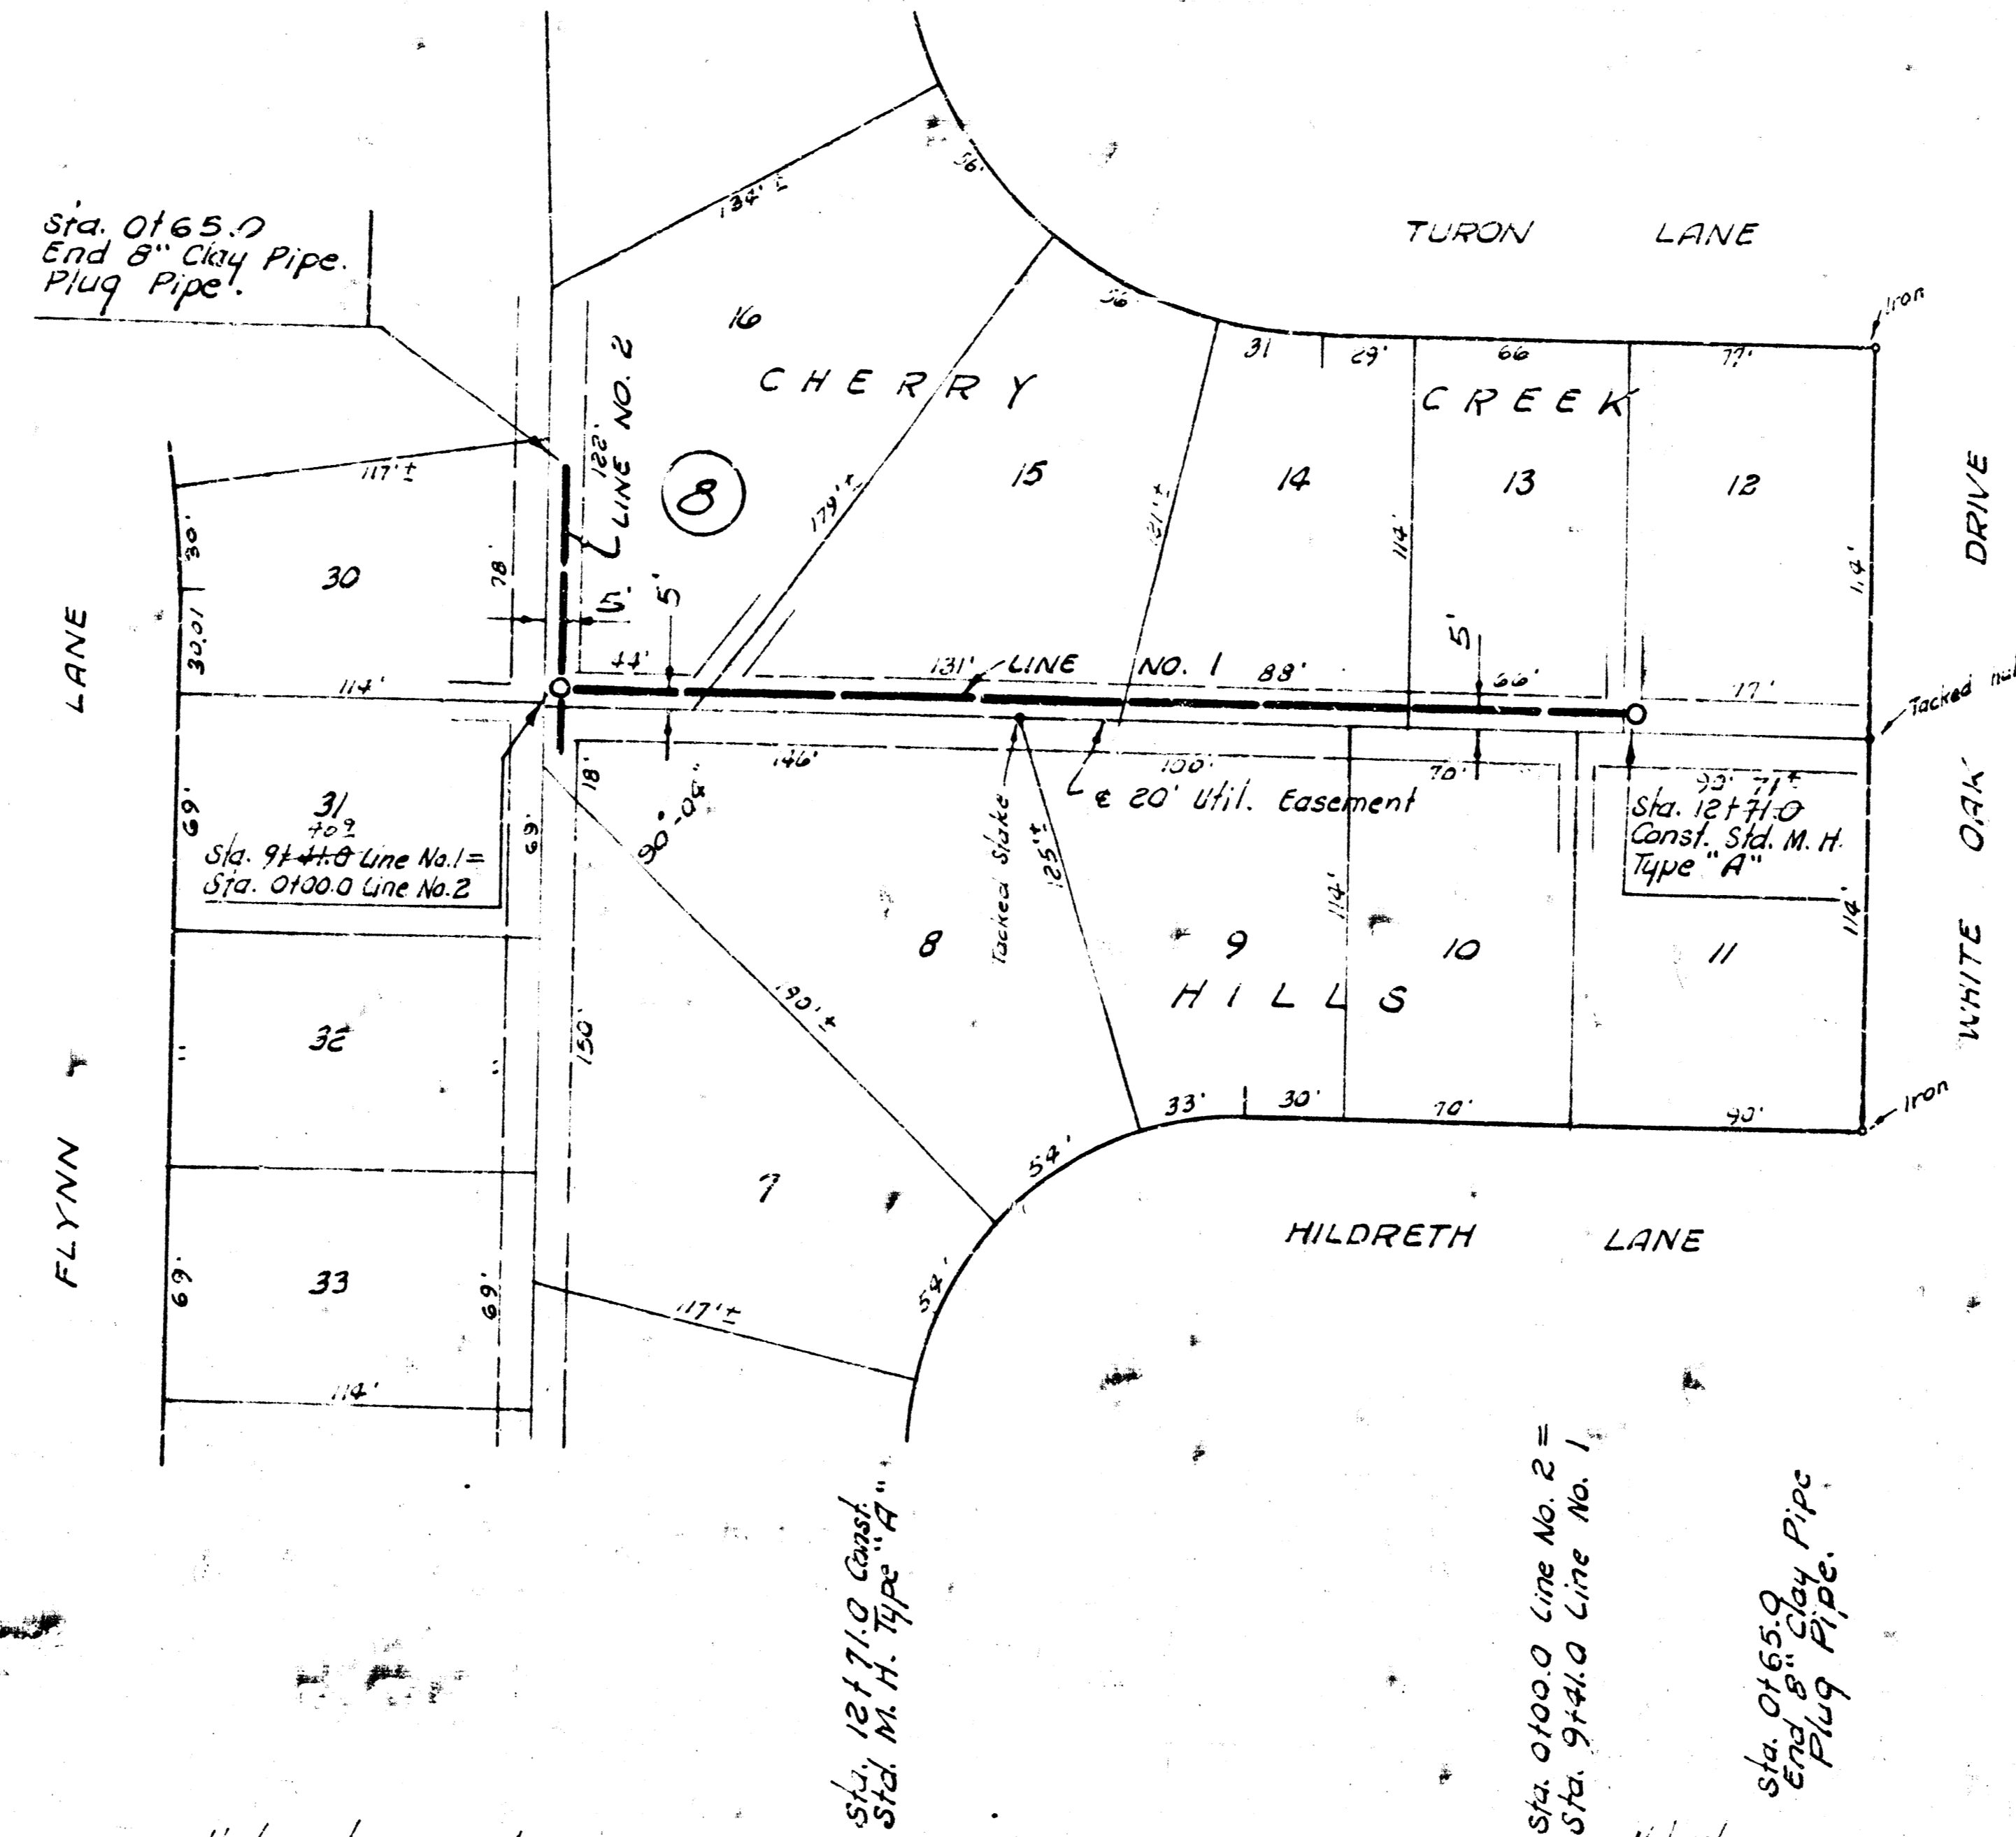

182
175
170
165
160

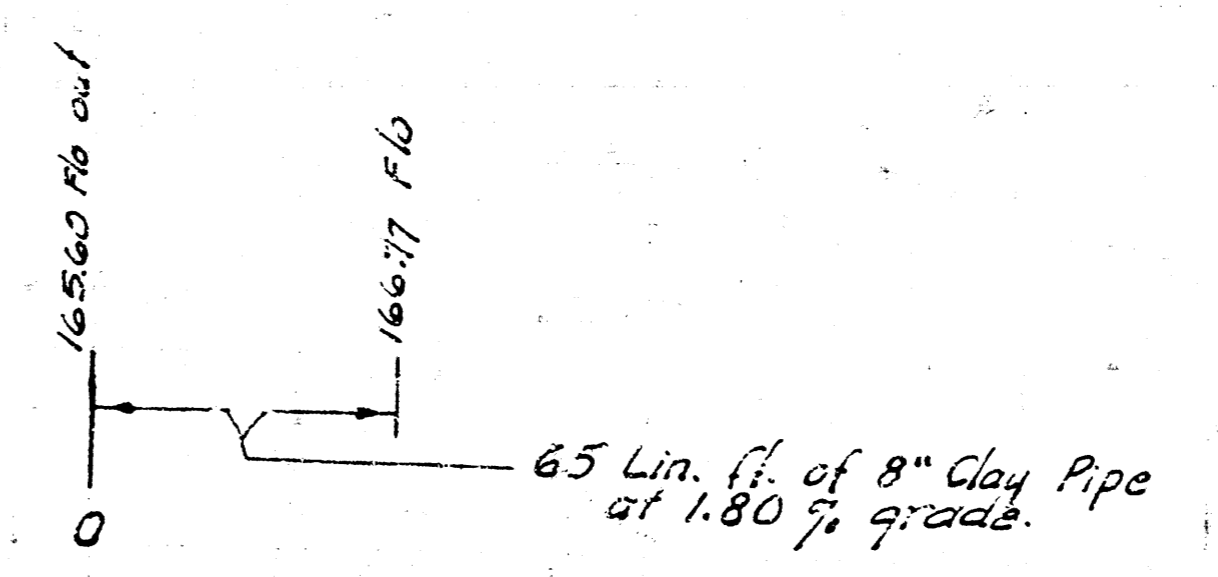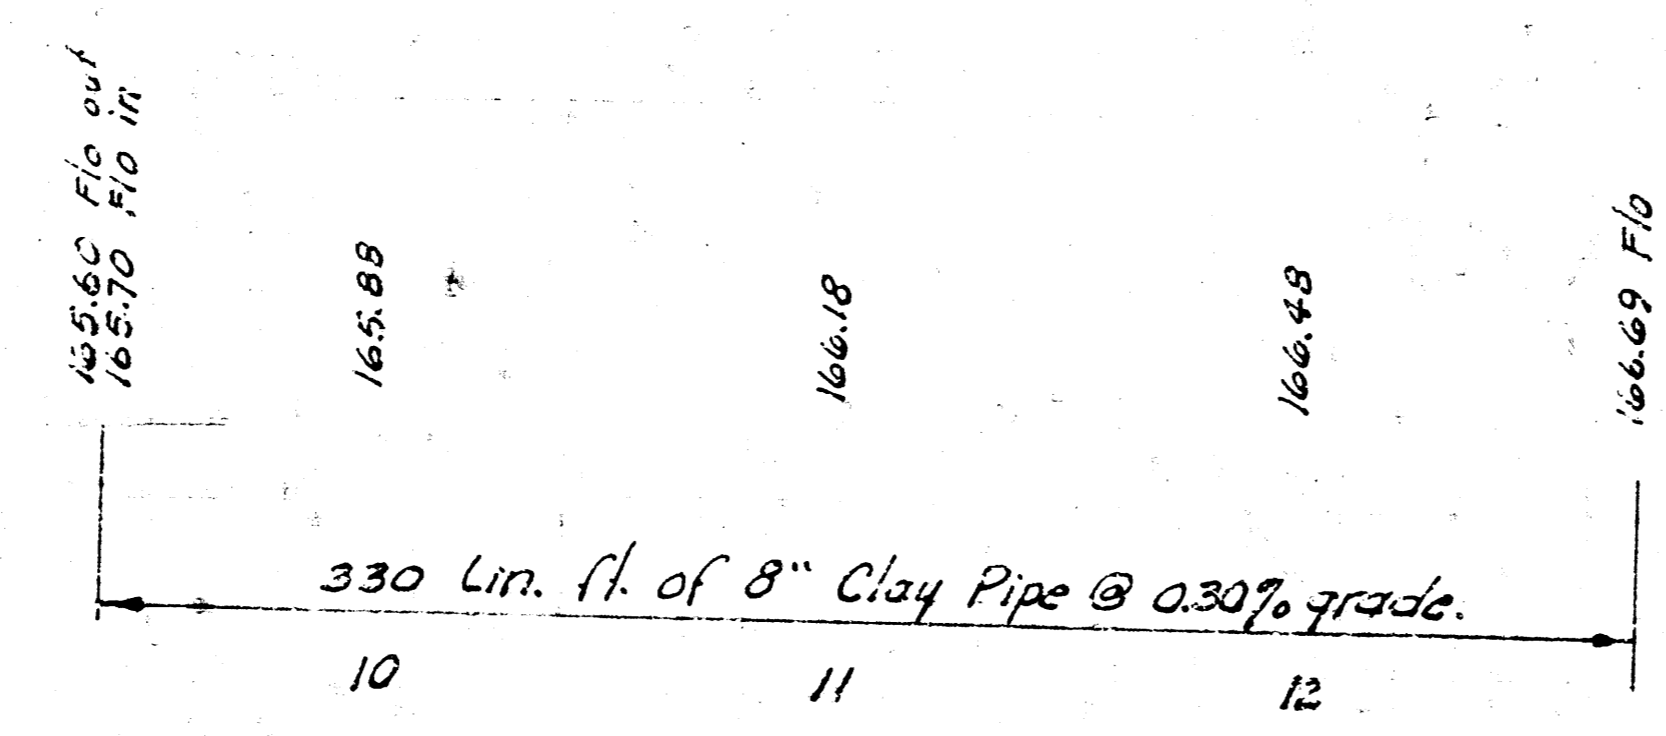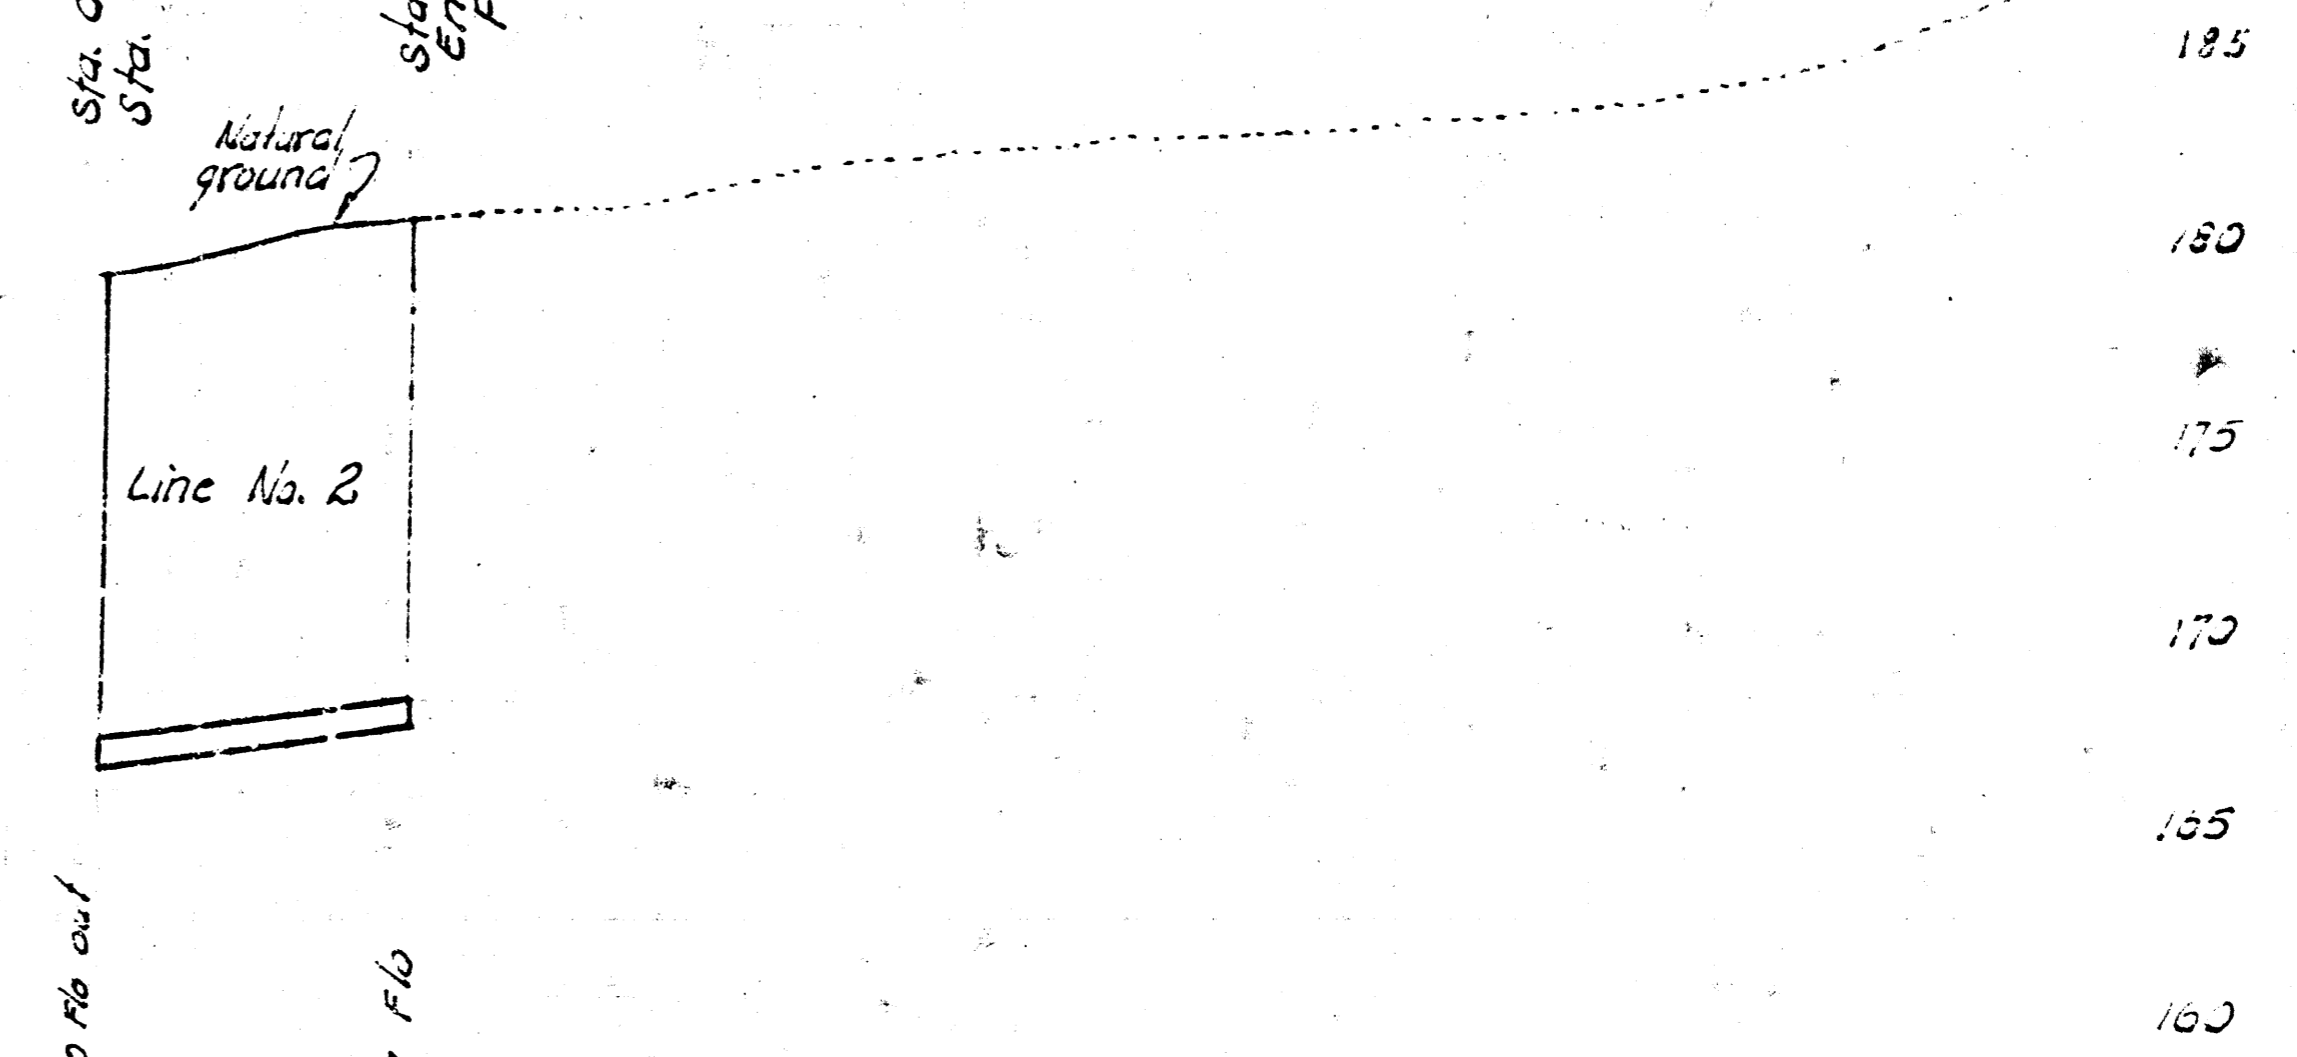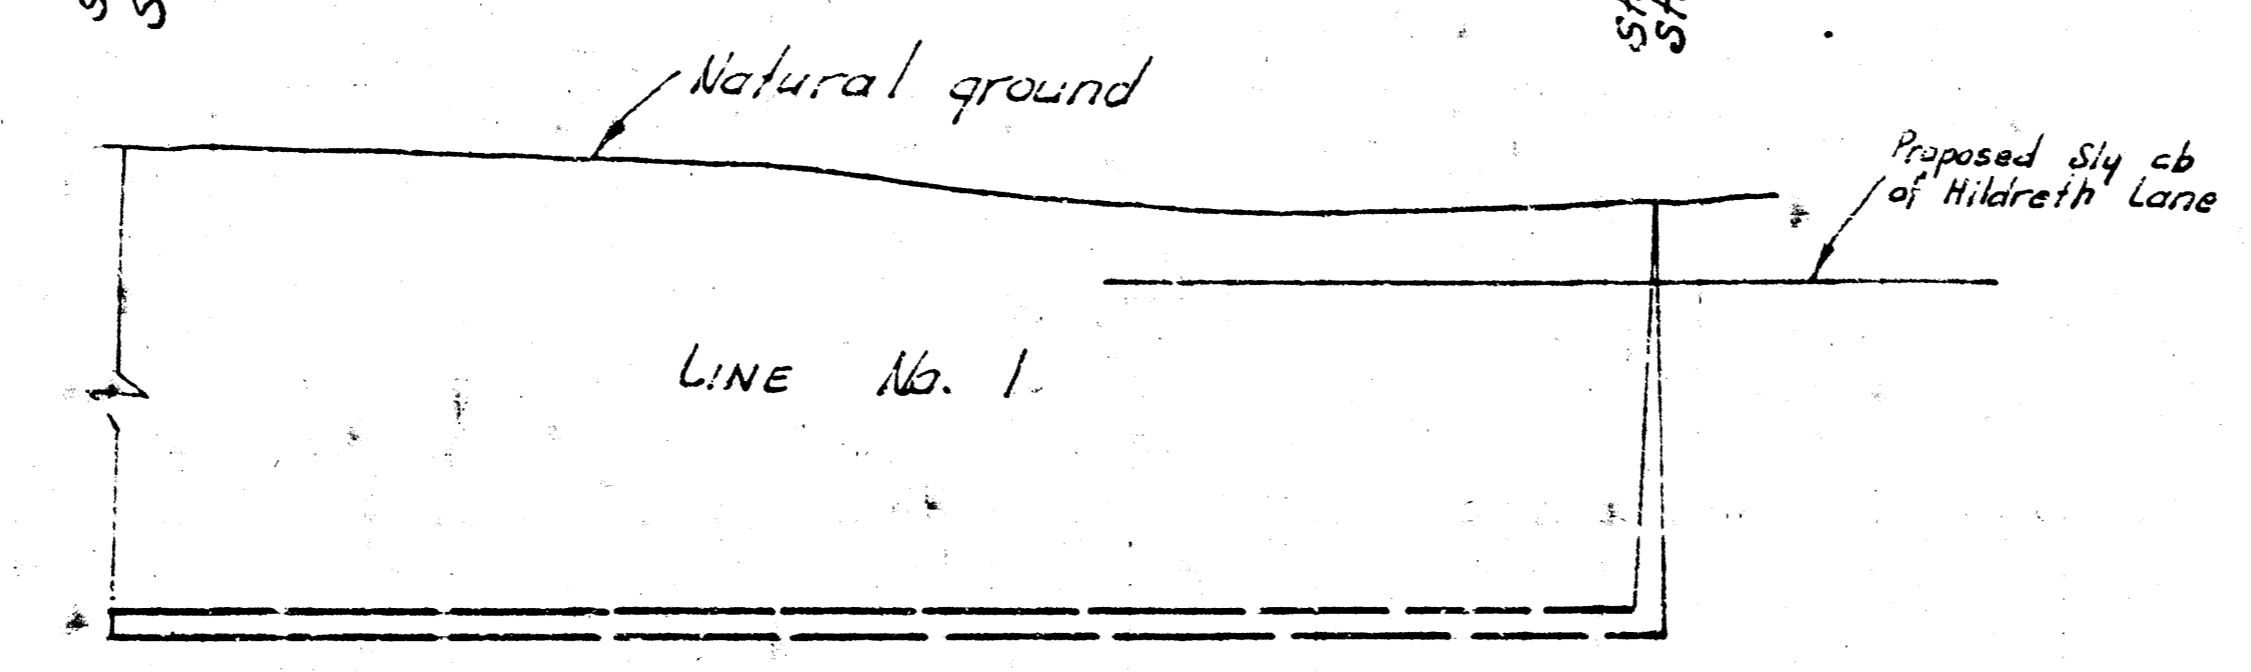

LAT. 4, MAIN 17, W. I. S.
PROJECT NO. DBKL573015

14 2 5 (13)