
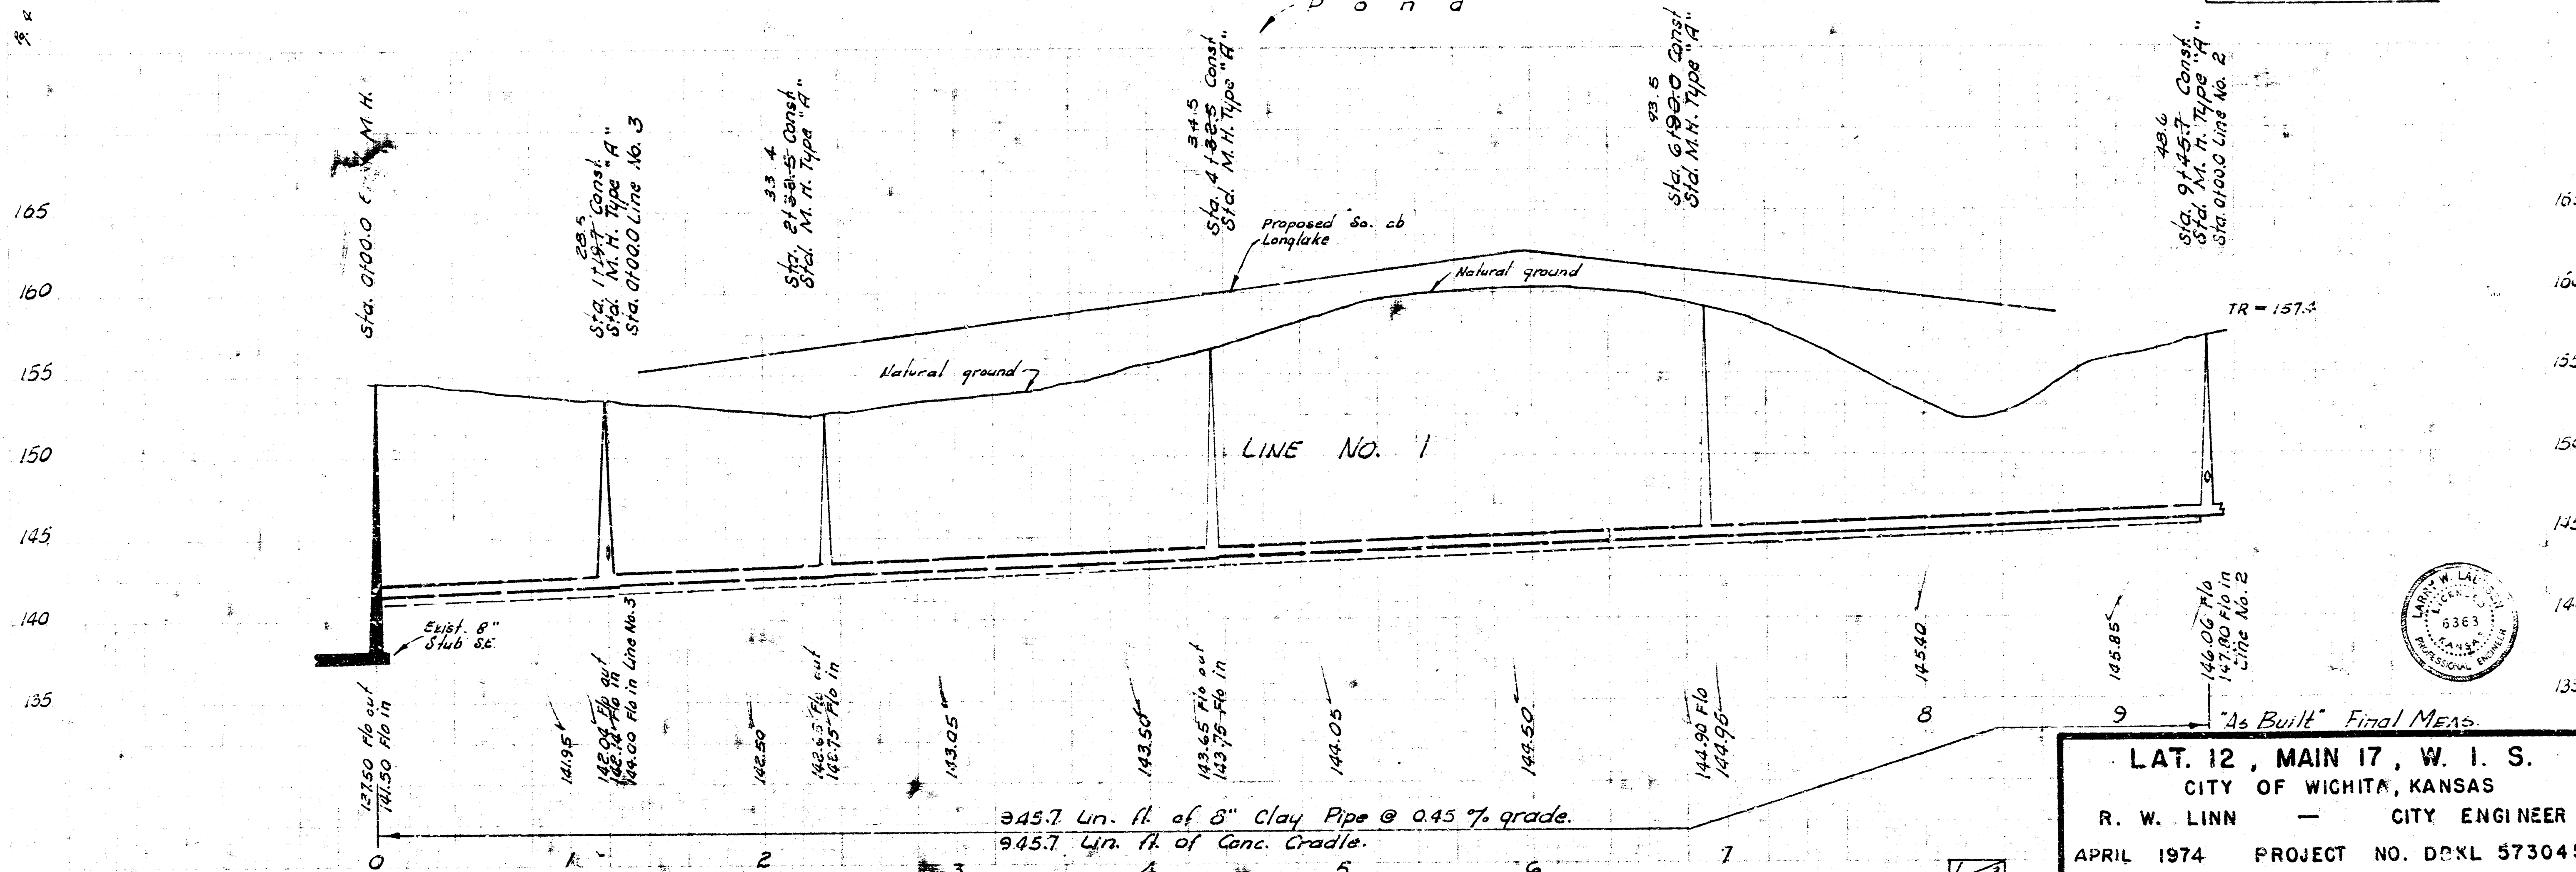


B. M. 153.50 "a" cut NW cor N-Wing wall on top of dam app 130' S. of Lakeland Circle.  
 B. M. 153.53 Top steel T. P. 38' N. of H.L. Longford Lane & E.L. Cedar Lakes Rdn.

Plan Scale 1" = 40' Horiz.  
 Profile Scale 1" = 5' Vert.

**NOTE:**  
 Tie Conc. Cradle to manholes with 4 - 3" #4 Steel bars.  
 Bid price of Lin. ft. of conc. Cradle is to include the steel.  
 Conc. Cradle may be deleted with the approval of the field Engineer.

**NOTE:**  
 The bid price of Lump Sum Clearing Right-of-Way to include all cost of removing trees, hedges, stumps and any other items in the way of the construction of the sewer.

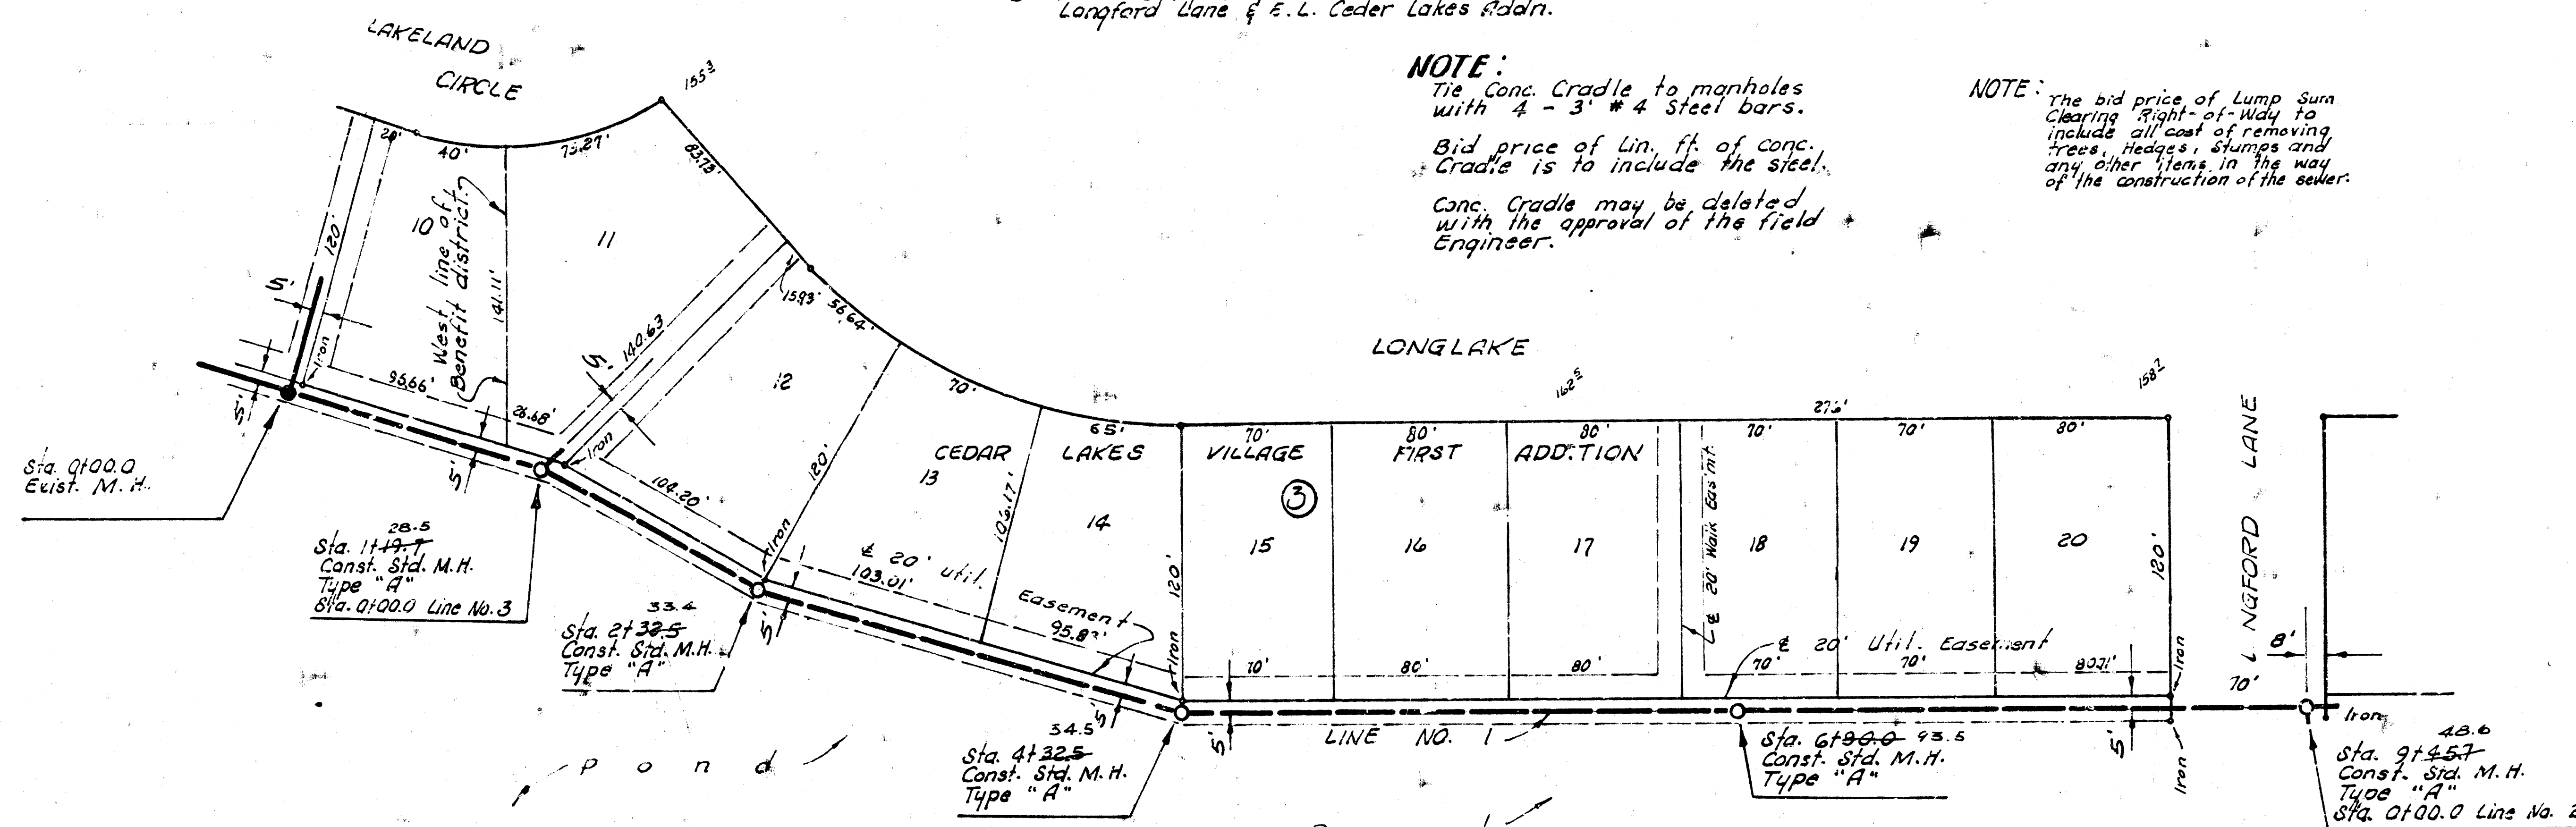

**LAT. 12, MAIN 17, W. I. S.**  
**CITY OF WICHITA, KANSAS**  
**R. W. LINN — CITY ENGINEER**  
**APRIL 1974 PROJECT NO. DOKL 573045**

