

BM = 1537.46 "□" on SW corner Concrete Headwall to Dyke

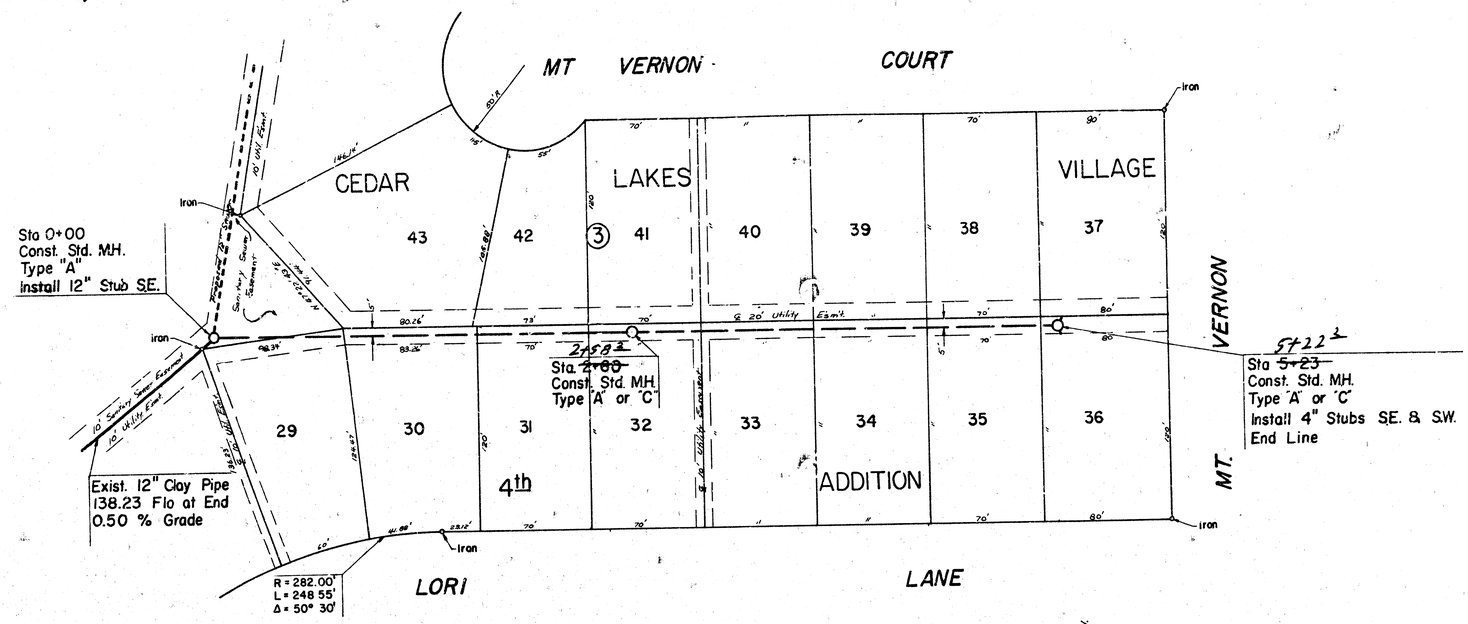

Plan Scale 1" = 40'
Profile Scale 1" = 40' Horz.
1" = 5' Vert.

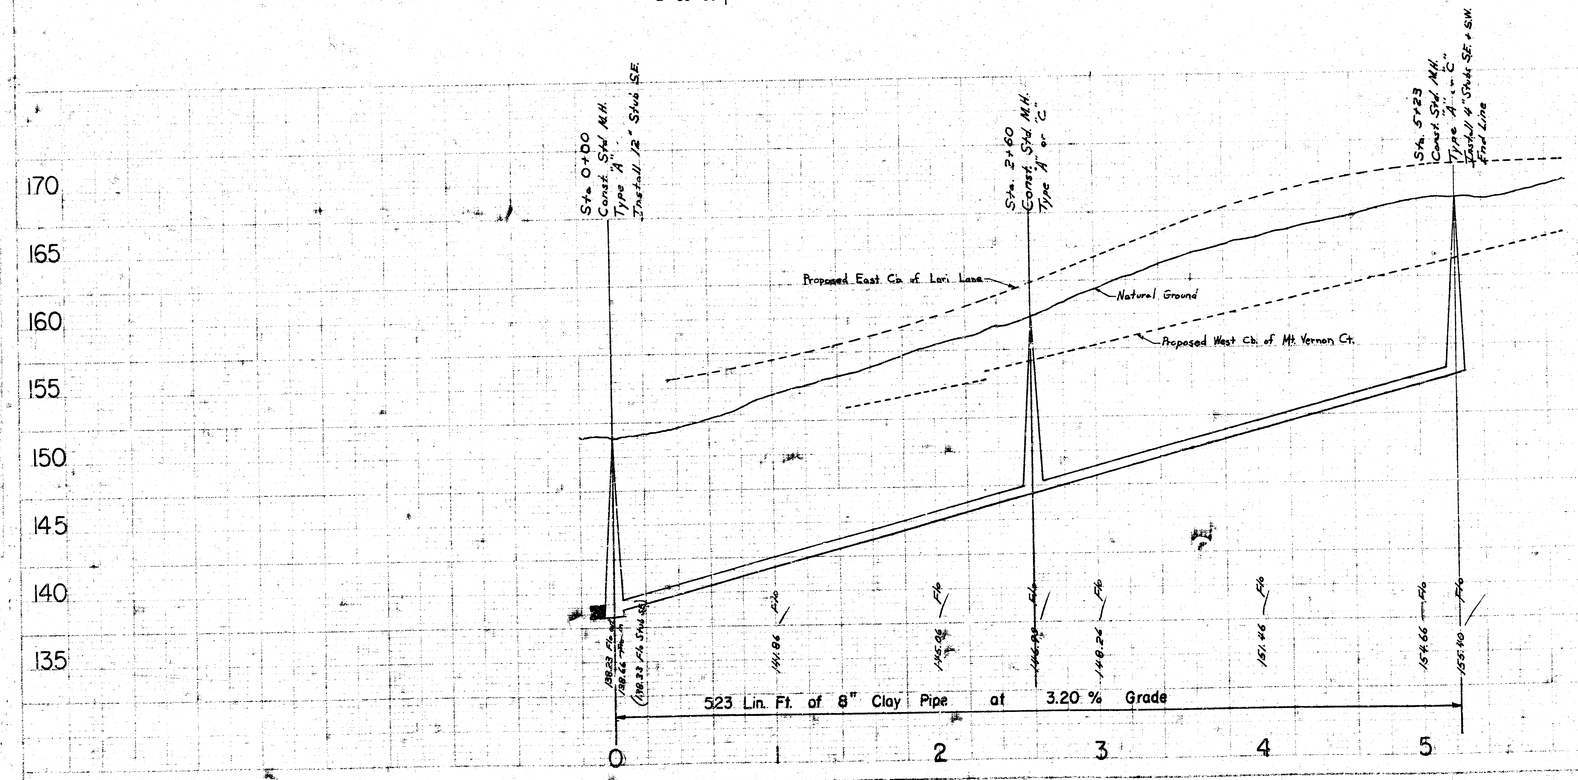

As Built 11-6-75

LAT 23 MAIN 17 WAR INDUSTRIES SEWER
CITY OF WICHITA KANSAS
R. W. LINN CITY ENGINEER
Project No. DBKL 574 105

12 8 3 3 1/1