



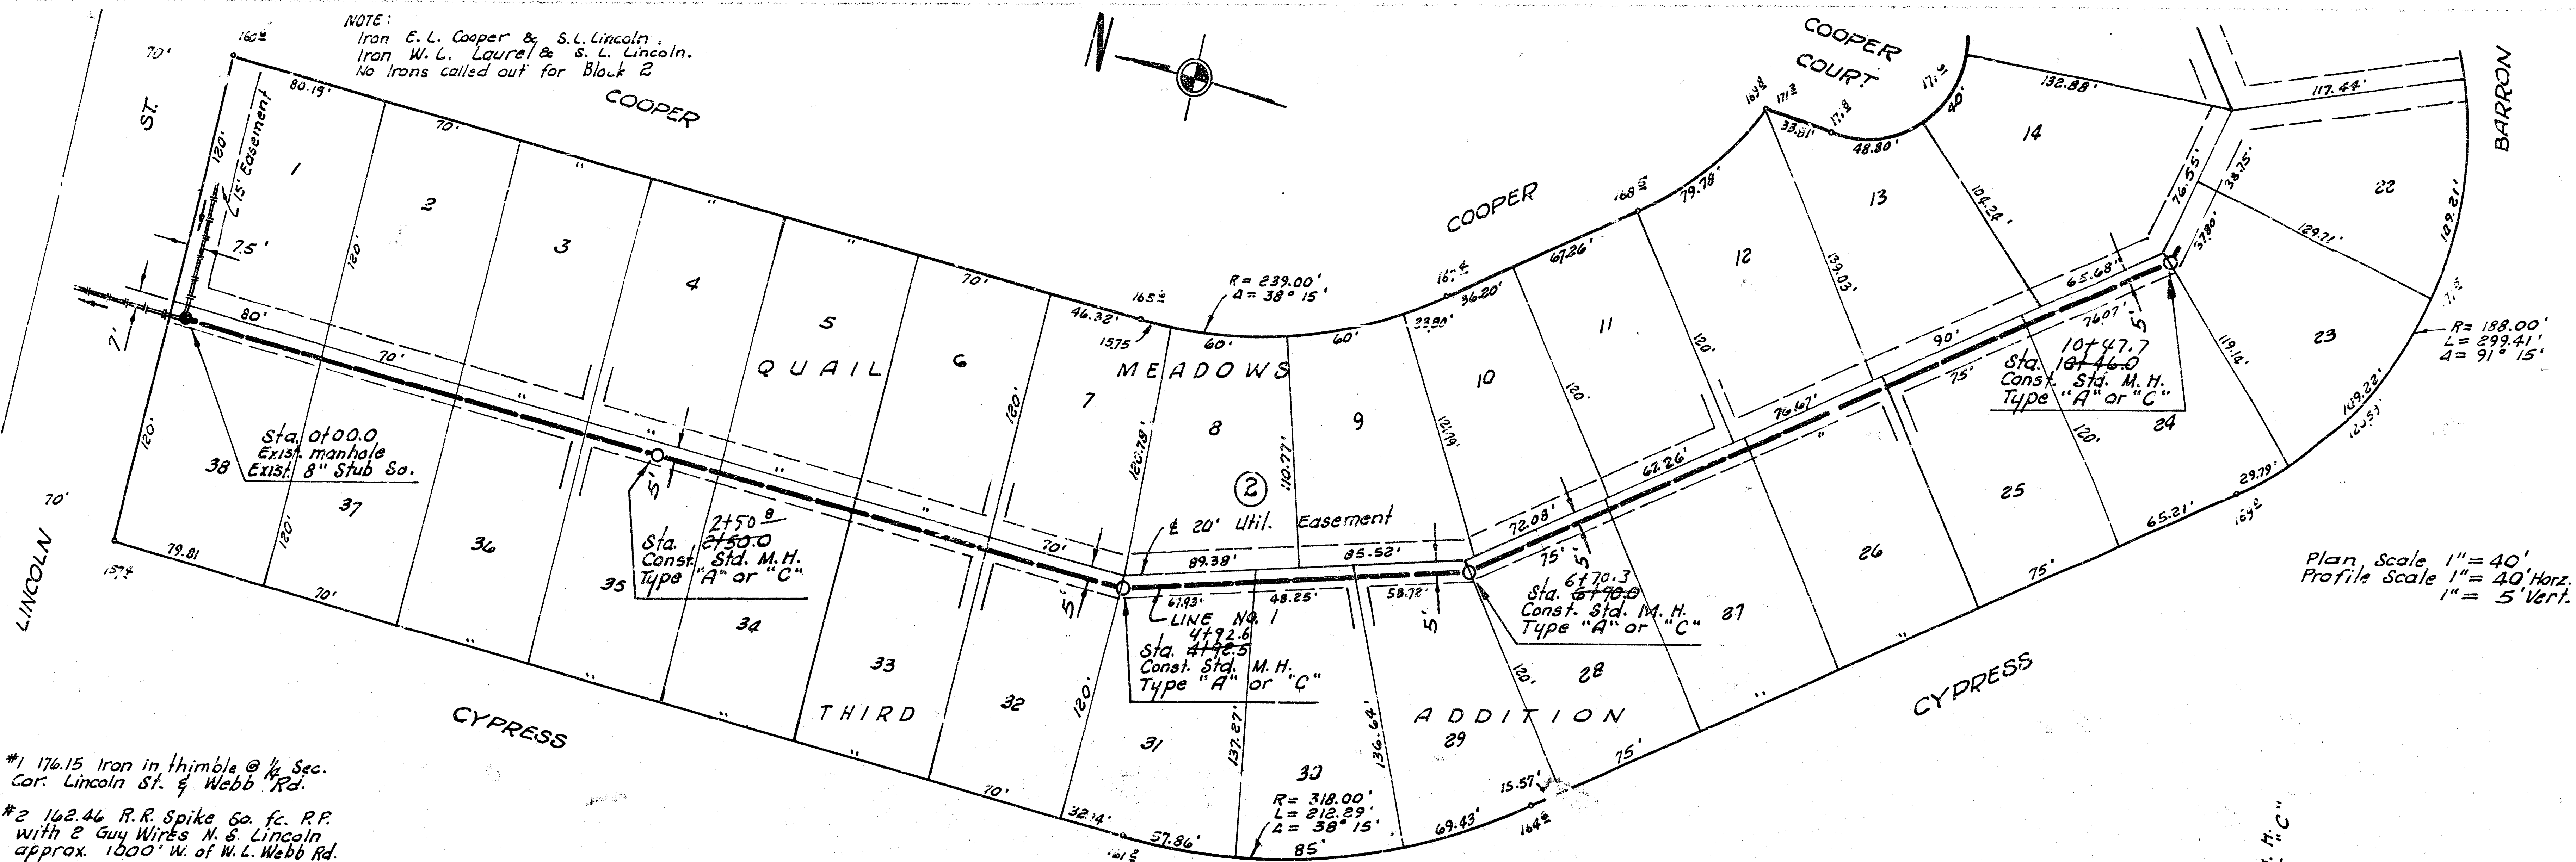

B. M. #1 176.15 Iron in thimble @ 1/4 Sec.
Cor. Lincoln St. & Webb Rd.

B. #2 162.46 R.R. Spike 60. fc. R.P.
with 2 Guy Wires N. & Lincoln
approx. 1000' W. of W.L. Webb Rd.

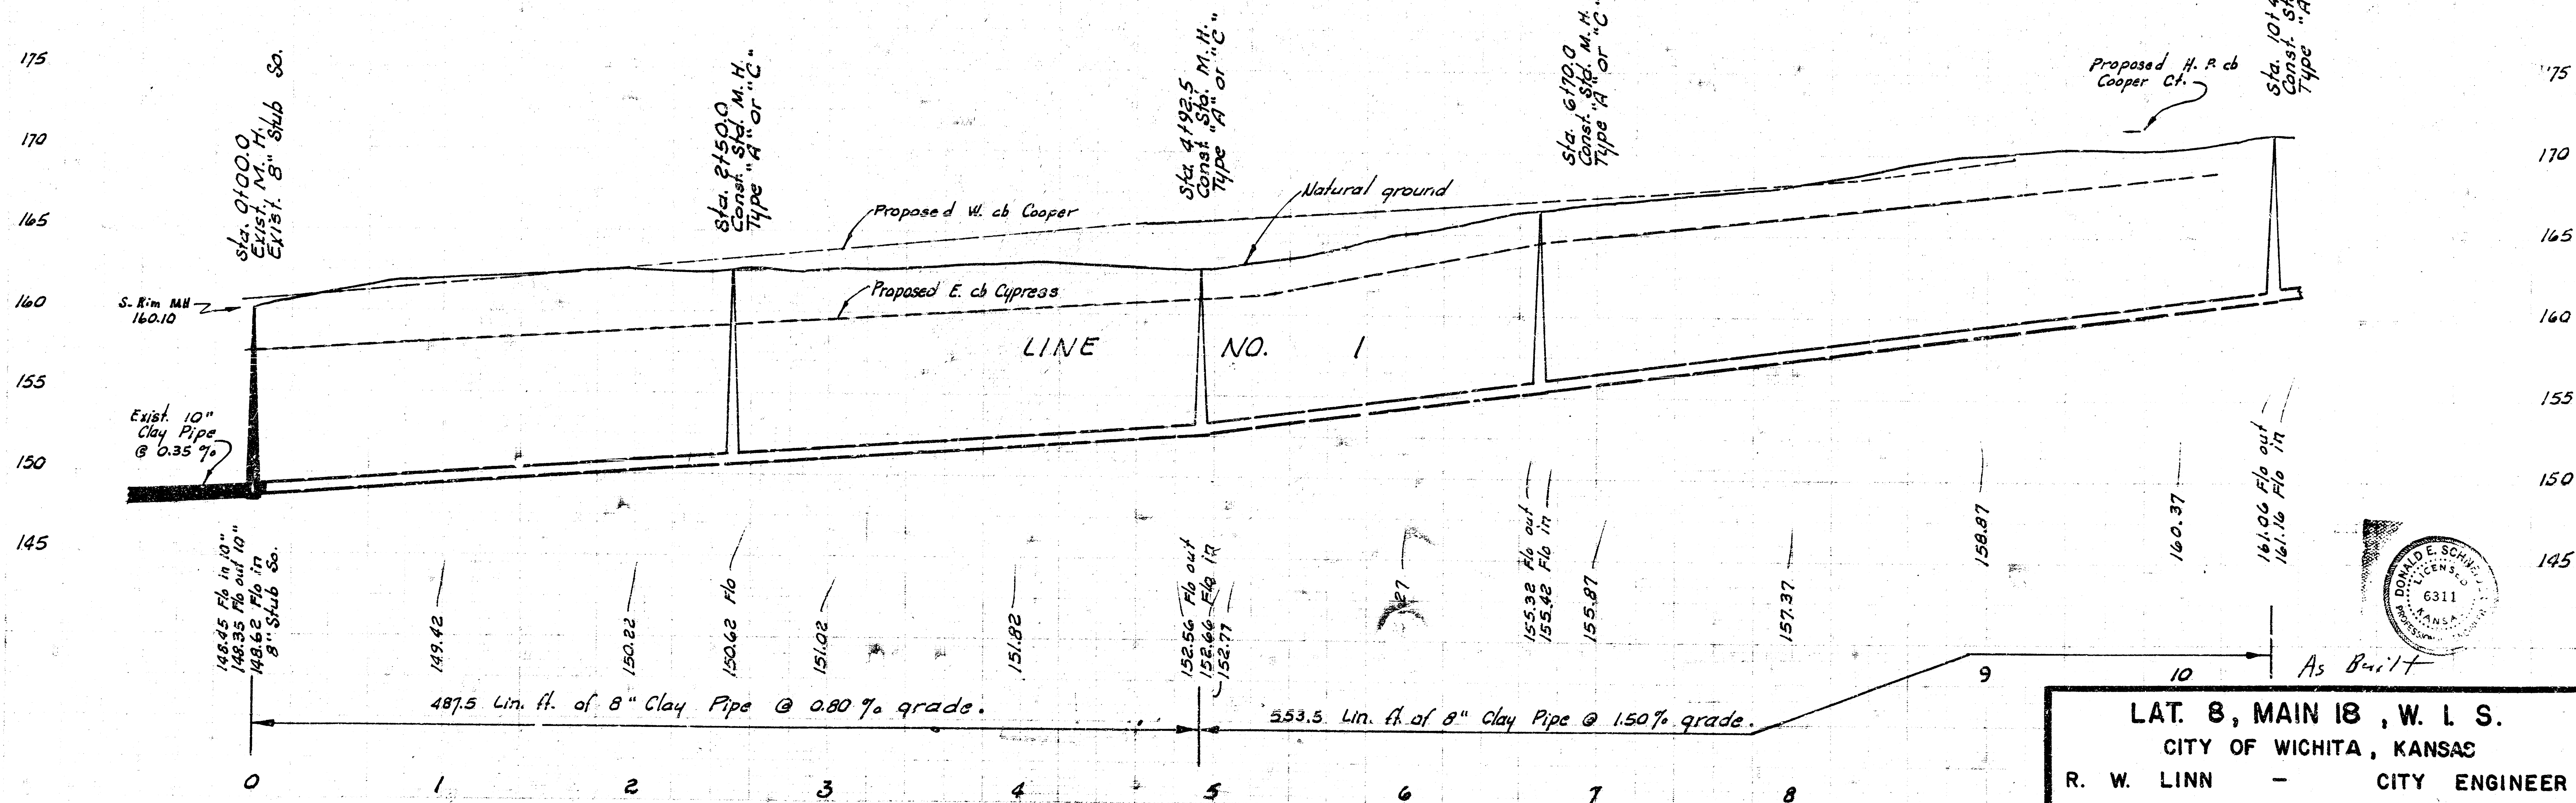

LAT. 8, MAIN 18, W. L. S.
CITY OF WICHITA, KANSAS
R. W. LINN - CITY ENGINEER
JAN. 1975 PROJECT NO. DB KL 574077

