

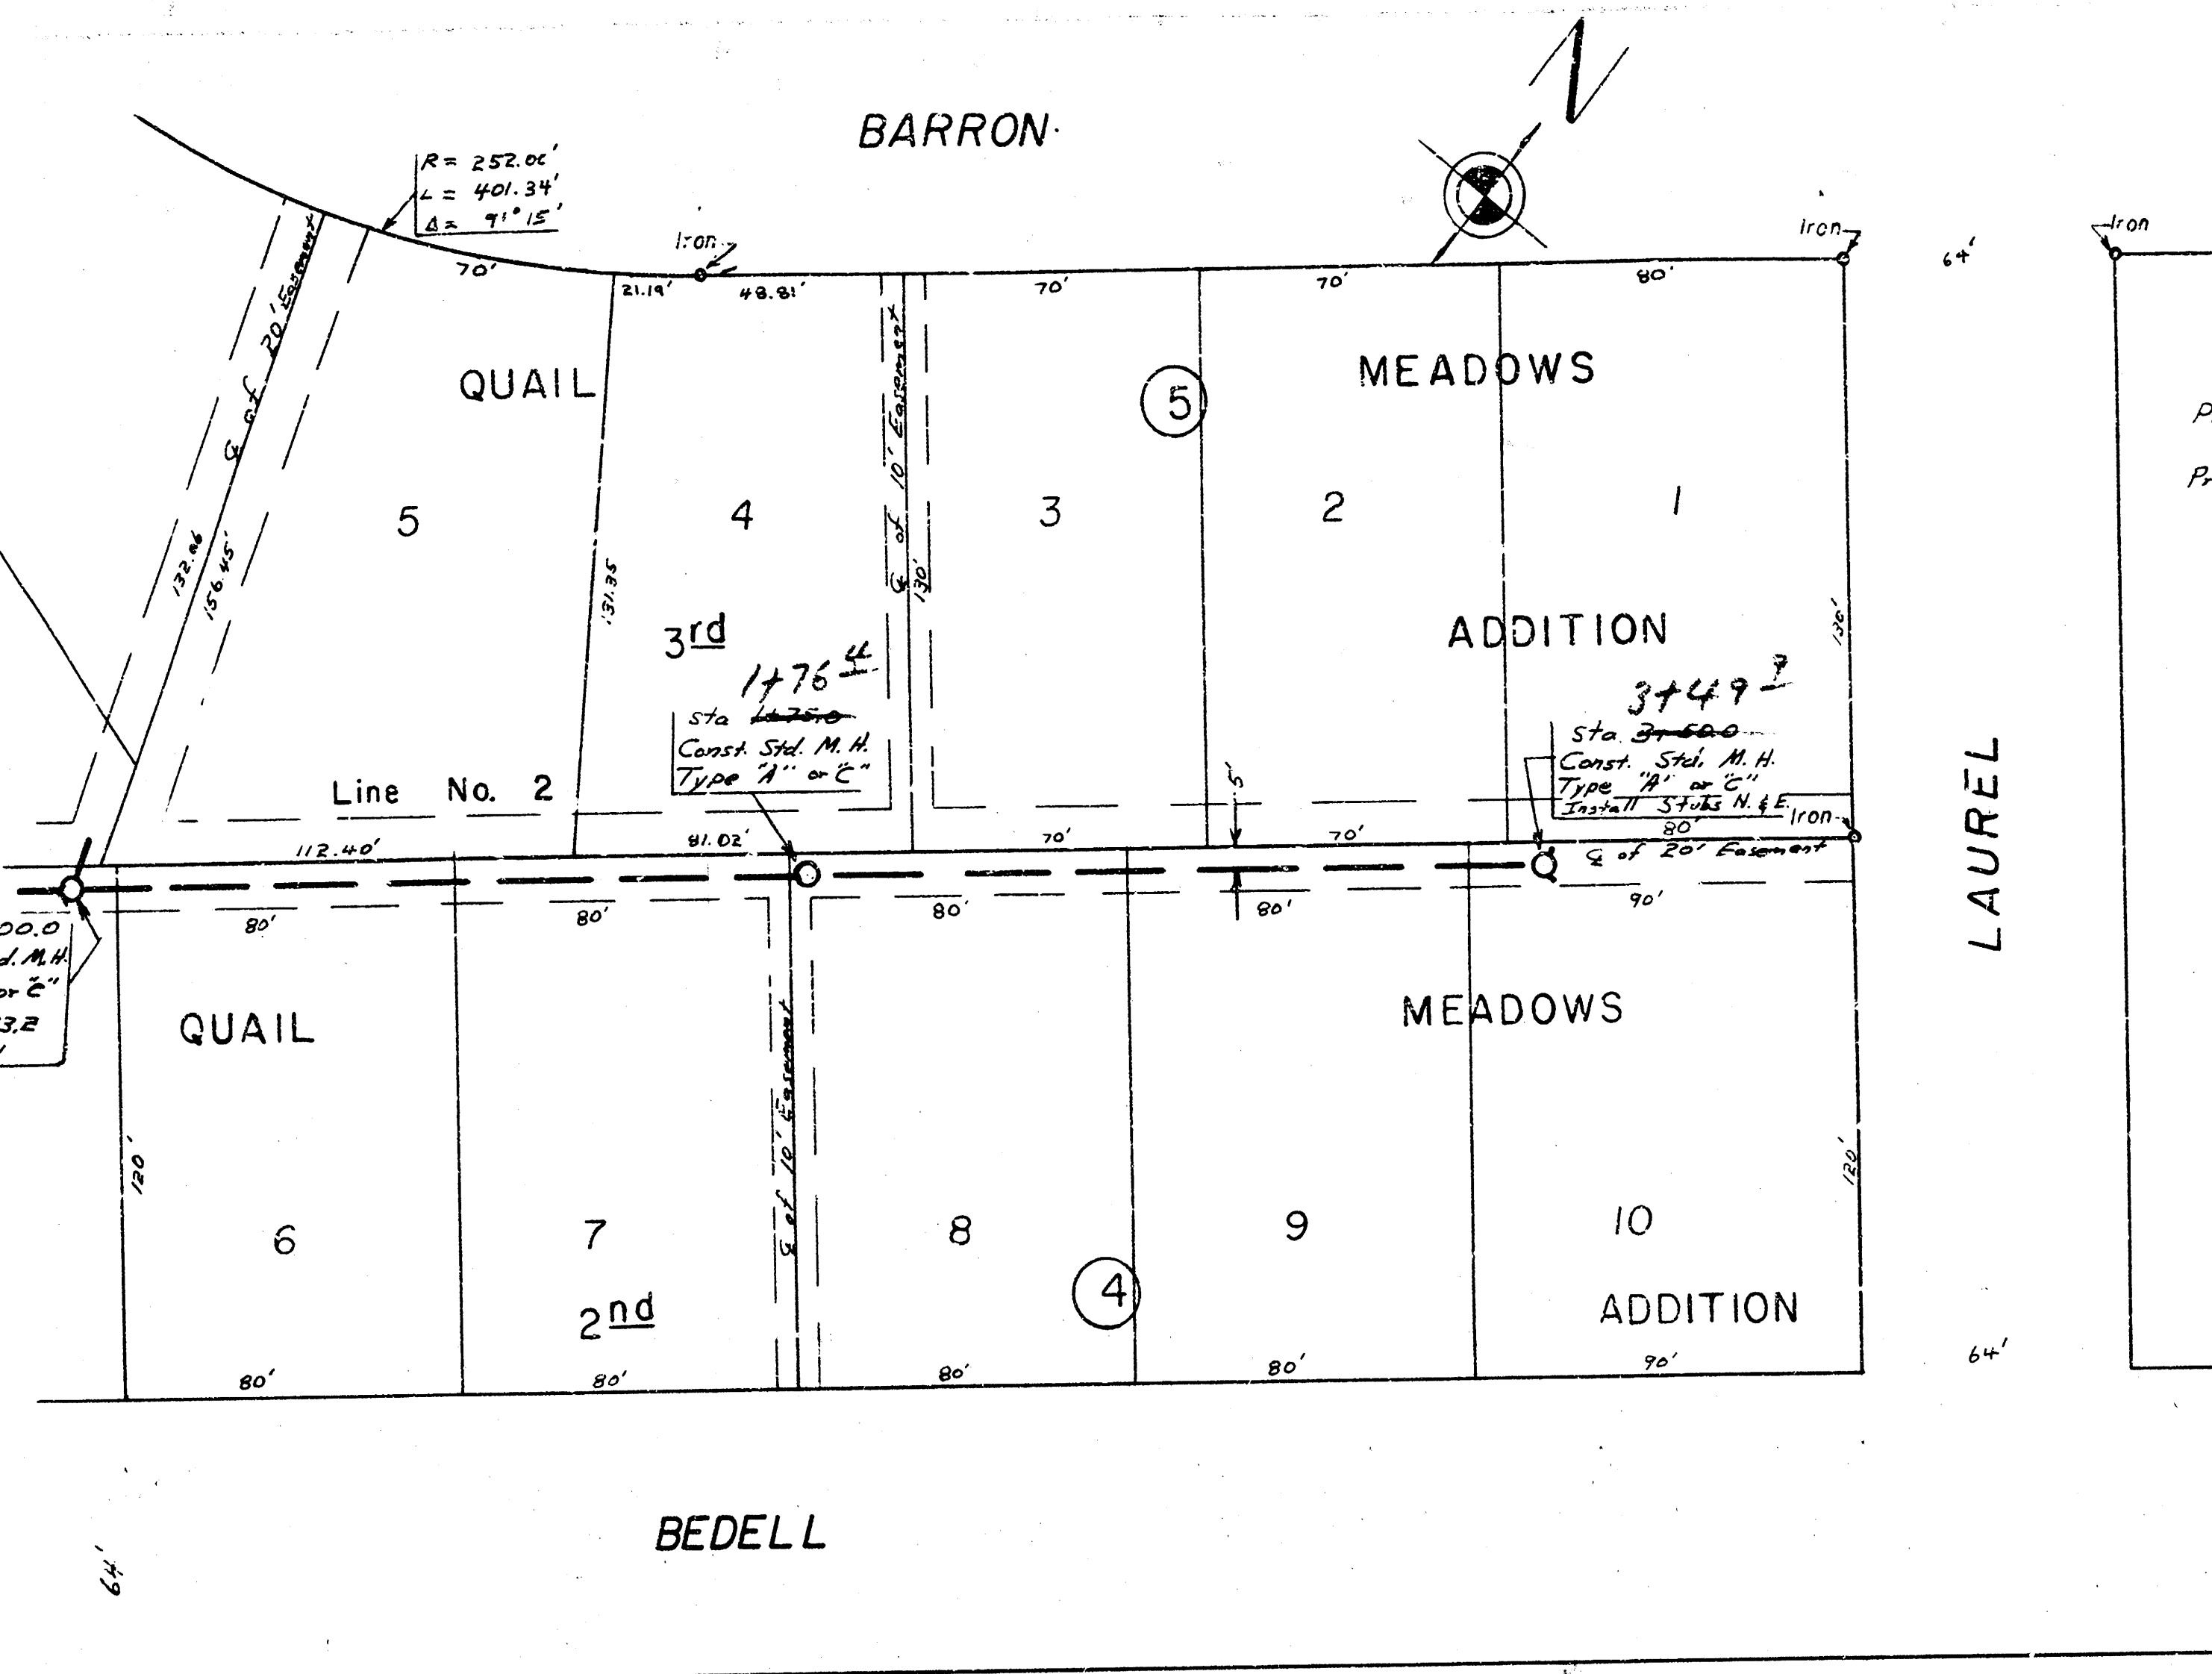
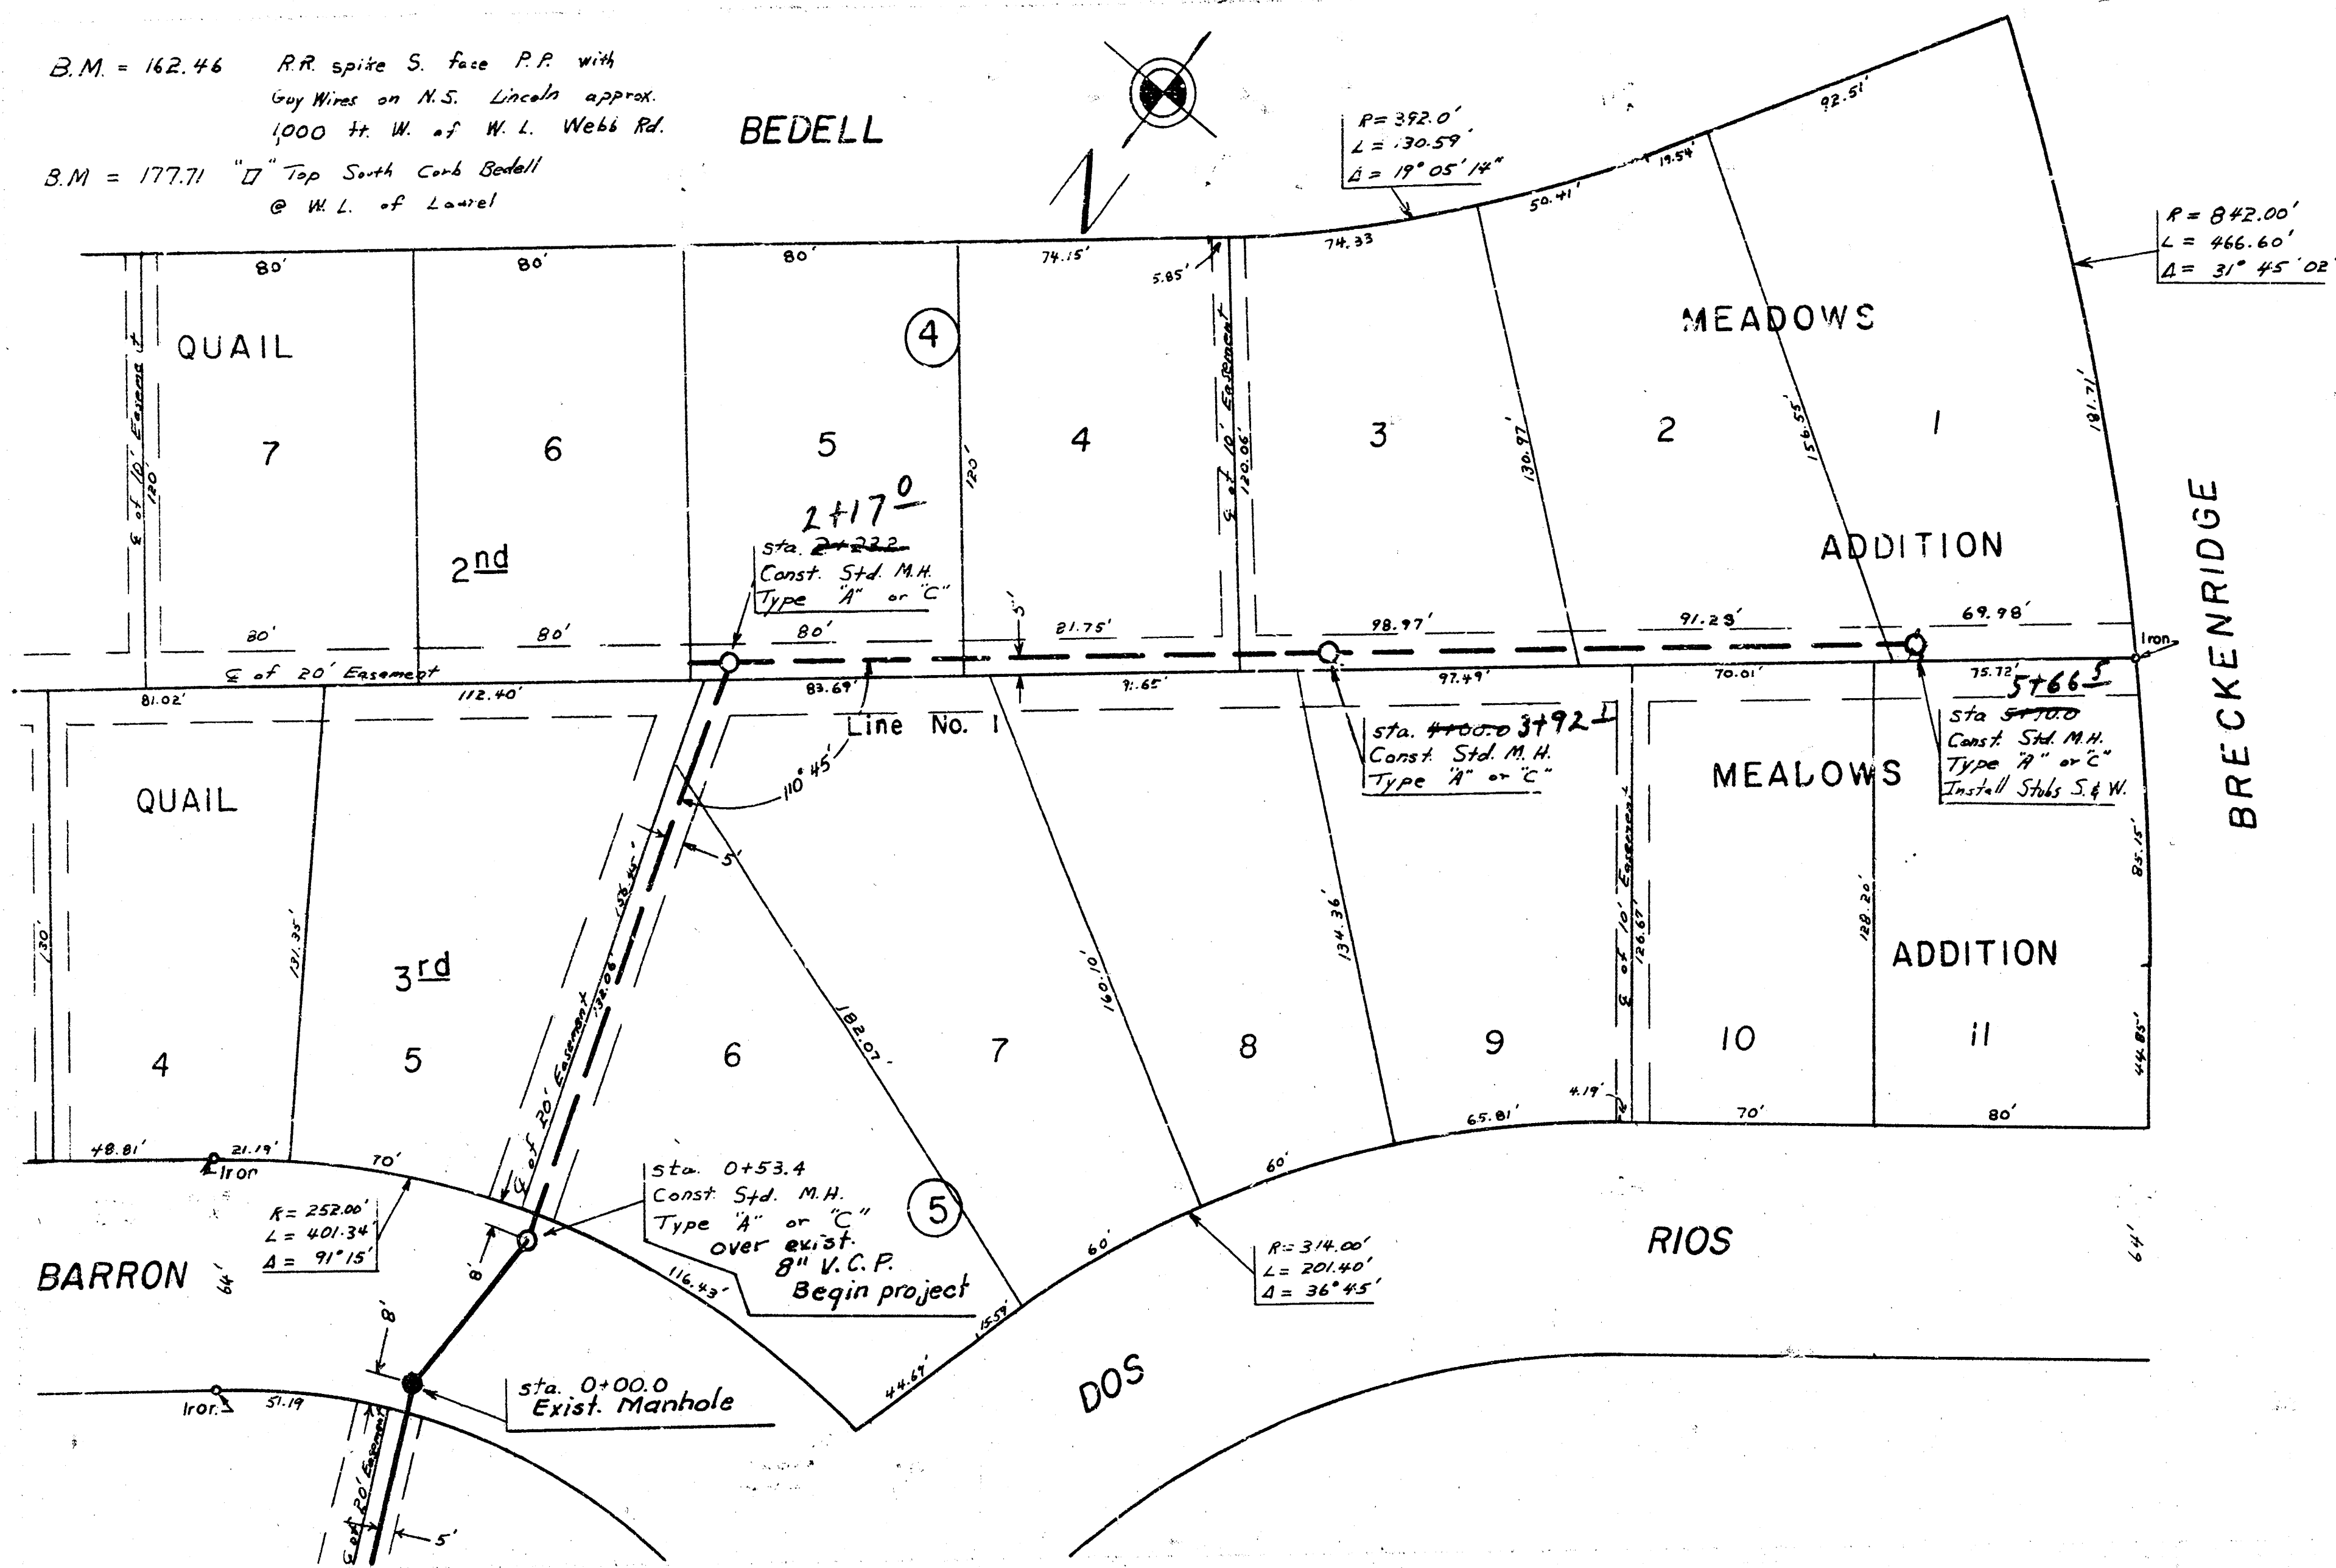


B.M. = 162.46 RR spike S. face P.P. with
 Guy Wires on N.S. Lincoln approx.
 1000 ft. W. of W.L. Wells Rd.
 B.M. = 177.71 "D" Top South Corn Bedell
 @ W.L. of Laurel

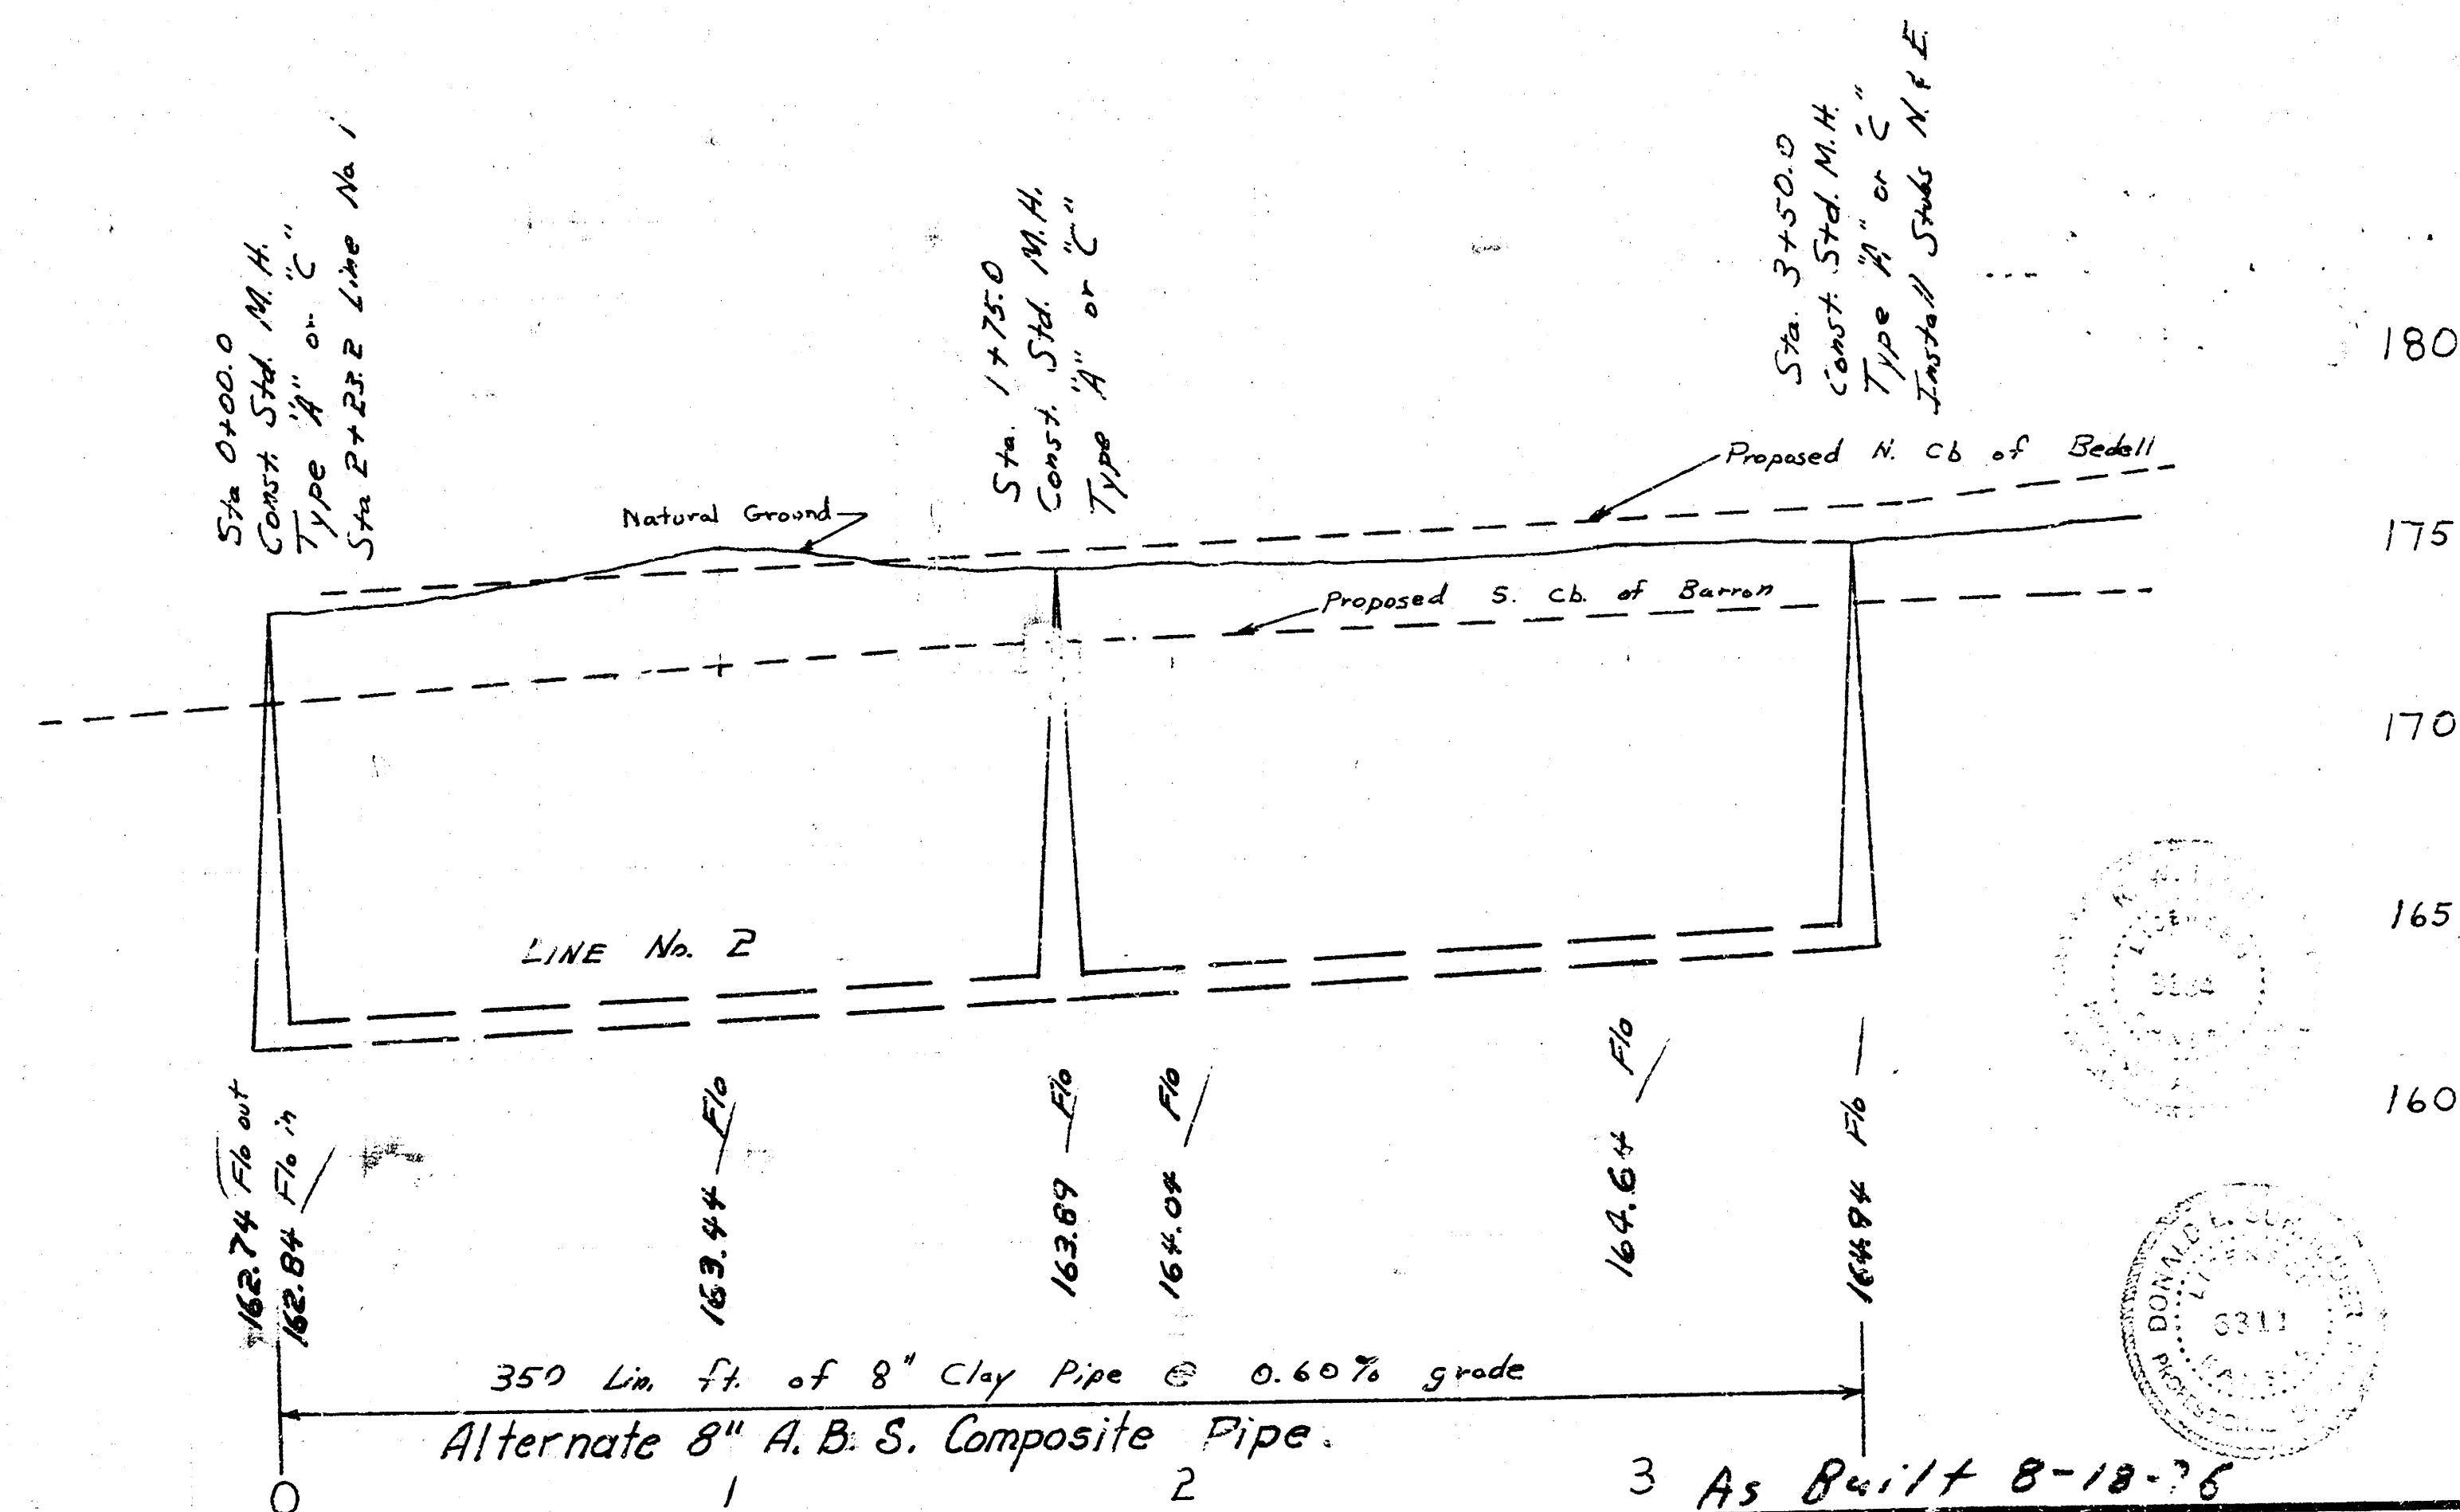

Plan Scale 1" = 40'
 Profile Scale 1" = 40' Horiz.
 1" = 5' Vert.

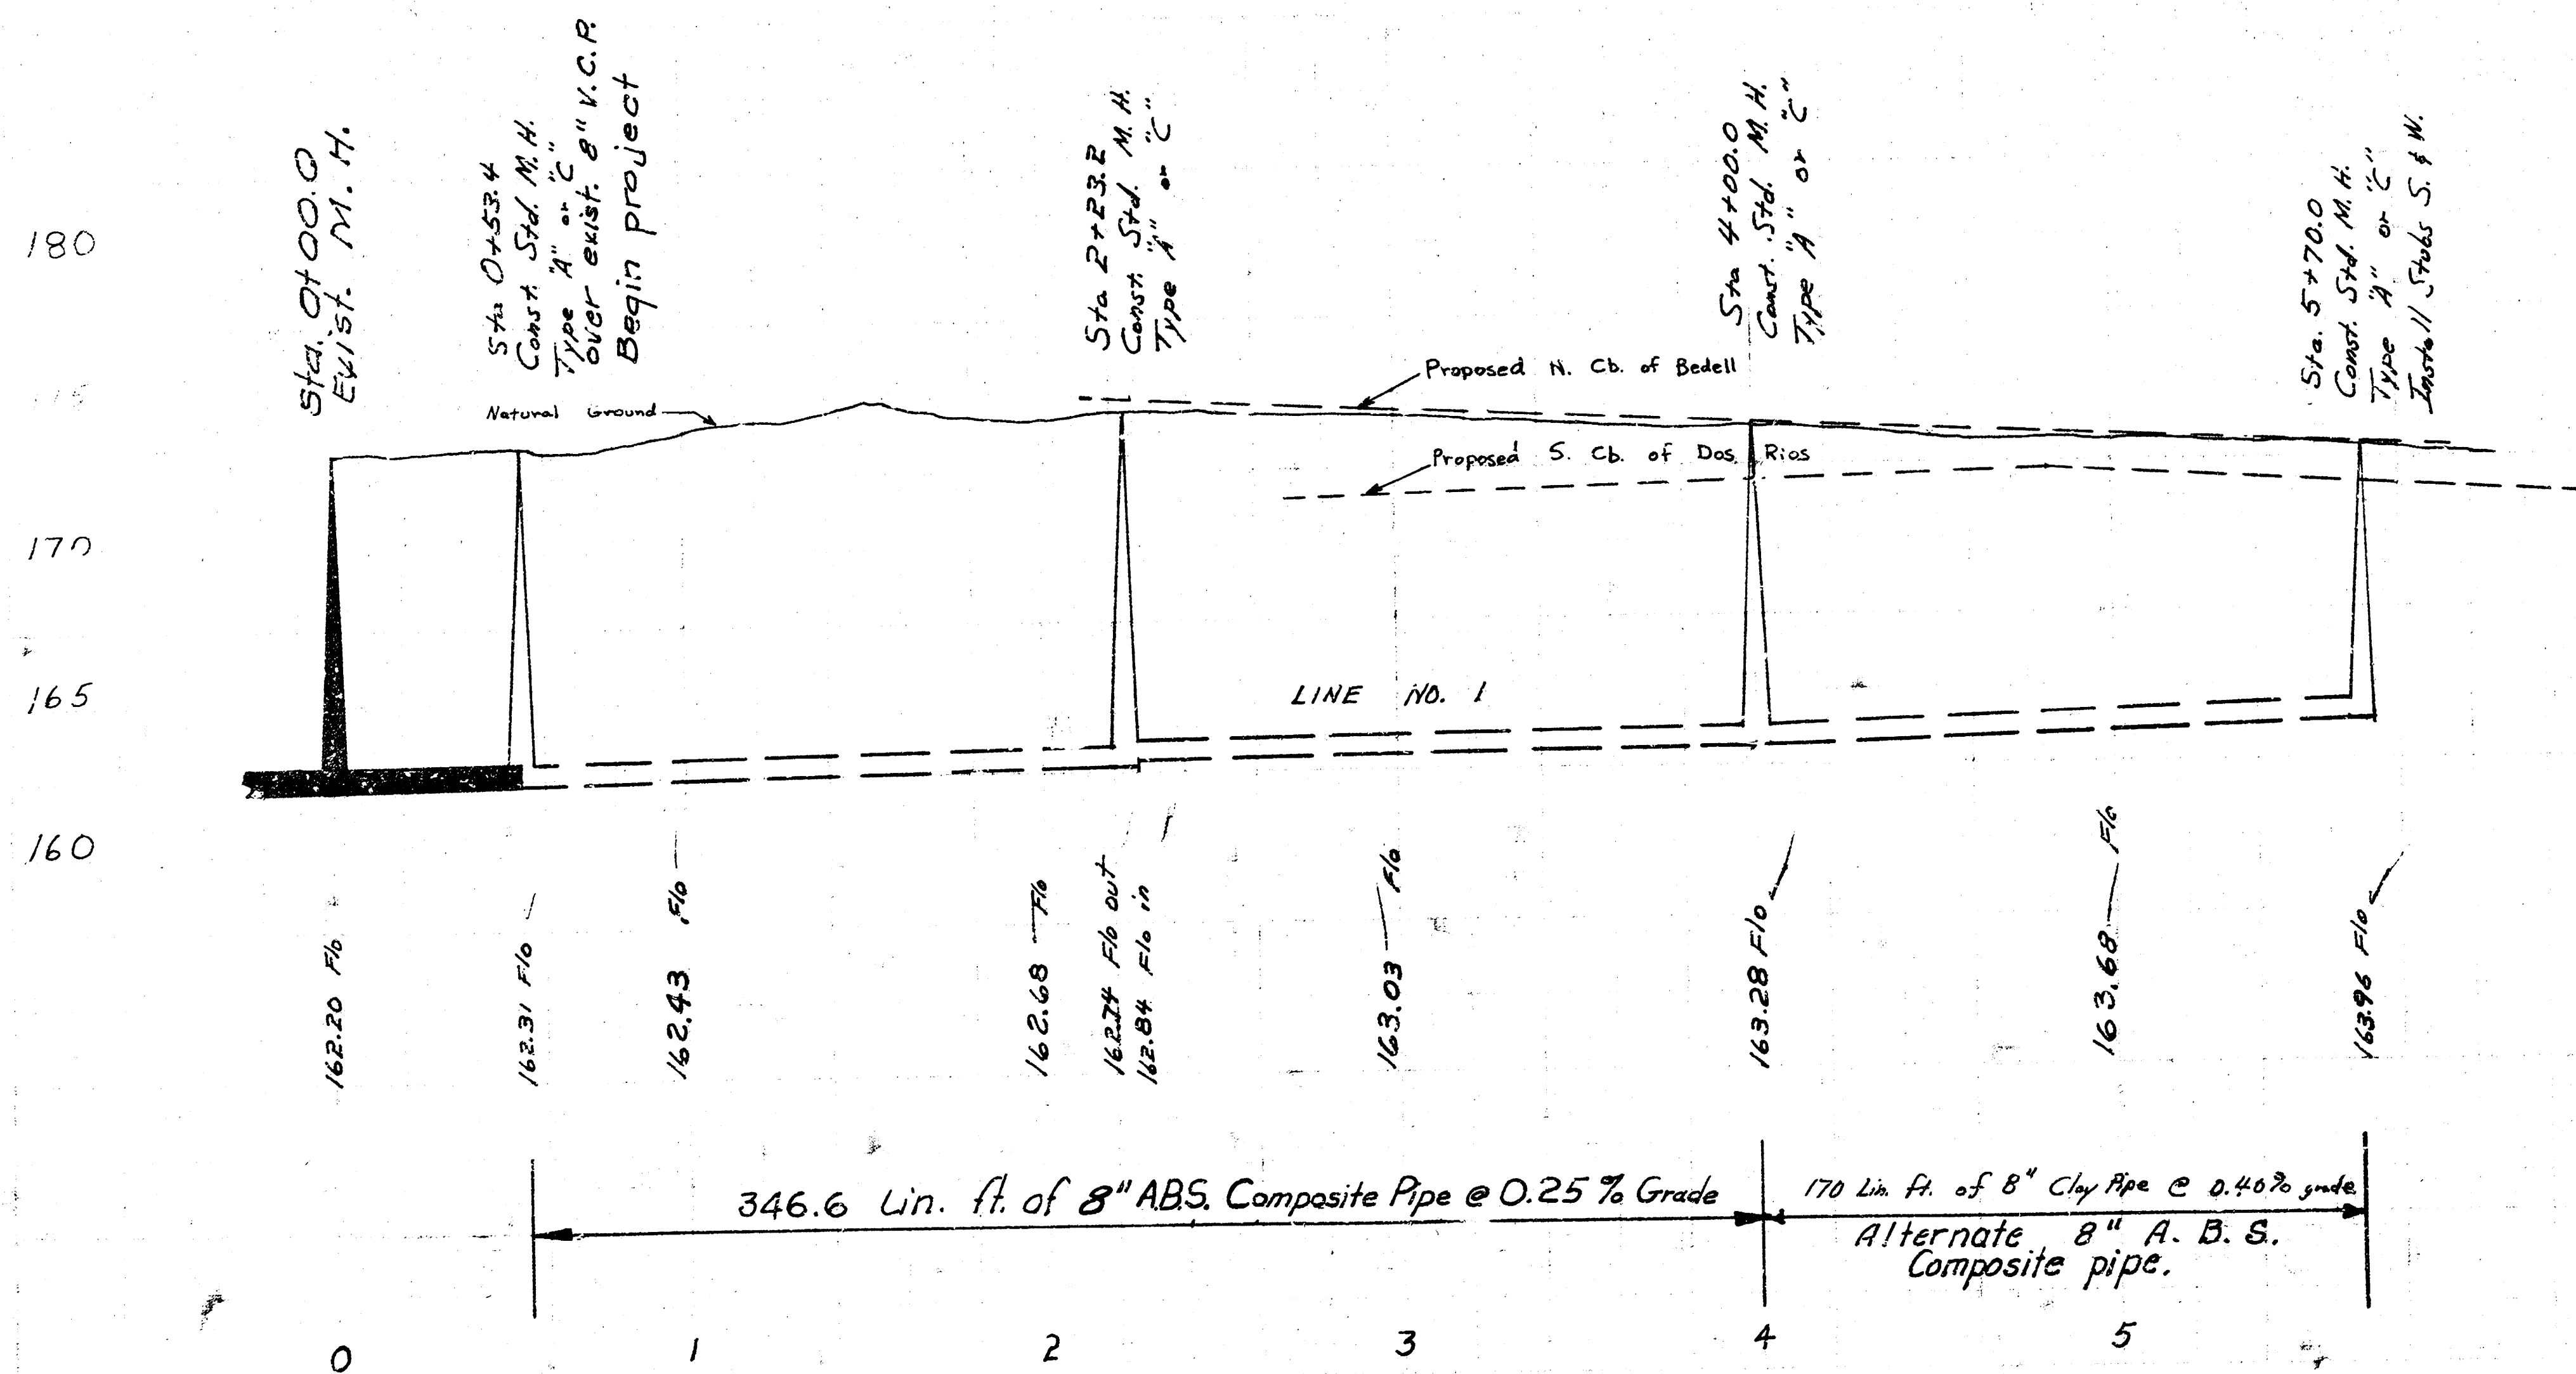

LAT. 9 MAIN 18 W.I.S.
 CITY OF WICHITA, KANSAS
 R. W. LINN — CITY ENGINEER
 MARCH, 1976. PROJECT NO. DBKL574078