
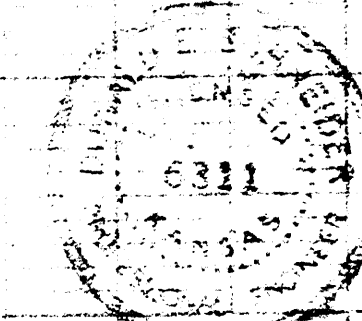




PLAN  
 1"=40'  
 1"=40'

PLAN  
 1"=40'  
 1"=40'

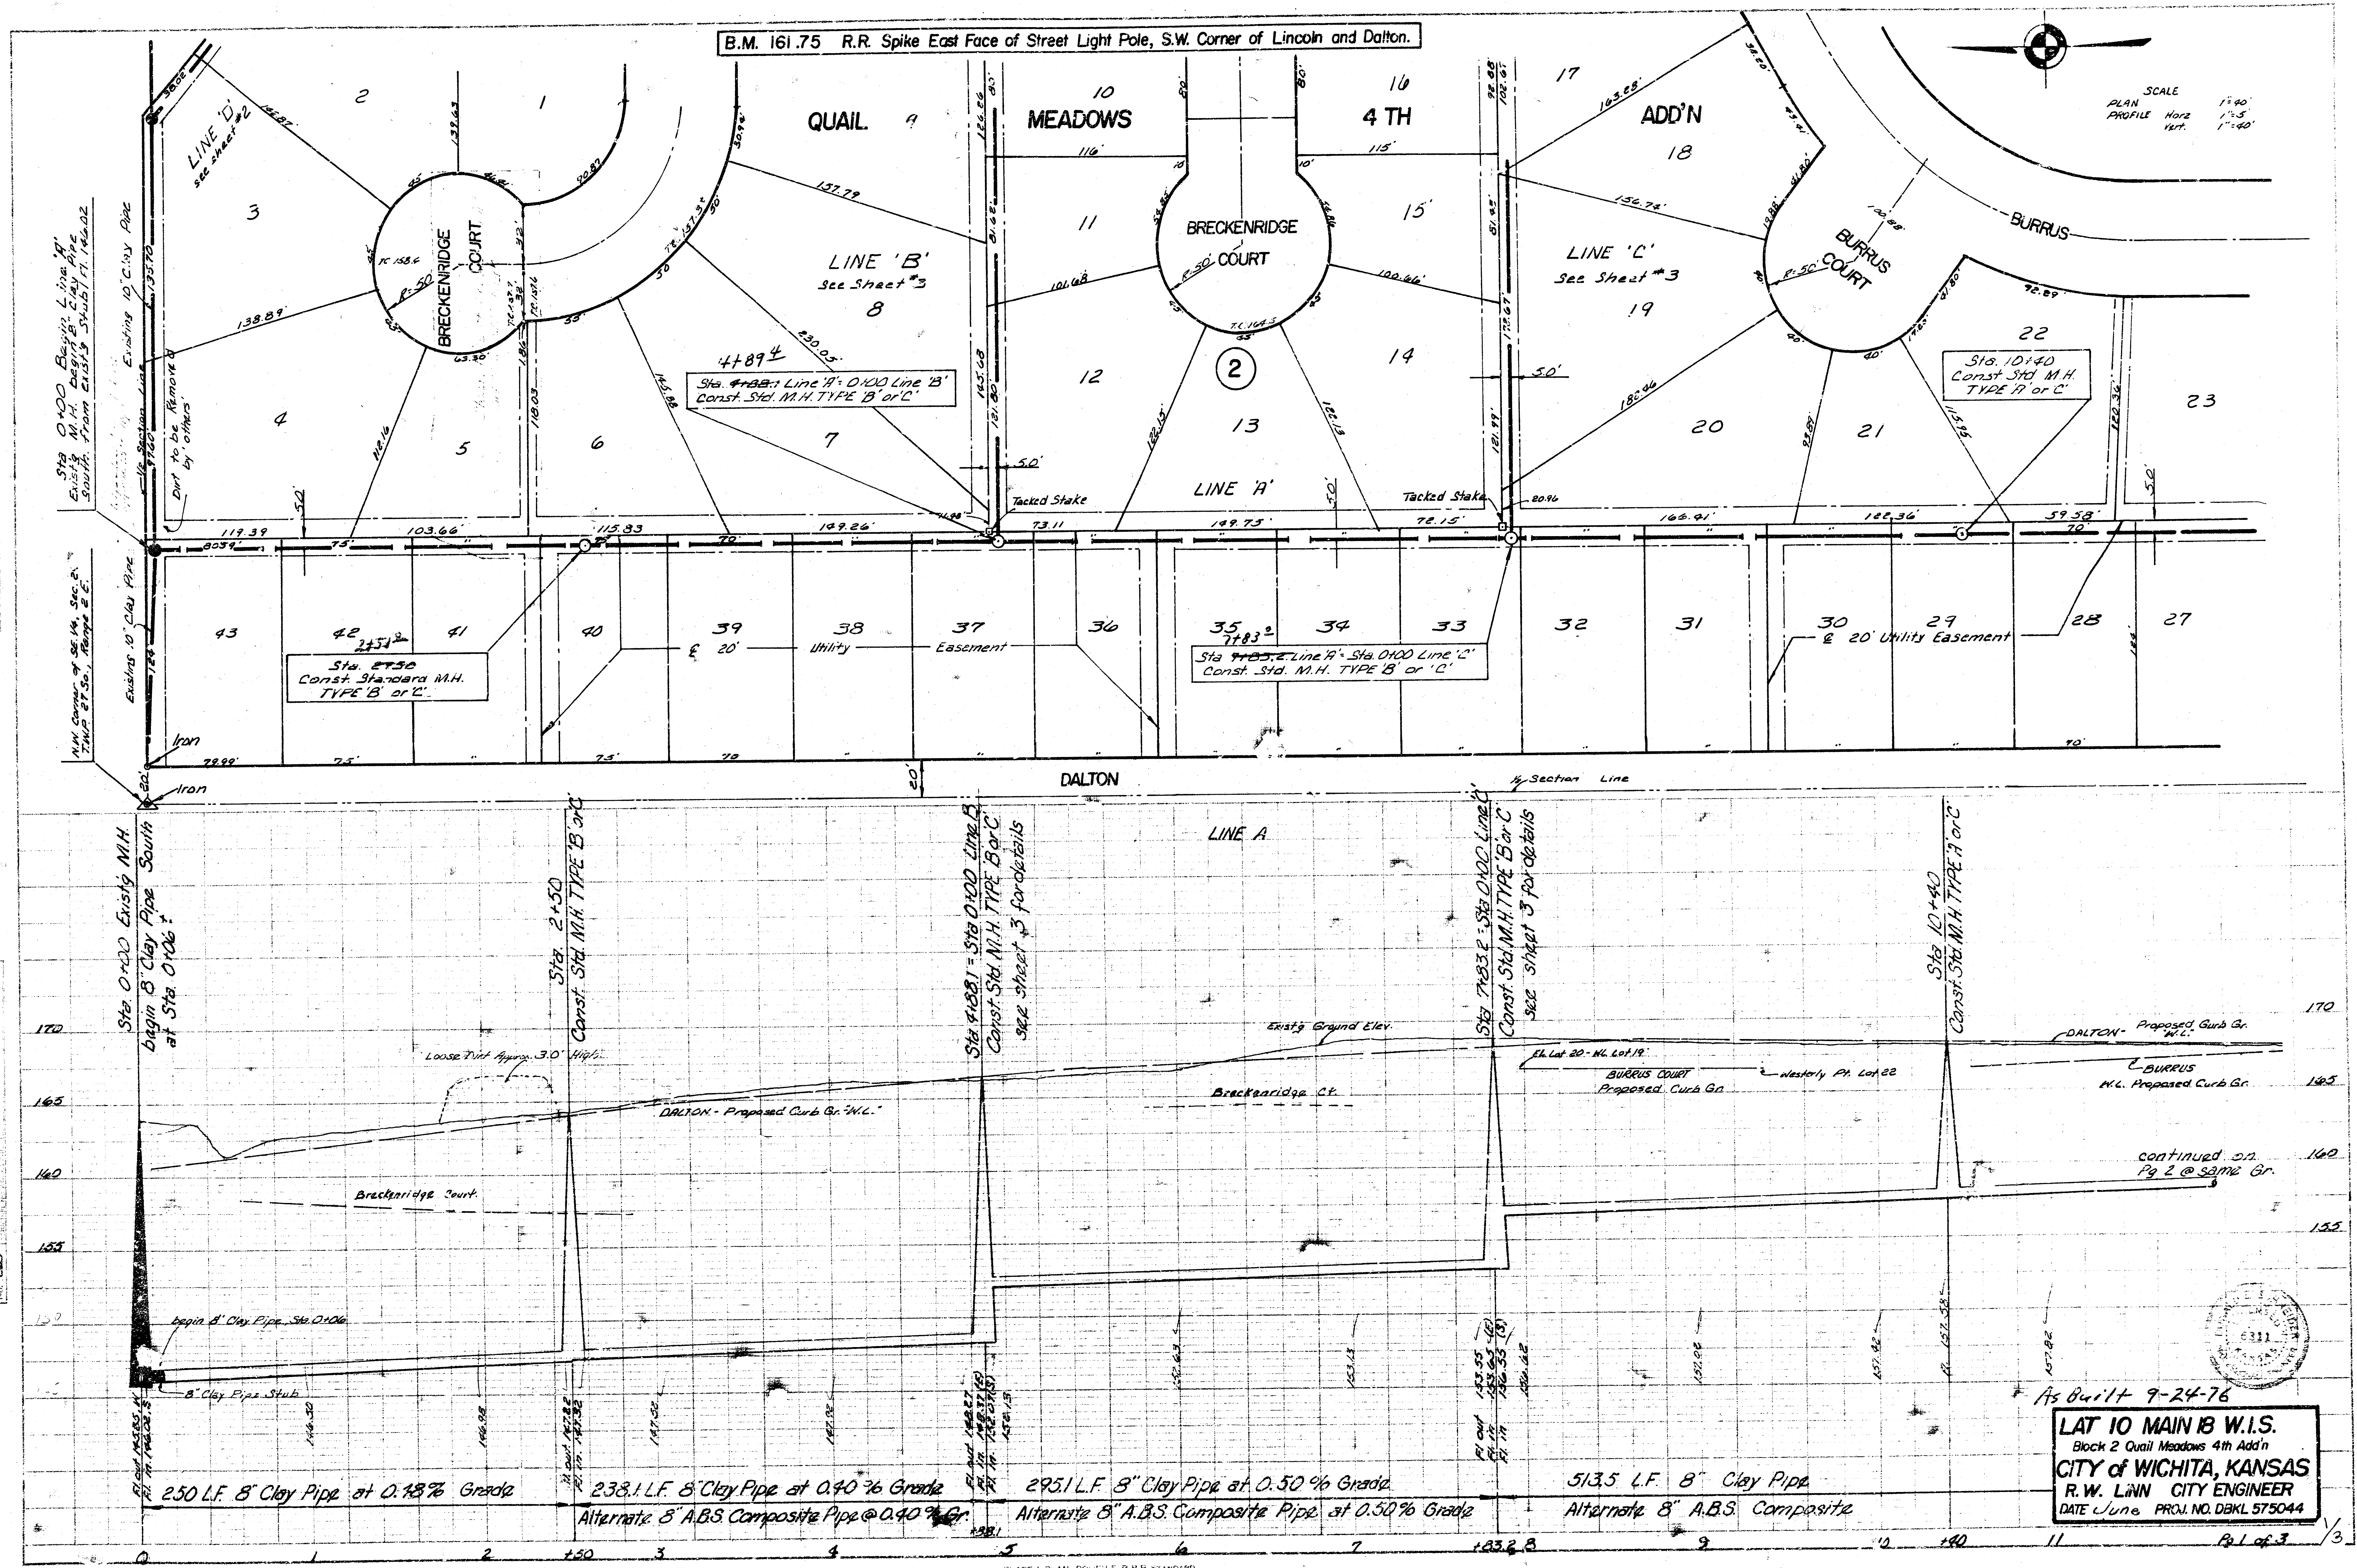


PROFILE  

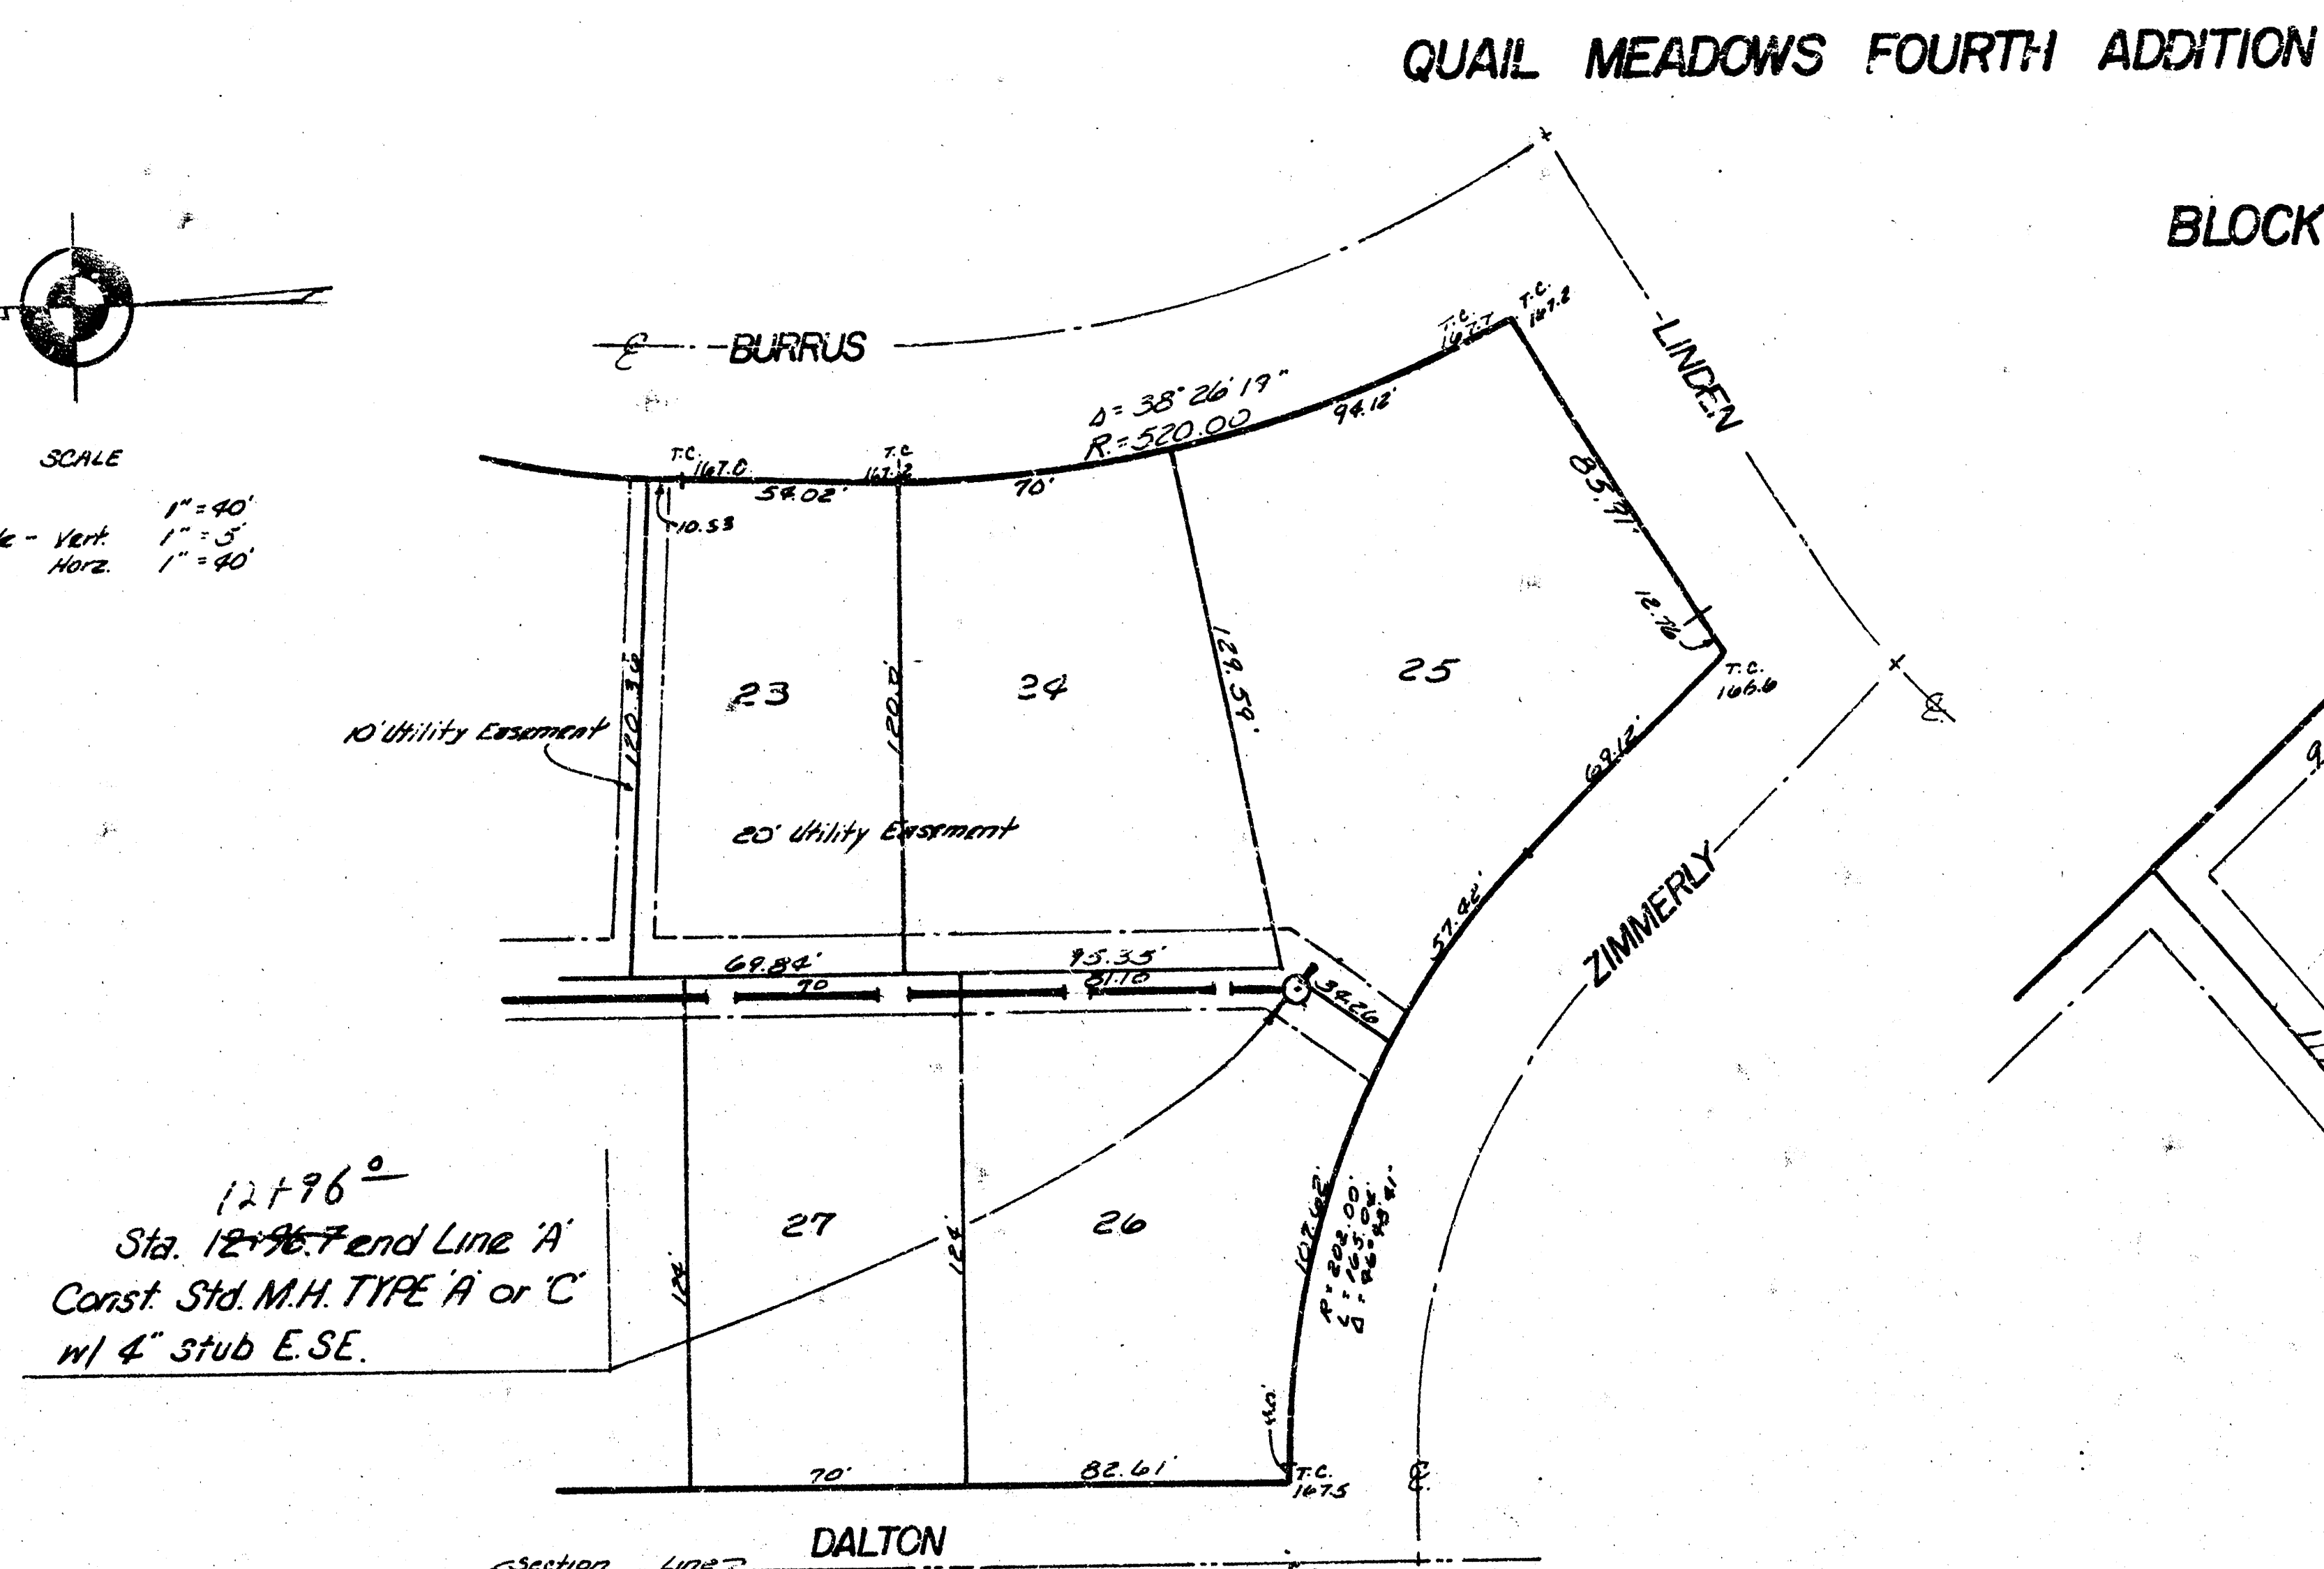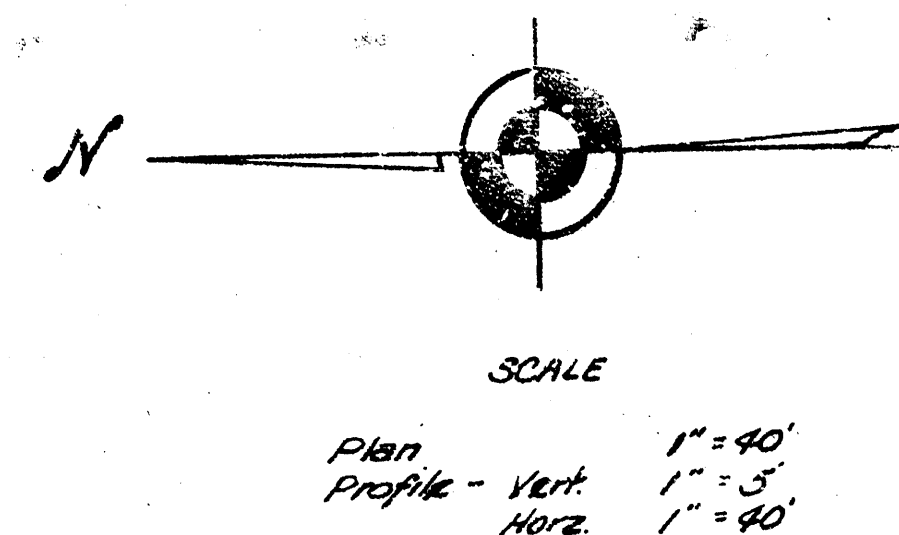

**BLOCK NO. 2**



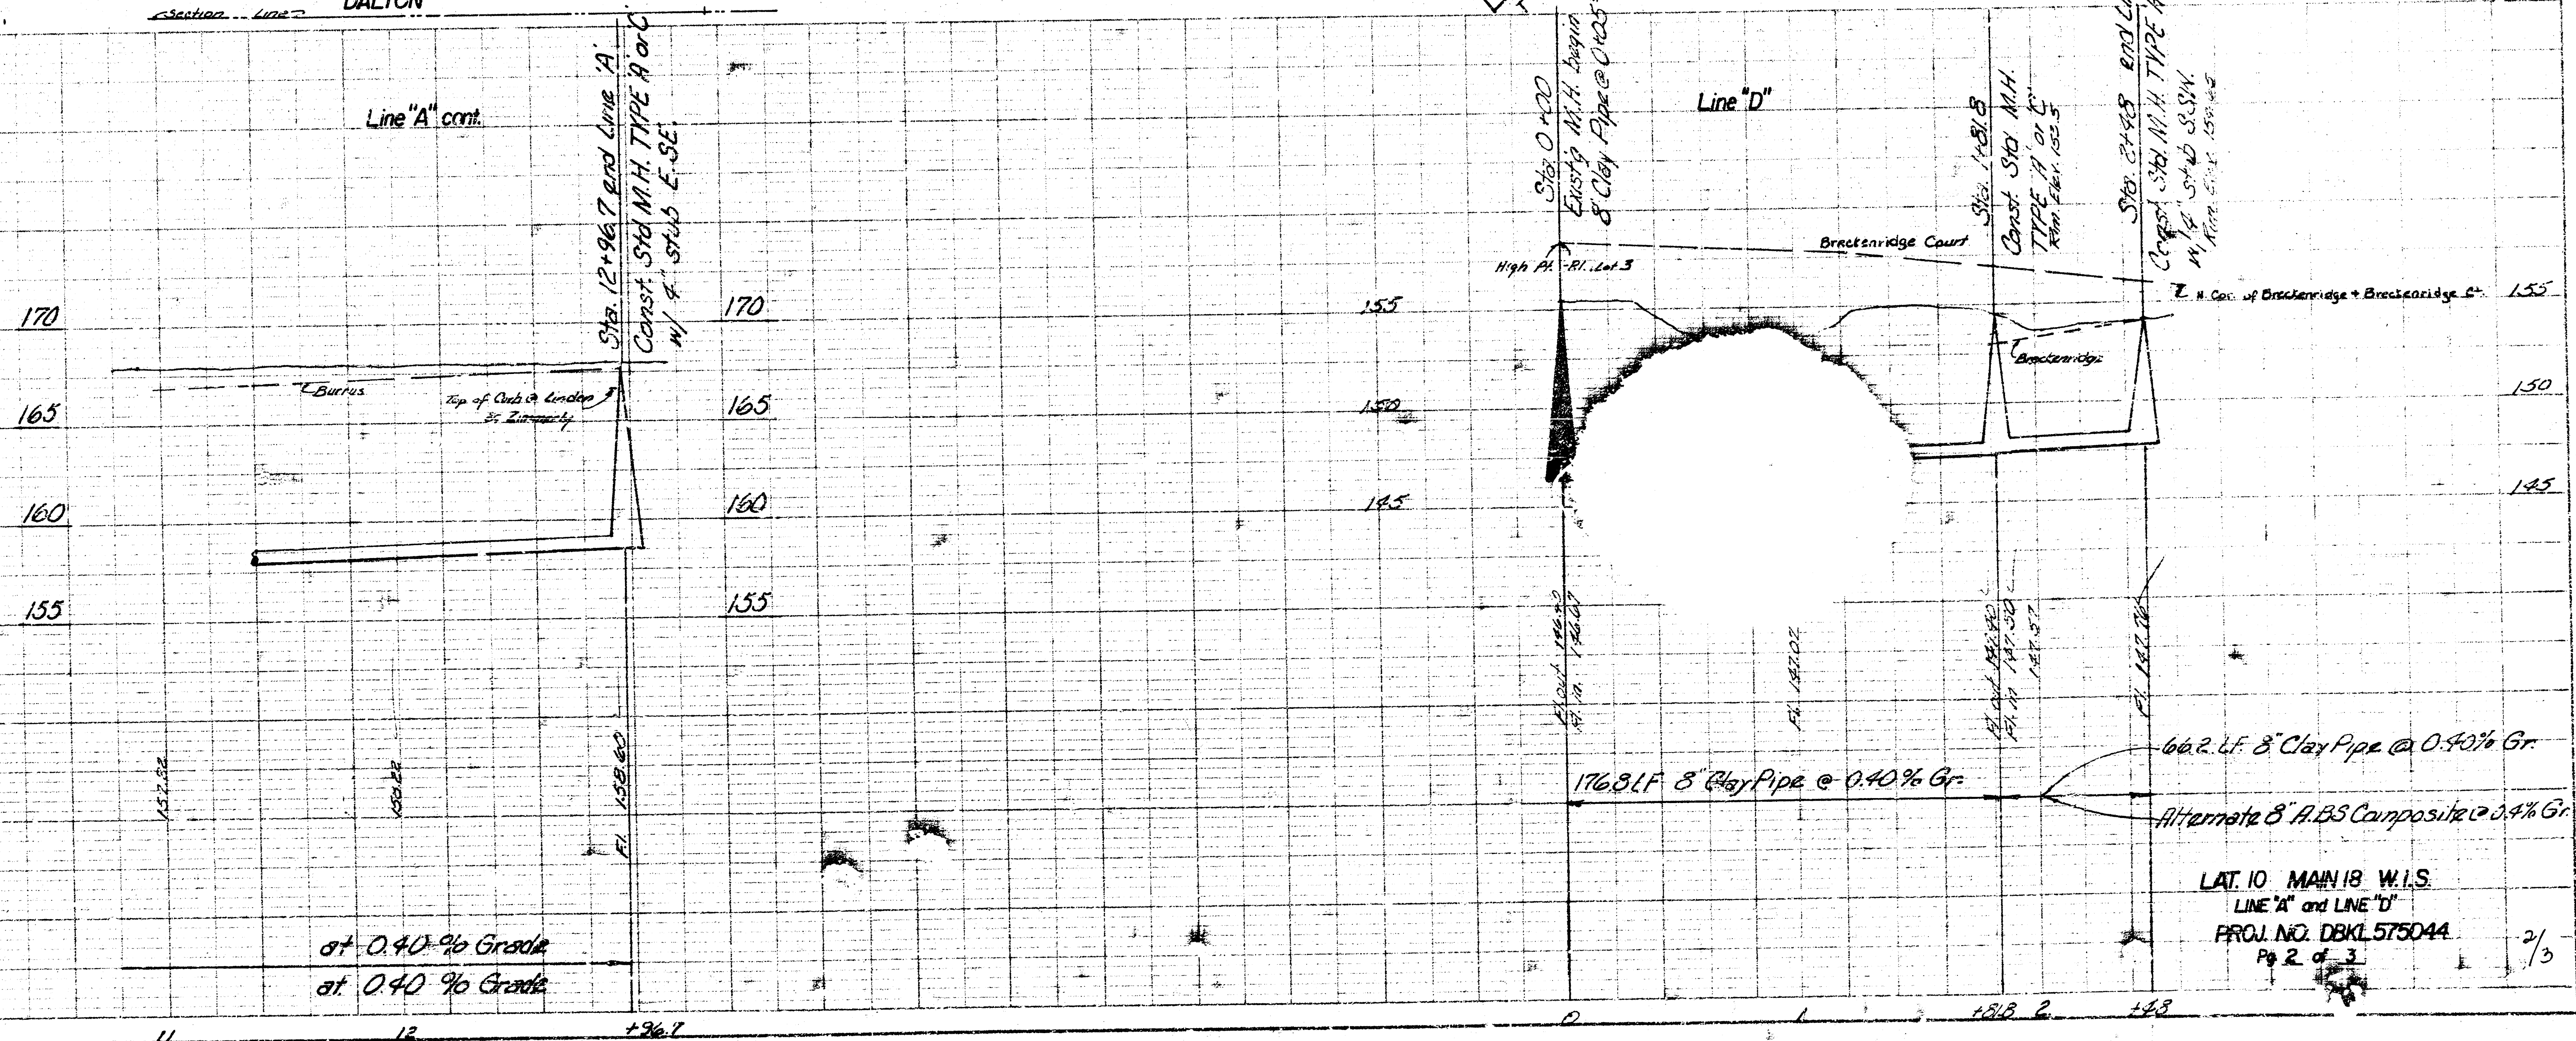


PLATE 1 PLAN-PROFILE B P R STANDARD

B.M. 161.75 R.R. Spike East Face of Street Light Pole, S.W. Corner of Lincoln and Dalton

FOURTH  
BLOCK NO. 2

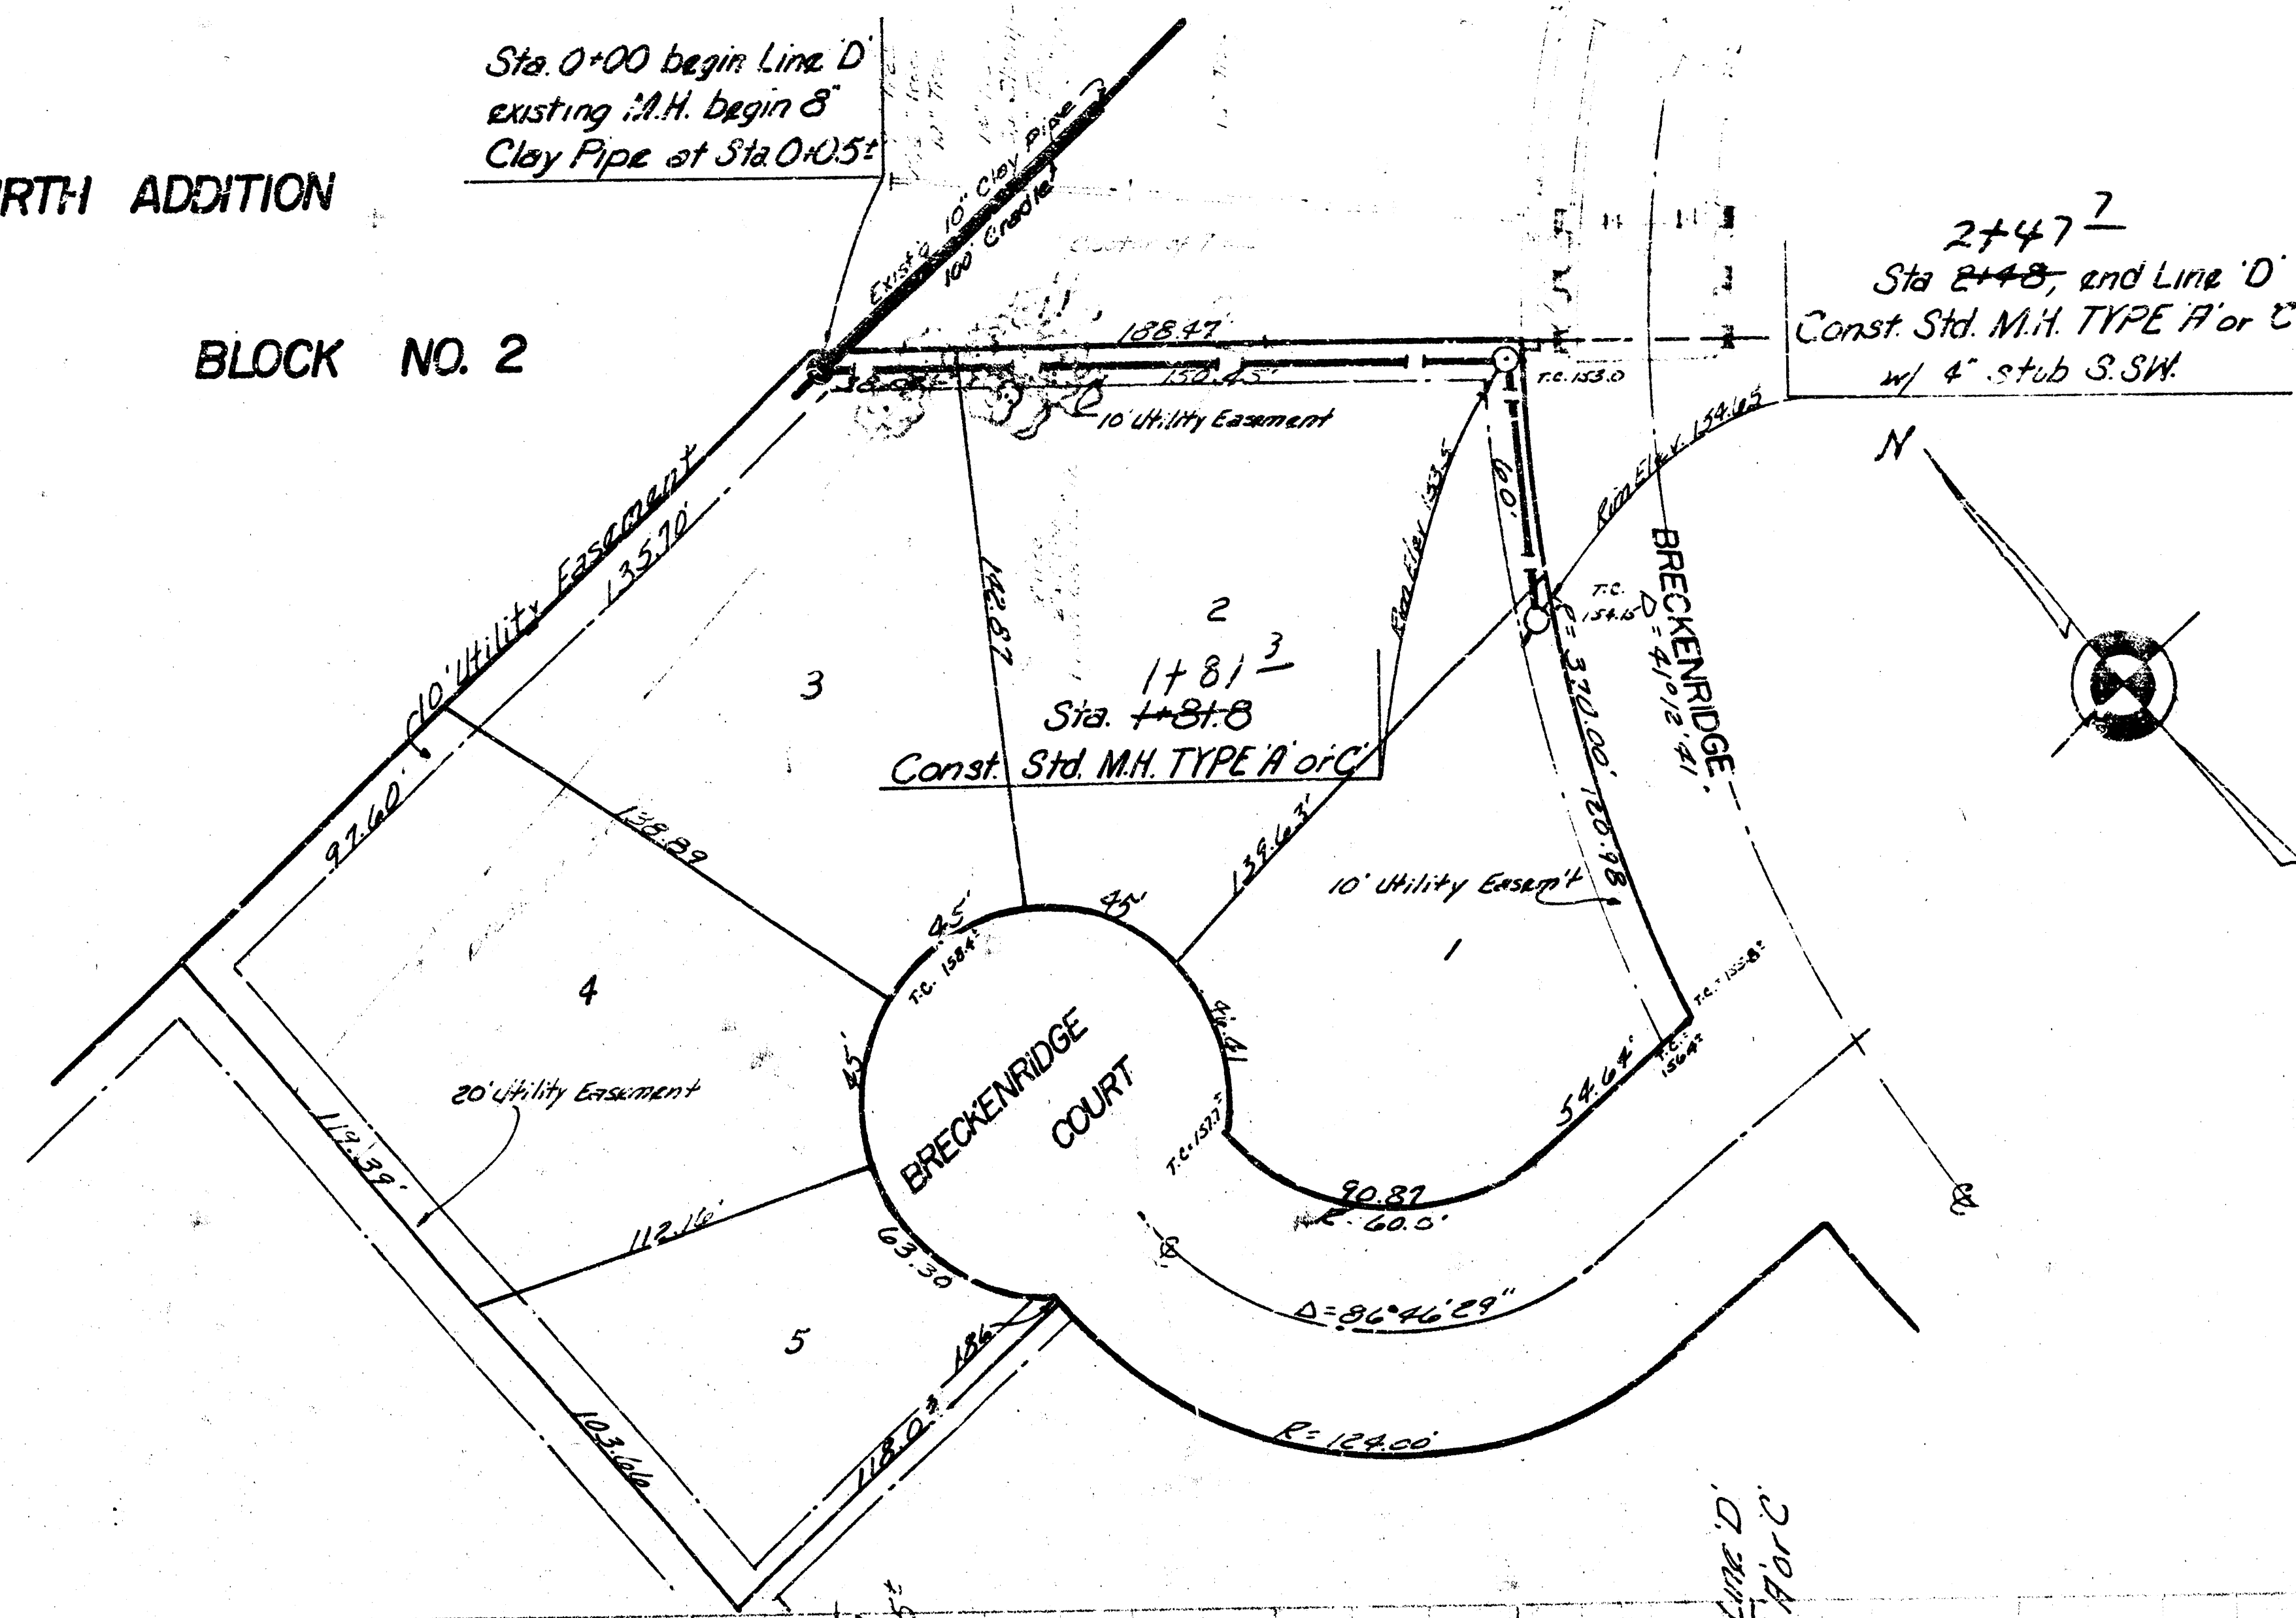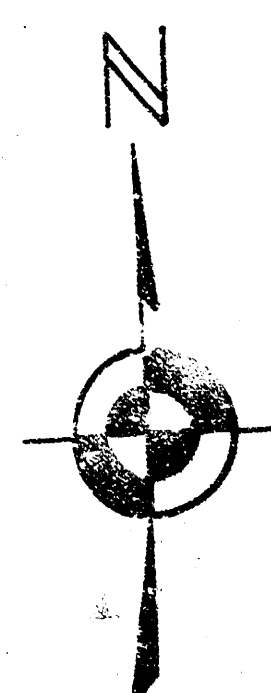

SCALE  
PLAN 1"=40'  
PROFILE Vert. 1"=5'  
HORZ. 1"=40'



LINE "A"  
SHEET NO. 1

Sta 0+00 Line "B" = Sta 4+88.1  
Line "A" begin 8" ABS Composite Pipe, East, see sheet 1

LINE "A"  
Sta 0+00 Line "C" = Sta 7+83.2  
Line "A" begin 8" S.S. East  
see sheet No. 1

2+14.2  
Sta. 2+13.4 and Line "B"  
Const. Std. M.H. TYPE "A" or "C"  
w/ 4" stub S.E.

2+13.2  
Sta. 2+13.4 and Line "C"  
Const. Std. M.H. TYPE "A" or "C"  
w/ 4" stub N.E.

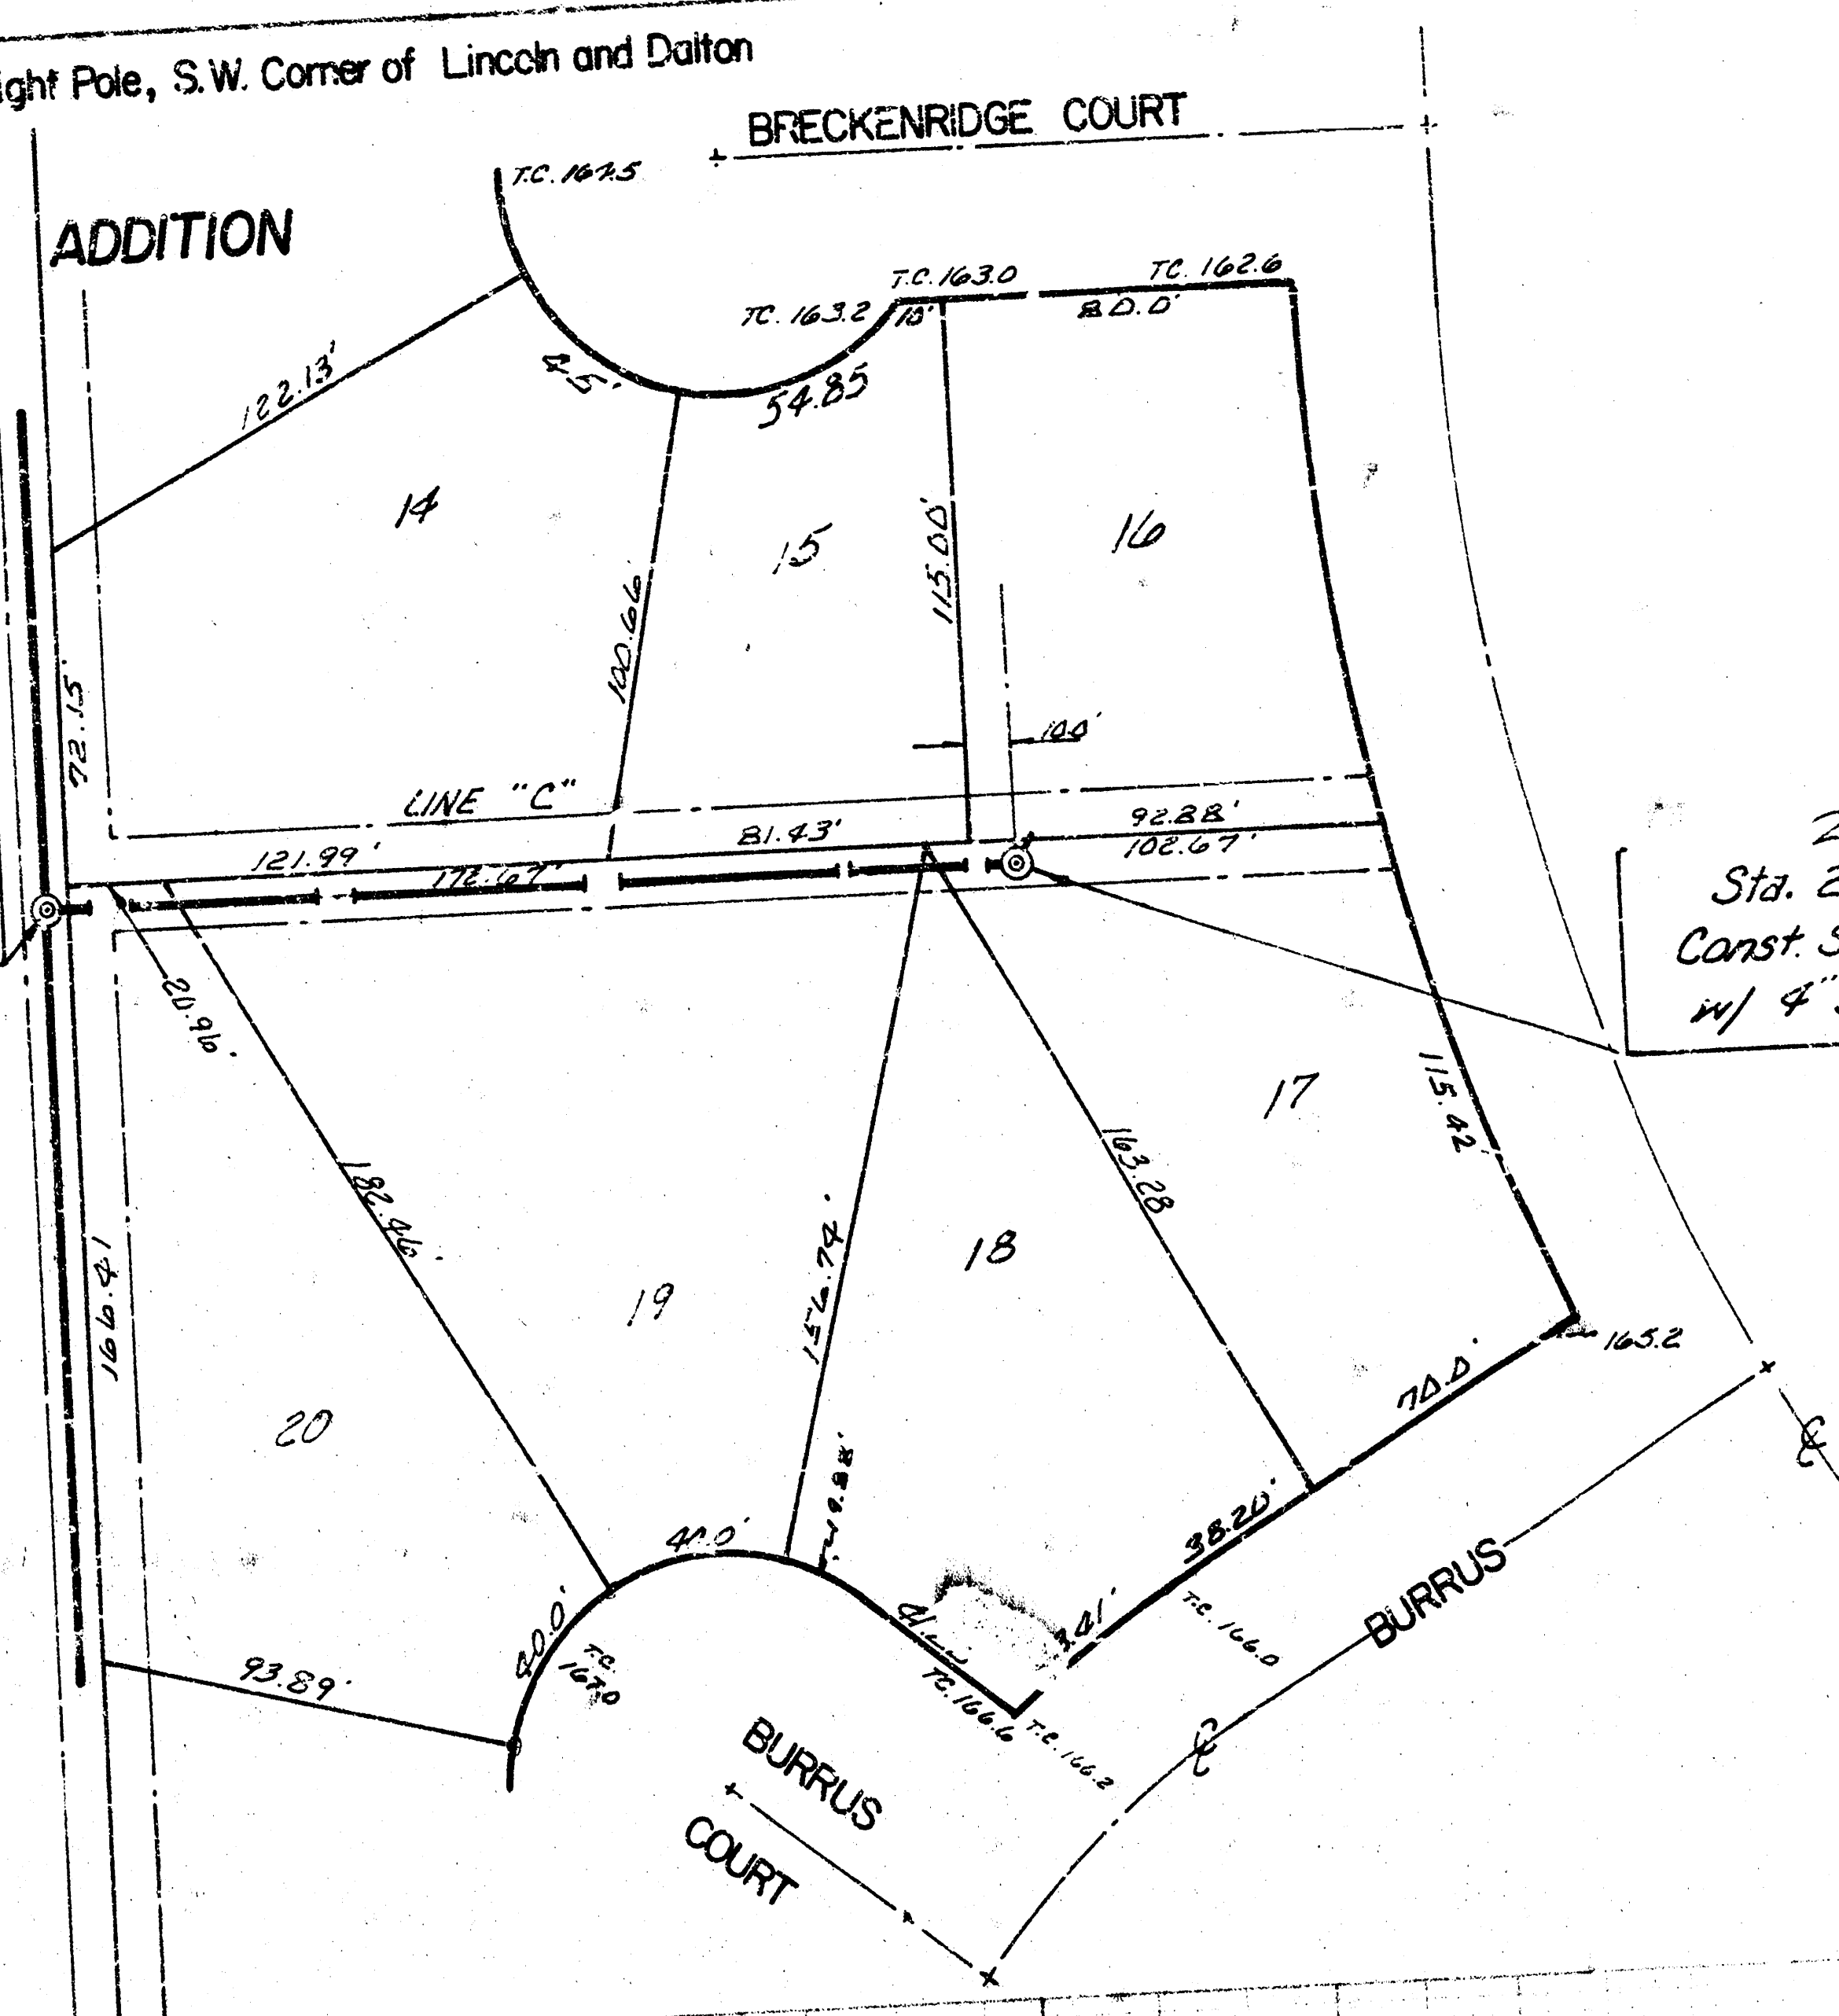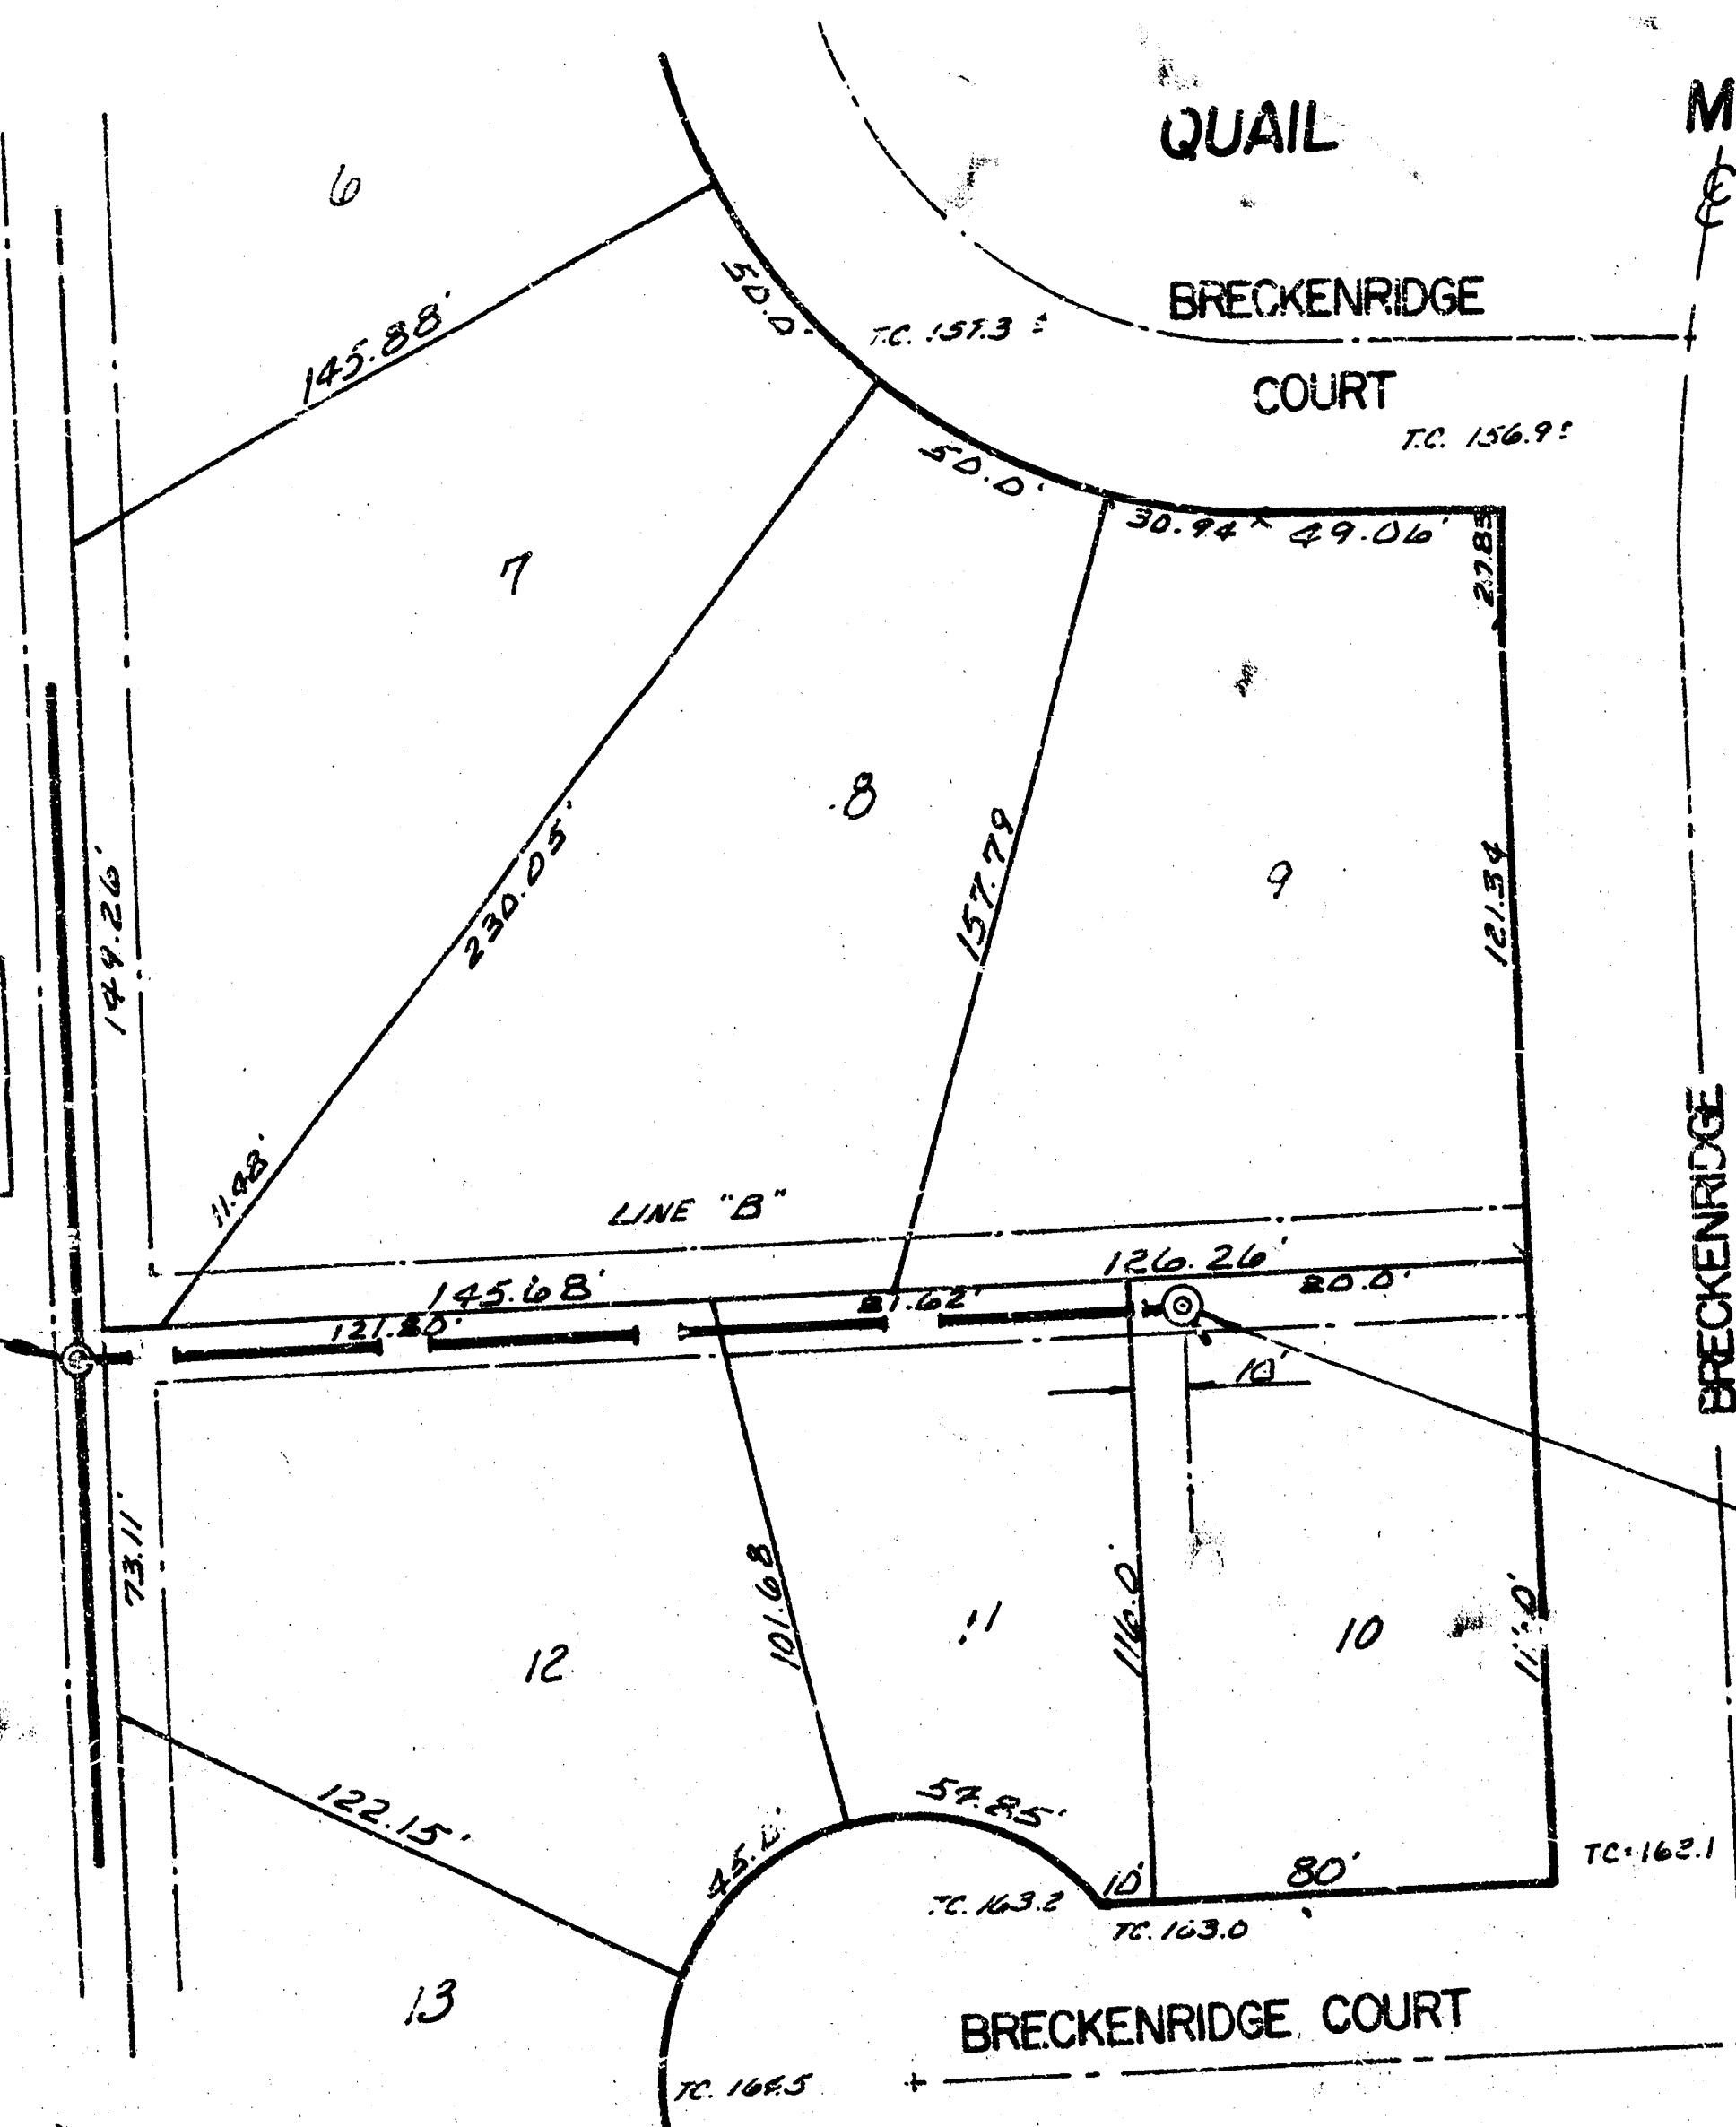

LAT. 10 MAIN 18 W.L.S.  
LINE "B" and "C"  
PROJ. NO. DBKL575044  
Pg. 3 of 3