
MAIN 19, WAR INDUSTRIES SEWER

CITY OF WICHITA, KANSAS

R. W. LINN – CITY ENGINEER

1976, PROJECT NO. DBKM 574055

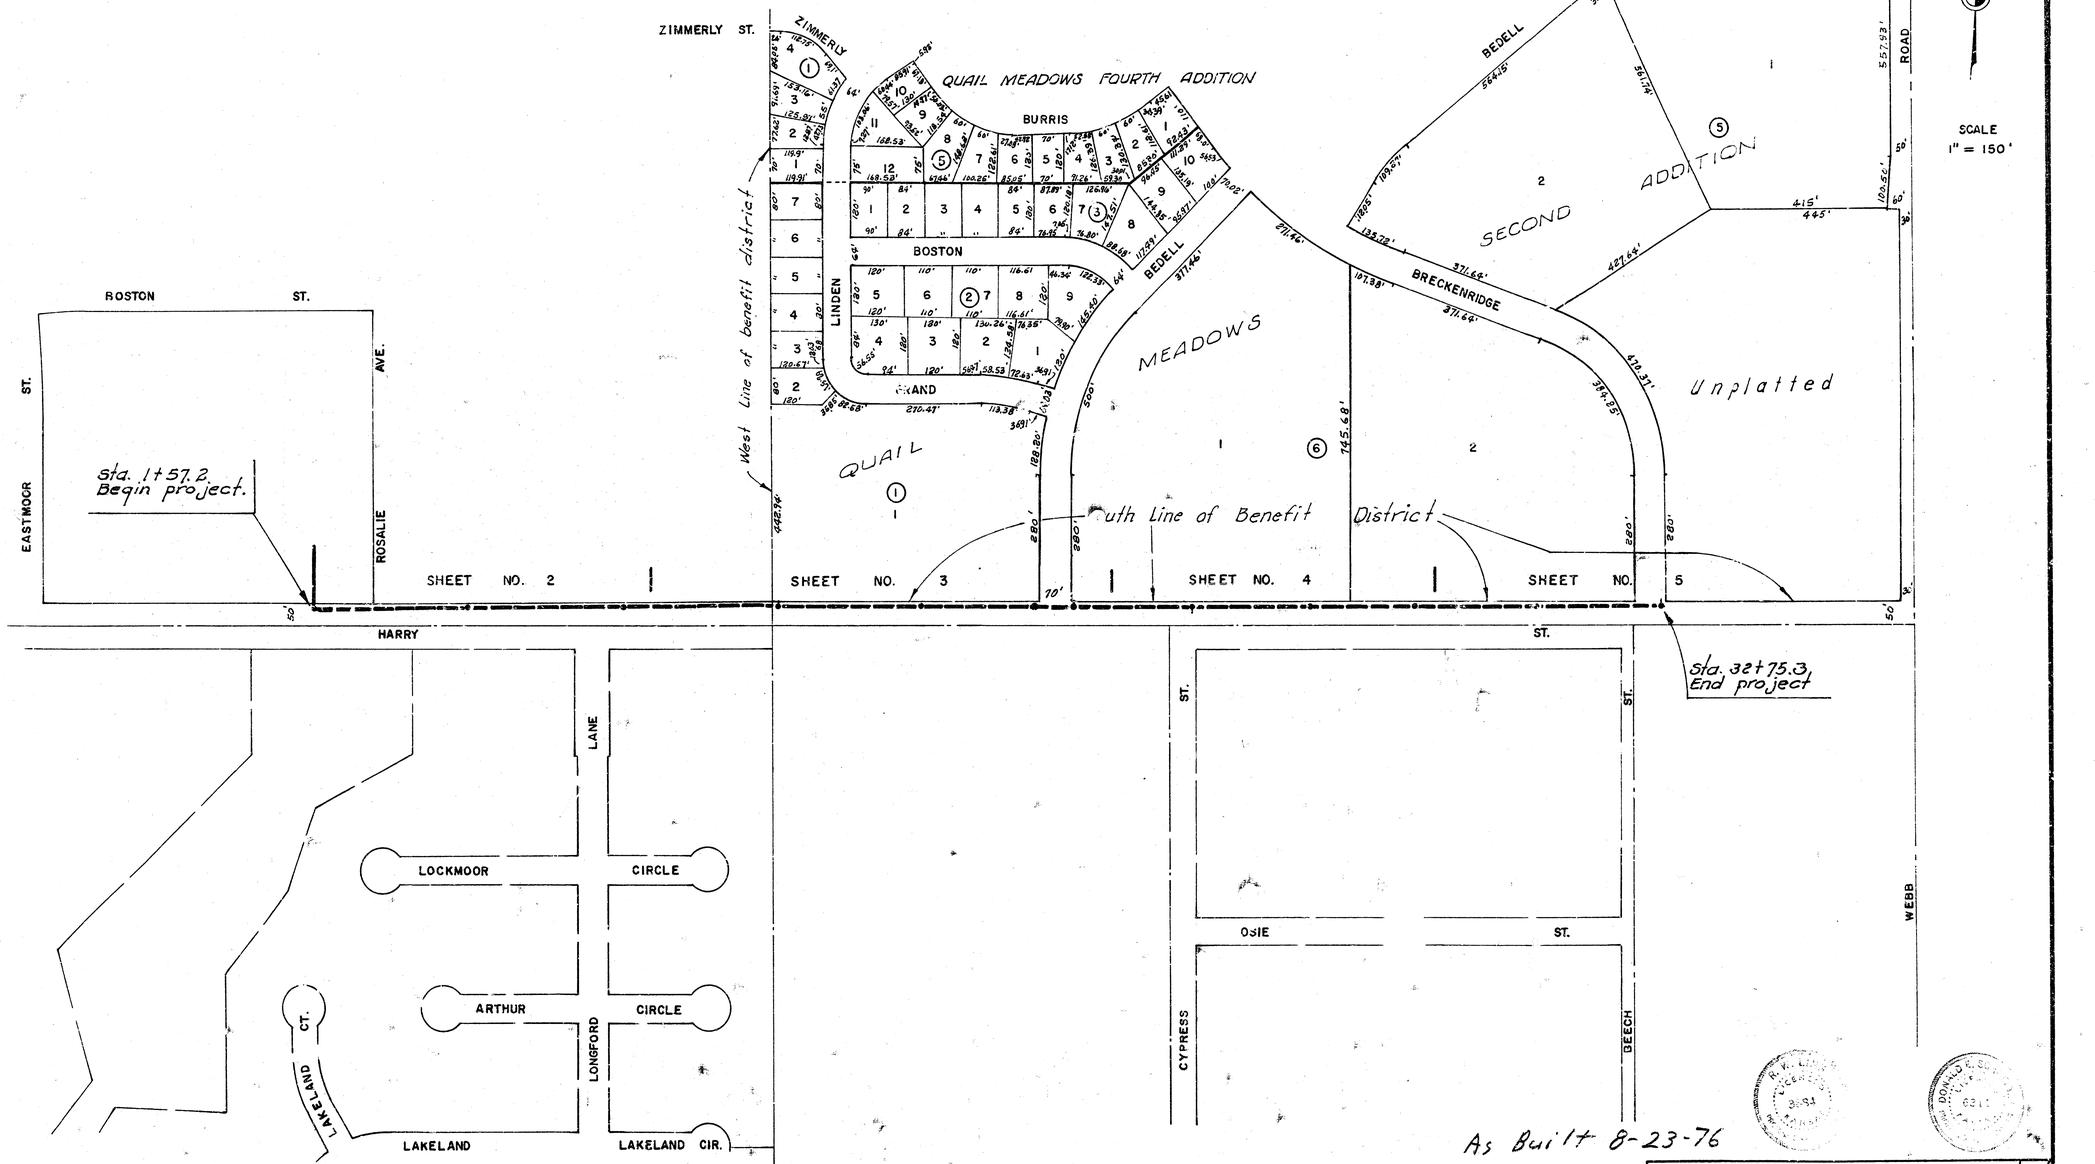


As Built 8-23-76

MAIN 19, W. I. S. 1/5 | 1/5


PROJECT NO. DBKM 57 4055

B. M. 161.82 City Std. 42' W. & 48' S. of ¼ Sec. cor. 1/2 Mile E. of Rock Rd. & Harry.


B. M. 172.03 Webb Rd. & Harry City B.M. disc. 48' So. & 46' W. of ℄ both.

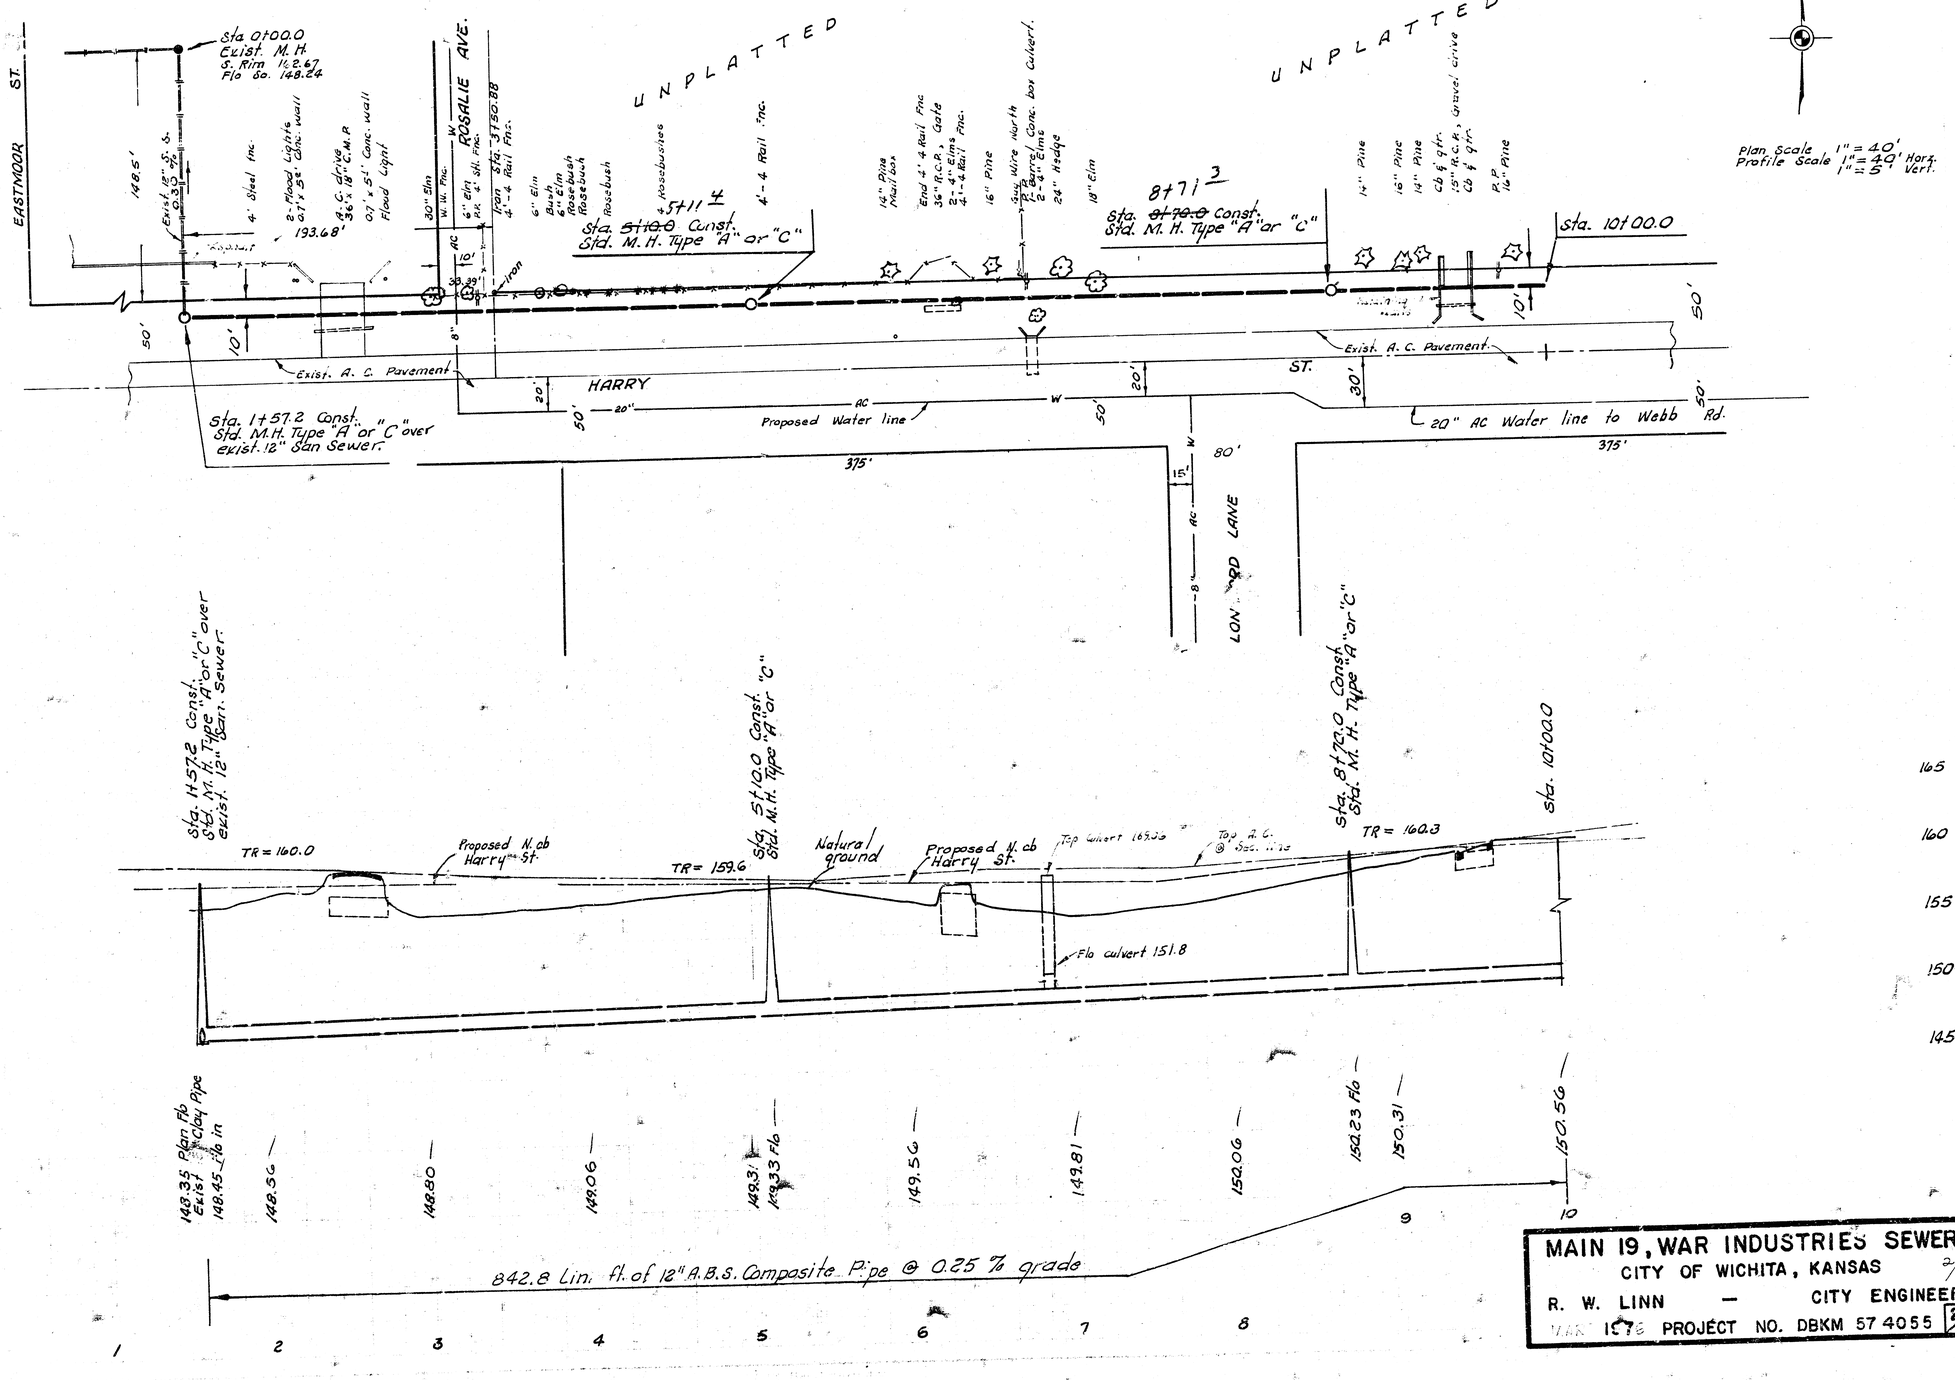


MAIN 19, WAR INDUSTRIES SEWER
CITY OF WICHITA, KANSAS 2/5
R. W. LINN — CITY ENGINEER
WAR 1578 PROJECT NO. DBKM 57 4055 2/5

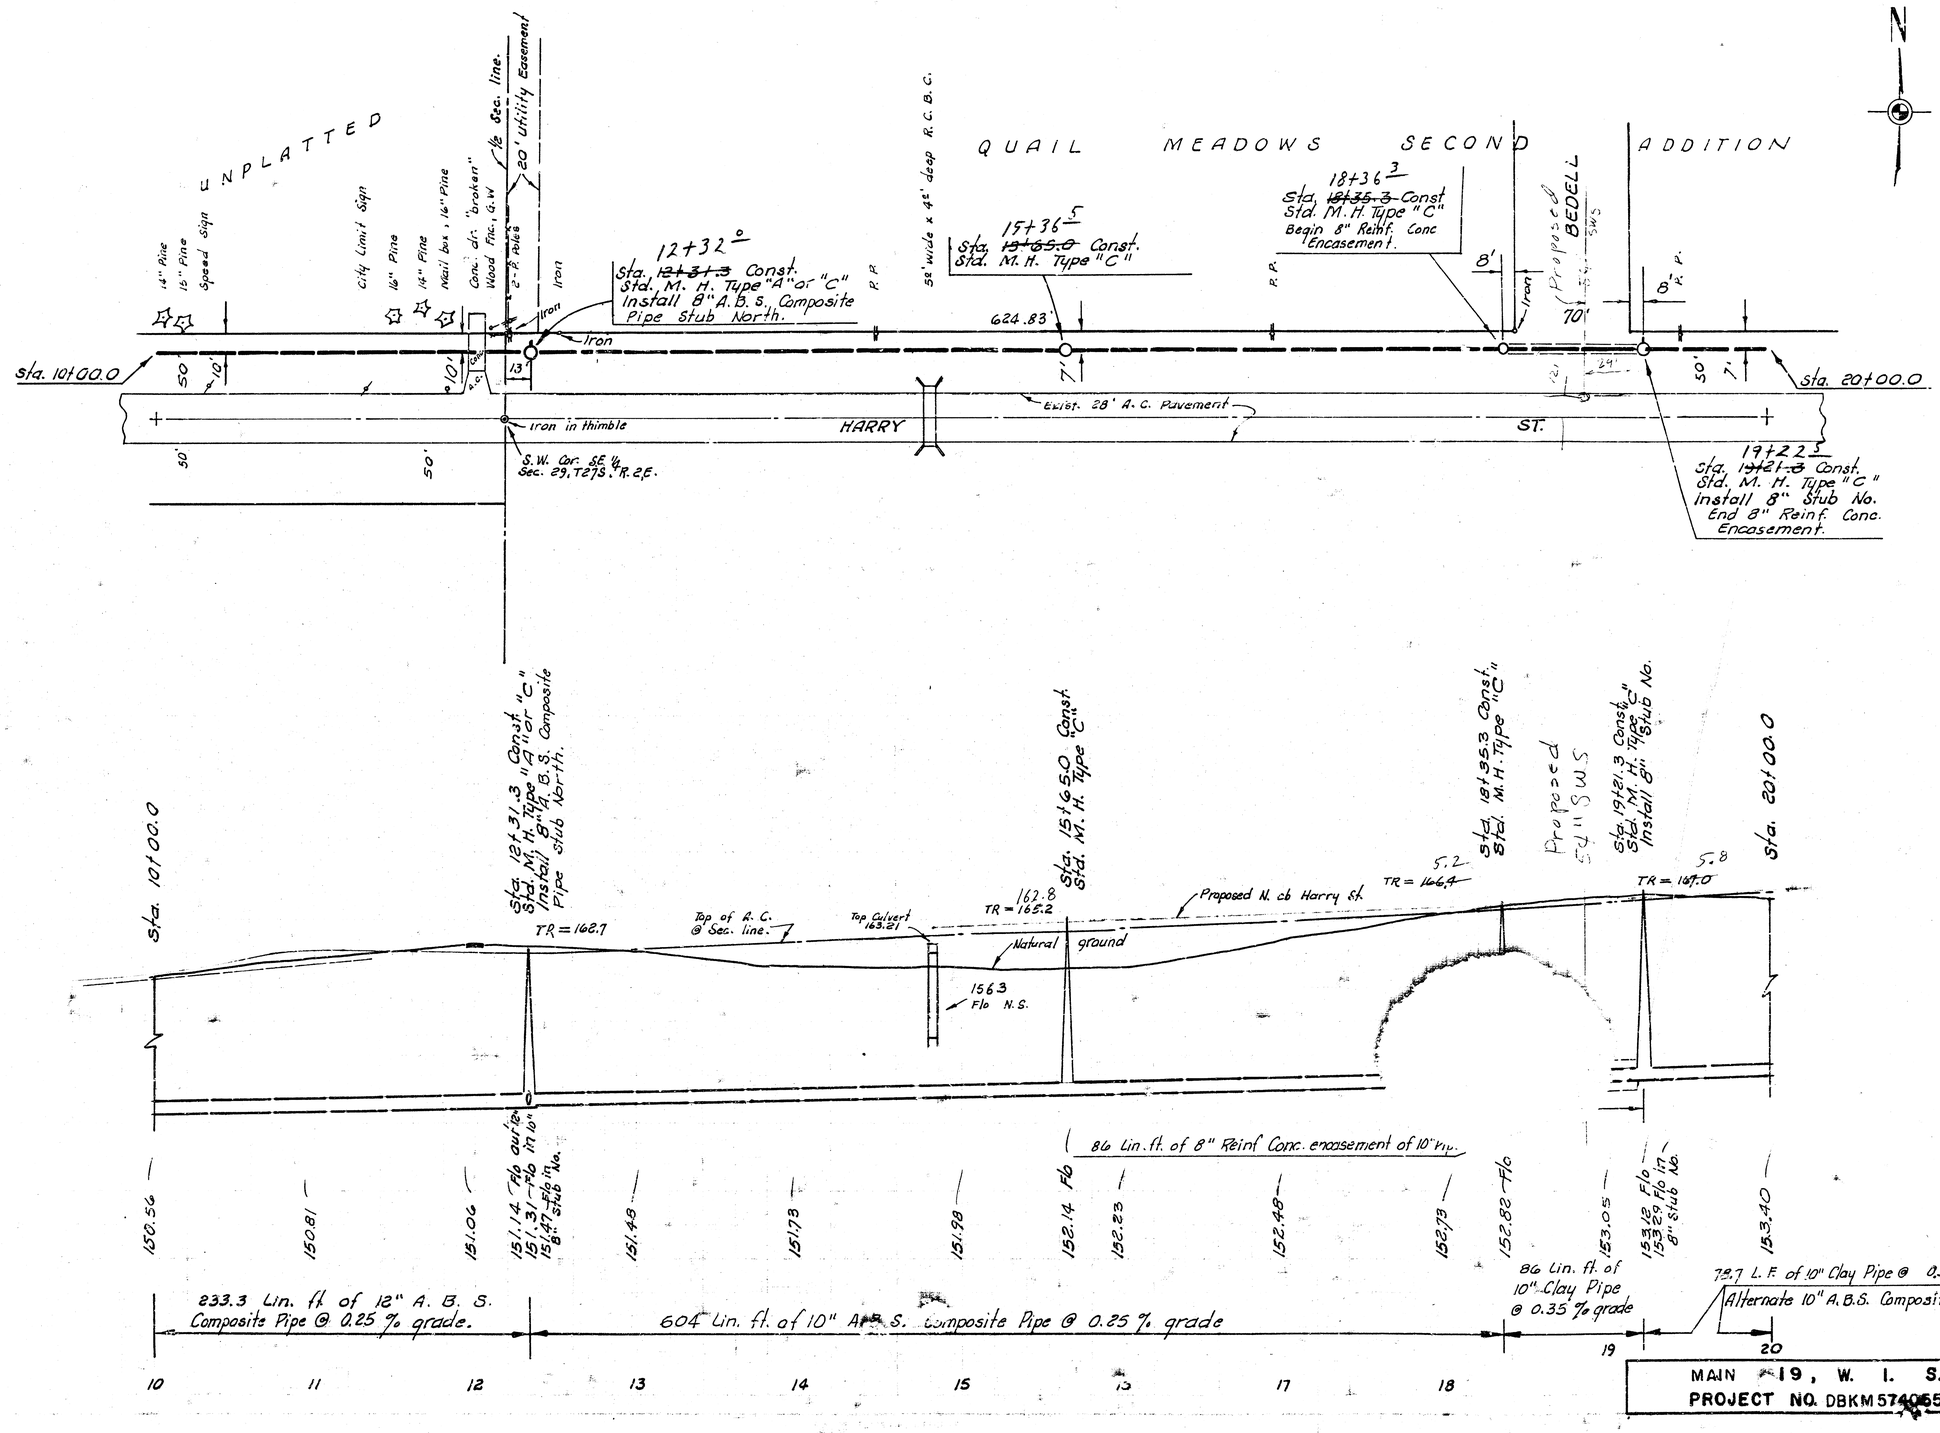


MAIN 19, W. I. S. 3/5 | 3/5
PROJECT NO. DBKM 574055

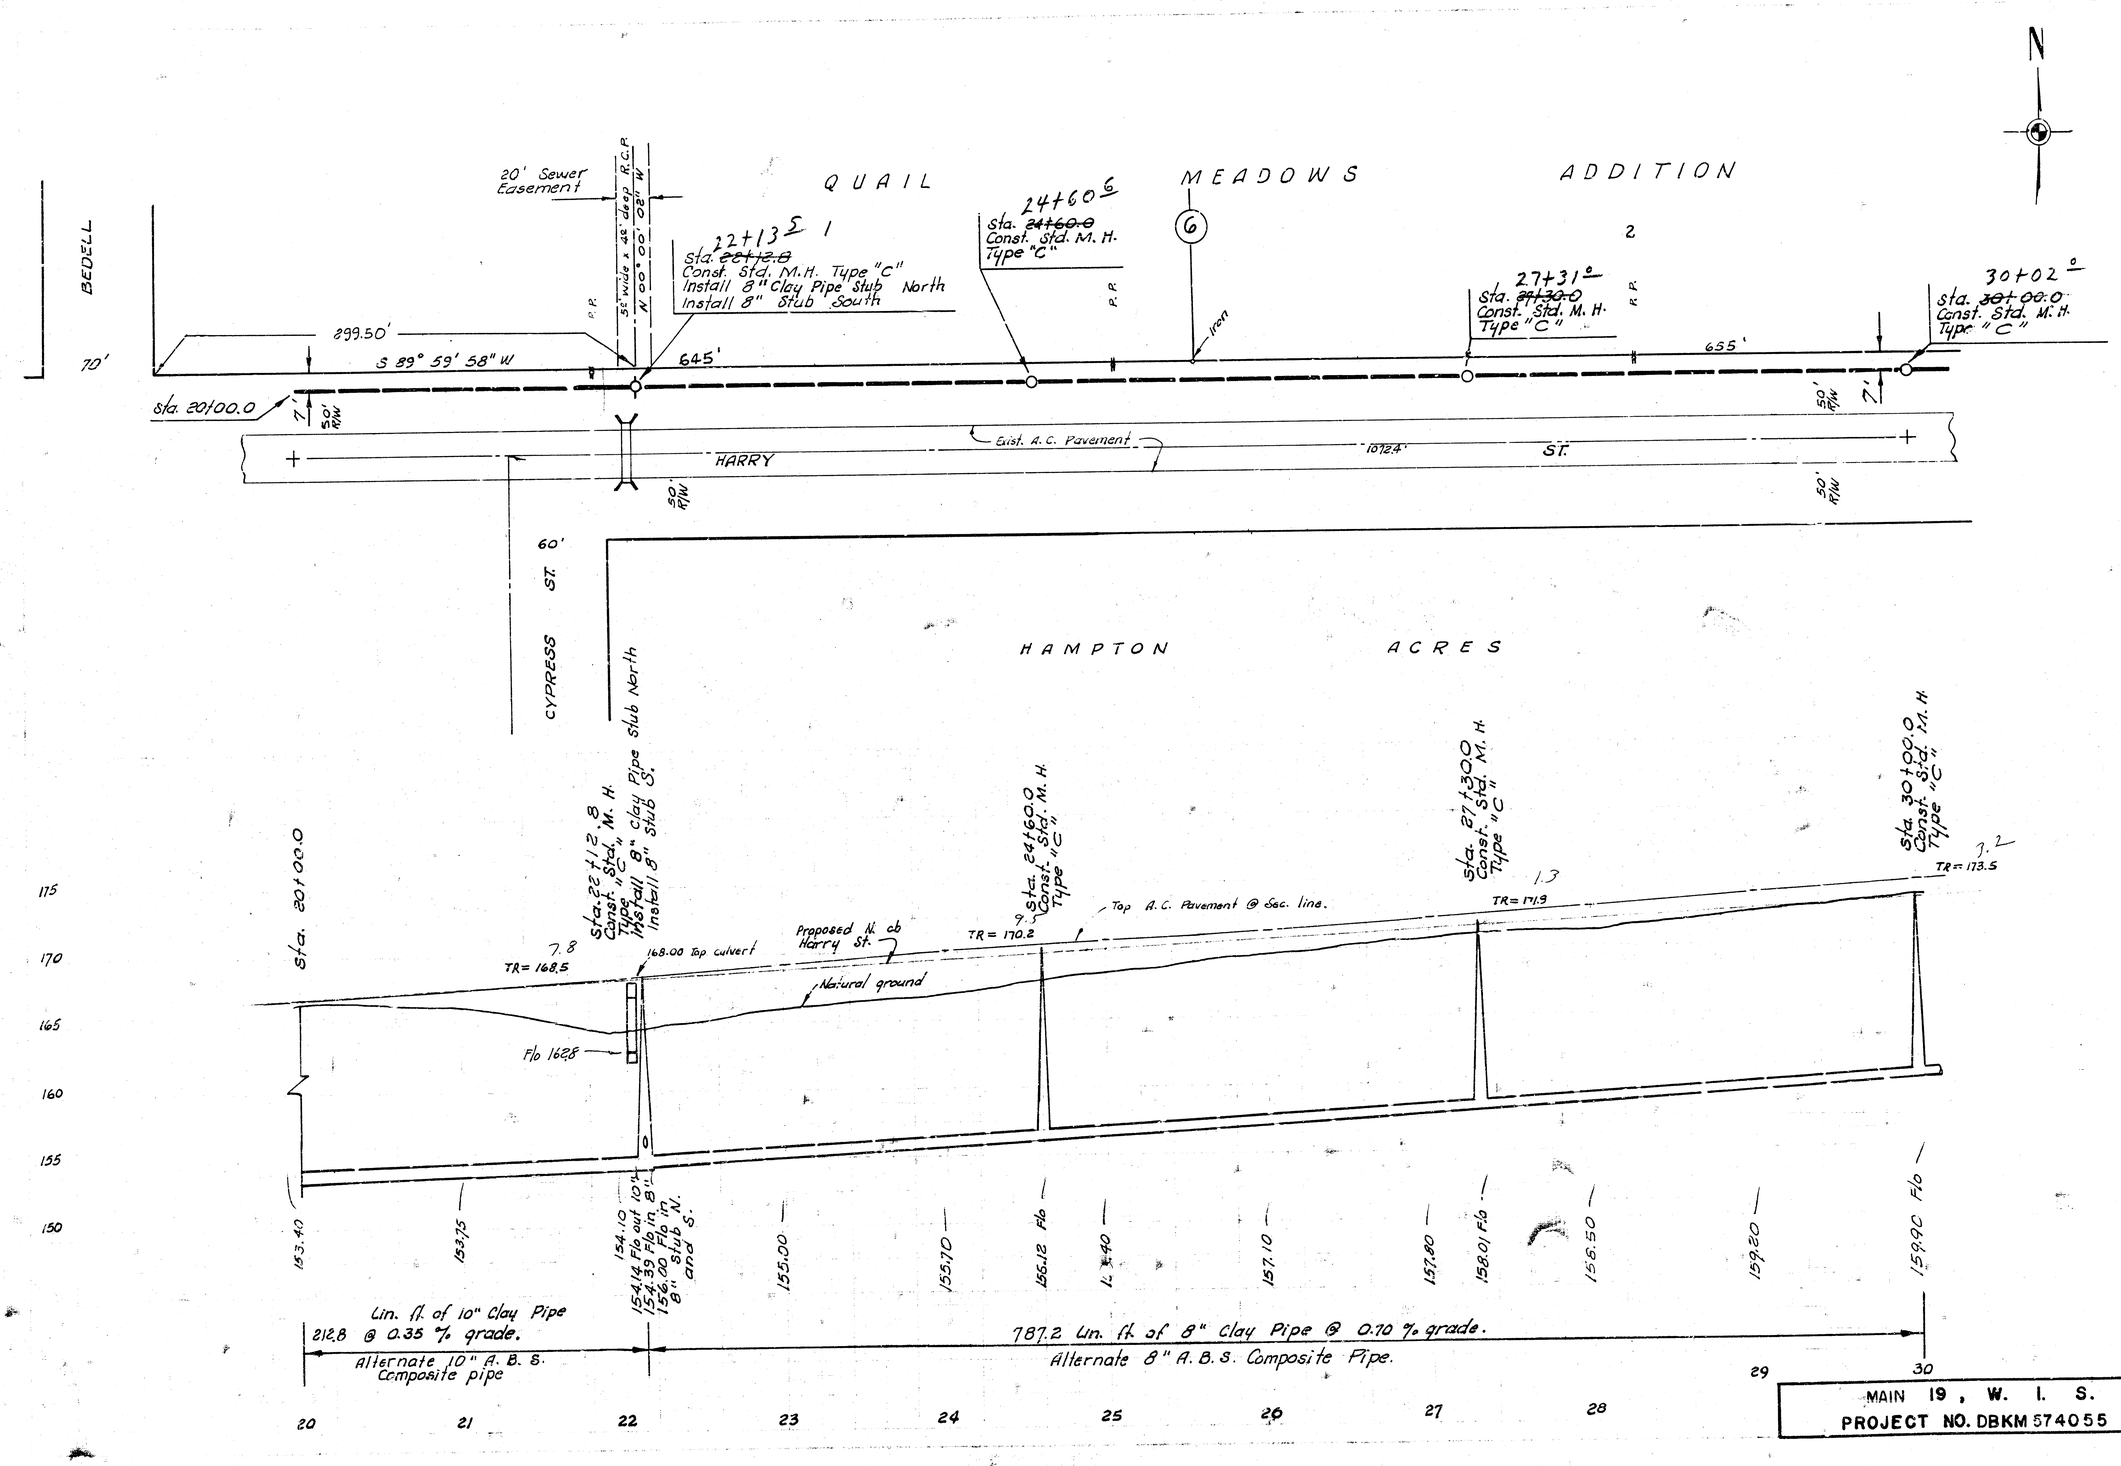

MAIN 19, W. I. S. 4/5 | 4/5
PROJECT NO. DBKM 574055

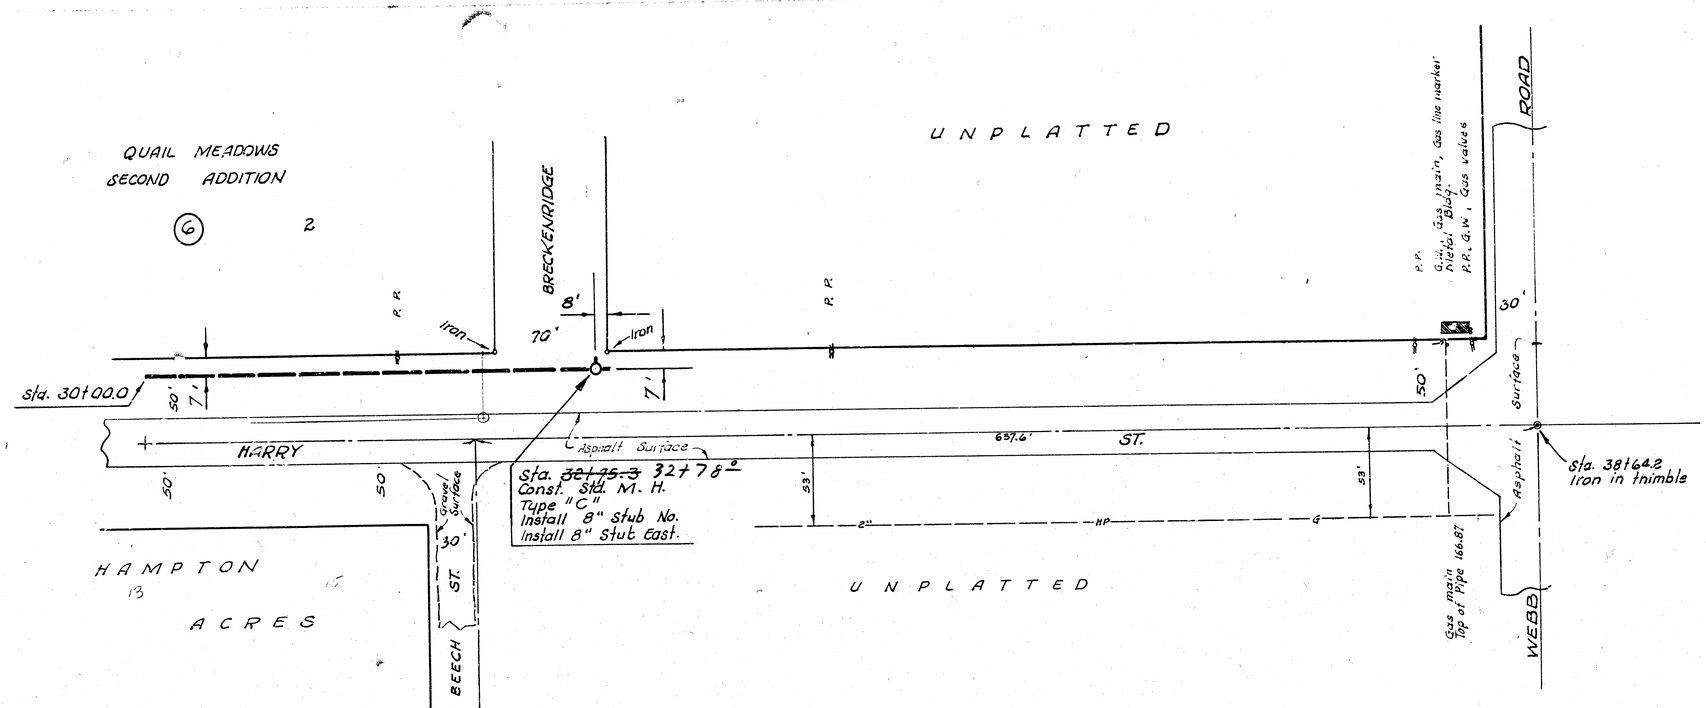

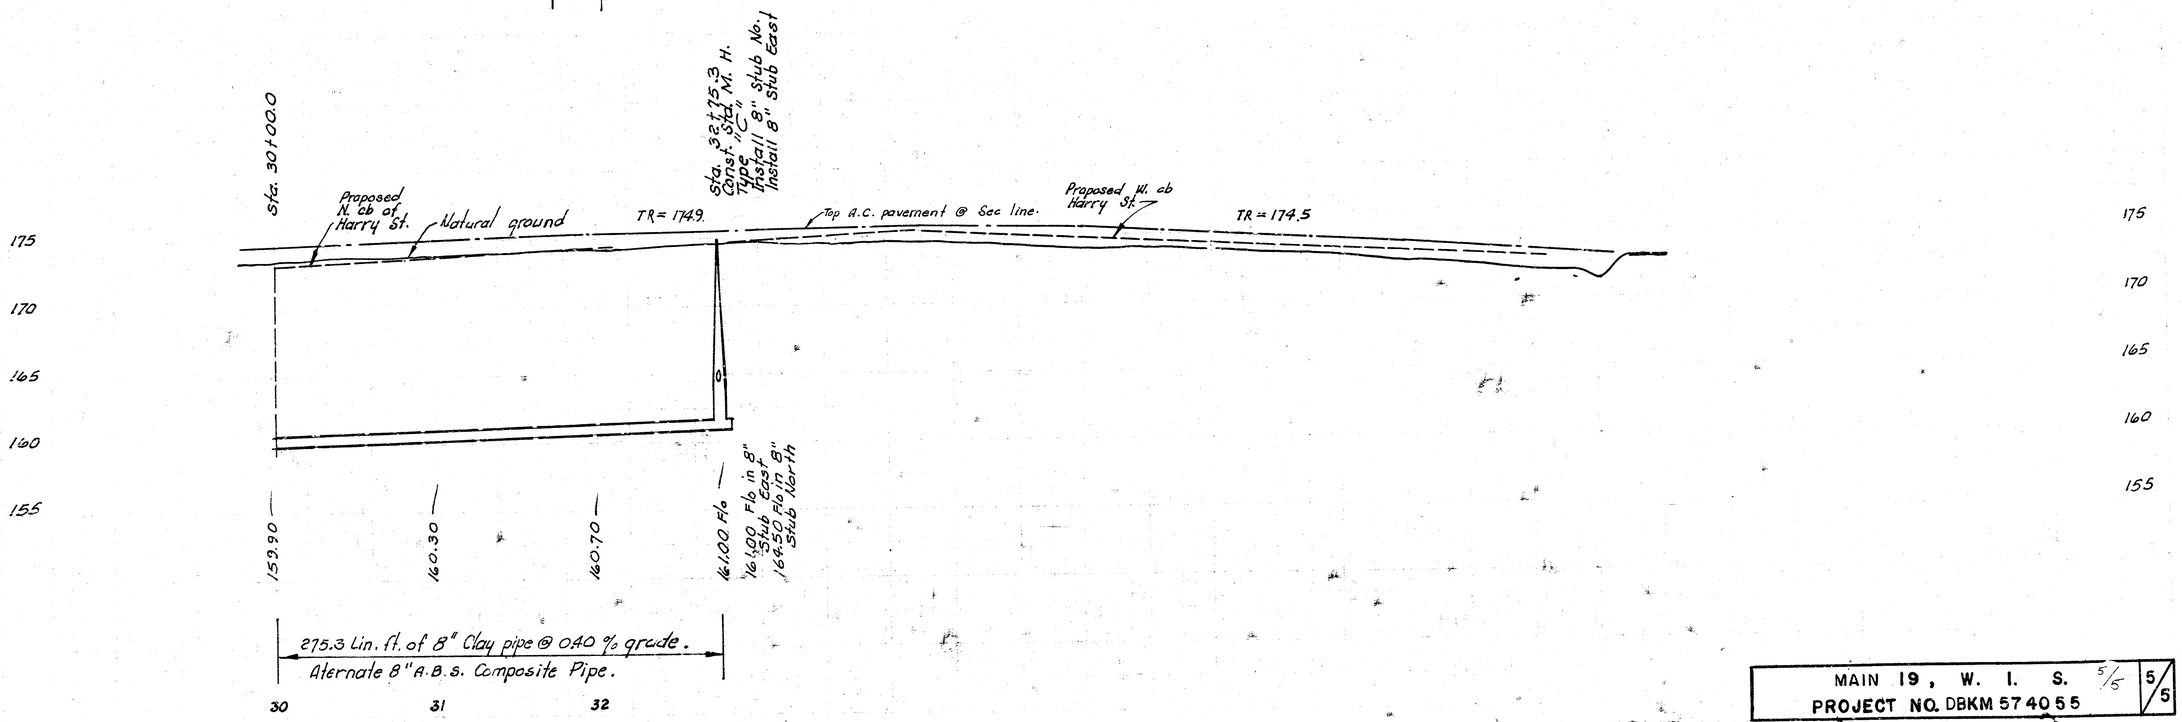

MAIN 19, W. I. S. 5/5 | 5/5
PROJECT NO. DBKM 57 40 55