



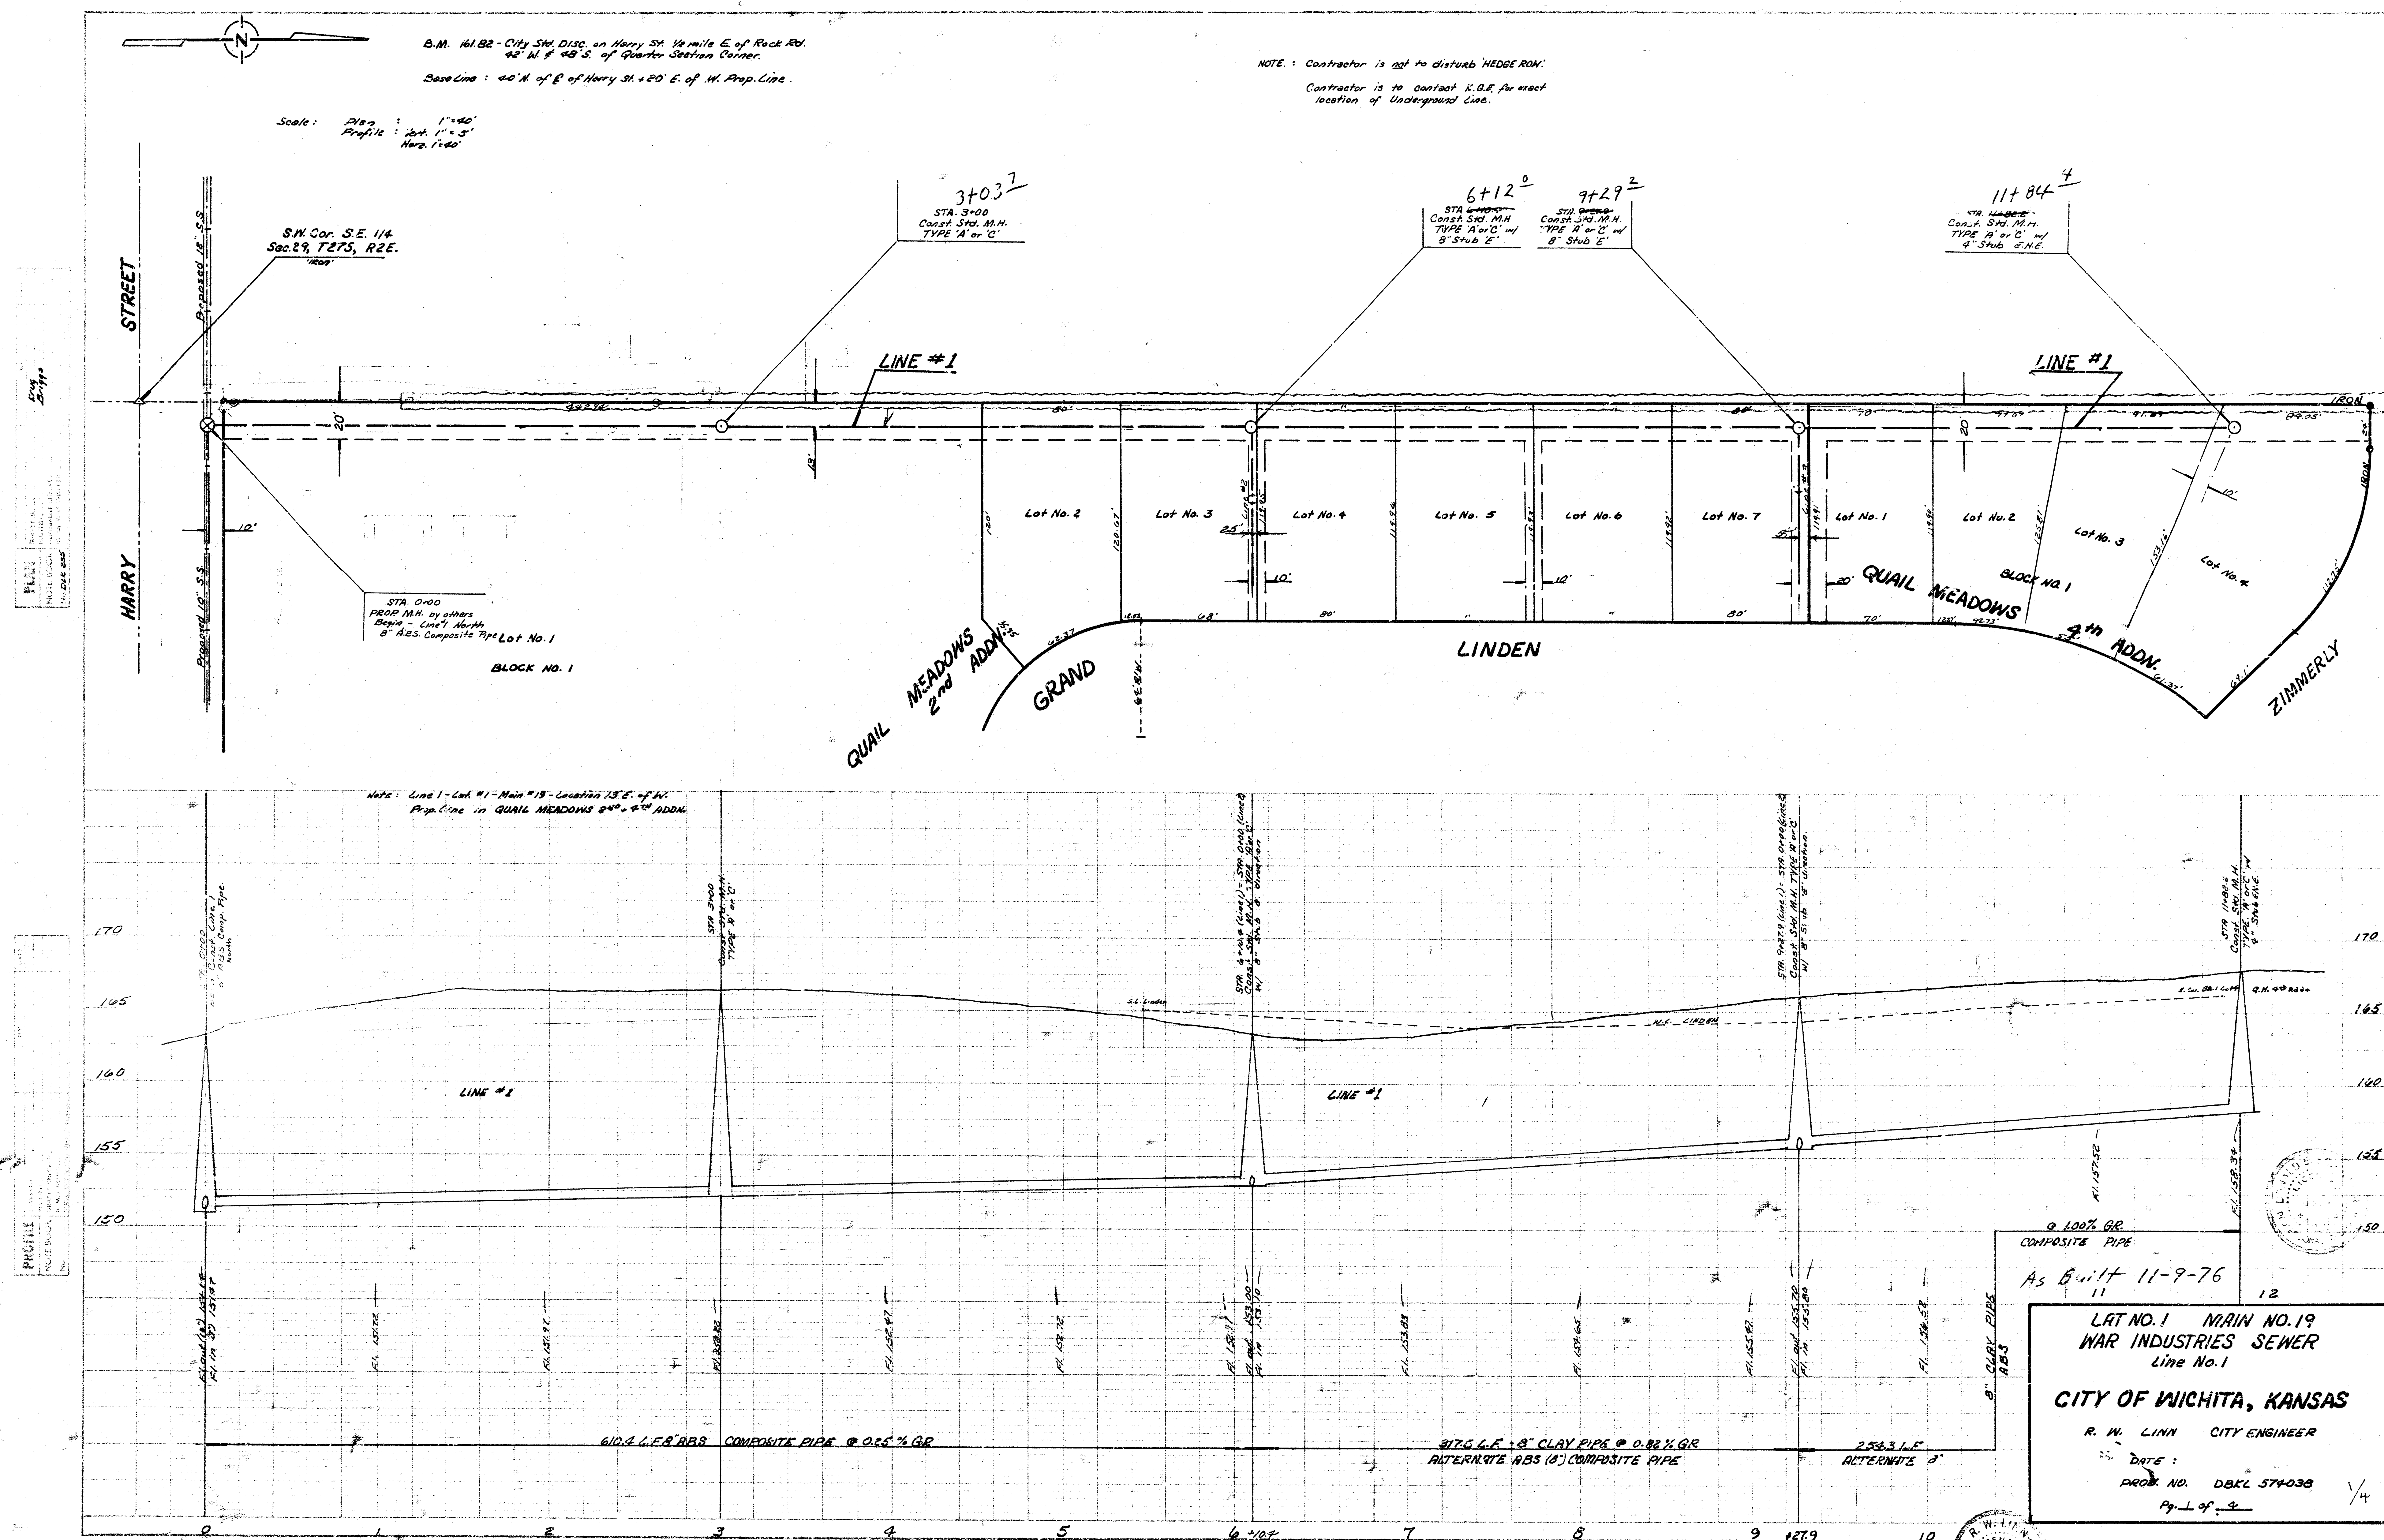


Scale: PLAN 1" = 40'
 PROFILE Vert. 1" = 5'
 Horiz. 1" = 40'

B.M. 16182 - City Stn. Dis. 4 Harry 1/2 mi. E. of Rock Rd.
 42' N. - 40' S. of 1/4 Sec. Corner.

STA 0+00 Line #2 -
 STA 6+10 Line #1
 Begin 3" S.S. Line #2

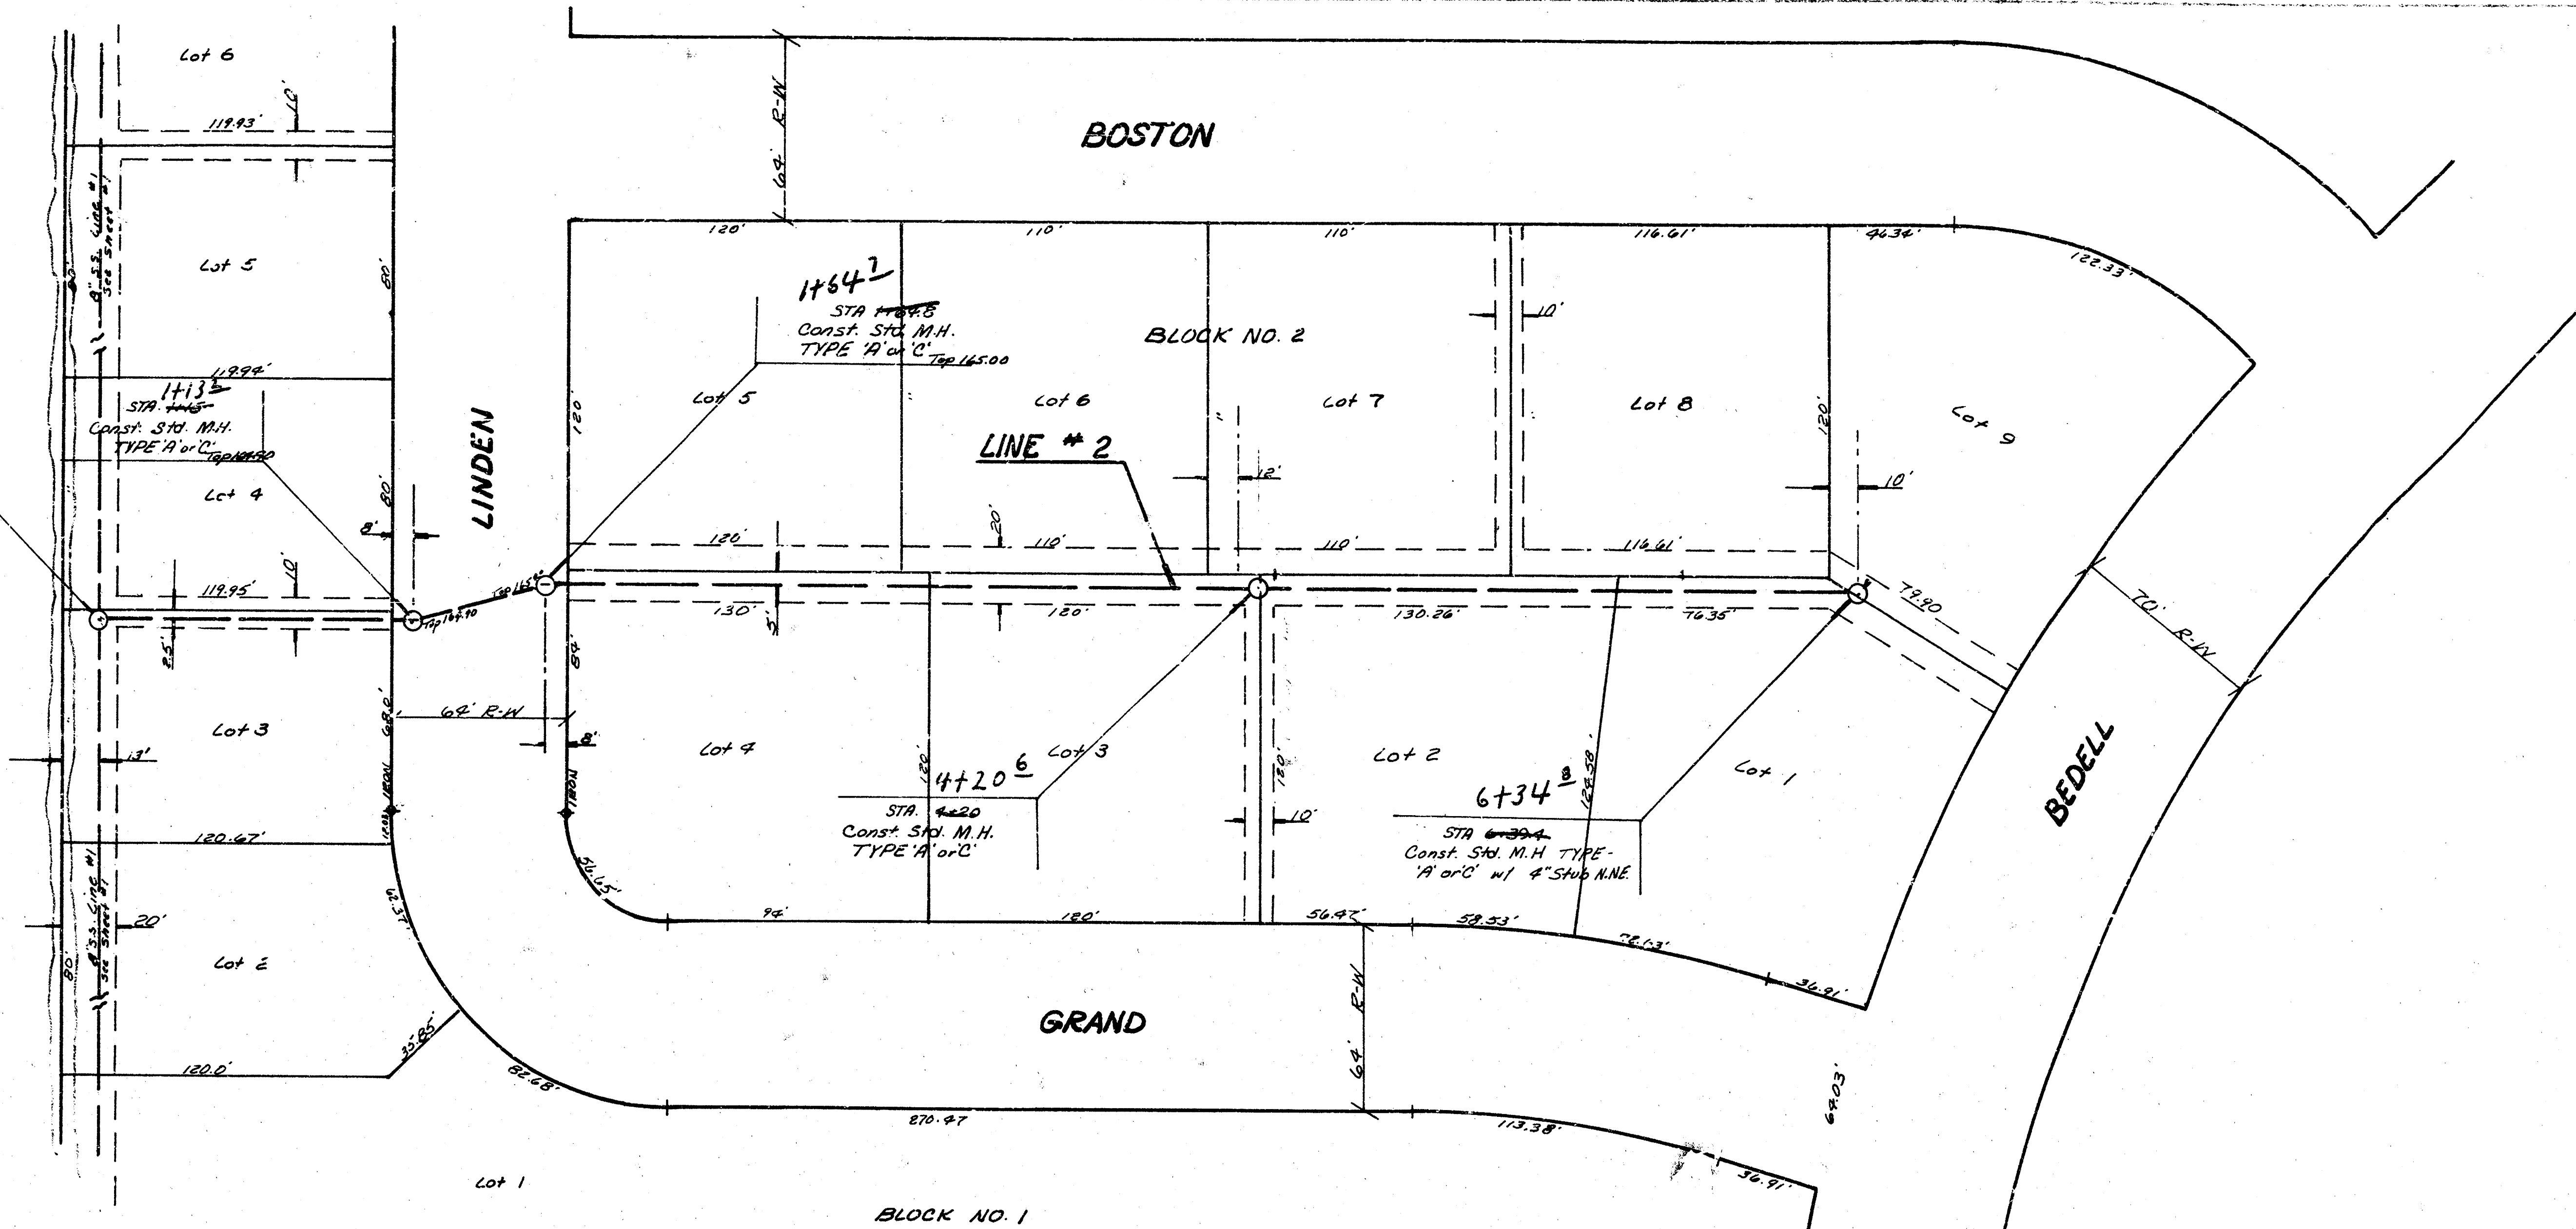


Note: Sta 0+00 Line #2 -

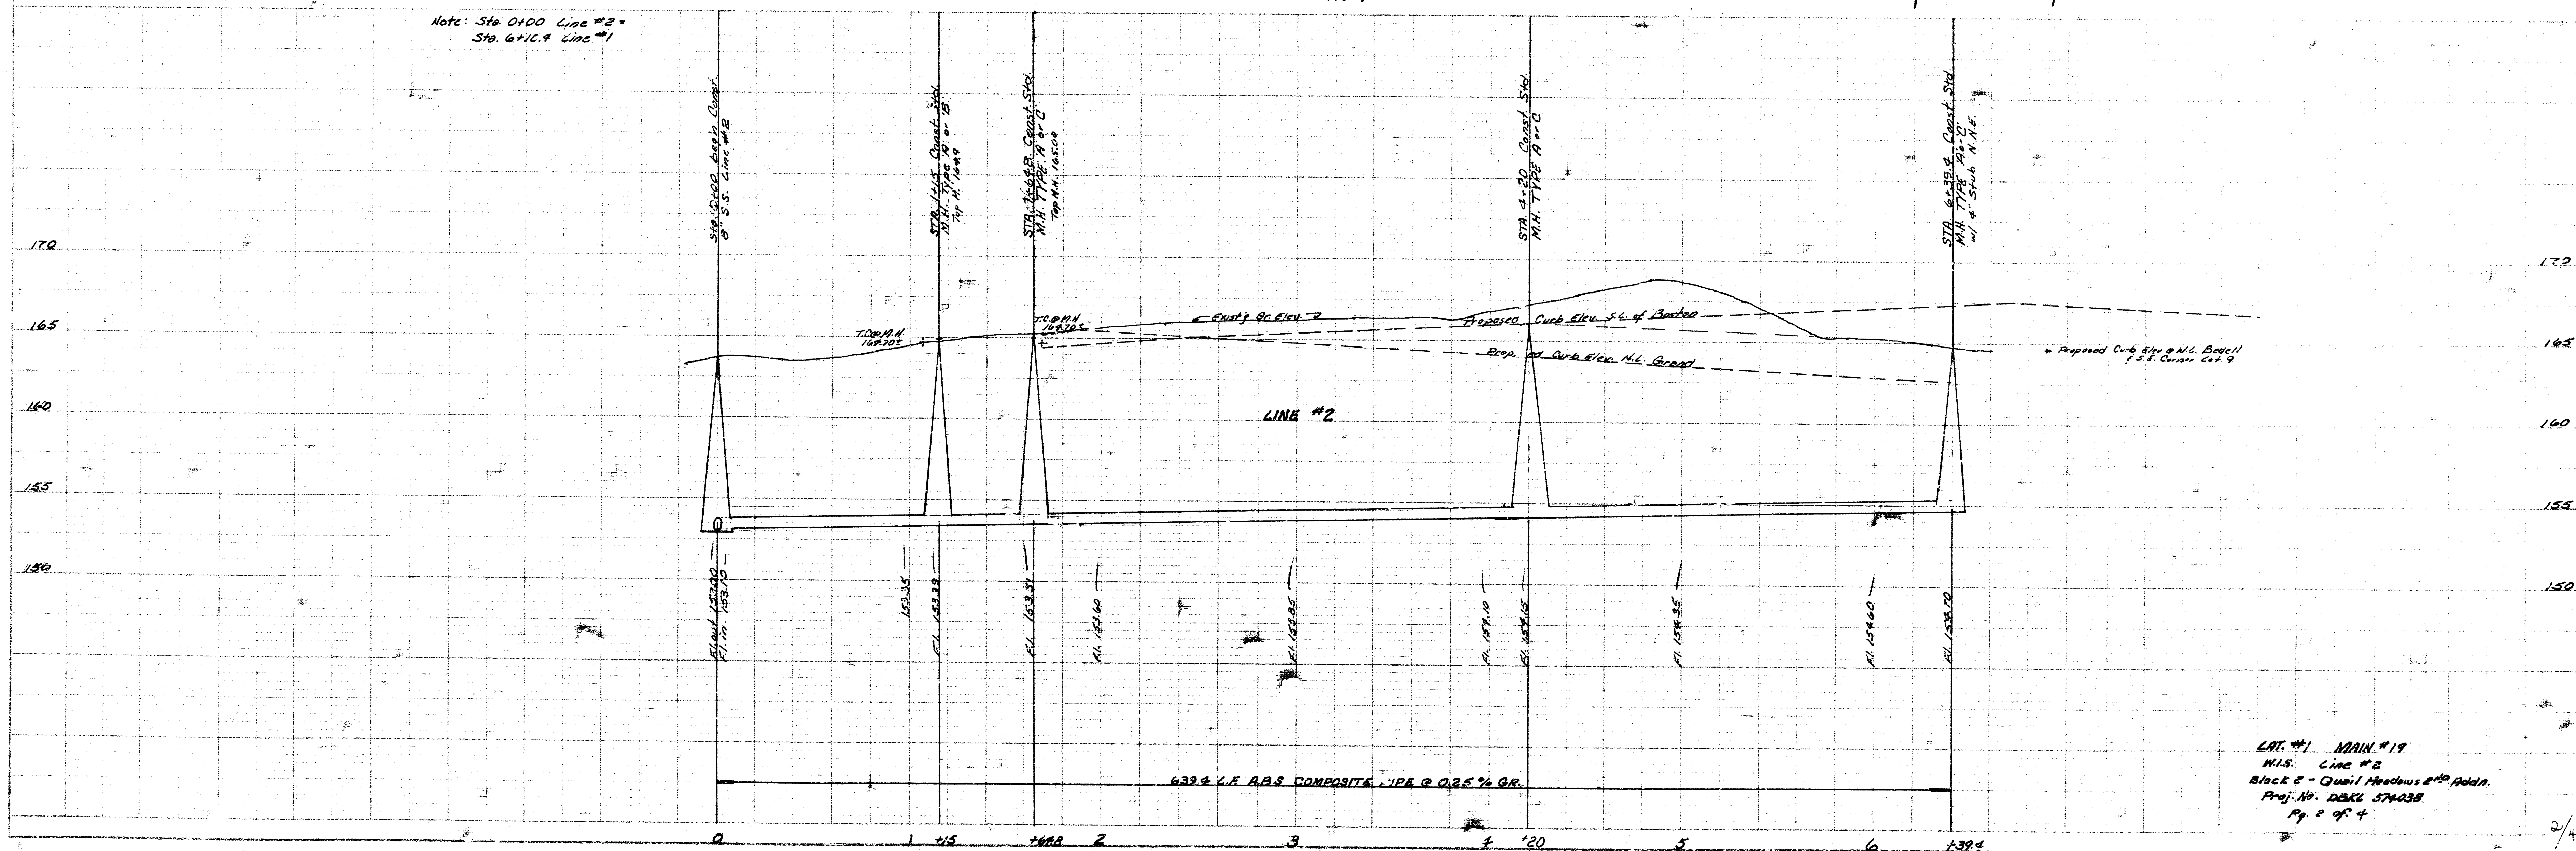


LOT #1 MAIN #19
 W.L. Line #2
 Block 2 - Quail Meadows 2nd Addn.
 Proj. No. DECE 574038
 Pg. 2 of 4

PLAN
Scale: PROFILE Vert. 1" = 5'
HORIZ. 1" = 40'
B.M. 168.43 - "D" Top of Curb at Corner
N.E. Elmerly

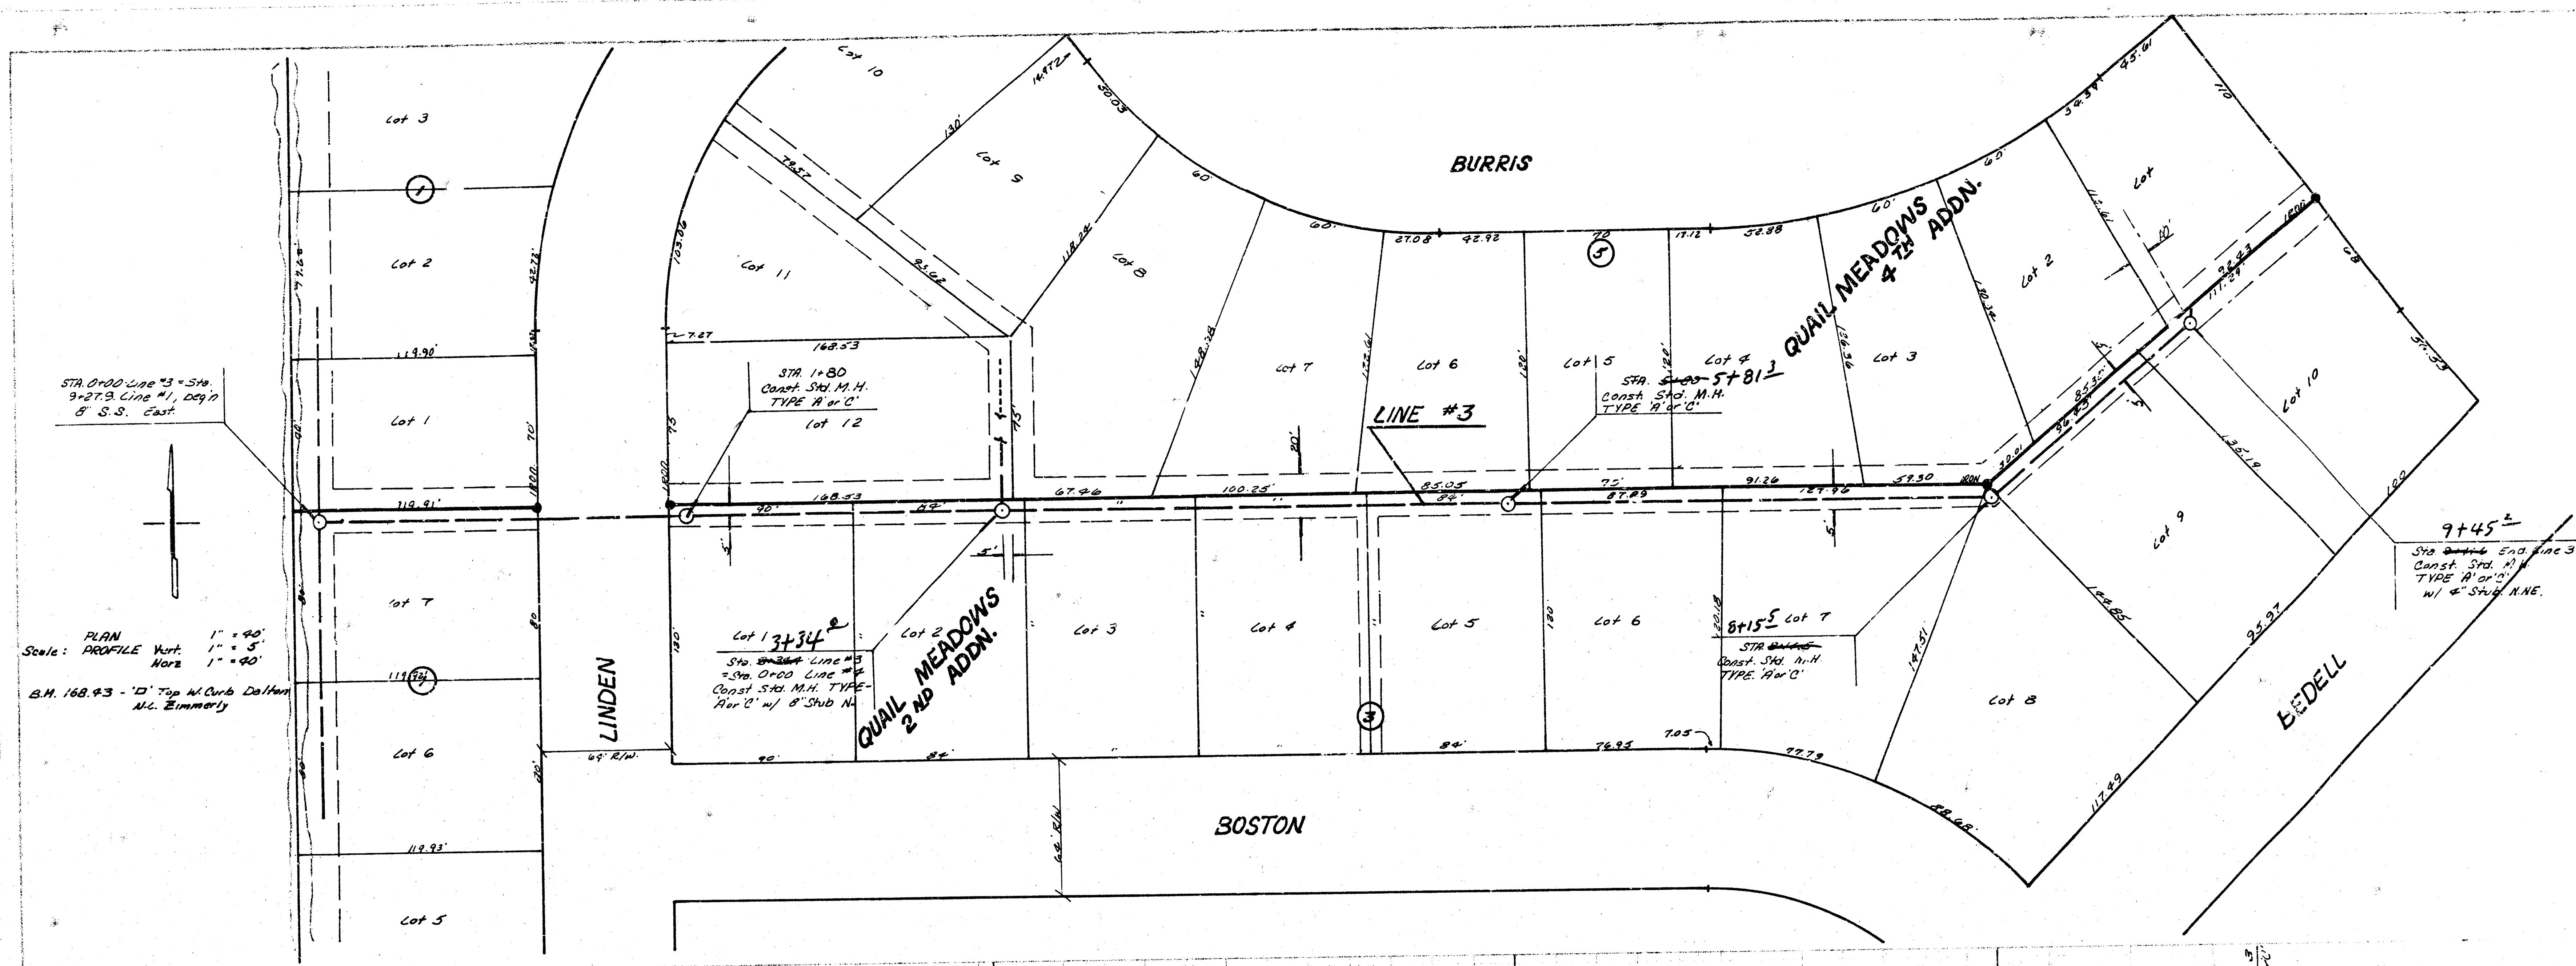

PROFILE
Scale: 1" = 5'

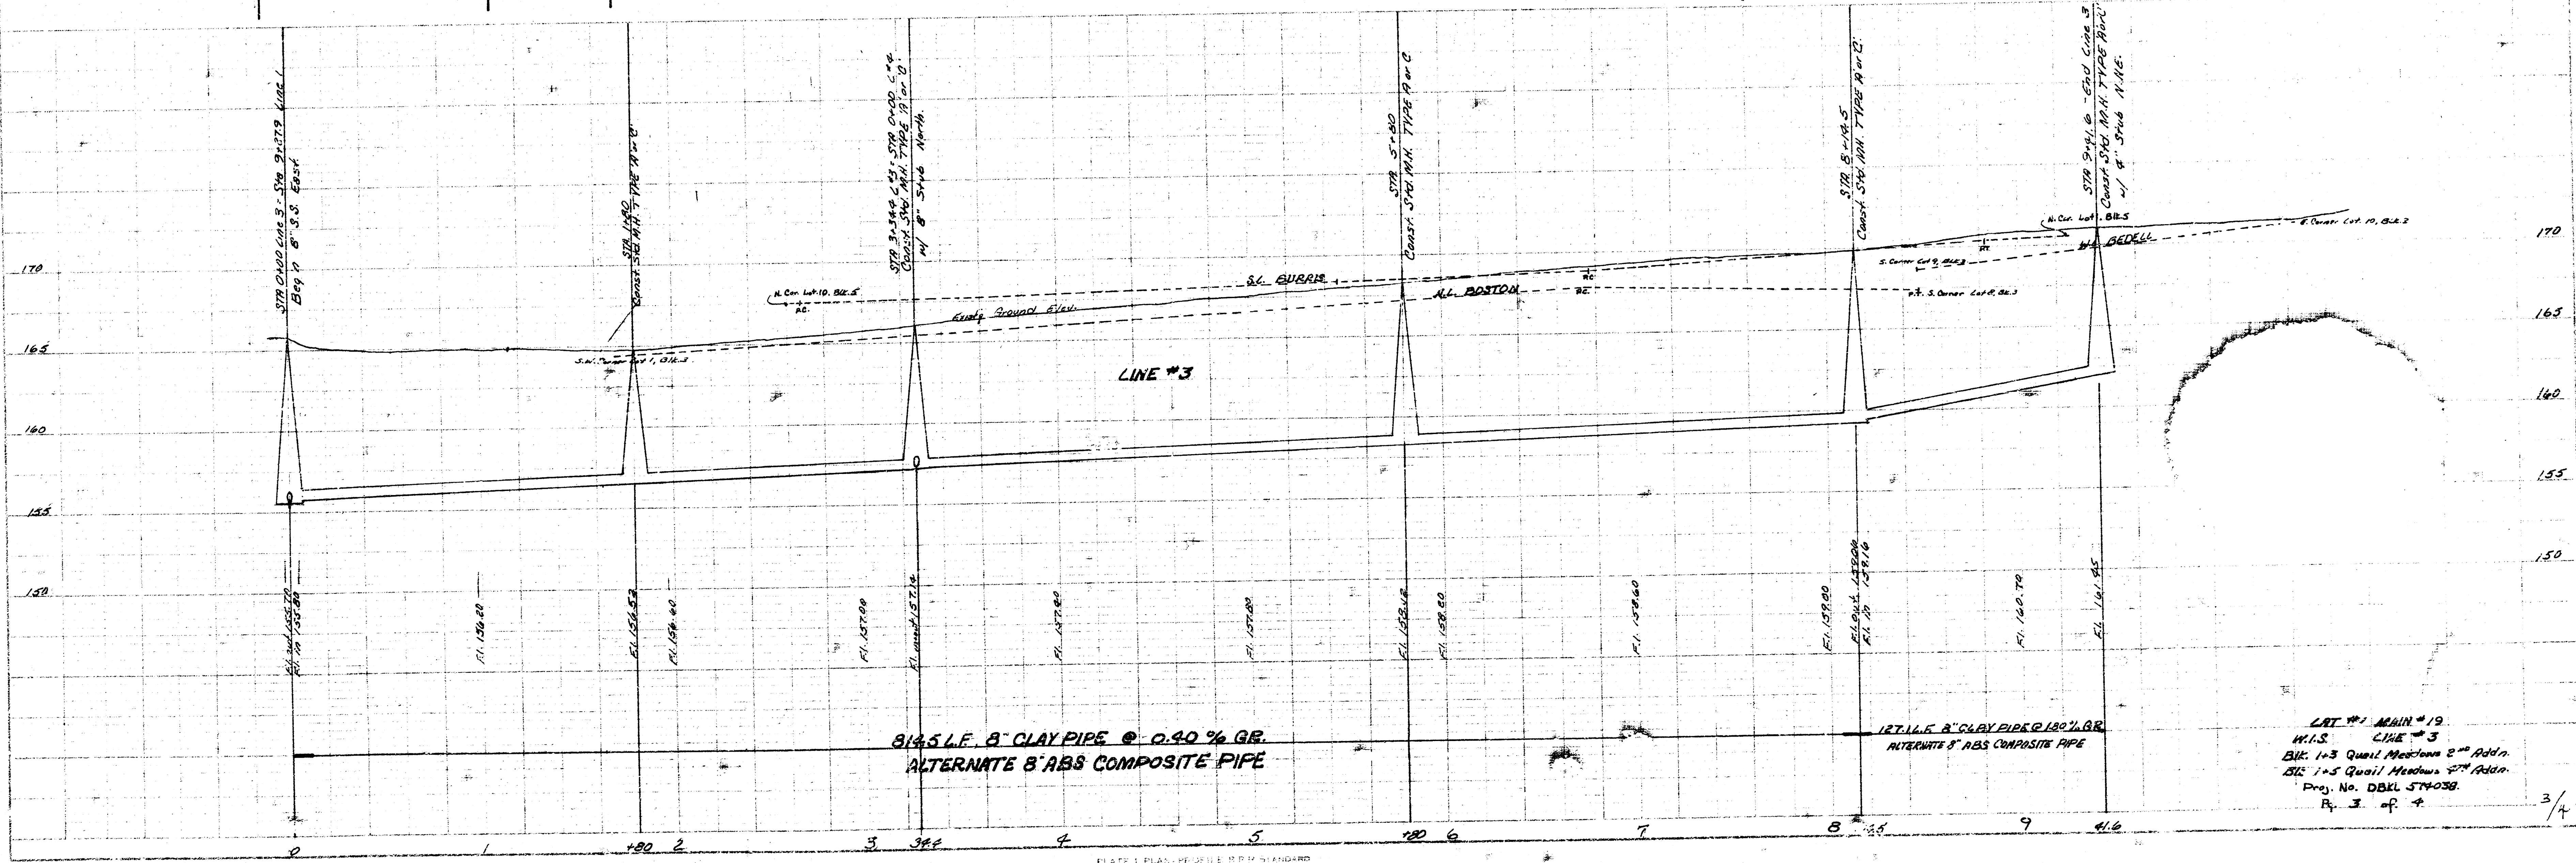

L.I.T. #1 MAIN #19
LINE #3
BLK 1+3 Quail Meadows 2ND Addn.
BLK 1+5 Quail Meadows 4TH Addn.
Pg. 3 of 4


Plan Scale 1"=40'
 Profile Vert. Scale 1"=5'
 Horiz. Scale 1"=40'

D.M. 177.74 - 10' Top S. Curb Bedell & W. Laurel

Sta 76³
 STA 0+77
 Const. Std. M.H. TYPE "A" or "B"

QUAIL MEADOWS
 2nd ADDITION


STA. 0+00 Line #4
 STA. 3+34.4 Line #3
 Degn. 5' 3.3"

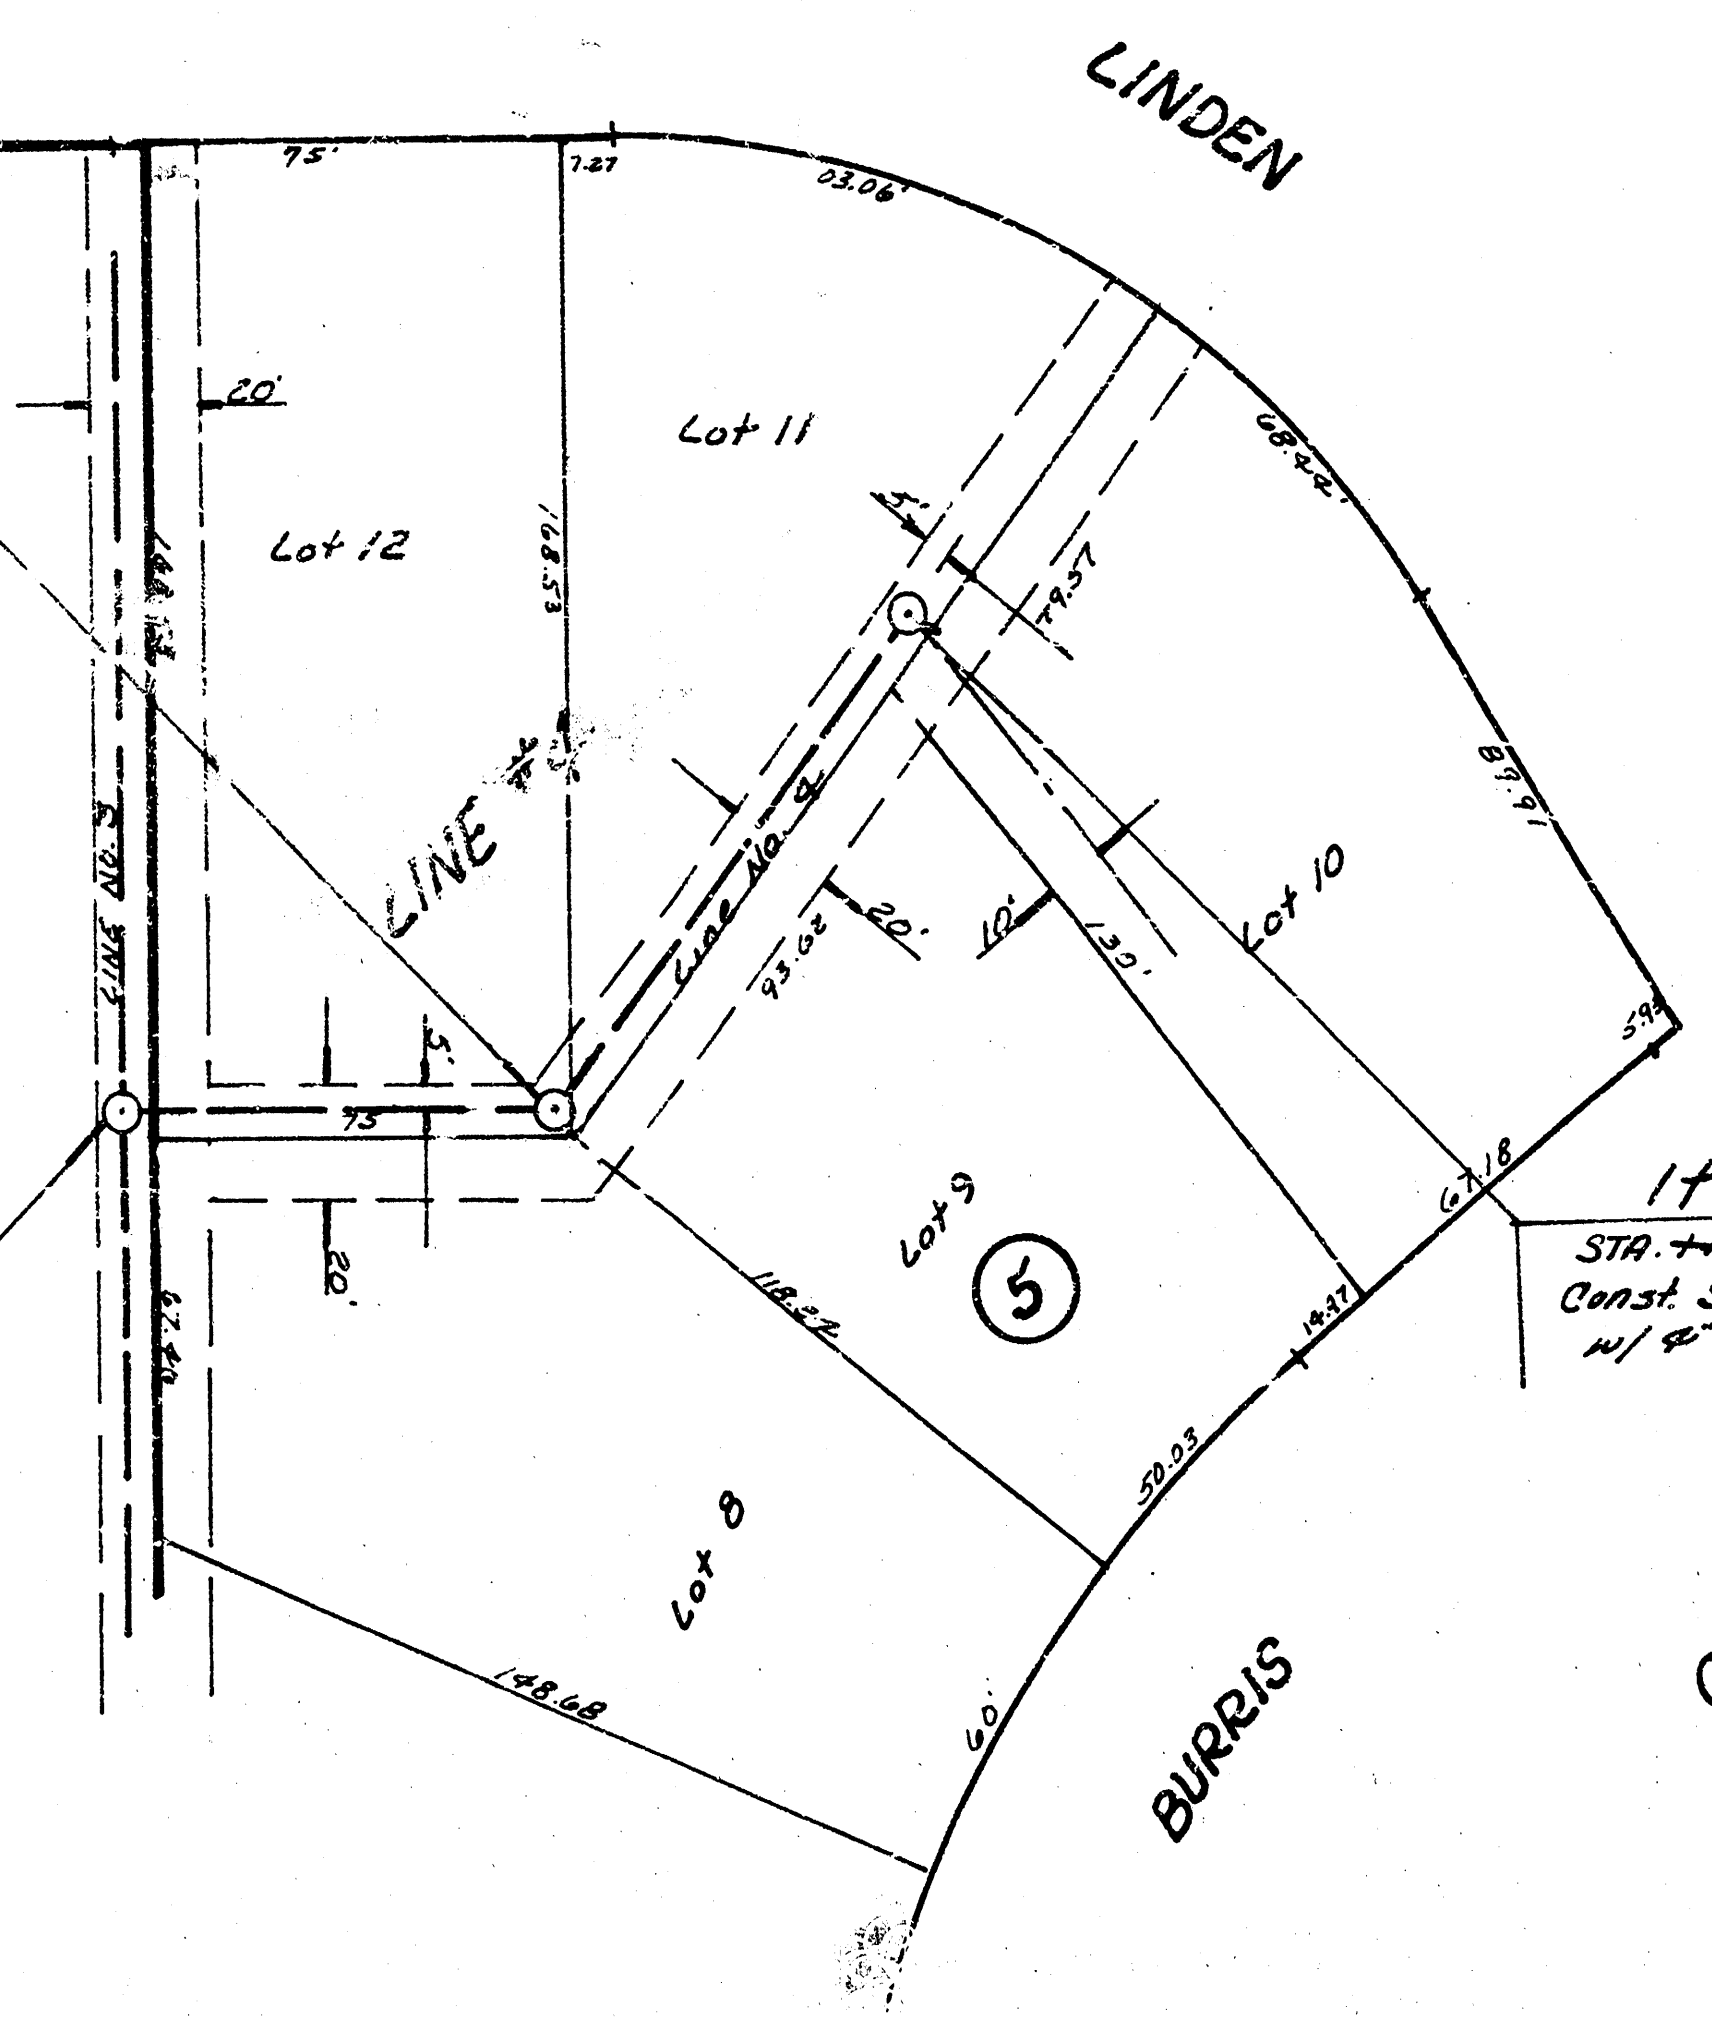

1+835
 STA. 4+00 End Proj.
 Const. Std. M.H. TYPE "A" or "B"
 w/ 4" Stub

QUAIL MEADOWS
 4th ADDITION

NOTE: STA. 0+00 Line #4
 STA. 3+34.4 Line #3

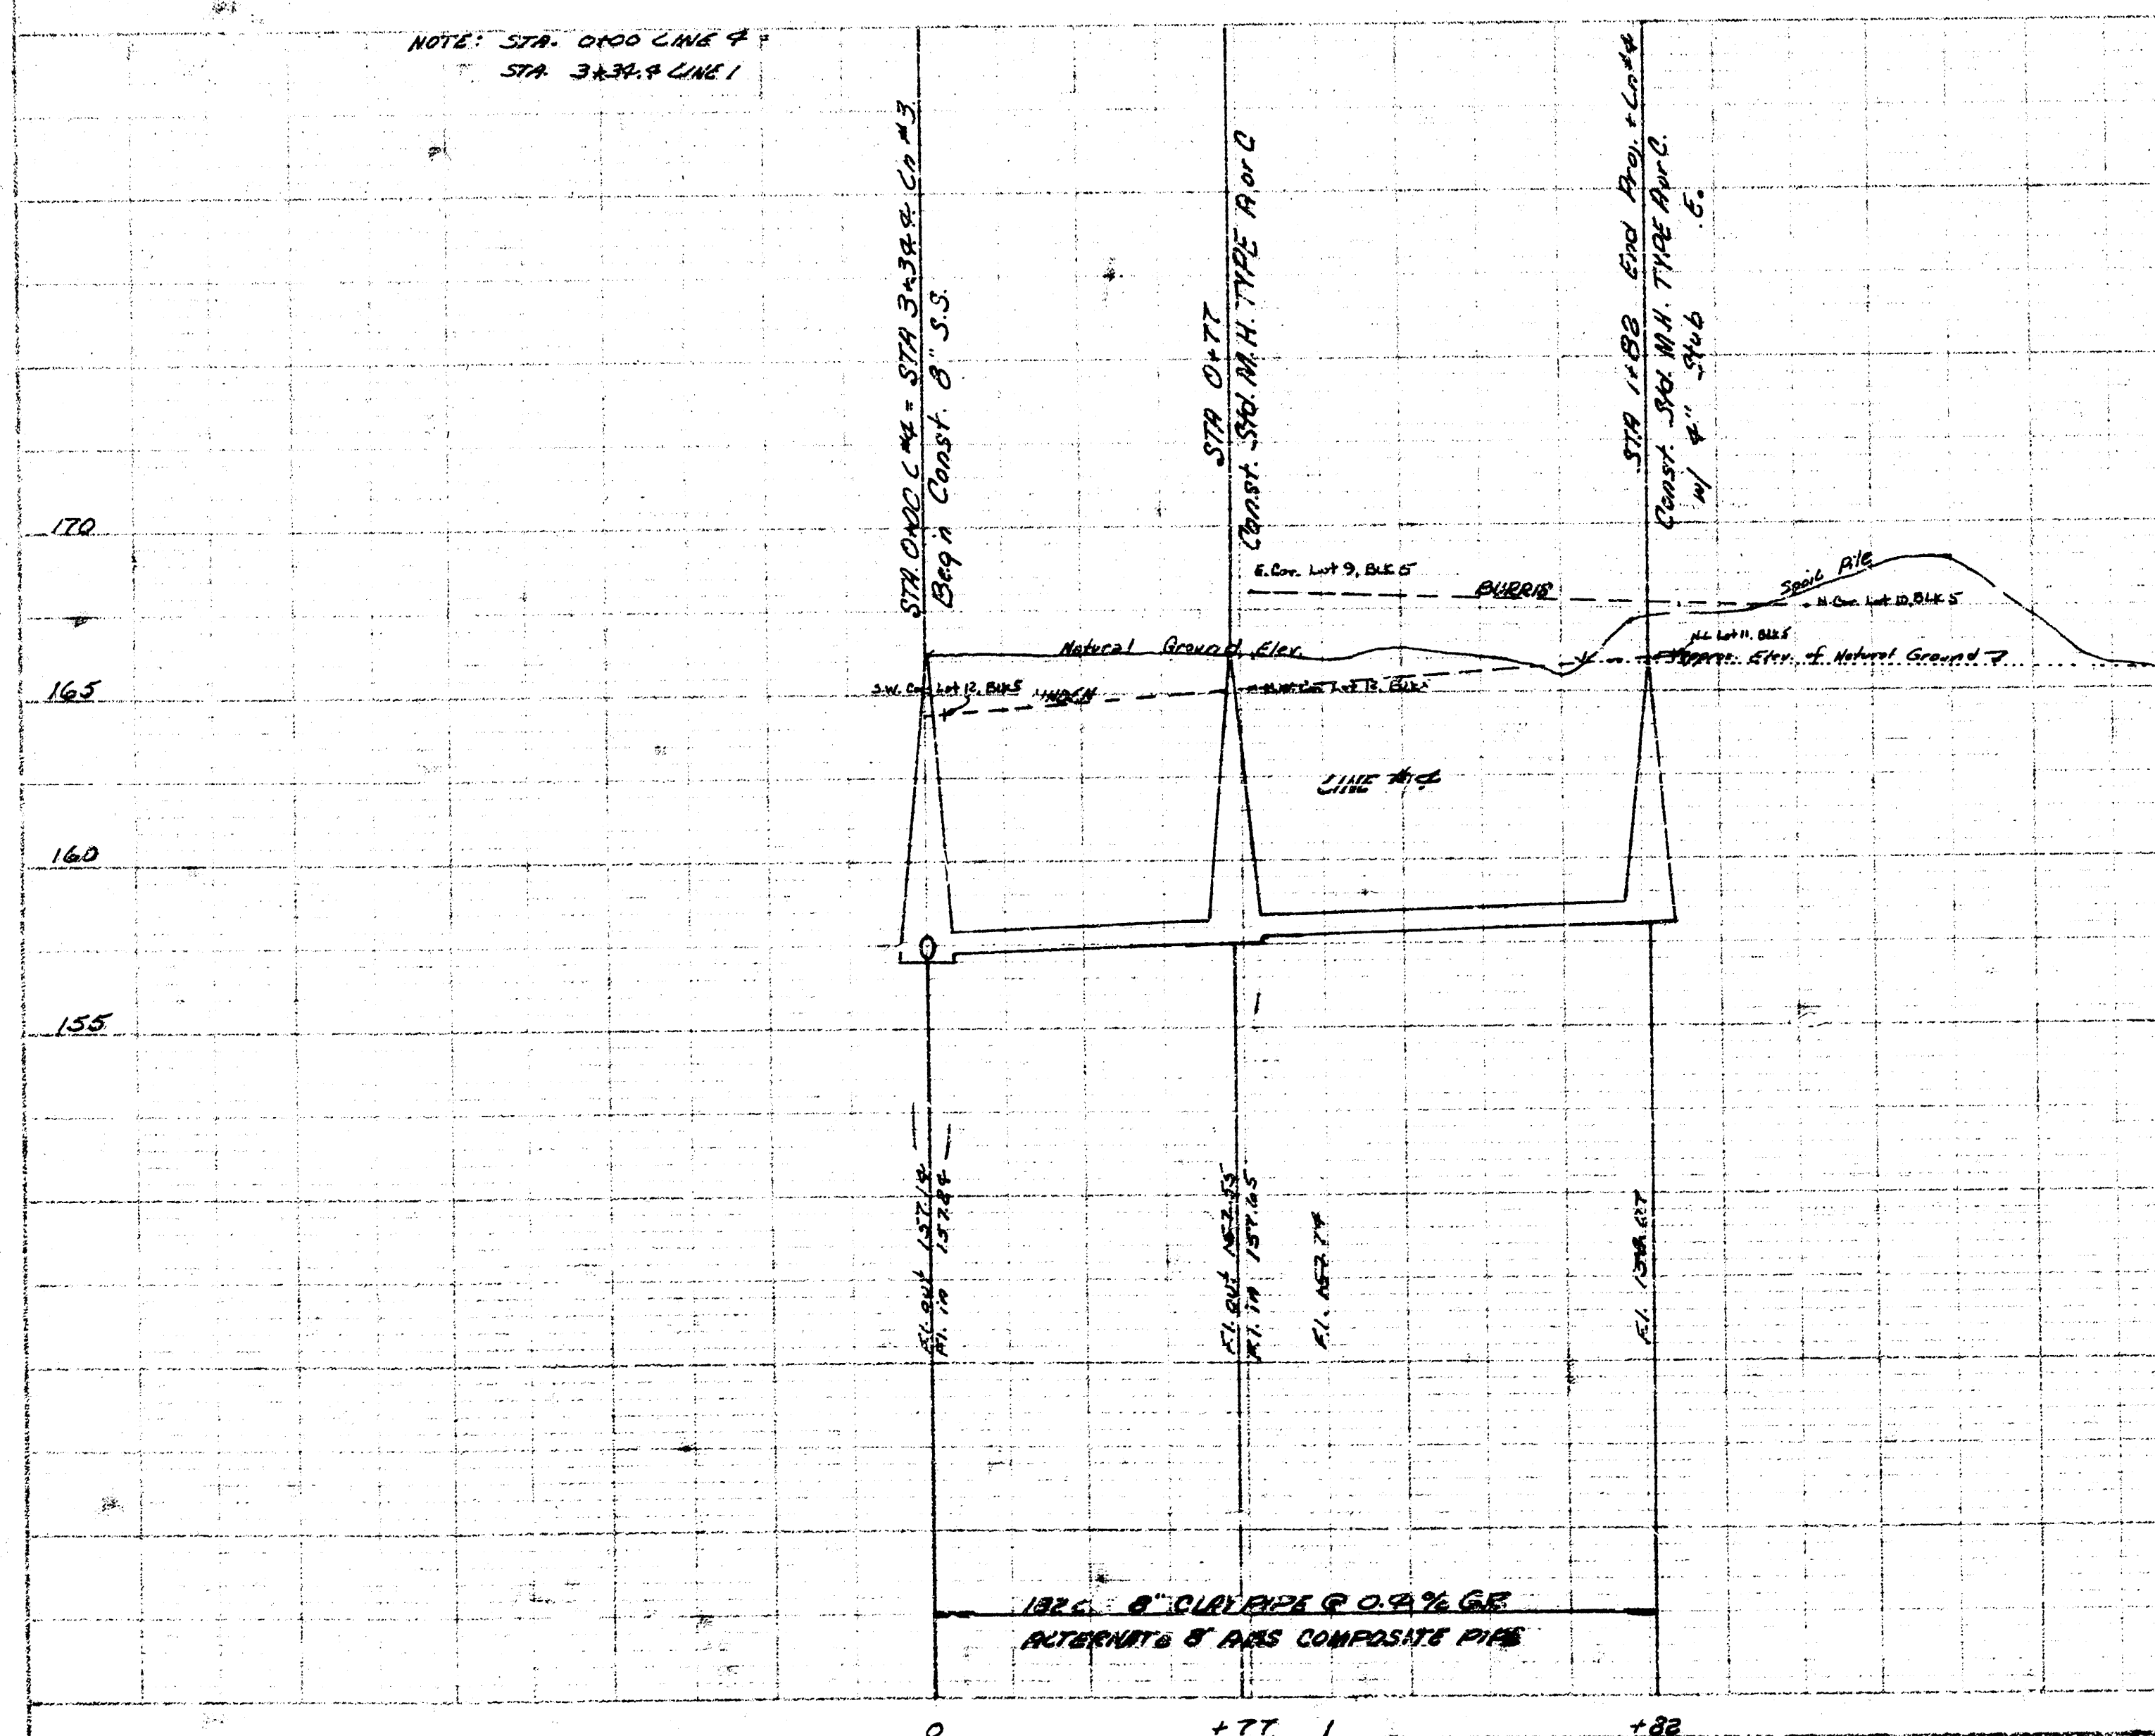

STA. 0+00 Line #4
 STA. 3+34.4 Line #3

STA. 0+77
 Const. Std. M.H. TYPE "A" or "B"

 Const. Std. M.H. TYPE "A" or "B"
 w/ 4" Stub

LINE #4

LINE #3


LOT #1 MAIN #13
 Line No. 4
 Date 4/5, 4/6 8/3/0/11/12
 Quail Meadows 4th Addition
 Proj. No. DBK 574034
 Pg. 2 of 2