

SANITARY SEWER IMPROVEMENTS FOR

LATERAL 13 MAIN 19

WAR INDUSTRIES SEWER

HEDGEWOOD ADDITION

LOTS 1 THROUGH 8 INCLUSIVE AND,
LOTS 13 THROUGH 20 INCLUSIVE.


PROJECT NUMBER
468 76 245 81869 000 000 001

GENERAL NOTES

- Underground utility service lines and overhead utility pole lines are to be adjusted as necessary by others prior to construction unless the plans specifically call for their adjustment by the Contractor or unless the plans specifically identify a utility to be adjusted by its owner during construction. Existing utilities and their location, as shown on the plans, represent the best information obtainable for design. The Contractor will be required to work around existing utilities within the right-of-way which do not conflict with proposed construction.
- Trees and shrubs in public right-of-way which are in direct conflict with proposed new construction shall be removed by the Contractor with the Engineer's approval. Trees and shrubs which are not in direct conflict with proposed new construction shall be saved and protected from damage.
- The Contractor shall be responsible for preserving property irons. The Contractor will be required to re-establish any property irons which are damaged or destroyed by his construction operations. Such irons shall be re-established by a licensed land surveyor in accordance with state laws.

CITY of WICHITA, KANSAS

MICHAEL E. LINDEBAK
CITY ENGINEER

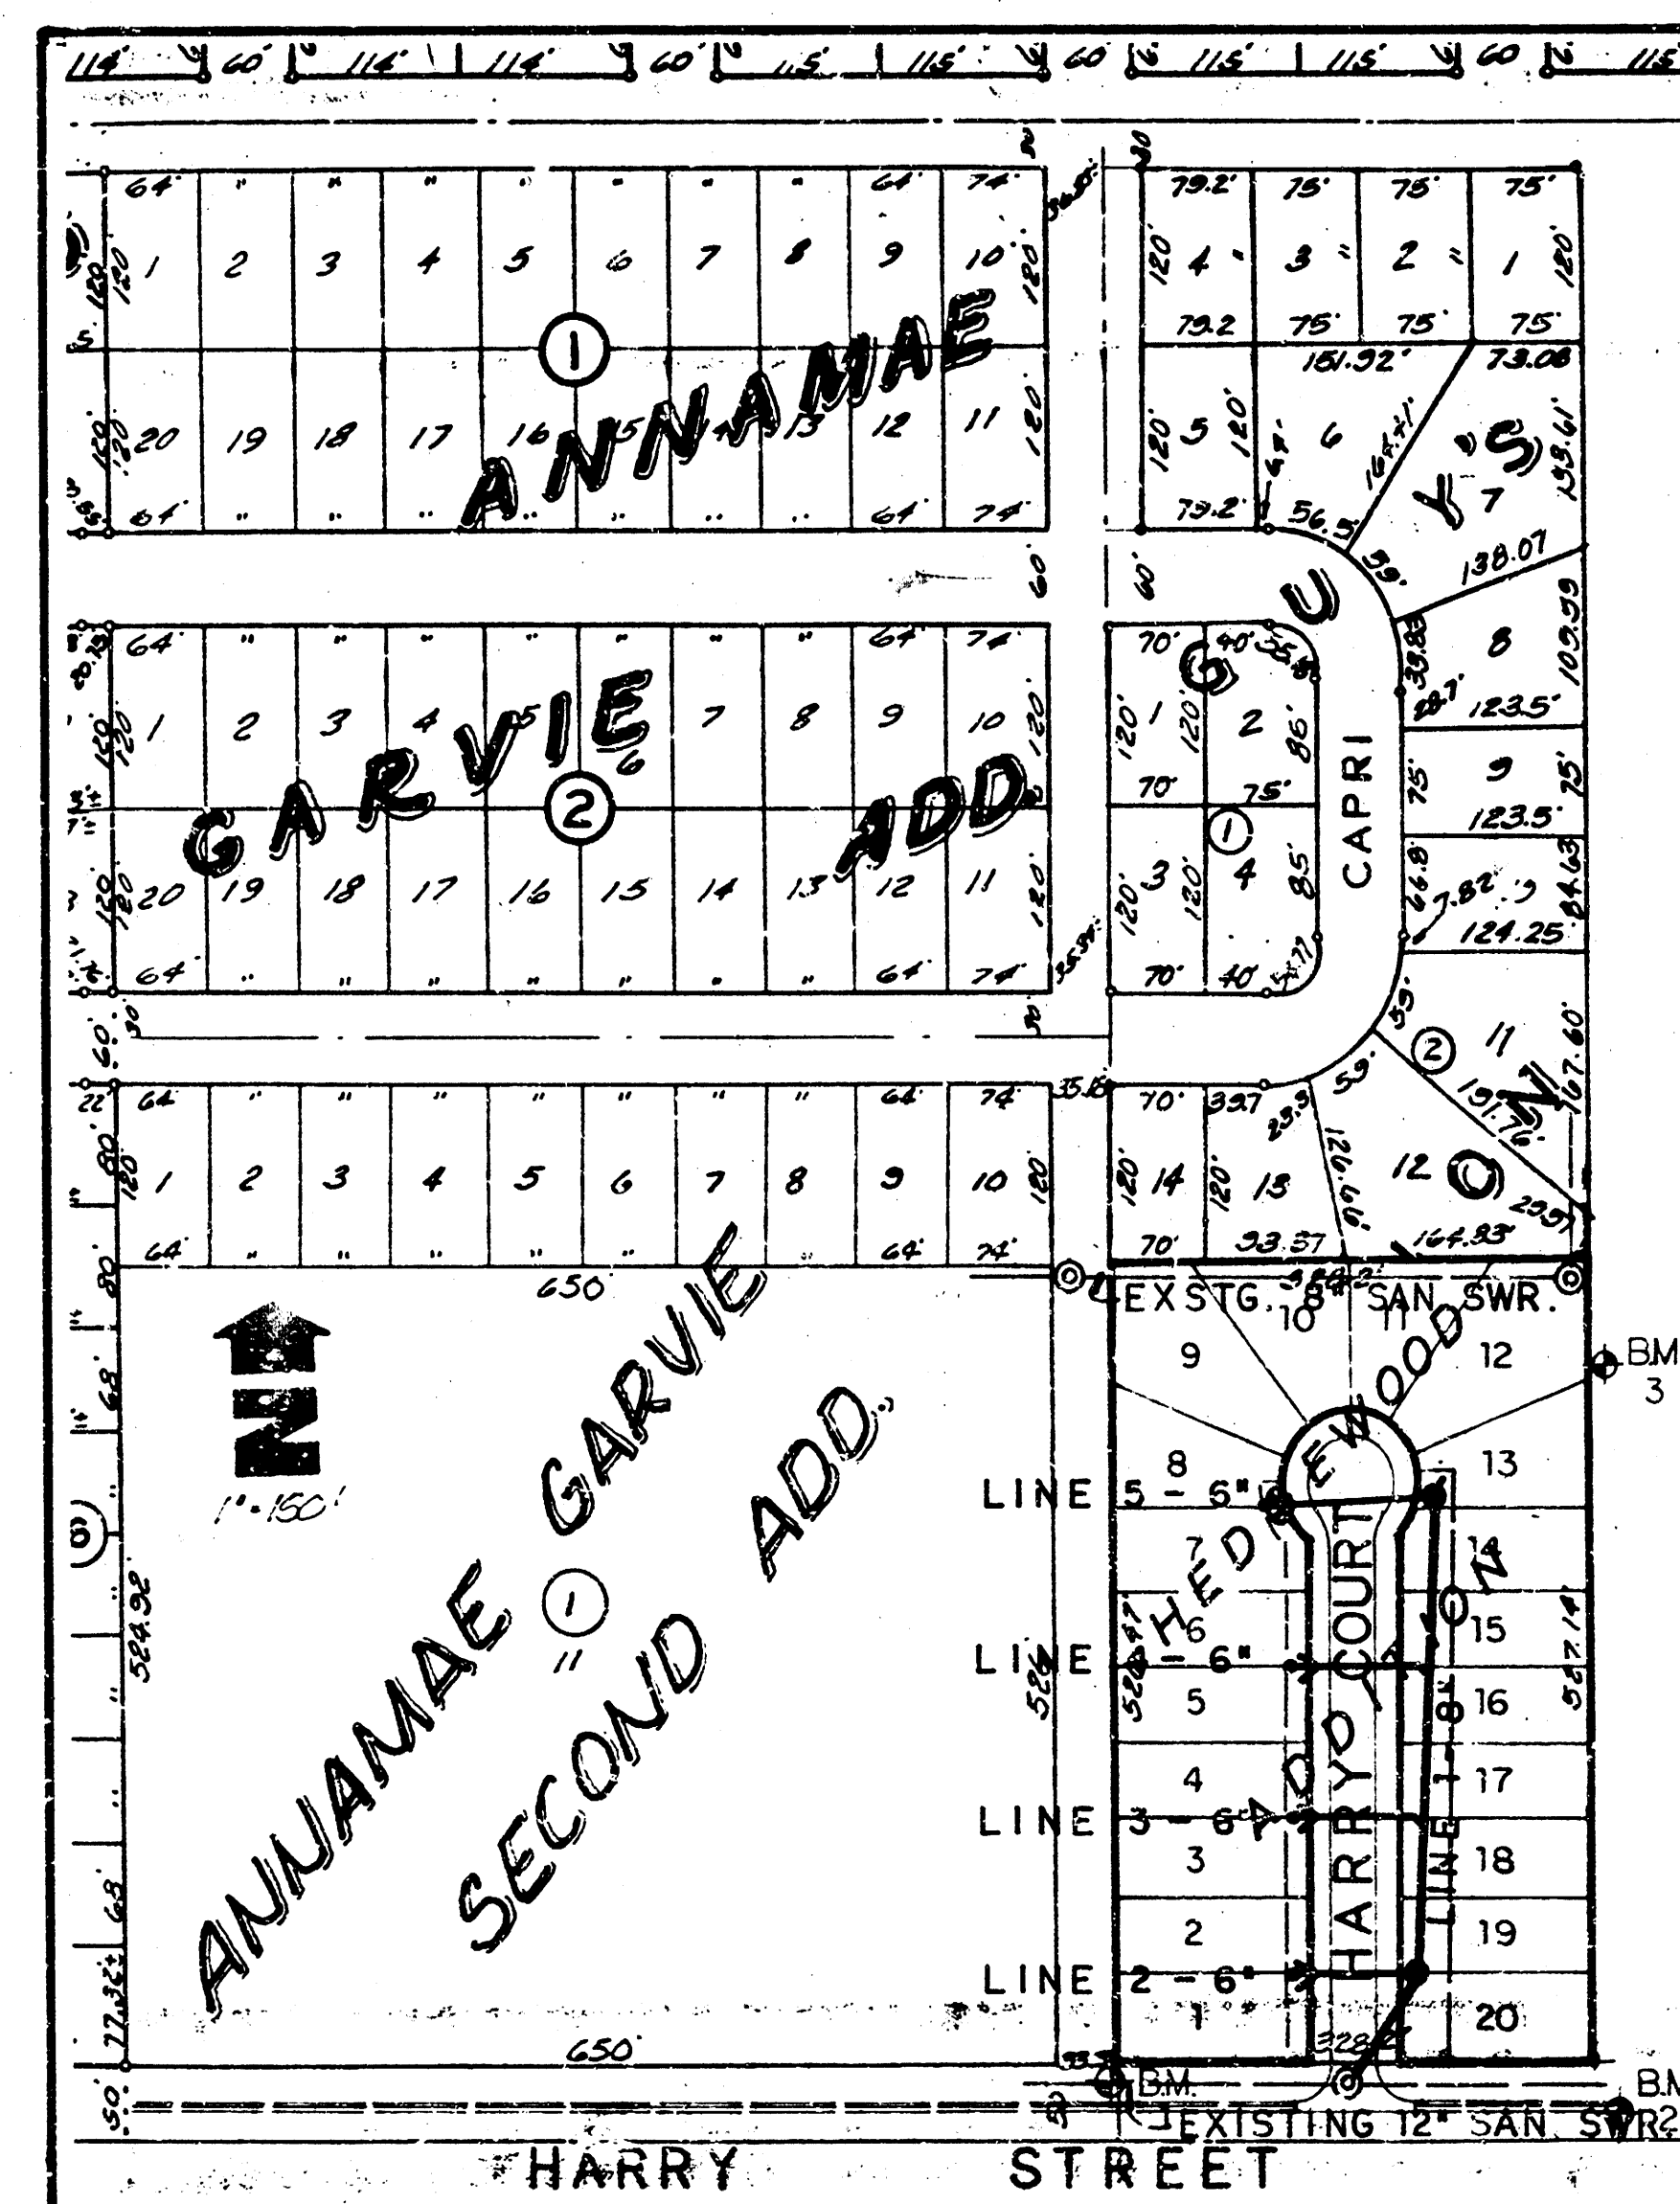

INDEX of SHEETS

Title Sheet 1
Plan-Profile (Lines 1-5) 2


BENCHMARKS

- Spike in So. Face of Power Pole @ SW Cor. Lot 15, Bk. 2, Garv's Addn (Lot 1, Hedgewood Addn). Elev. = 159.23 City datum
- "a" Cut in Top of Curb 104' E (1) and 24' S (1) @ Intersection Harry Court @ Harry Street. Elev. = 157.15 City datum
- R.R. Spike 79' 0" S and 7' 3" E of 1/2" Iron in N.E. Prop. Corner, Lot 12, Hedgewood Addn. Elev. = 155.51 City datum

IMPROVEMENT DISTRICT






BUILT AS PER PLAN
12-88
RDL

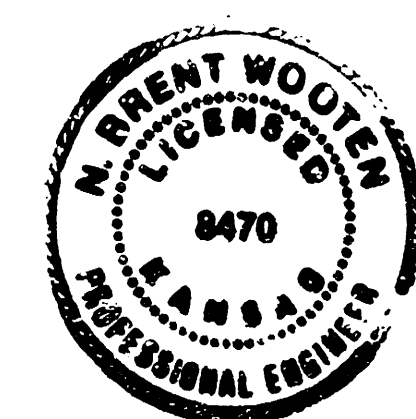


TITLE SHEET


BAUGHMAN COMPANY, P.A.					
SURVEYING & ENGINEERING					
315/252-7271 • 315 ELLIS • WICHITA, KANSAS 67211					
Design:	Drawn:	Checked:	Date:	Scale:	Sheet:
Wooten	garry	RDL	Nov 88	as noted	2
Project Number:					

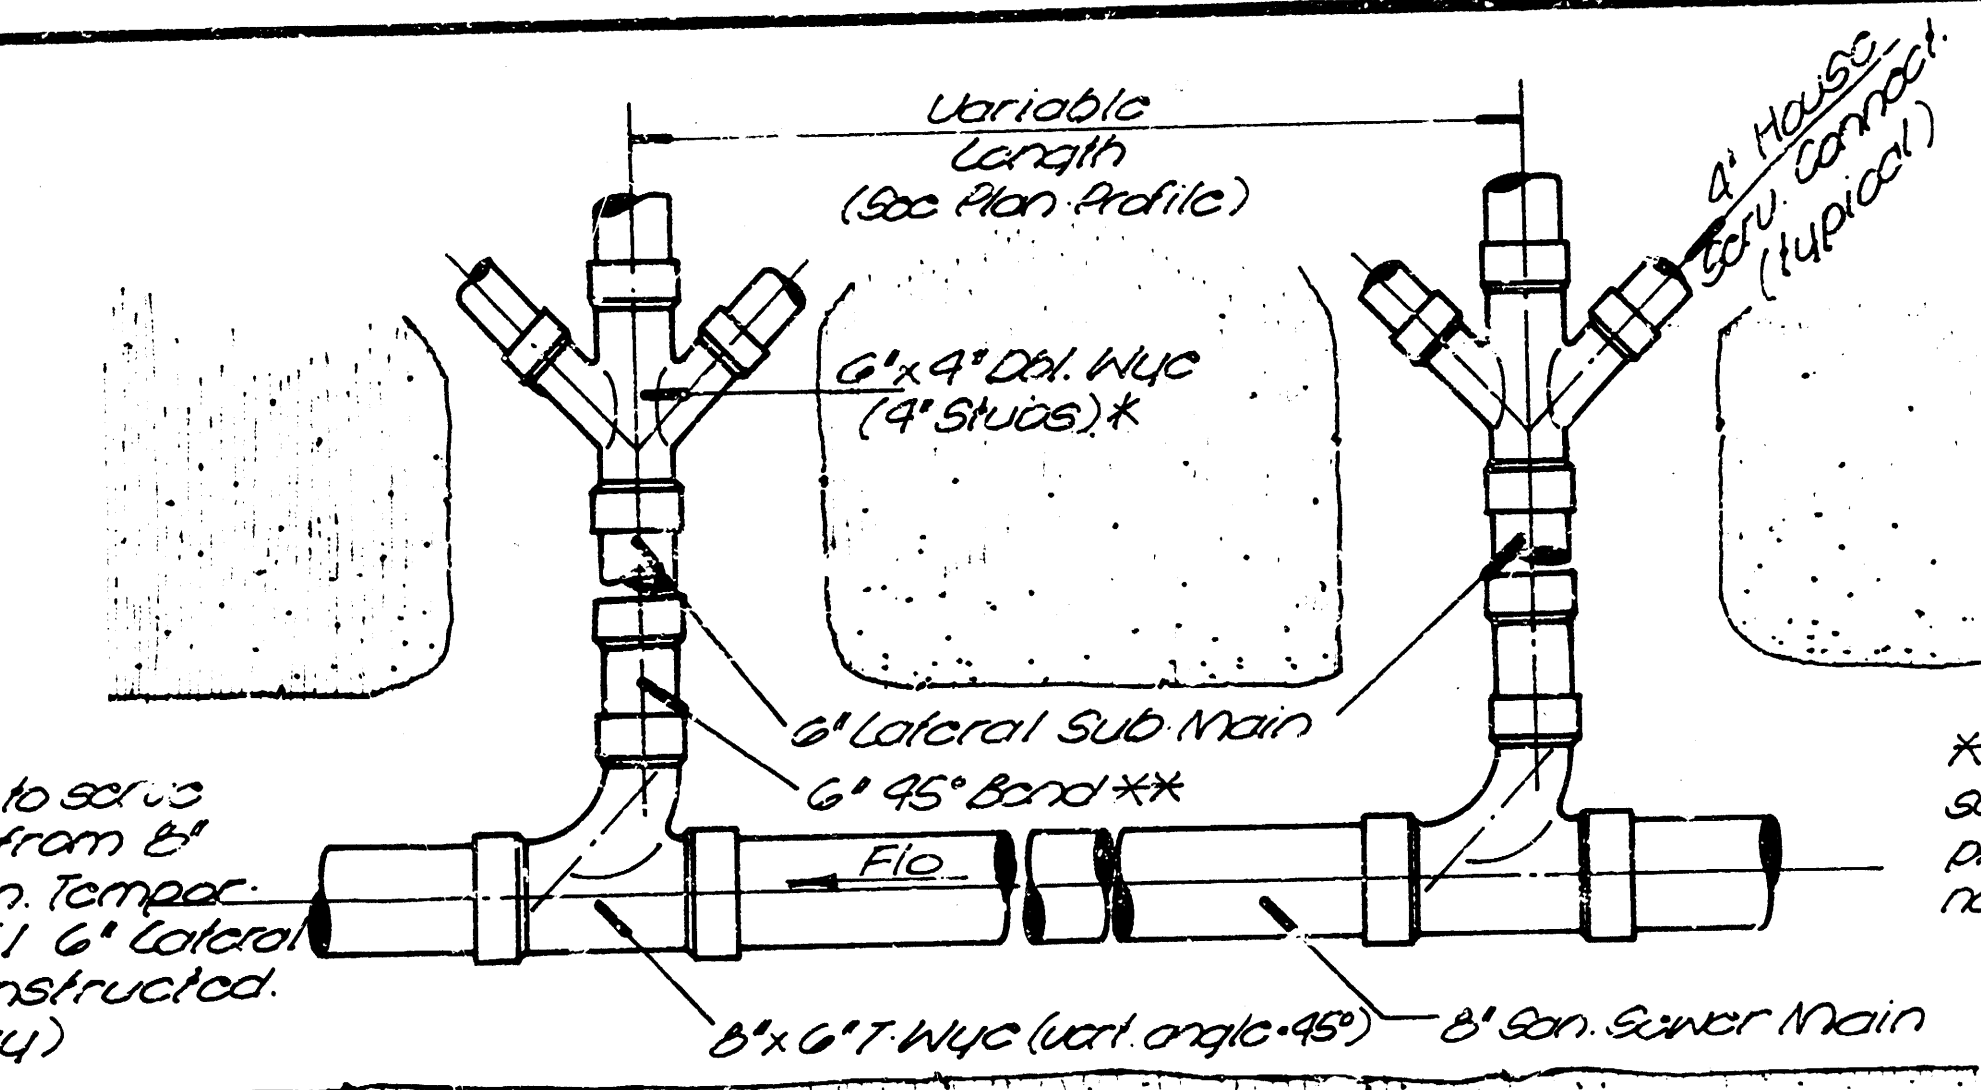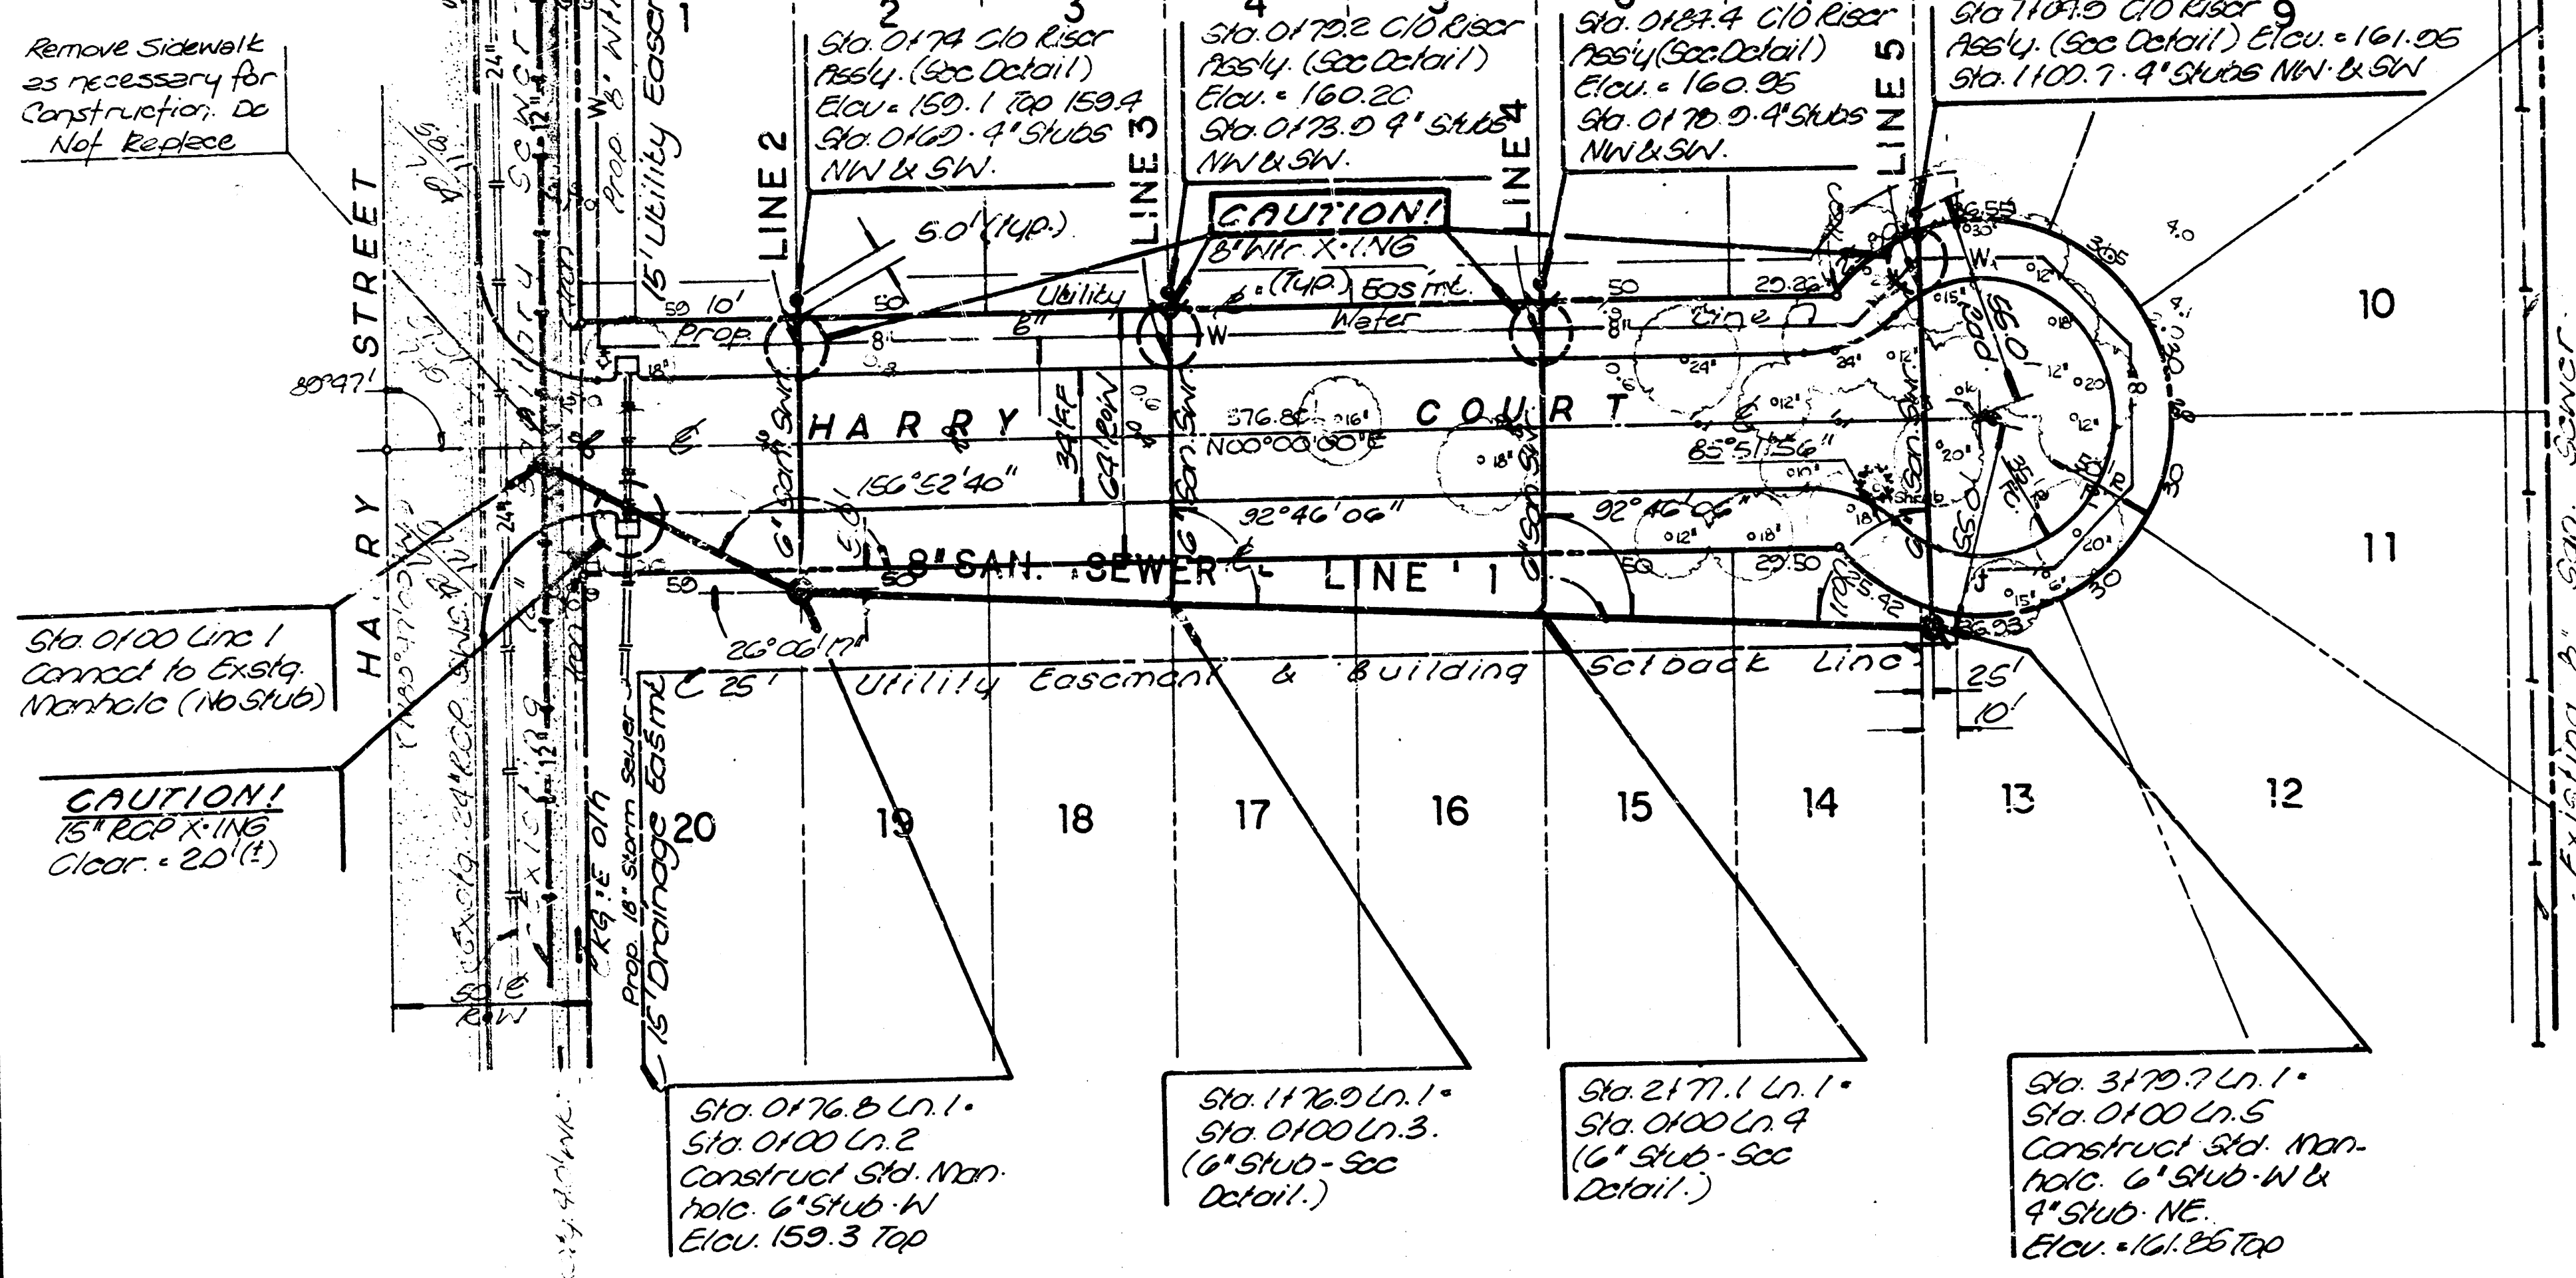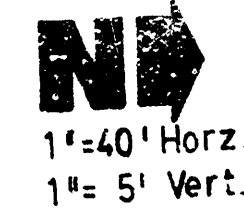

PLAN VIEW

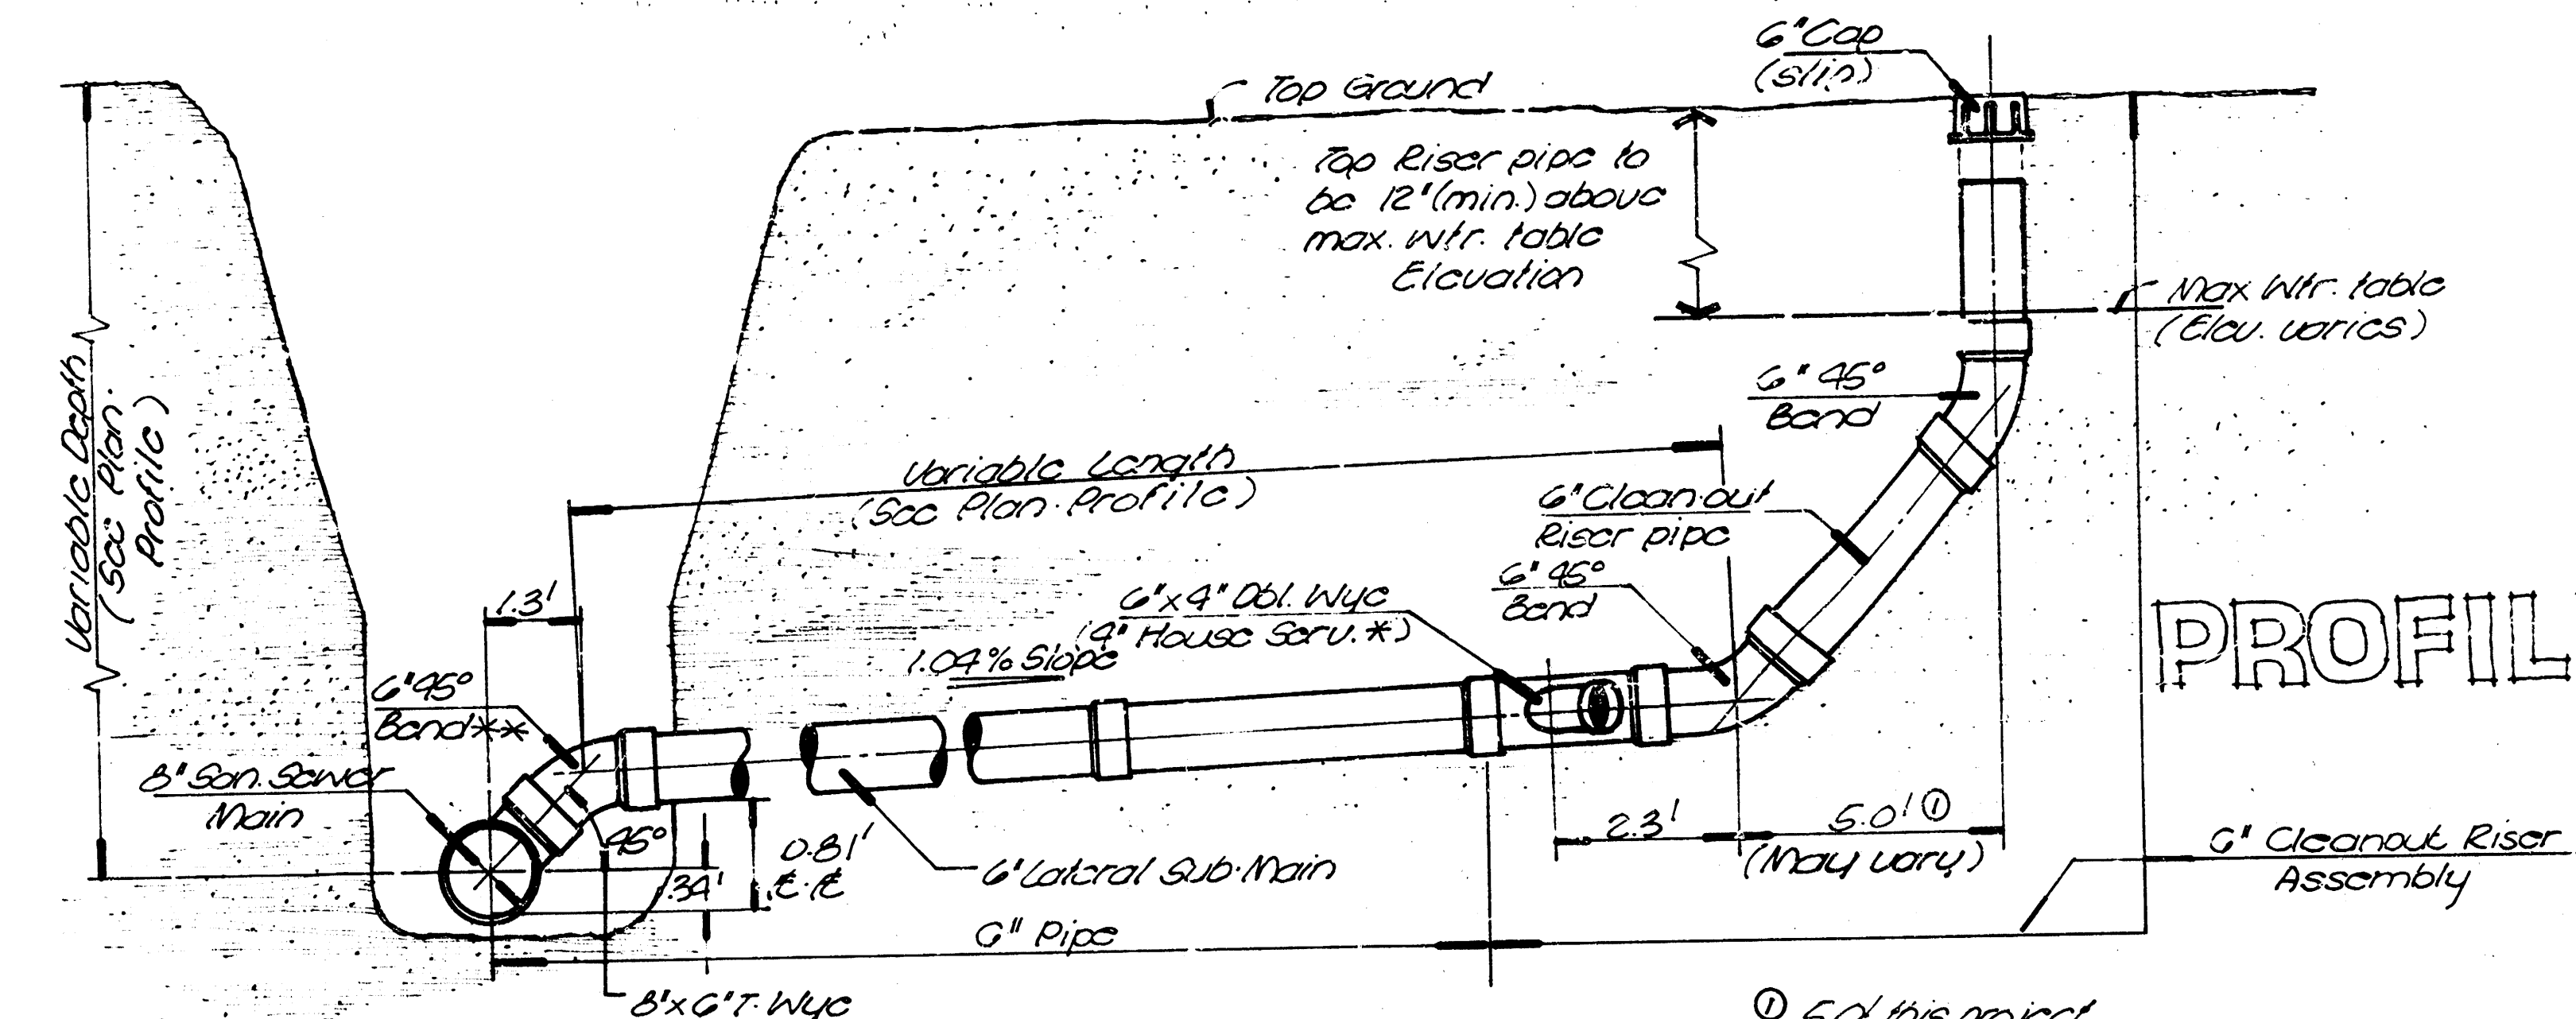

PROFILE

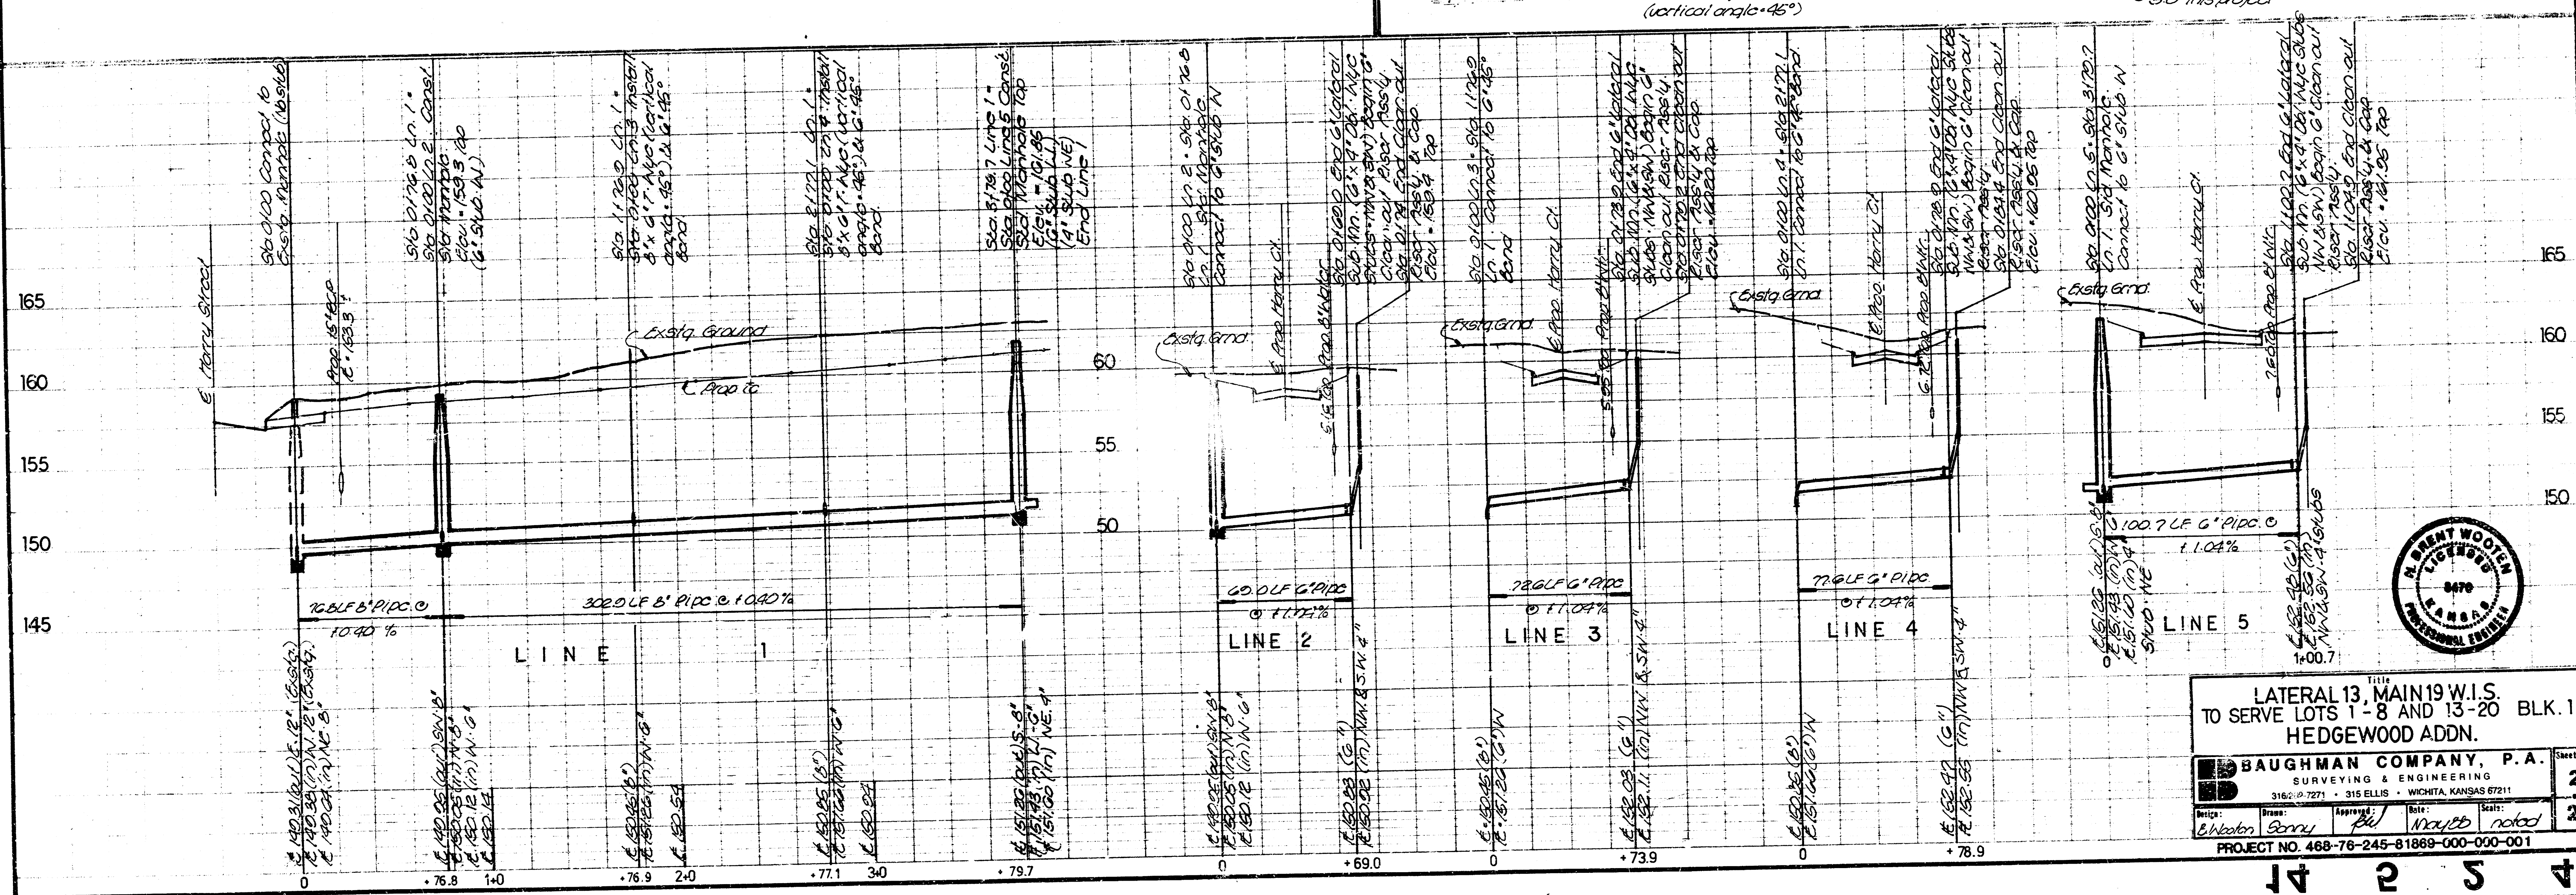

BAUGHMAN COMPANY, P.A.
SURVEYING & ENGINEERING
316 S. 22nd St. • 315 E. 11th St. • WICHITA, KANSAS 67211
Project No. 468-76-245-81889-000-001

Drawn by	Checked by	Reviewed by	Date	Scale
Wooten	Gerry	Wooten	10/1/76	As Noted