

LATERAL 12, MAIN 20, W.I.S.



PROJECT NO.

463-76-245-8055-000-000-001

CITY OF WICHITA, KANSAS

R.W. LINN CITY ENGINEER




JULY, 1978

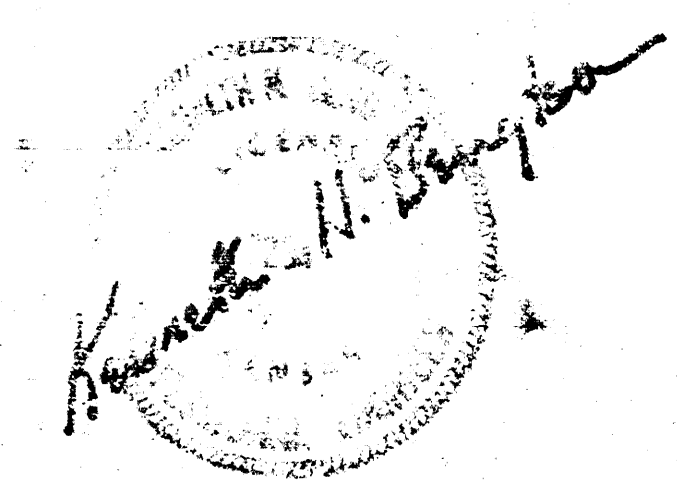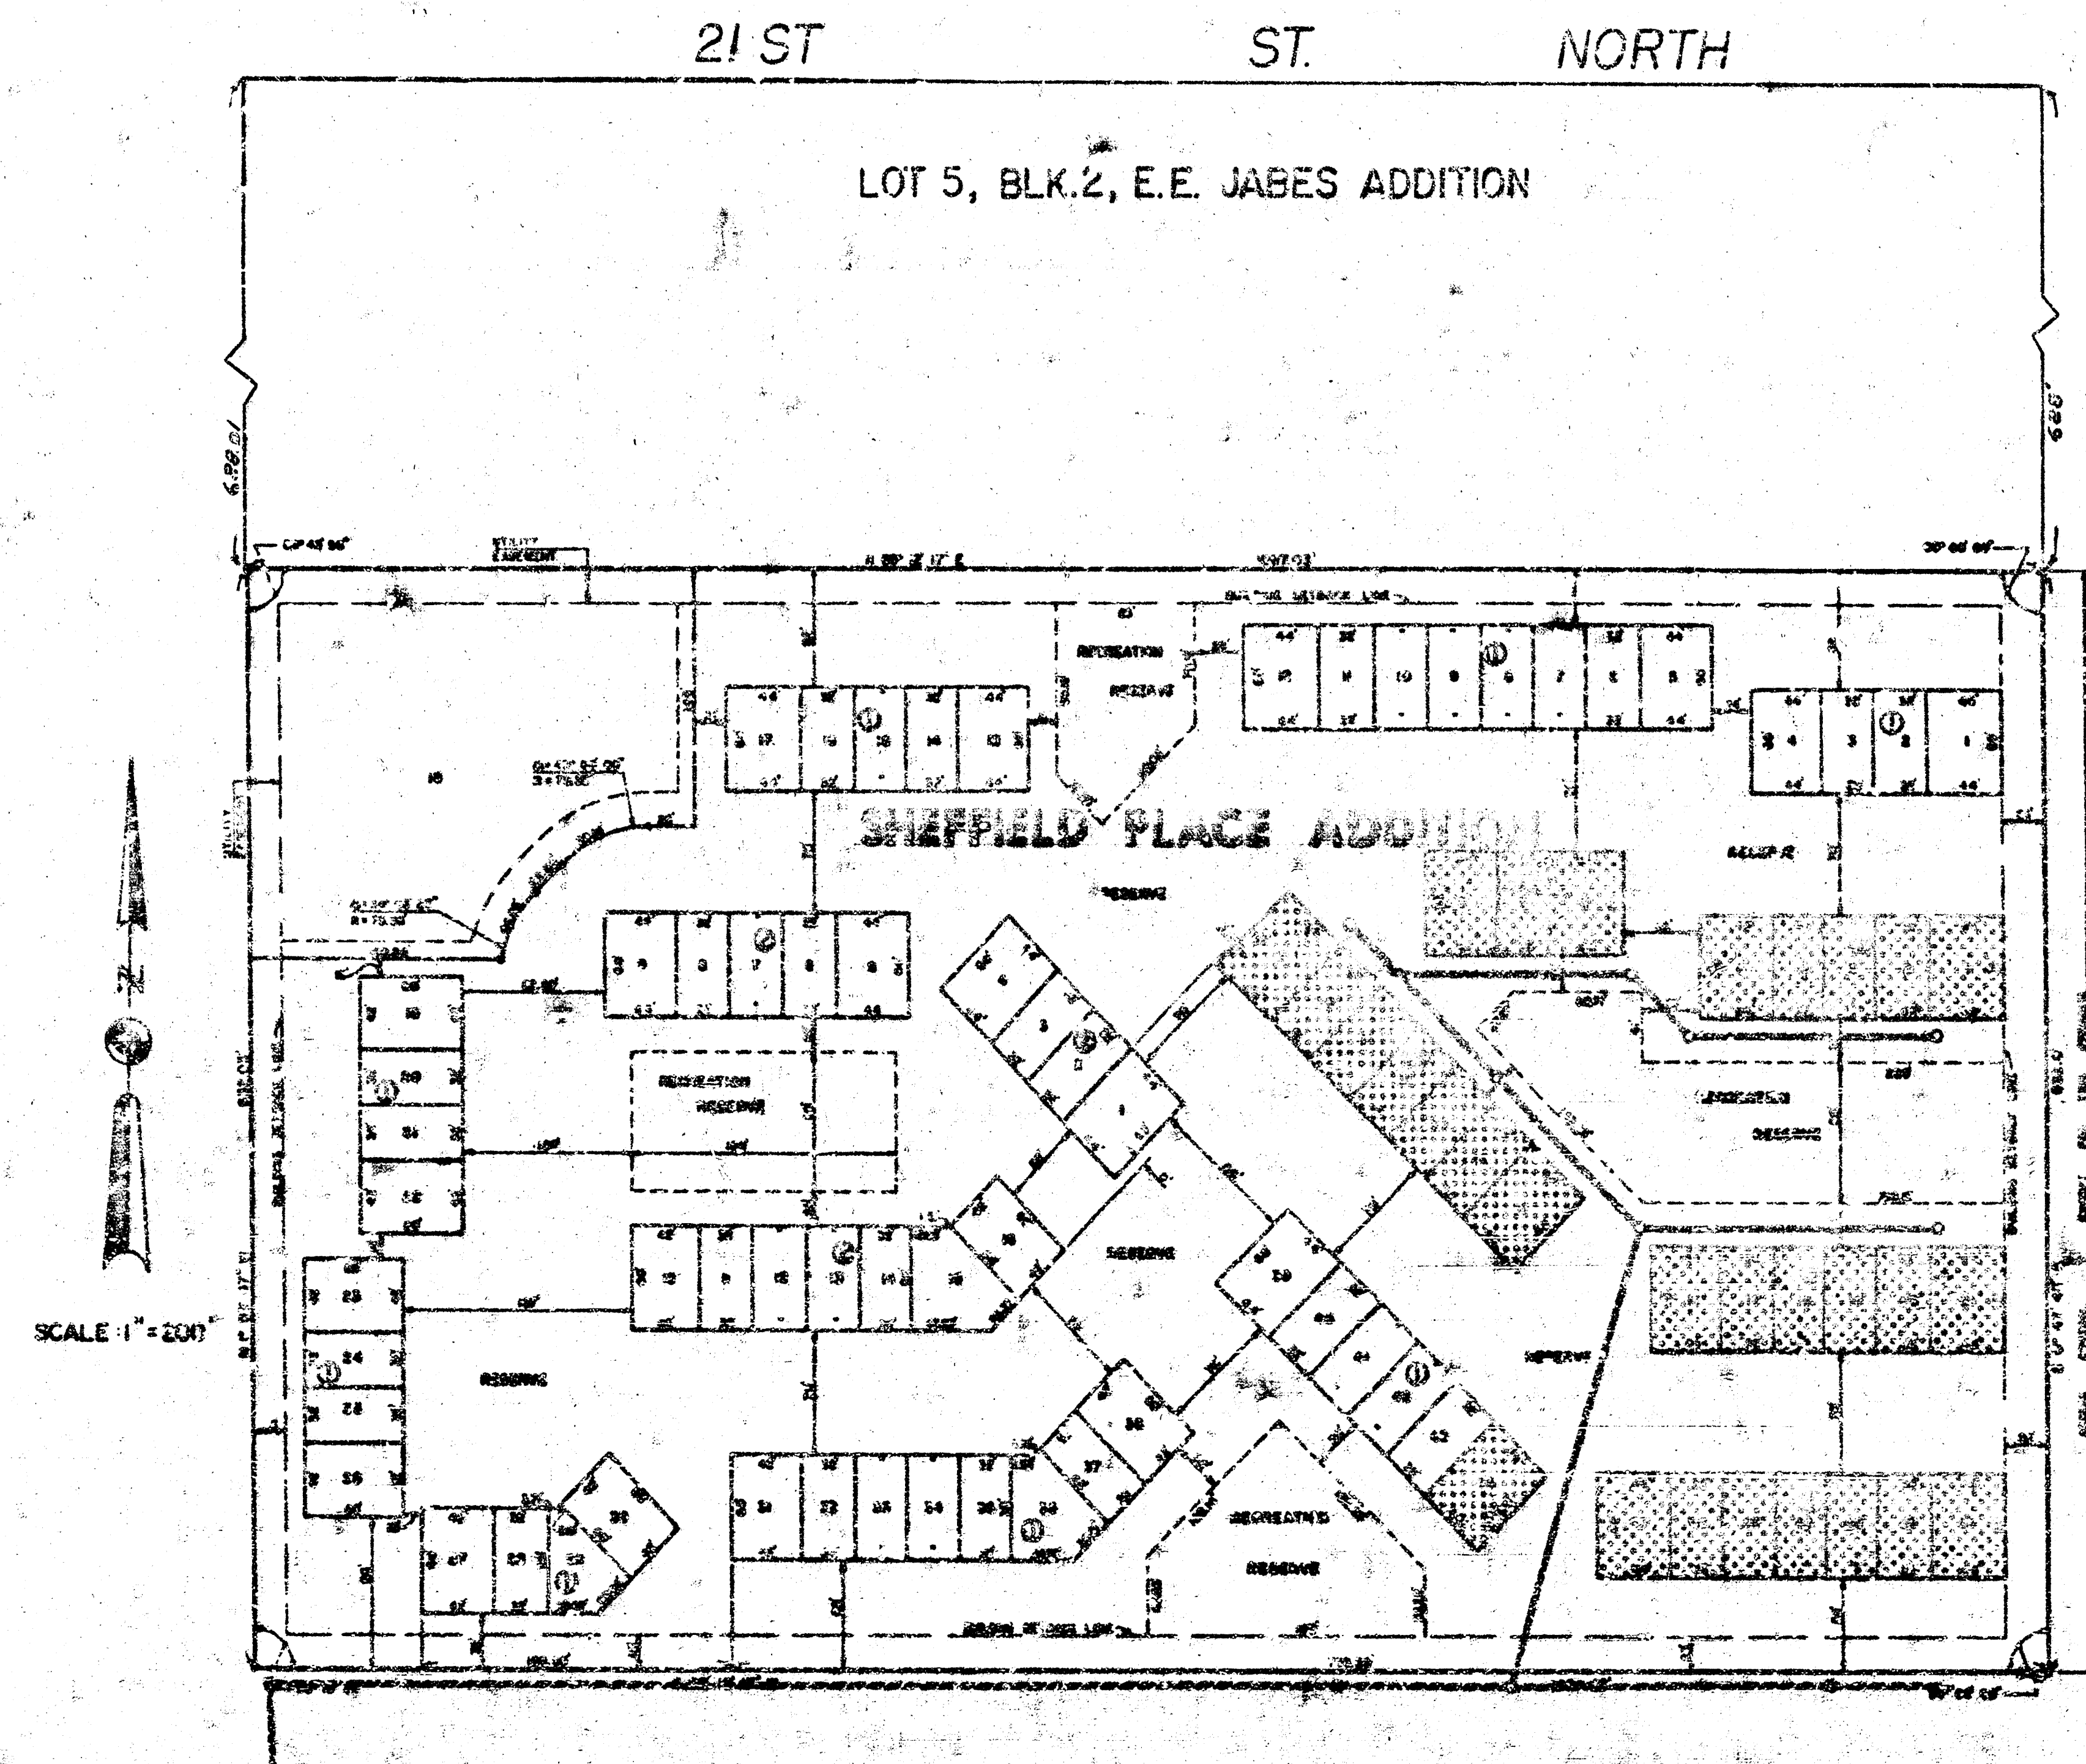

As Bldg
/s/ 3/6/79
B-1-94
D-41

BENEFIT DISTRICT DESCRIPTION - LOTS 44 THROUGH 51, BLOCK 1, AND ALL LOTS IN BLOCK 2, SHEFFIELD PLACE ADDITION

B.M. 217.23 - RR Spike S.S.T.P. No. Side 21st St No. and P.S.
E.L. Broadmoor

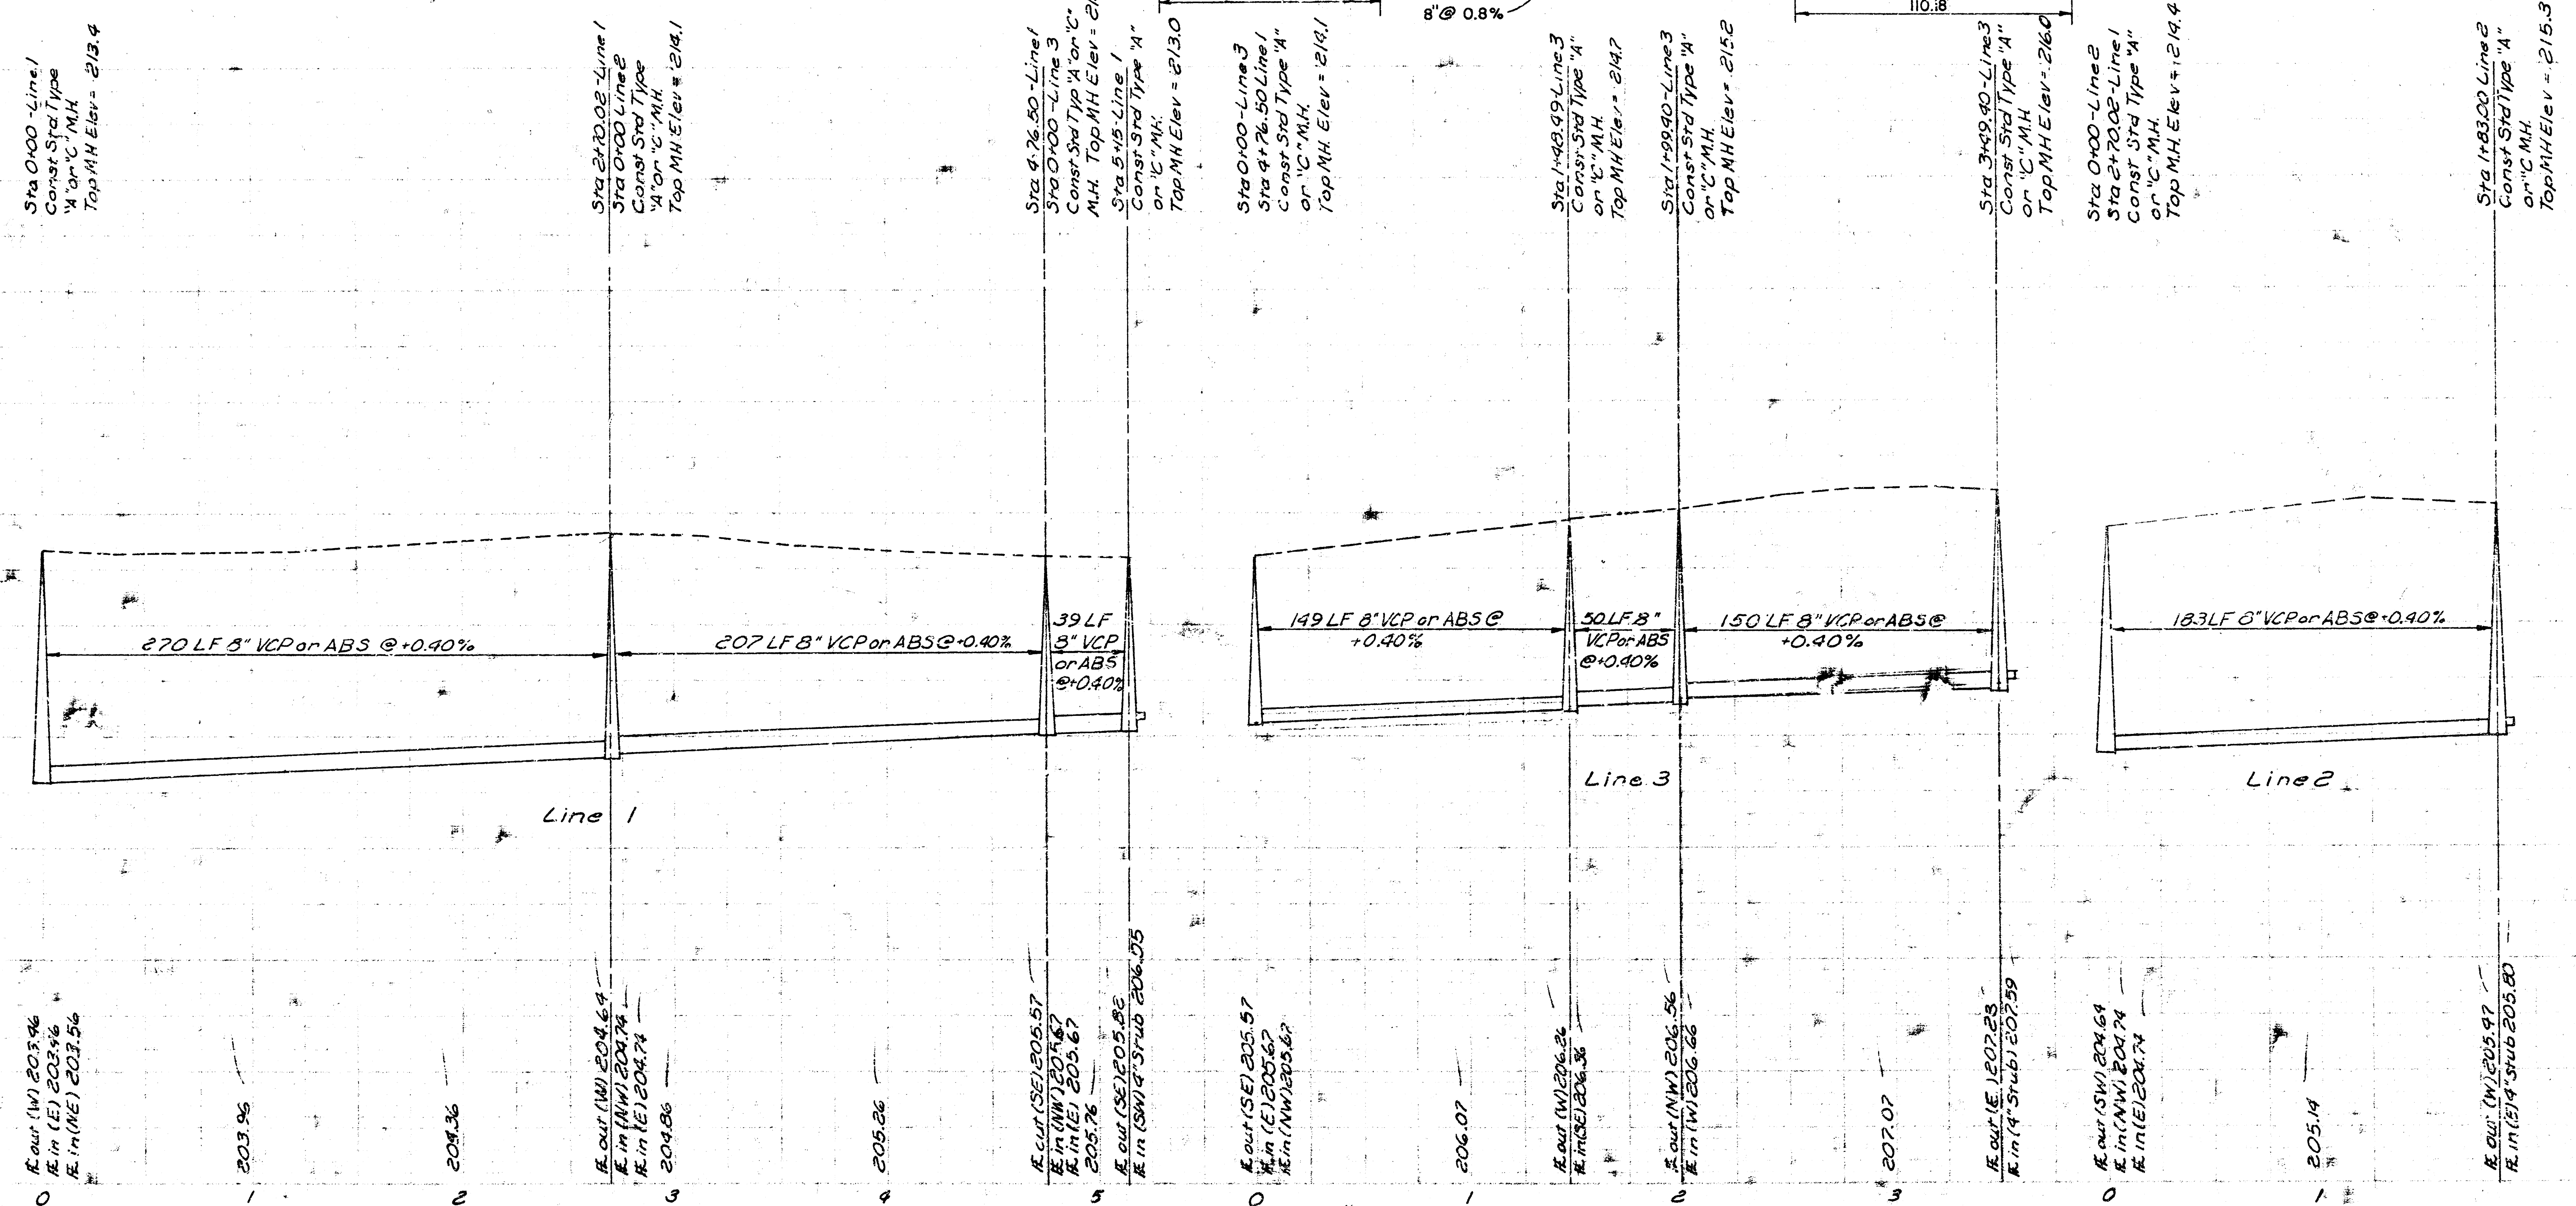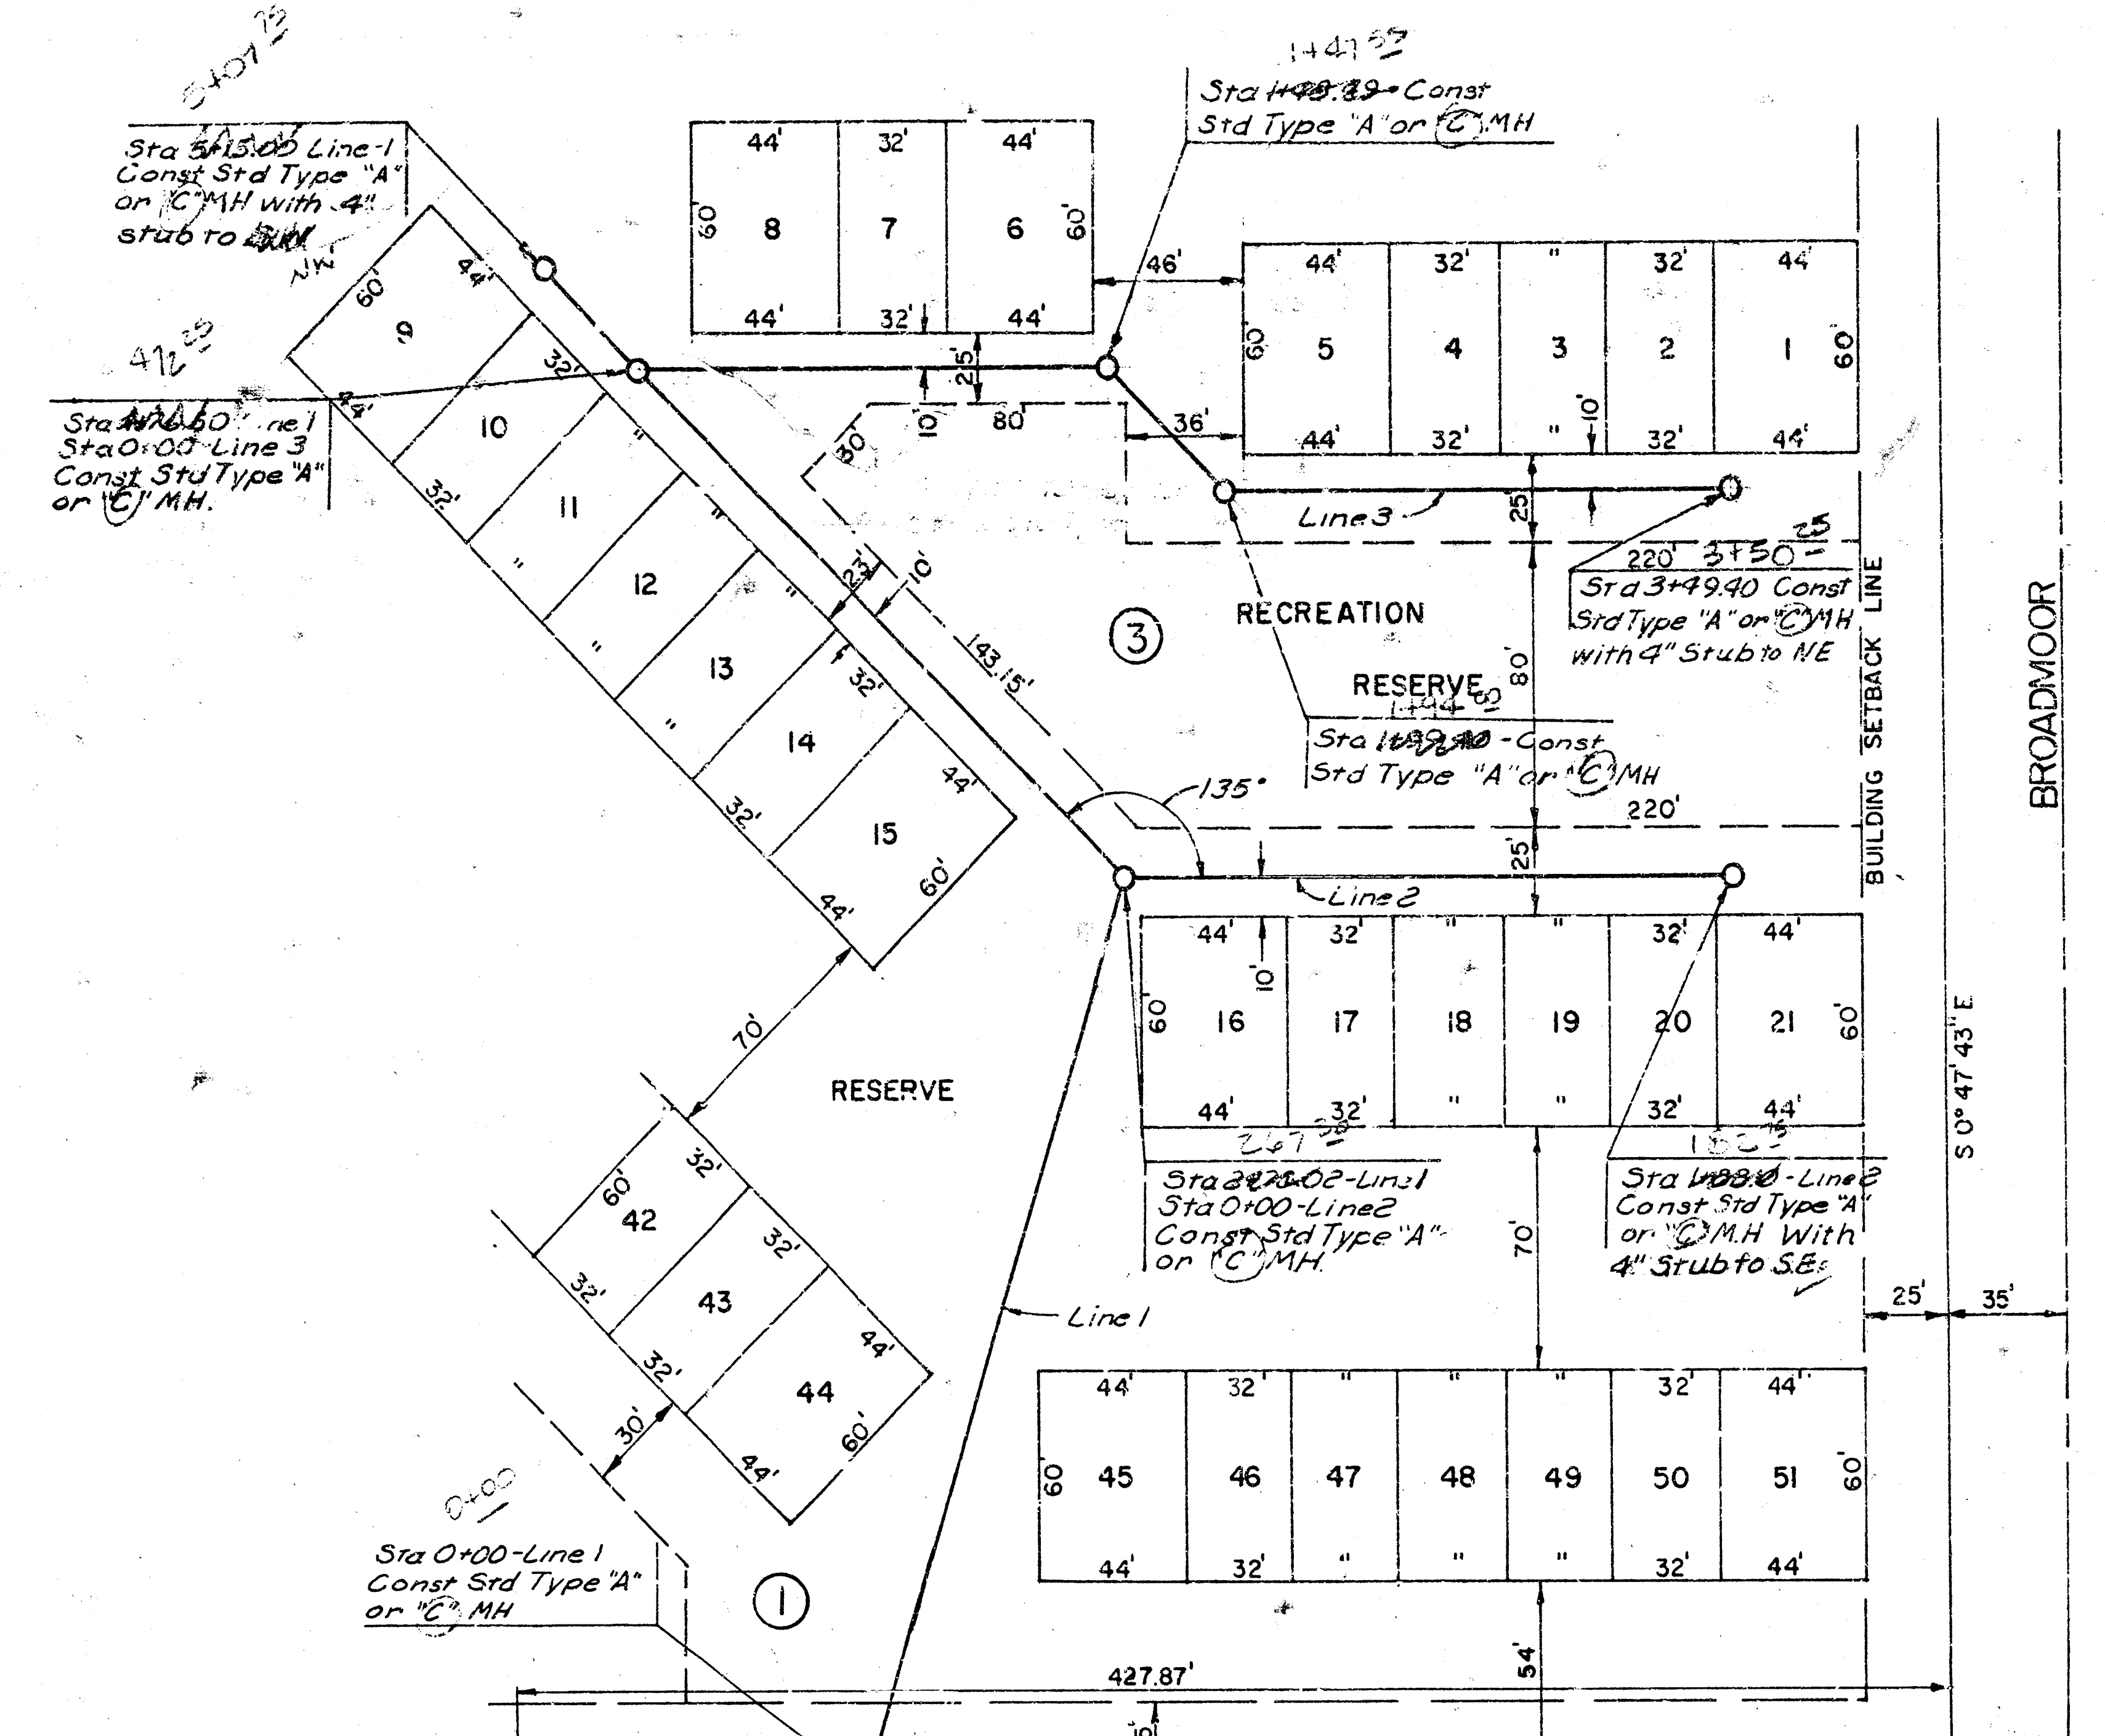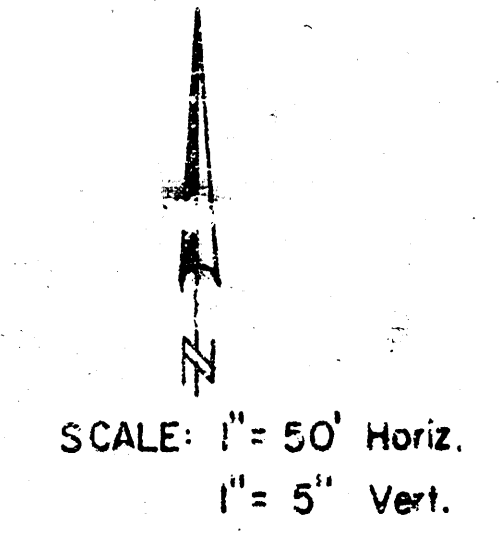

to RULY
H-4
D-A