
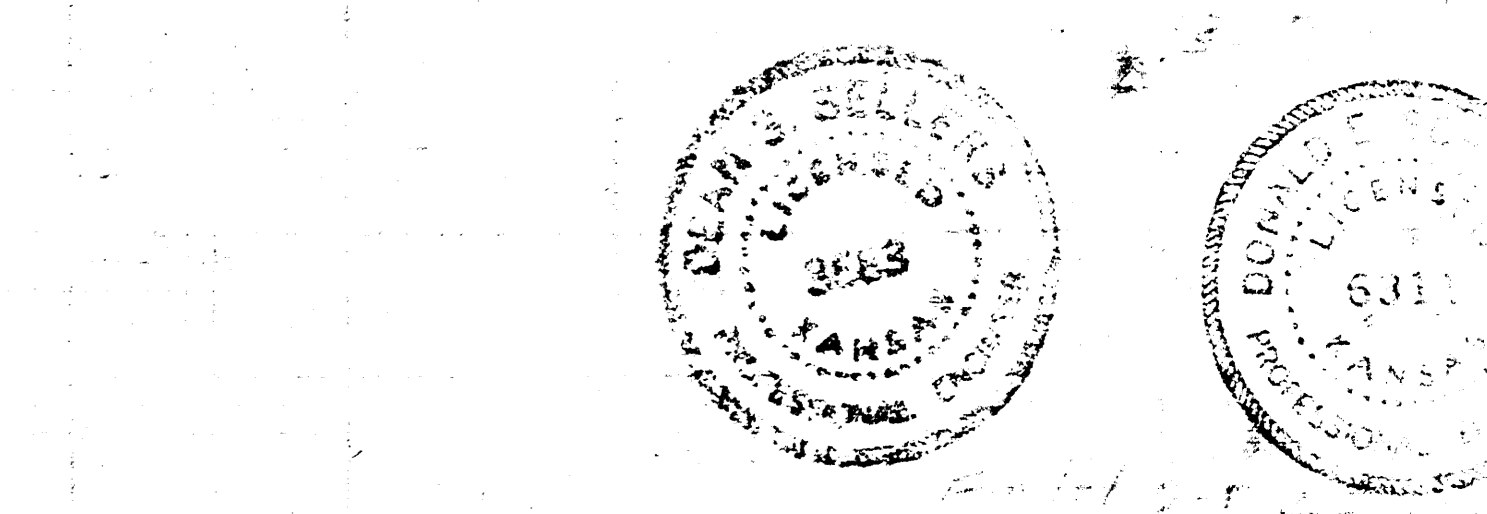
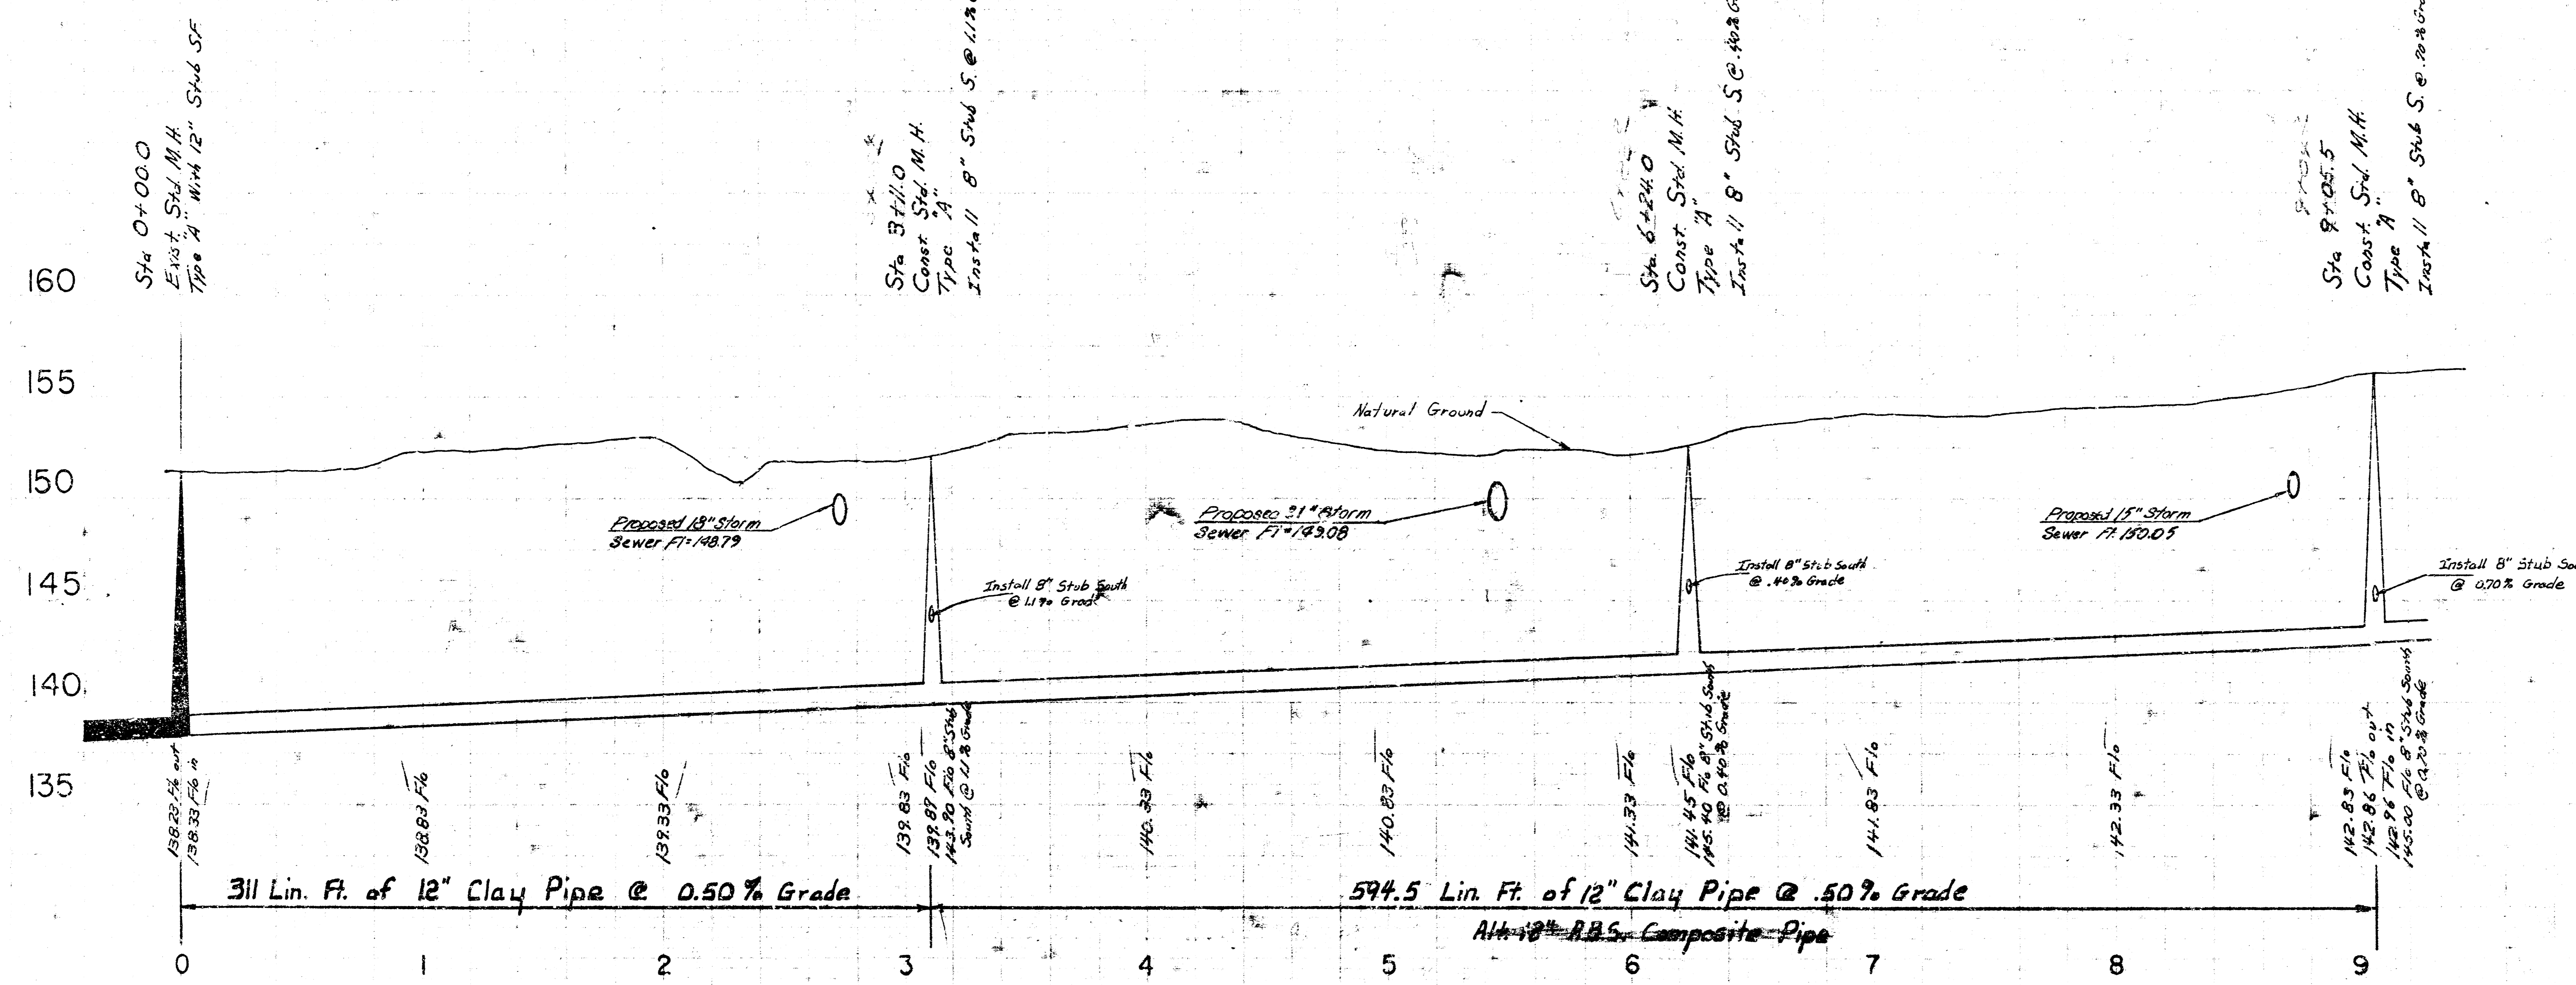


BM = 153.46 "□" on SW Cor. Conc. Headwall to Dyke


Plan Scale 1" = 40'  
Profile Scale 1" = 40' Horz.  
1" = 5' Vert.

**NOTE: SEE BENEFIT ORDINANCE FOR BENEFIT DISTRICT**  
RESERVE "A"  
*Note Type C Manholes were installed instead of type A*

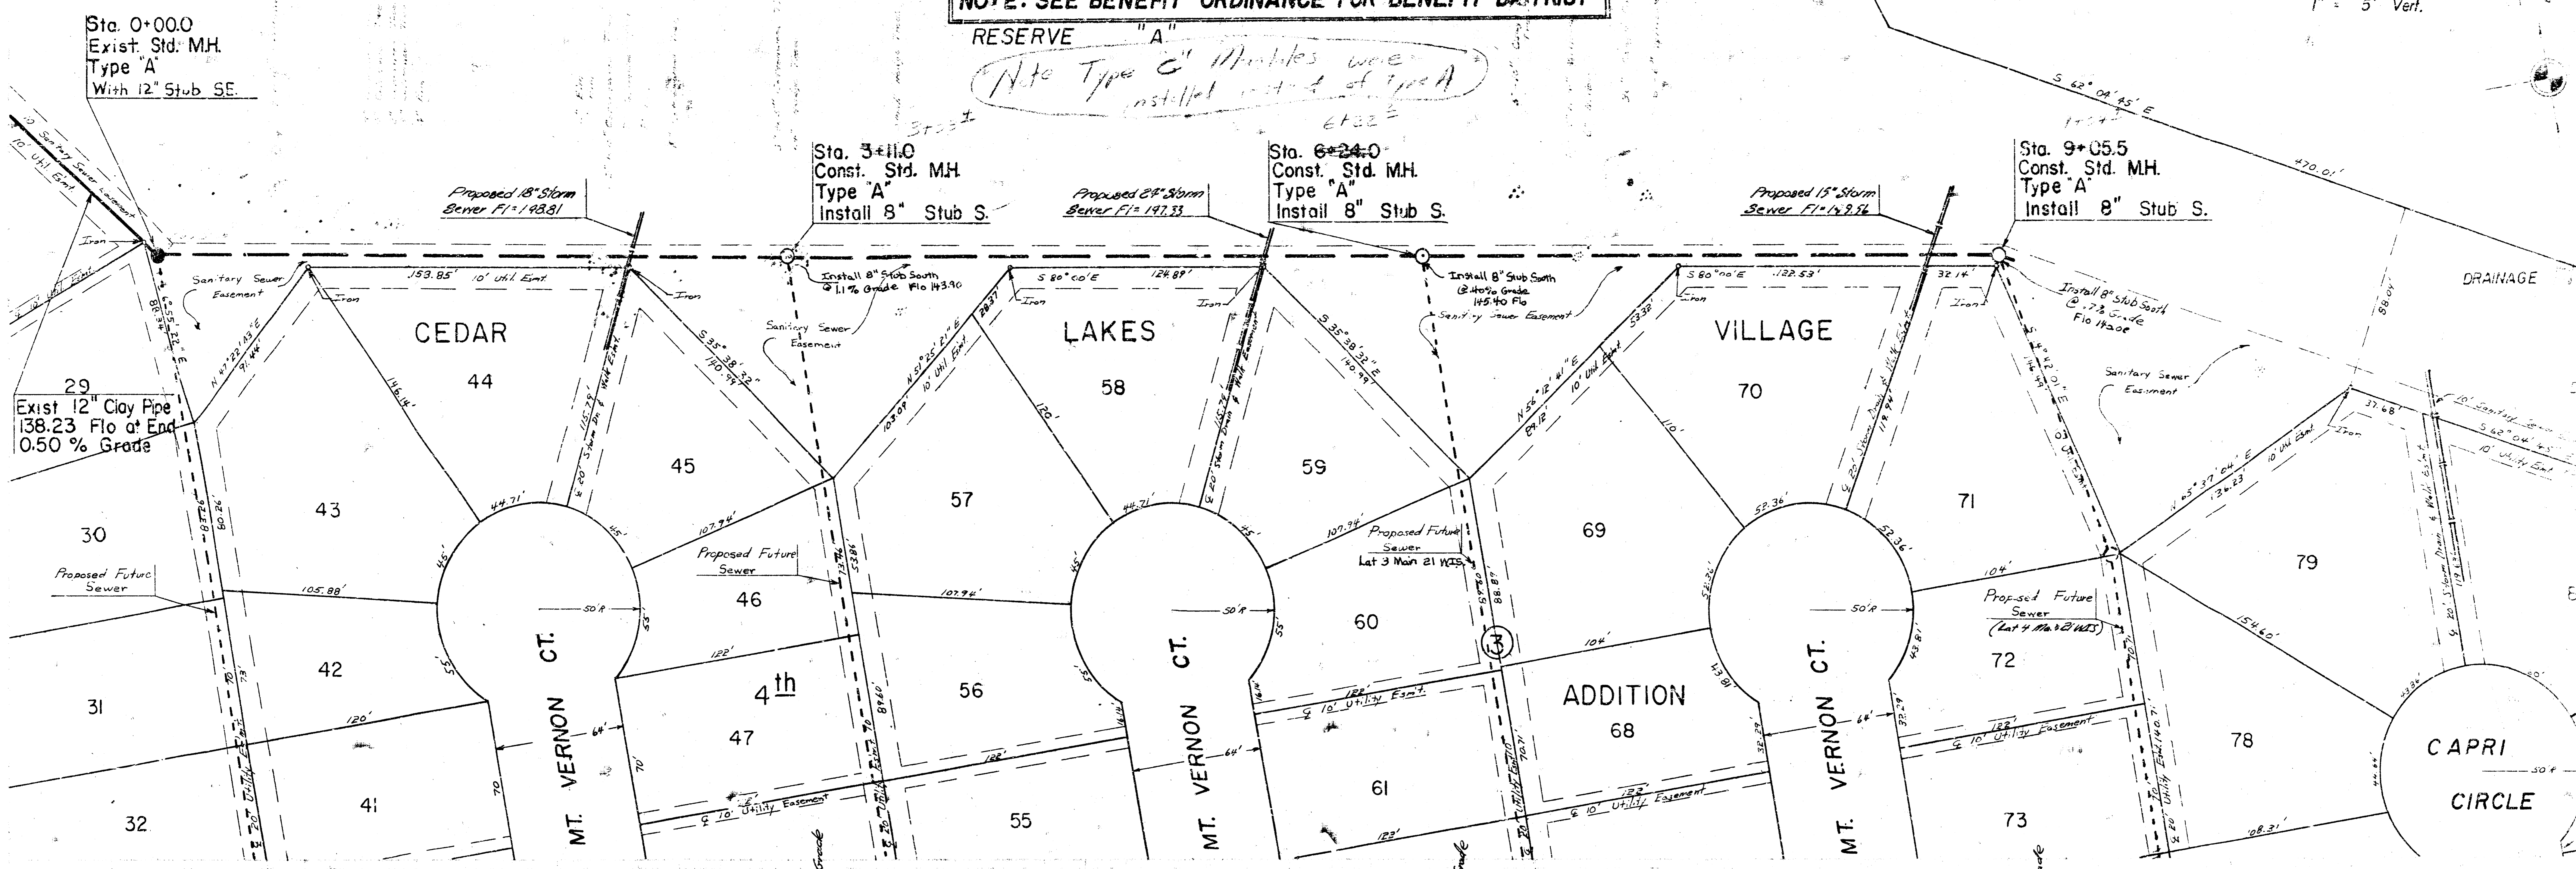

**MAIN 21 WAR INDUSTRIES**  
CITY OF WICHITA, KANSAS  
R. W. LINN — CITY ENG  
PROJECT NO. DRKM

RESERVE "A"

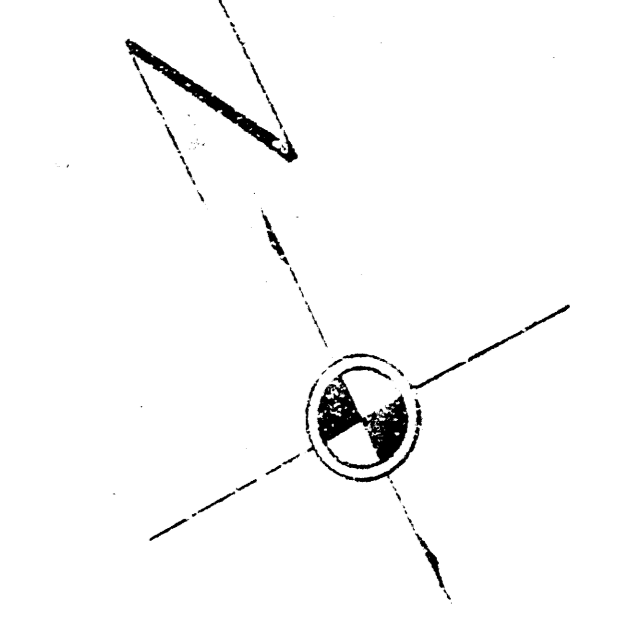

Plan Scale 1" = 40'  
Profile Scale 1" = 40' Horiz.  
1" = 5' Vert.

