


CONSTRUCTION PLANS FOR
LATERAL 12, MAIN 24
 OF THE
WAR INDUSTRIES SEWER
 IN
THE CITY OF WICHITA,
 SEDGWICK COUNTY, KANSAS
 MICHAEL E. LINDEBAK, P.E. - CITY ENGINEER

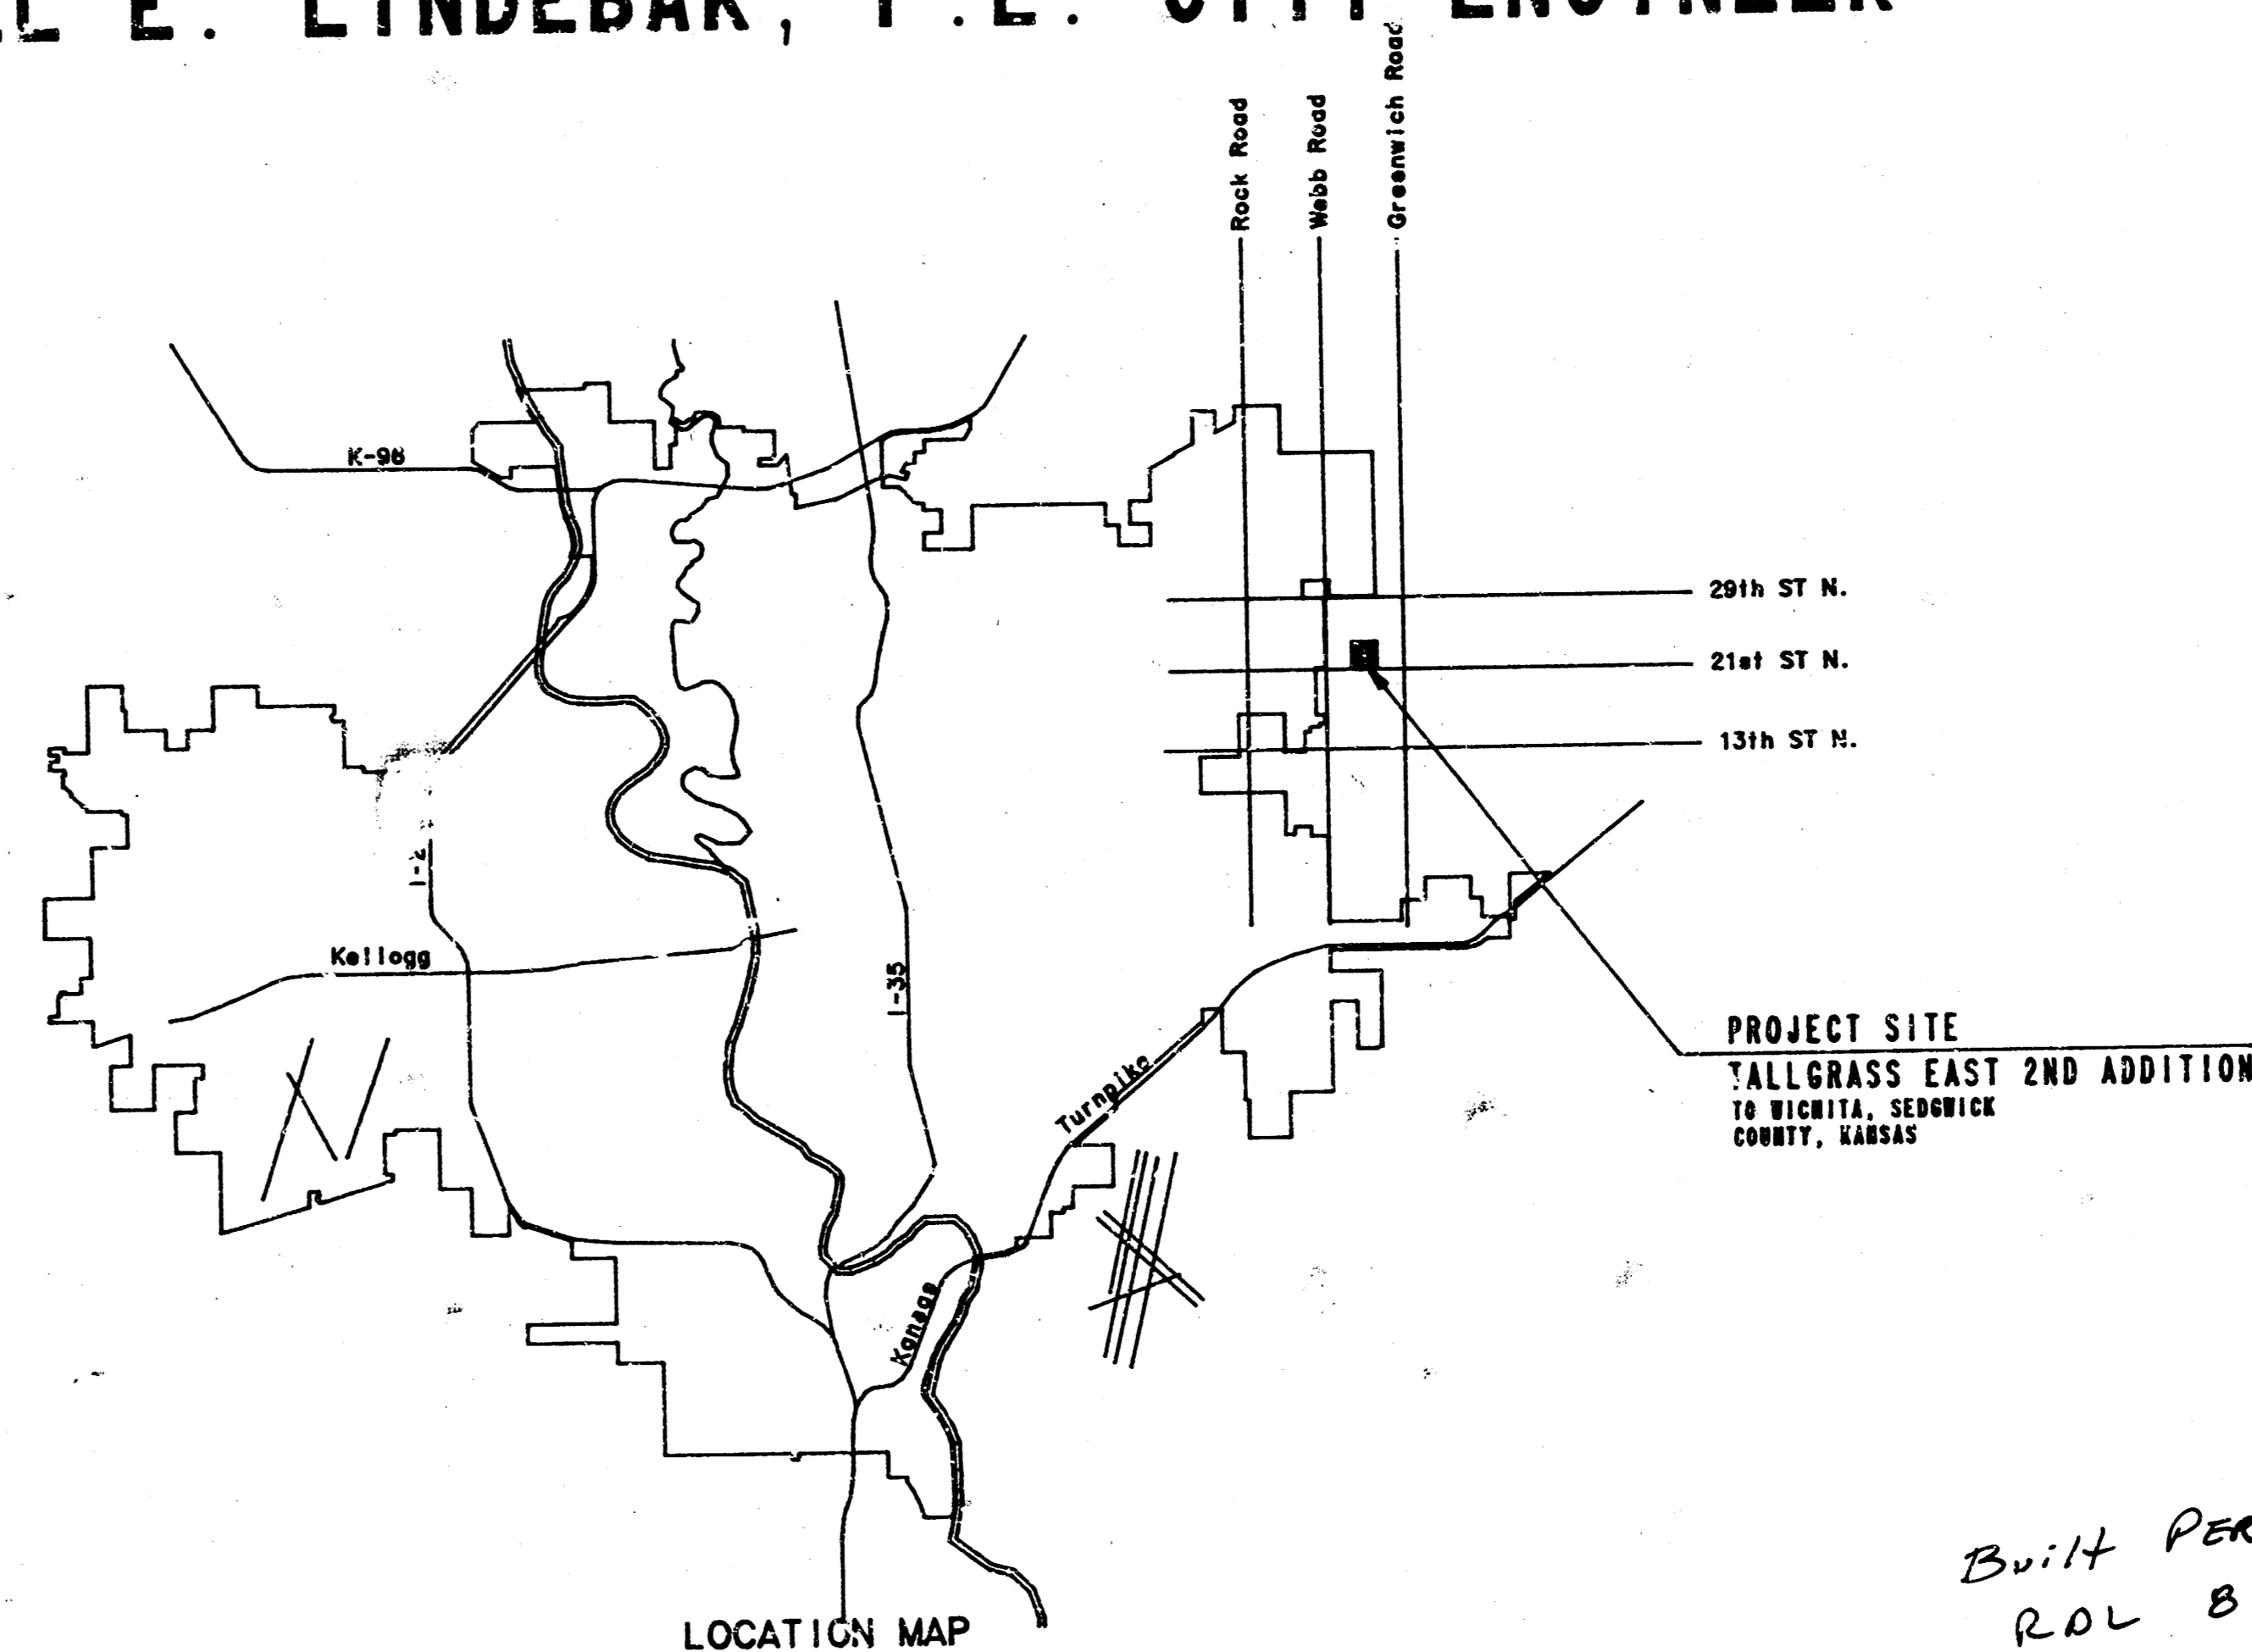

INDEX OF SHEETS

SHEET NO. 1	TITLE SHEET
SHEET NO. 2	KEY MAP and EASEMENT GRADING
SHEET NO. 3	PLAN
SHEET NO. 4-7	PLAN-PROFILE
SHEET NO. 8	TYPE "P" MANHOLE DETAILS
SHEET NO. 9	TYPE "D" MANHOLE DETAILS
SHEET NO. 10	TYPE "C" MANHOLE DETAILS
SHEET NO. 11	FRAME & COVER DETAIL
SHEET NO. 12	RISER DETAIL

*Built PER PLAN
 ROL 8-89*

*SC
 5190*




INDEX CODE #608042
 CITY OF WICHITA PROJECT NO. 468-76-245-81806-000-000-001

FEBRUARY, 1989

PLANS PREPARED BY
PROFESSIONAL ENGINEERING CONSULTANTS, P.A.
 ENGINEERS
 WICHITA, KANSAS


FEB 13, 1989

FILMED FROM THE BEST AVAILABLE COPY

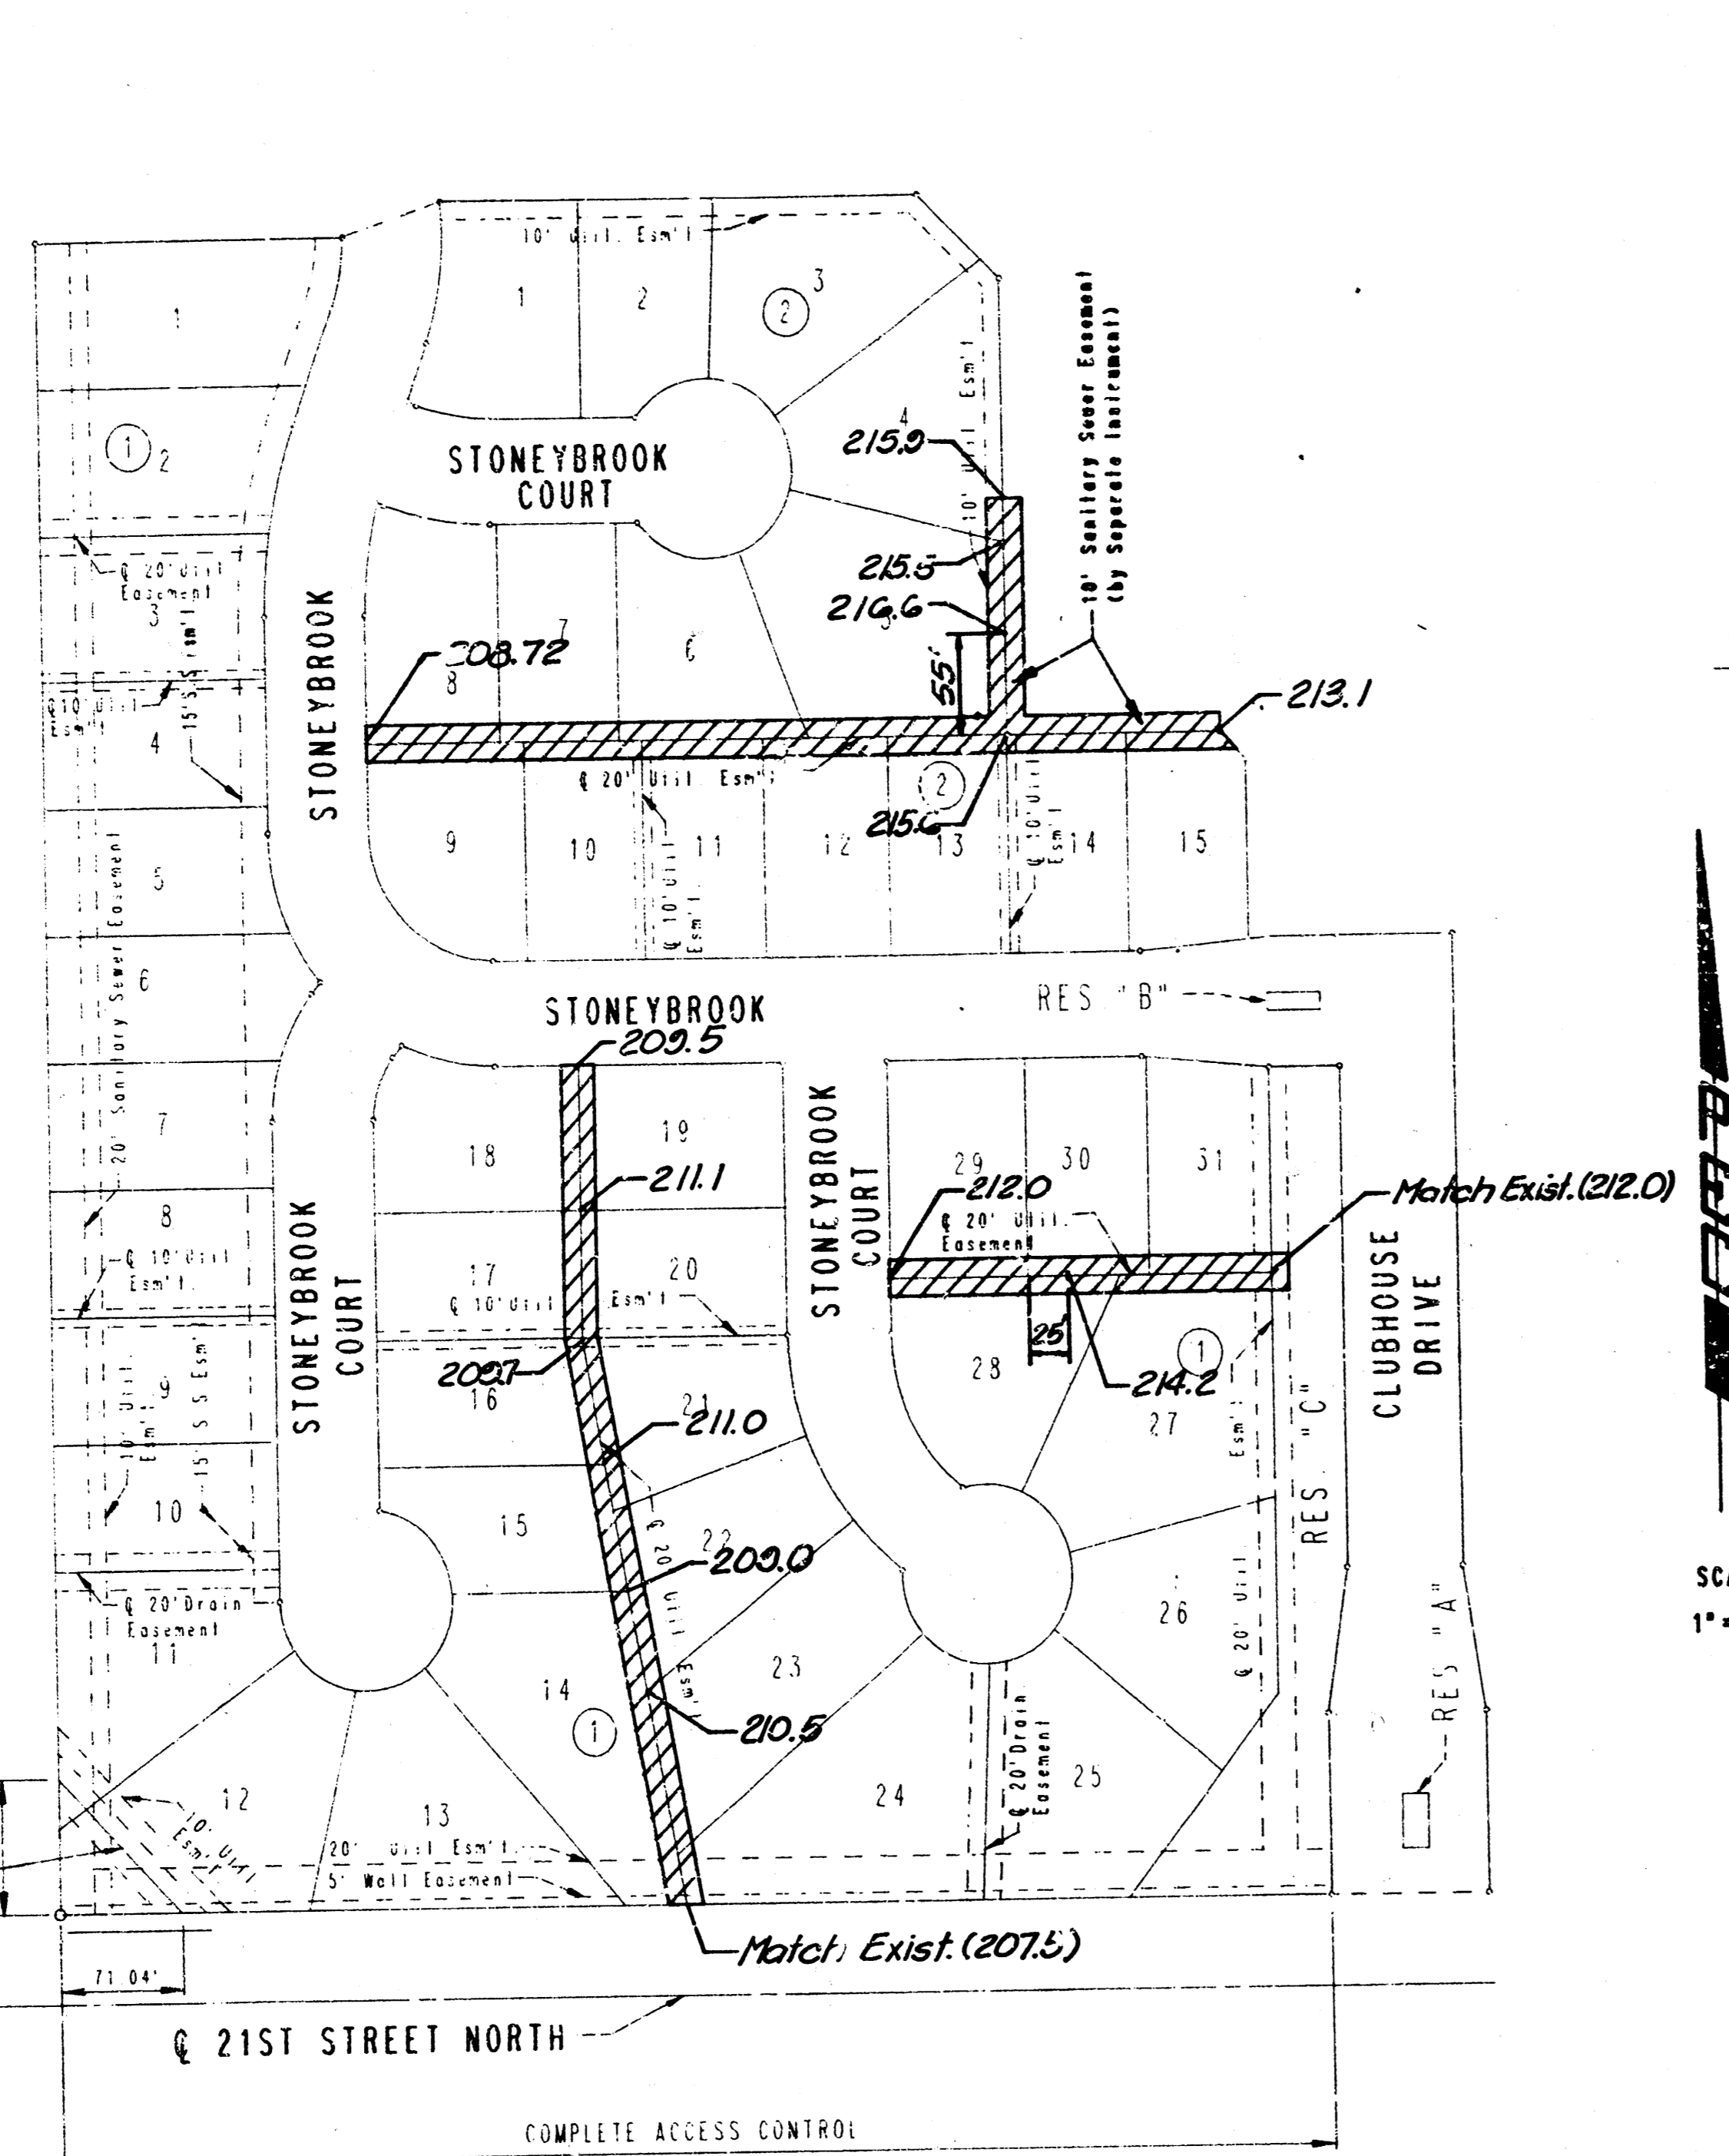


EASEMENT GRADING


Limits of Area to be Graded

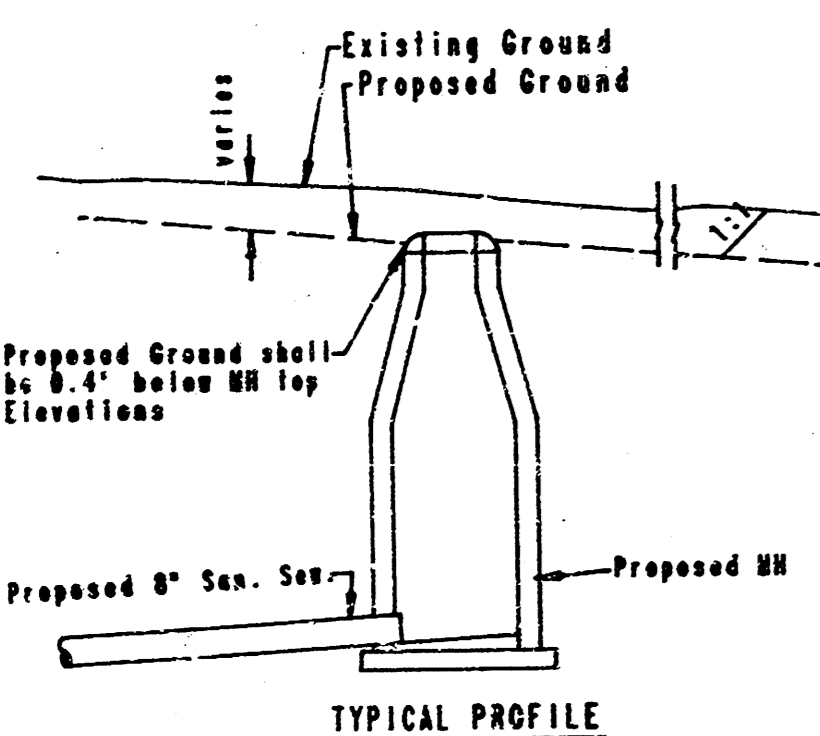


"CUT" SITUATIONS

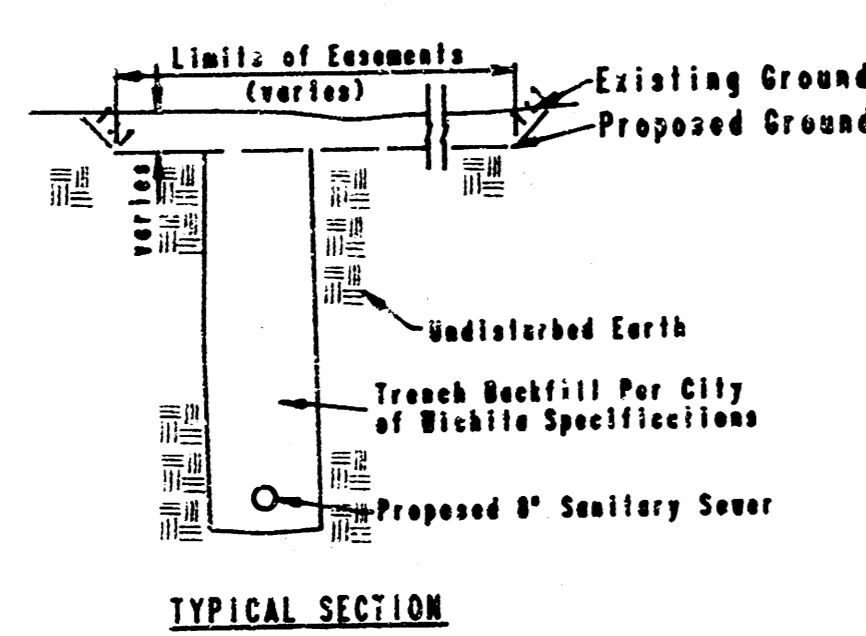

TYPICAL SECTION

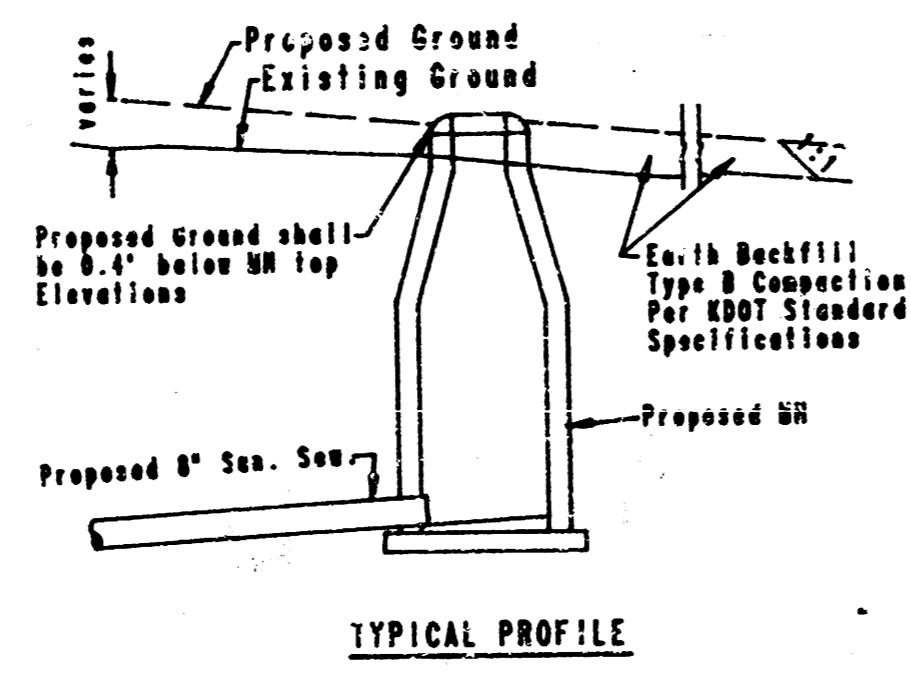

"FILL" SITUATIONS

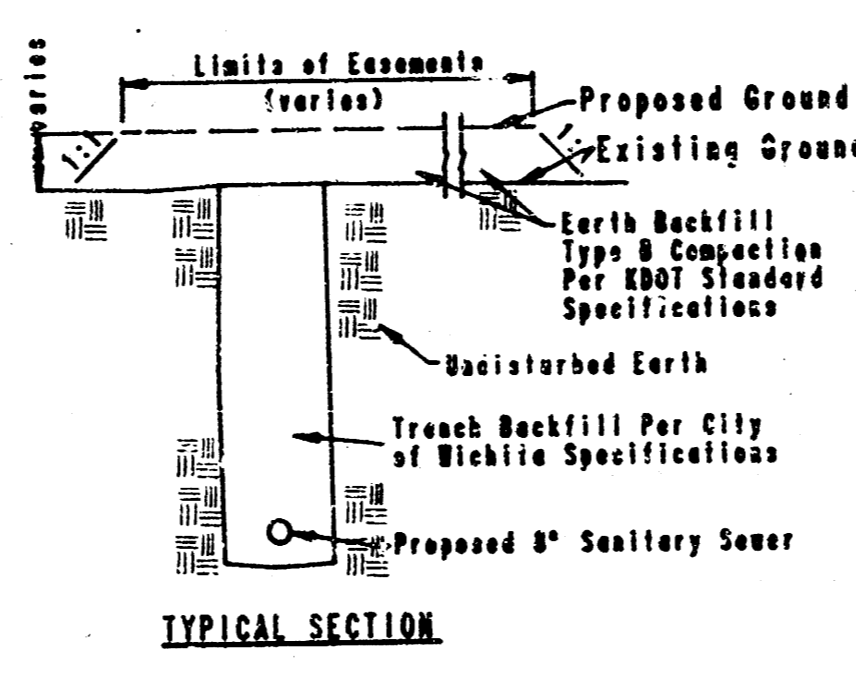

TYPICAL SECTION


BENCH MARK

BM - CITY OF WICHITA BM DISC, 44 FEET SOUTH AND 43 FEET EAST OF INTERSECTION OF CENTERLINES OF WEBB ROAD AND 21ST STREET NORTH. ELEV = 205.238

BM - CHISELED "X" IN TOP OF CURB AT P.C. ALONG WEST SIDE OF STONEYBROOK APPROXIMATELY 220 FEET NORTH OF THE NORTH LINE OF TALLGRASS EAST 2ND ADDITION (AT LOT 48, BLOCK 2 IN TALLGRASS EAST ADDITION). ELEV = 202.55

BM - CHISELED "X" IN TOP OF CURB AT P.C. ALONG WEST SIDE OF STONEYBROOK APPROXIMATELY 220 FEET NORTH OF THE NORTH LINE OF TALLGRASS EAST 2ND ADDITION (AT LOT 48, BLOCK 2 IN TALLGRASS EAST ADDITION). ELEV = 209.55

SCALE 1"=100'

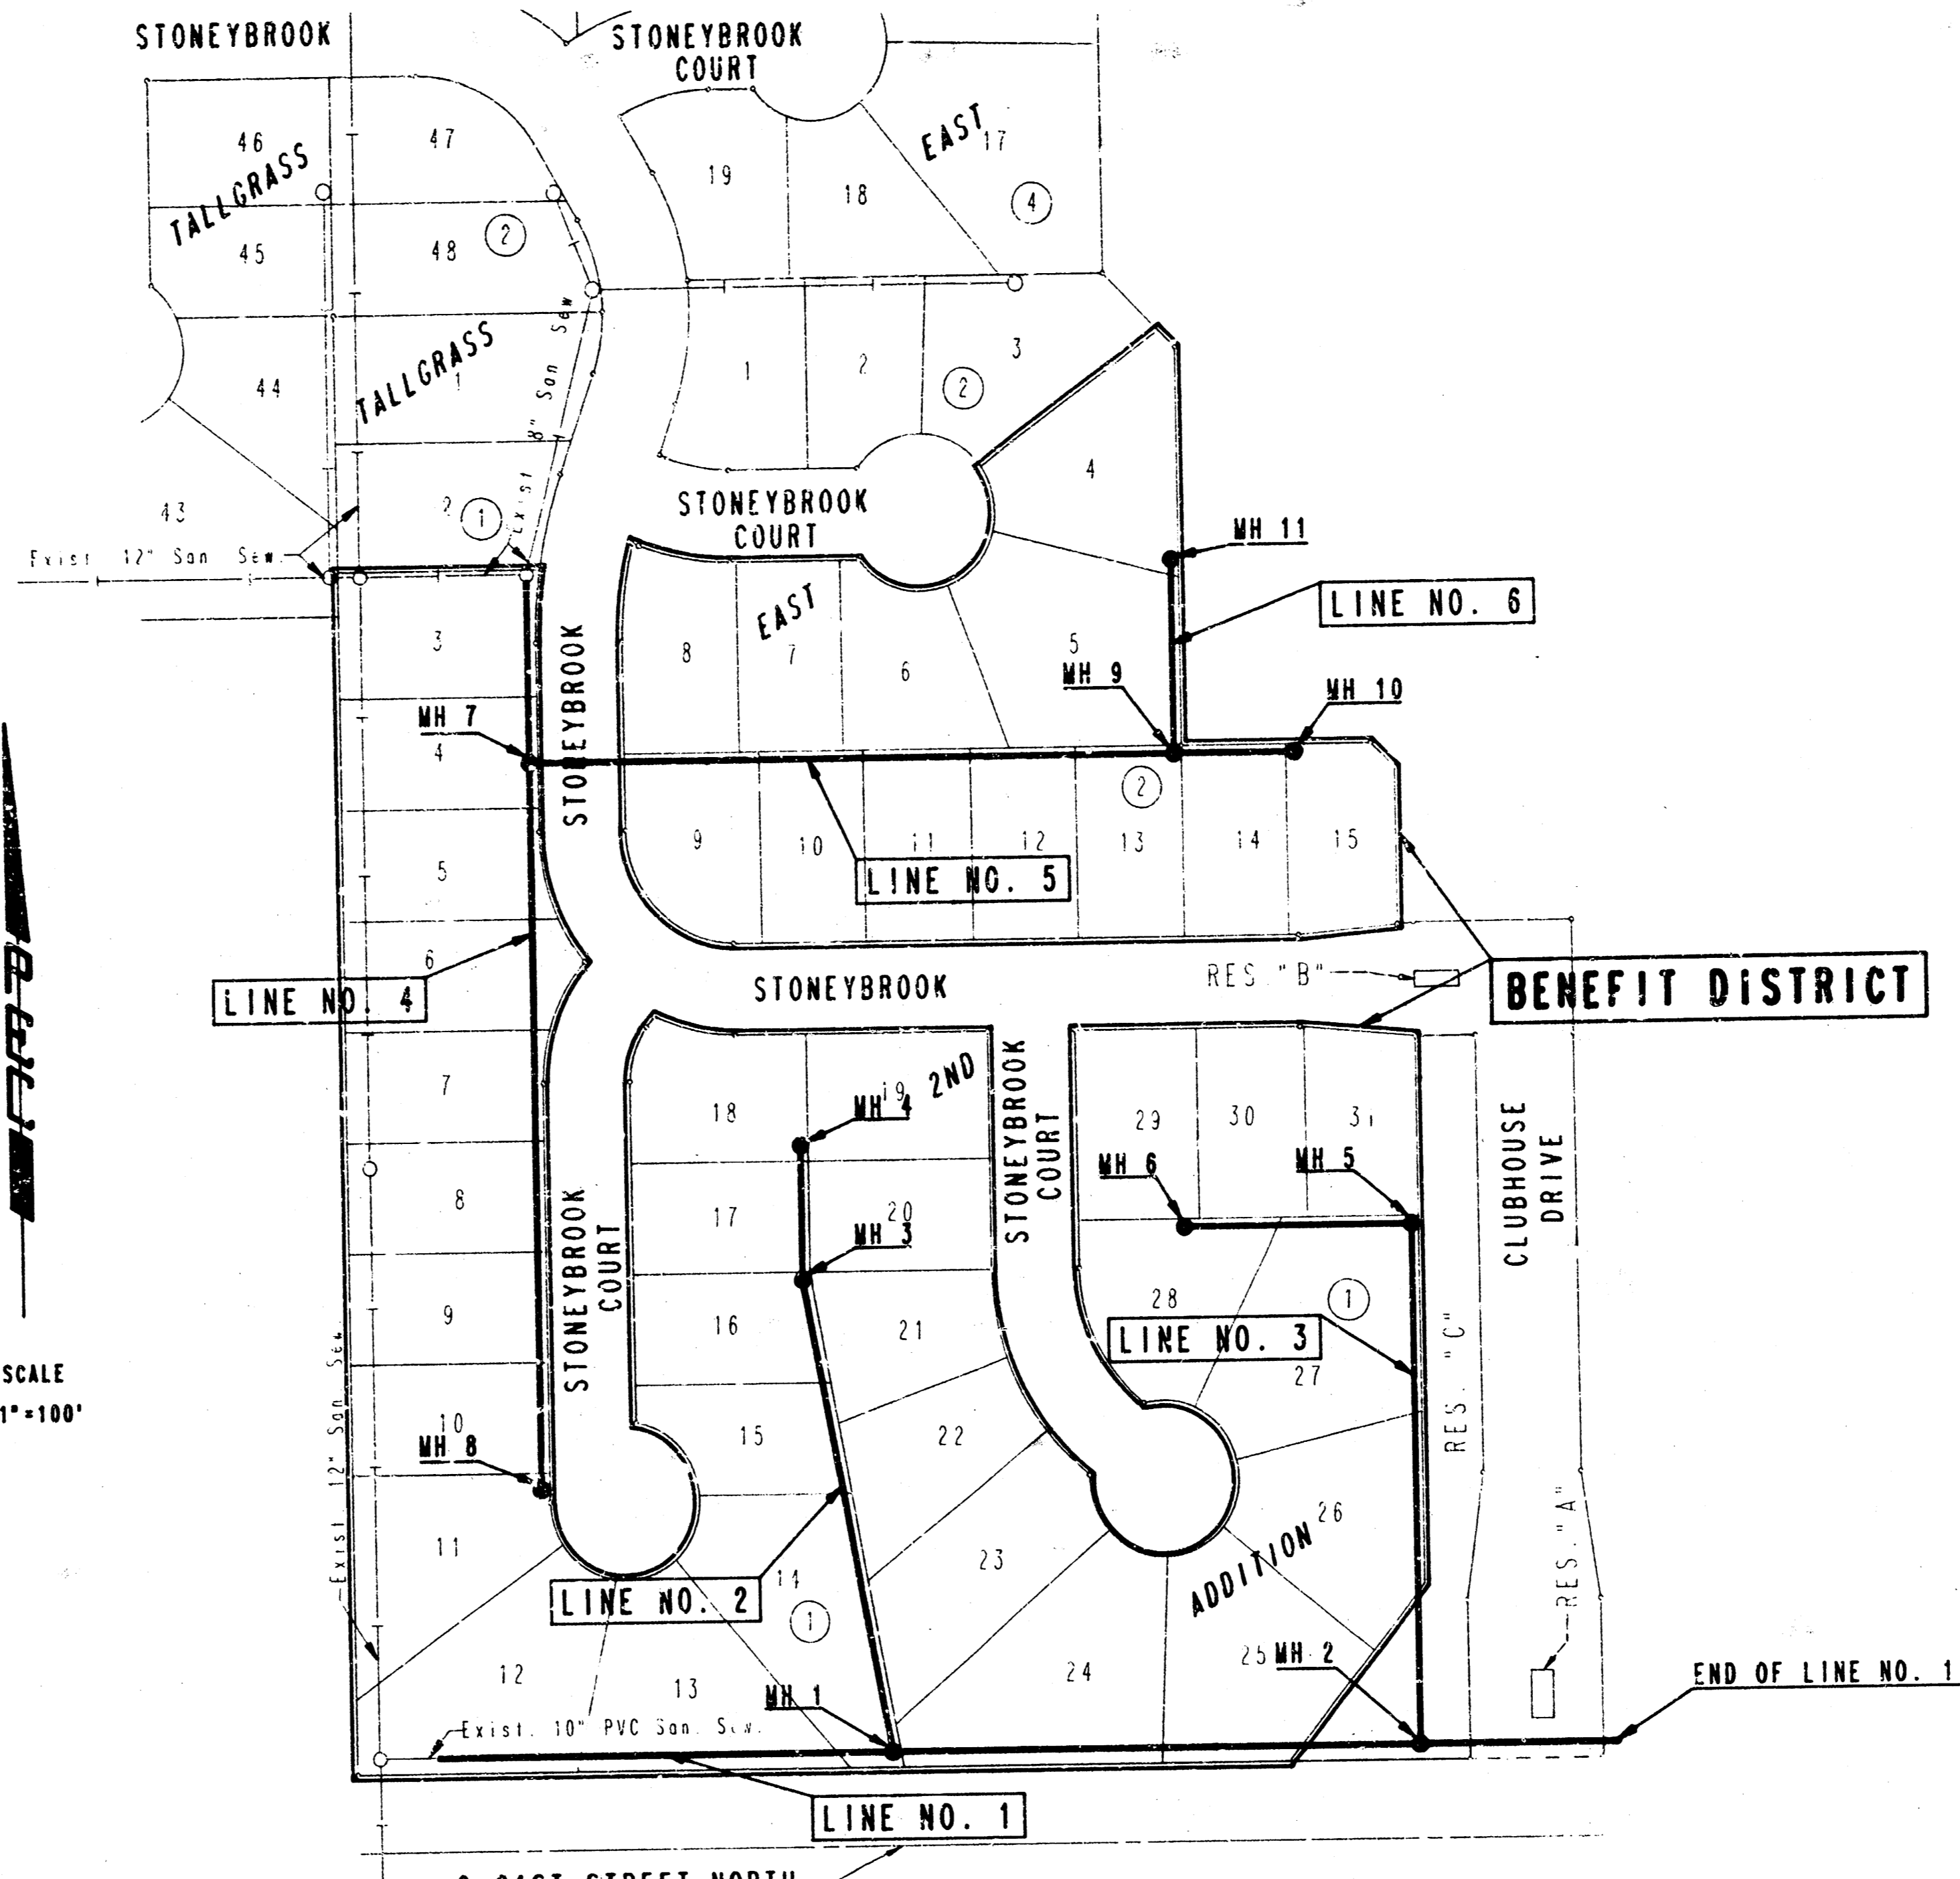


KEY MAP

- GENERAL NOTES**
- ALL CONSTRUCTION AND MATERIALS TO COMPLY WITH CITY OF WICHITA SPECIFICATIONS AND STANDARDS.
 - ALL ELEVATIONS SHOWN ARE CITY OF WICHITA DATUM (USGS-1187.4 = CITY DATUM).
 - THE CONTRACTOR SHALL LIMIT THE EXTENT OF TRENCH TO REMAIN OPEN OVERNIGHT AND WEEKENDS TO LESS THAN 50 FEET.
 - AT LEAST 48 HOURS PRIOR TO BEGINNING EXCAVATION, IF REQUIRED, (EXCLUDING WEEKENDS AND HOLIDAYS) THE CONTRACTOR SHALL CONTACT THE KANSAS ONE-CALL SYSTEM, A UTILITY LOCATION SERVICE AT (316) 687-2470 TO REQUEST THE FOLLOWING UTILITY COMPANIES TO LOCATE ANY EXISTING LINES WITHIN THE PROJECT AREA: KPL/GAS SERVICE COMPANY, K. G. & E., THE WICHITA WATER DEPARTMENT, AIR CAPITAL CABLEVISION, AND SOUTHWESTERN BELL TELEPHONE.
 - AT LEAST 48 HOURS PRIOR TO BEGINNING WORK, THE CONTRACTOR SHALL CONTACT MR. REX BROWN, AS NOTED BELOW, AND ADVISE HIM AS TO THE PROPOSED CONSTRUCTION SCHEDULE.
FARM AND INDUSTRIES
P.O. BOX 3516
BARTLESVILLE, OK 74006
MR. REX BROWN
(918)333-4111
 - UNDERGROUND UTILITY SERVICE LINES AND OVERHEAD UTILITY POLE LINES ARE TO BE ADJUSTED AS NECESSARY BY OTHERS PRIOR TO CONSTRUCTION UNLESS THE PLANS SPECIFICALLY CALL FOR THEIR ADJUSTMENT BY THE CONTRACTOR OR UNLESS THE PLANS SPECIFICALLY IDENTIFY A UTILITY TO BE ADJUSTED BY ITS OWNER DURING CONSTRUCTION. EXISTING UTILITIES AND THEIR LOCATION, AS SHOWN ON THE PLANS, REPRESENT THE BEST INFORMATION OBTAINABLE FOR DESIGN. THE CONTRACTOR WILL BE REQUIRED TO WORK AROUND EXISTING UTILITIES WITHIN THE RIGHT-OF-WAY WHICH DO NOT CONFLICT WITH PROPOSED CONSTRUCTION.
 - THE CONTRACTOR SHALL BE RESPONSIBLE FOR PRESERVING PROPERTY IRONS. THE CONTRACTOR SHALL BE REQUIRED TO RE-ESTABLISH ANY PROPERTY IRONS WHICH ARE DAMAGED OR DESTROYED BY HIS CONSTRUCTION OPERATIONS. SUCH IRONS SHALL BE RE-ESTABLISHED BY A LICENSED LAND SURVEYOR IN ACCORDANCE WITH STATE LAWS. ALL COSTS FOR THIS WORK SHALL BE SUBSIDIARY TO THE OTHER ITEMS OF WORK.
 - CONTRACTOR SHALL PROVIDE POSITIVE DRAINAGE AWAY FROM ALL MANHOLE COVERS.
 - CONTRACTOR SHALL GRADE THE SANITARY SEWER ALIGNMENT TO THE PROFILE AND ELEVATIONS SHOWN ON THE EASEMENT GRADING PLAN TO THE EXTENT THAT DIRT GENERATED BY THIS PROJECT WILL ALLOW. THE CONTRACTOR SHALL NOT BE REQUIRED TO FURNISH ADDITIONAL DIRT TO ACCOMPLISH THIS GRADING. ALL COSTS FOR GRADING SHALL BE SUBSIDIARY TO THE PROJECT.
 - UNLESS OTHERWISE SPECIFIED ON THE PLANS, MANHOLES MAY BE TYPE "M", "C", OR "D" MANHOLES. MANHOLES SHALL BE CONSTRUCTED IN ACCORDANCE WITH THE STANDARD SPECIFICATIONS AND THE STANDARD DETAIL DRAWINGS.

RISER LOCATION TABLE					
LINE NO.	STATION	TEE SADDLE LOCATION		DIRECTION	RISER PIPE (I.F.)
		BLOCK NO.	LOT NO.		
1	0+80	1	12	Left	6.0
2	1+45	1	13	Left	7.0
3	0+45	1	25	Left	9.5
4	0+48+13	1	3	Right	8.0
5	0+50	1	4	Right	5.5
6	1+00	1	5	Right	4.5
7	2+25	1	6	Right	3.5
8	2+25	1	7	Right	3.0
9	3+65	1	8	Right	2.5
10	3+10	2	12	Right	3.0
11	3+35	2	5	Left	3.0
12	3+20	2	13	Right	3.5

*10"x4" tee saddles
All other tee saddles are 8"x4"

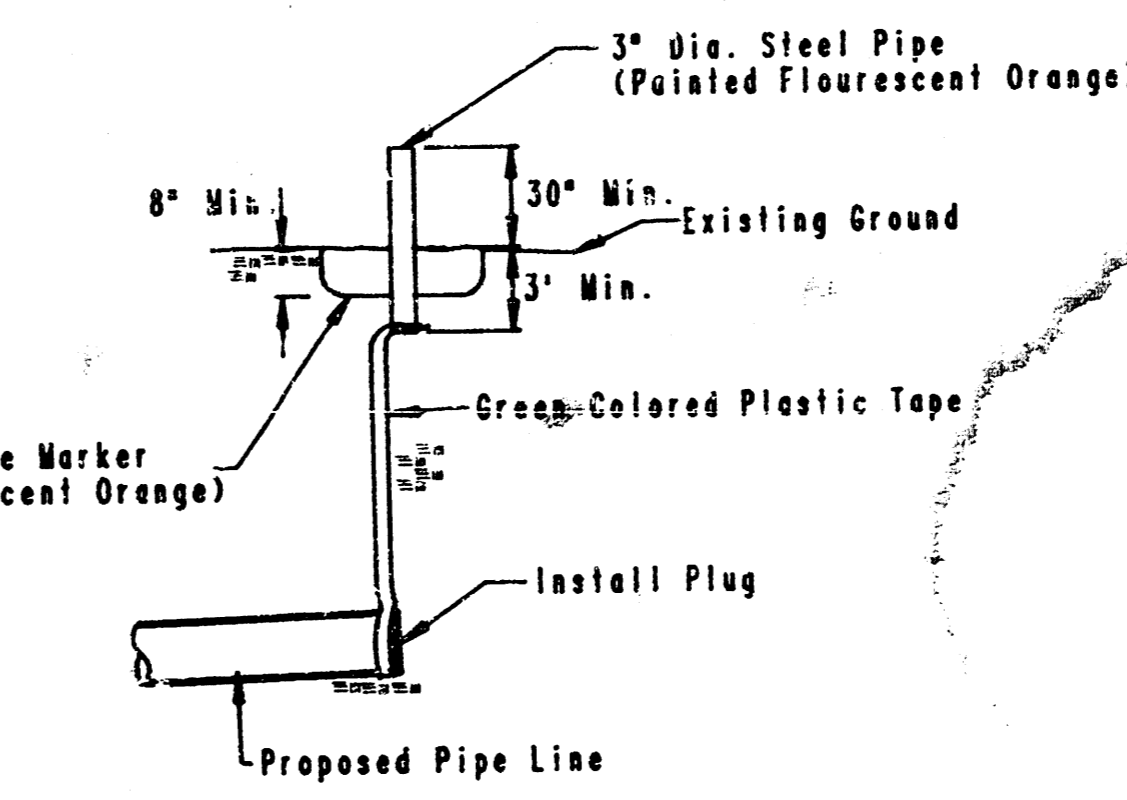

BURIED PIPE PLUG & FLAG DETAIL
(STAKING & PLUGGING SHALL BE SUBSIDIARY TO THE PIPE LINE INSTALLATION)



No.	Revision	By	Date

LATERAL 12, MAIN 24 OF THE WAR INDUSTRIES SEWER

KEY MAP and EASEMENT GRADING

MICHAEL E. LINDEBAK, P.E. - CITY ENGINEER
CITY OF WICHITA PROJECT NO. 488-76-245-81806-000-001

PROFESSIONAL ENGINEERING CONSULTANTS, P.A.
ENGINEERS
WICHITA, KANSAS

Designed by WDS,CRY Job No. 34-88189-1
Drawn by TRV, GLM Date APRIL, 1988

FILMED FROM THE BEST AVAILABLE COPY

TALLGRASS EAST 2ND ADDITION TO WICHITA, SEDGWICK COUNTY, KANSAS



STATE OF KANSAS }
COUNTY OF SEDGWICK } SS

I, R. W. LIND, a PROFESSIONAL ENGINEER in aforesaid STATE and COUNTY, DO HEREBY CERTIFY THAT ON THIS 30th DAY OF December 1987, I HAVE BEEN IN RESPONSIBLE CHARGE OF SURVEYING AND PLATTING OF TALLGRASS EAST 2ND ADDITION TO WICHITA, SEDGWICK COUNTY, KANSAS, 1875 LOTS, BLOCKS, AND RESERVES, THE SAME BEING A TRACT OF LAND IN THE SW 1/4 OF SECTION 4, TOWNSHIP 27 SOUTH, RANGE 2 EAST OF THE 6TH P.M.; AND DESCRIBED AS: COMMENCING AT THE SE CORNER OF THE SW 1/4 OF SAID SECTION 4; THENCE BEARING S89°13'35"W ALONG THE SOUTH LINE OF SAID SECTION 4 A DISTANCE OF 614.77 FEET; THENCE BEARING N1°10'25"W A DISTANCE OF 40.00 FEET TO THE POINT OF BEGINNING; THENCE BEARING S89°49'35"E PARALLEL TO AND 40.00 FEET NORTH OF THE SOUTH LINE OF SAID SECTION 4 A DISTANCE OF 828.35 FEET; THENCE BEARING N1°10'25"W A DISTANCE OF 930.00 FEET TO THE SW CORNER OF LOT 28, BLOCK 2, IN TALLGRASS EAST; THENCE BEARING N89°49'35"E ALONG THE SOUTH LINE OF SAID LOT 28 A DISTANCE OF 178.59 FEET; THENCE BEARING N10°33'51"E A DISTANCE OF 40.04 FEET TO THE SW CORNER OF LOT 19, BLOCK 4, IN SAID TALLGRASS EAST; THENCE BEARING N89°49'35"E ALONG THE SOUTH LINE OF LOTS 19, 20 AND 17, BLOCK 4, IN SAID TALLGRASS EAST A DISTANCE OF 276.74 FEET TO THE SE CORNER OF SAID LOT 17; THENCE BEARING S49°10'25"E A DISTANCE OF 68.47 FEET; THENCE BEARING S1°10'25"E A DISTANCE OF 251.00 FEET; THENCE BEARING N89°49'35"E A DISTANCE OF 125.00 FEET; THENCE BEARING S49°10'25"E A DISTANCE OF 27.00 FEET; THENCE BEARING S1°10'25"E A DISTANCE OF 89.03 FEET; THENCE BEARING N83°29'40"E A DISTANCE OF 11.03 FEET; THENCE BEARING N89°49'35"E A DISTANCE OF 106.00 FEET; THENCE BEARING S1°10'25"E A DISTANCE OF 347.02 FEET; THENCE BEARING S89°49'35"E A DISTANCE OF 80.00 FEET; THENCE BEARING S1°10'25"E A DISTANCE OF 110.00 FEET TO THE POINT OF BEGINNING.

R. W. LIND
P. E. #3884, R. L. S. #834
PROFESSIONAL ENGINEERING CONSULTANTS, P.A.



KNOW ALL MEN BY THESE PRESENTS THAT WE, THE UNDERSIGNED PROPERTY OWNERS OF THE LAND, AS ABOVE SET FORTH IN THE ENGINEER'S CERTIFICATE, HAVE CAUSED THE LAND TO BE SURVEYED AND PLATTED INTO LOTS, BLOCKS, STREETS, AND RESERVES, THE SAME TO BE KNOWN AS TALLGRASS EAST 2ND ADDITION TO WICHITA, SEDGWICK COUNTY, KANSAS. EASEMENTS, AS INDICATED FOR THE CONSTRUCTION AND MAINTENANCE OF PUBLIC UTILITIES, AND DRAINAGE ARE HEREBY GRANTED.

RESERVES A AND B ARE HEREBY RESERVED FOR ENTRY FEATURES, LANDSCAPING AND IRRIGATION SYSTEMS. RESERVE C IS ALSO RESERVED FOR UTILITIES CONFINED WITHIN EASEMENTS. RESERVE D IS HEREBY RESERVED FOR DRAINAGE, ENTRY MONUMENTS, LANDSCAPING, IRRIGATION, SIDEWALKS AND UTILITIES CONFINED WITHIN EASEMENTS. THE FIVE-FOOT WALL EASEMENT, AS SHOWN IS HEREBY PLATTED FOR THE CONSTRUCTION AND MAINTENANCE OF A PRIVATE WALL. UTILITIES MAY CROSS THE WALL EASEMENT.


ALL RESERVES SHALL BE SUBJECT TO RESTRICTIVE COVENANTS ESTABLISHED BY THE DECLARATION OF LANDOWNERS' ASSOCIATION AGREEMENTS AND SHALL BE OWNED AND MAINTAINED BY THE ONE OR MORE HOMEOWNERS' ASSOCIATIONS TO BE FORMED WITHIN TALLGRASS EAST 2ND ADDITION. THE STREETS ARE HEREBY DEDICATED TO AND FOR THE USE OF THE PUBLIC. ALL ADJUTERS' RIGHTS OF ACCESS TO AND FROM 21ST STREET NORTH OVER AND ACROSS THE SOUTH LINE OF BLOCK 1 AS SHOWN, IS HEREBY GRANTED TO THE CITY OF WICHITA. THAT PORTION OF THE SANITARY SEWER EASEMENTS AS RECORDED ON FILM 843, PAGE 859, AND FILM 866, PAGE 990, TOGETHER WITH THE DRAINAGE EASEMENTS RECORDED ON FILM 866, PAGE 1006, FILM 868, PAGE 1007, AND FILM 879, PAGE 336, WITHIN THE ABOVE DESCRIBED TRACT ARE HEREBY VACATED AND REPLATTED BY VIRTUE OF K.S.A. 12-512(b) AMENDED.

OWNER: SLANSON INVESTMENT CORPORATION
Larry A. Chambers, VICE PRESIDENT

STATE OF KANSAS }
COUNTY OF SEDGWICK } SS

BE IT REMEMBERED THAT ON THIS 9th DAY OF January, 1988, BEFORE ME, A NOTARY PUBLIC in aforesaid STATE and COUNTY, CAME LARRY A. CHAMBERS, VICE PRESIDENT OF SLANSON INVESTMENT CORPORATION, TO ME PERSONALLY KNOWN TO BE THE SAME PERSON WHO EXECUTED THE FOREGOING INSTRUMENT OF WRITING AND FULLY ACKNOWLEDGE THE EXECUTION OF SAME FOR AND ON BEHALF OF SAID VOLUNTARY ACT AND DEED OF SAID TRUST. IN TESTIMONY WHEREOF I HAVE HERETO SET MY HAND AND AFFIXED MY NOTARIAL SEAL THE DAY AND YEAR ABOVE WRITTEN.

Linda A. Graham, NOTARY PUBLIC
MY COMMISSION EXPIRES 2/9/88

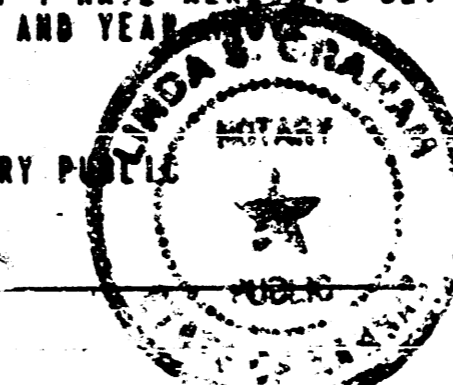

BE, THE MELLOW BANK, N.A., PITTSBURGH, PA. HOLDER OF A MORTGAGE ON THE ABOVE DESCRIBED PROPERTY, DO HEREBY CONSENT TO THE PLATTING OF TALLGRASS EAST 2ND ADDITION TO WICHITA, SEDGWICK COUNTY, KANSAS.
Martha Lia Frost, ASSISTANT VICE PRESIDENT

STATE OF PENNSYLVANIA }
COUNTY OF ALLEGHENY } SS

BE IT REMEMBERED THAT ON THIS 11th DAY OF January, 1987, BEFORE ME, A NOTARY PUBLIC in aforesaid STATE and COUNTY, CAME Martha Lia Frost OF THE MELLOW BANK, N.A., PITTSBURGH, PA. TO ME PERSONALLY KNOWN TO BE THE SAME PERSON WHO EXECUTED THE FOREGOING INSTRUMENT OF WRITING AND FULLY ACKNOWLEDGE THE EXECUTION OF SAME FOR AND ON BEHALF OF SAID VOLUNTARY ACT AND DEED OF SAID BANK. IN TESTIMONY WHEREOF I HAVE HERETO SET MY HAND AND AFFIXED MY NOTARIAL SEAL THE DAY AND YEAR ABOVE WRITTEN.
Jill Novorolsky, NOTARY PUBLIC
MY COMMISSION EXPIRES 6-10-1991

THIS PLAT HAS BEEN SUBMITTED TO AND APPROVED BY THE WICHITA-SEDGWICK COUNTY METROPOLITAN AREA PLANNING COMMISSION, WICHITA, KANSAS, DATED THIS 25th DAY OF December, 1987.

Edson Parsons, CHAIRMAN
Marvin S. Kroot, SECRETARY


THIS PLAT APPROVED AND ALL DEDICATIONS SHOWN HEREON ARE ACCEPTED BY THE CITY COUNCIL OF THE CITY OF WICHITA, KANSAS, DATED THIS 24th DAY OF January, 1988.

Robert C. Knorr, MAYOR
Dale E. Rea, DEPUTY CITY CLERK

Entered on transfer record this 28 DAY OF March, 1988.
Don Wright, COUNTY CLERK

THIS IS TO CERTIFY THAT THIS INSTRUMENT WAS FILED FOR RECORD IN THE REGISTER OF DEEDS OFFICE AT 9:30 A.M. ON THIS 27th DAY OF MARCH, 1988.

Pat Kettler, REGISTER OF DEEDS
Ed Rea, DEPUTY

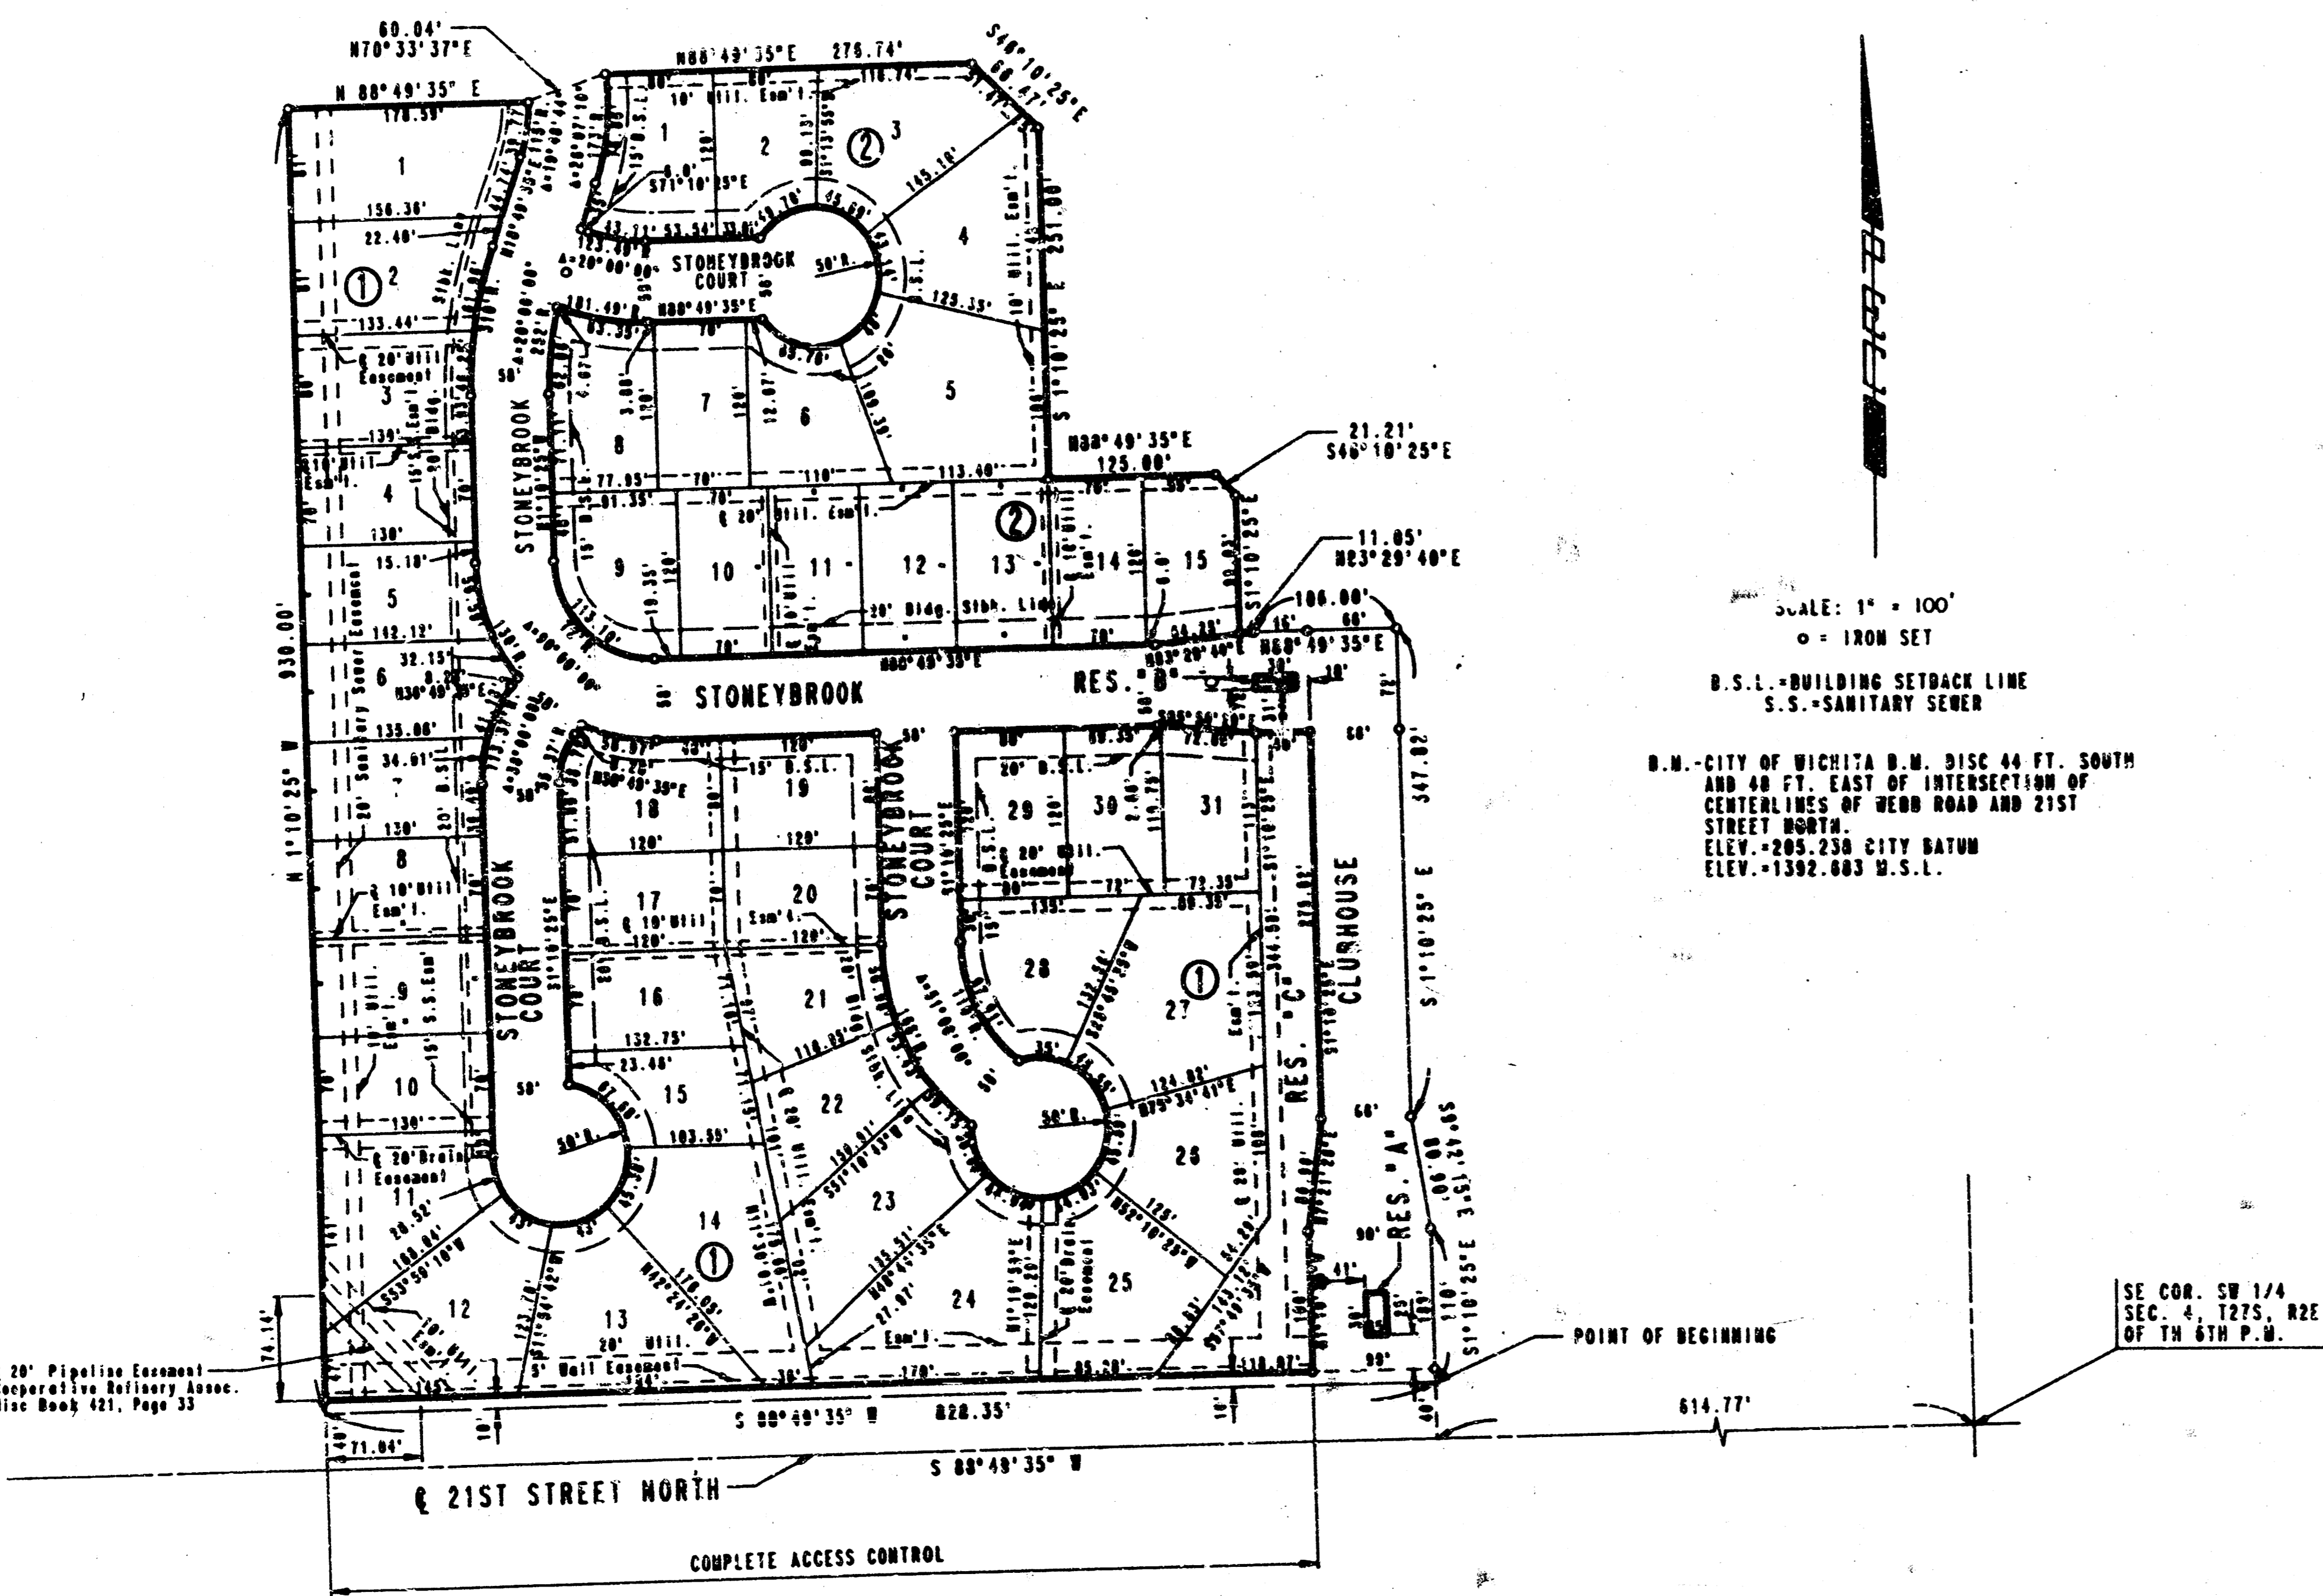

SCALE: 1" = 100'
O = IRON SET

D.S.L. - BUILDING SETBACK LINE
S.S. - SANITARY SEWER

D.M. - CITY OF WICHITA D.M. DISC 44 FT. SOUTH AND 40 FT. EAST OF INTERSECTION OF CENTERLINES OF REAR ROAD AND 21ST STREET NORTH
ELEV. - 205.238 CITY DATUM
ELEV. - 1392.683 U.S.L.


SE COR. SW 1/4 SEC. 4, T27S, R2E OF TH 6TH P.M.

26.00

Revised from F 949 of 1248
F 949 of 1249

Sh. 3 of 12



Feb 13, 1988 Tallgrass East 2 SS PPI

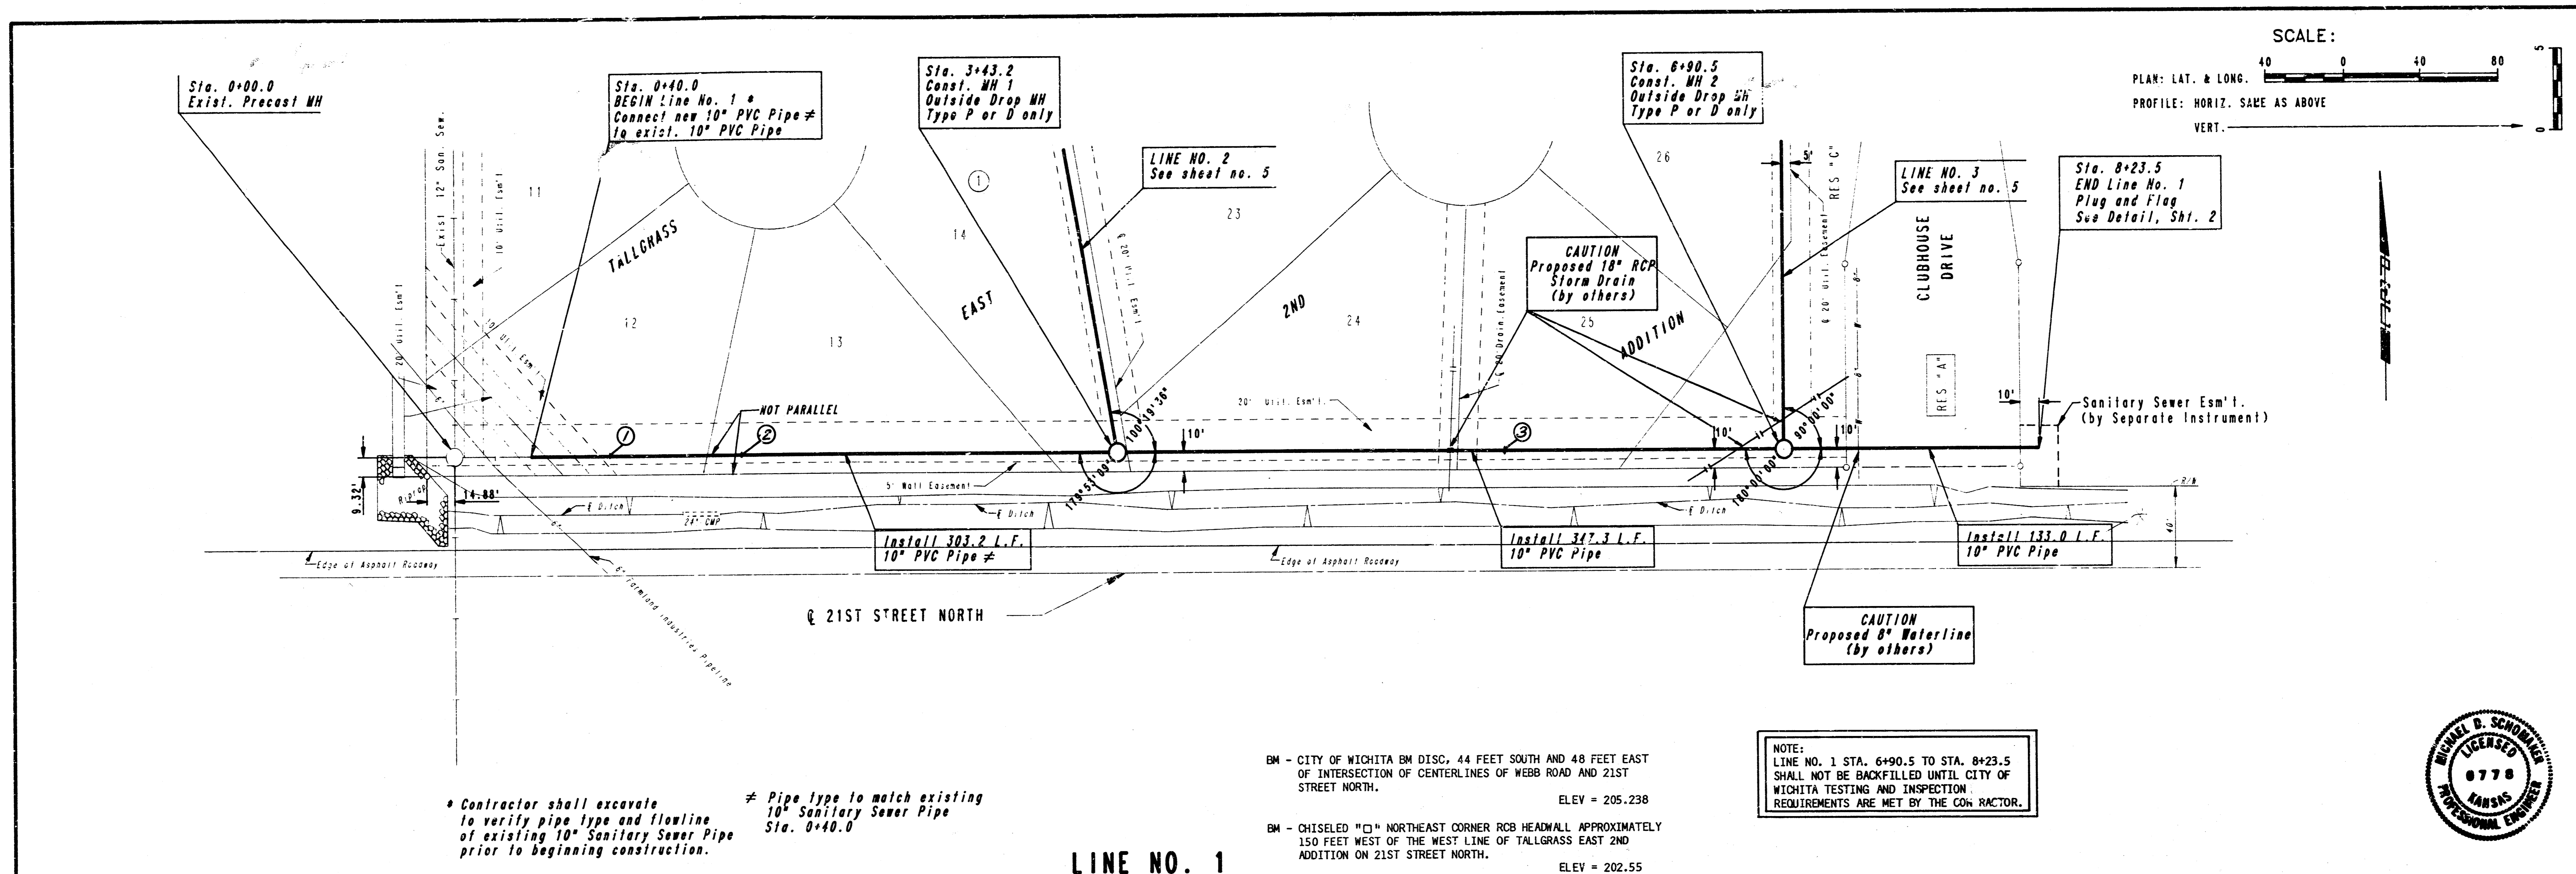

* Contractor shall excavate to verify pipe type and flowline of existing 10" Sanitary Sewer Pipe prior to beginning construction.

* Pipe type to match existing 10" Sanitary Sewer Pipe Sta. 0+40.0

LINE NO. 1

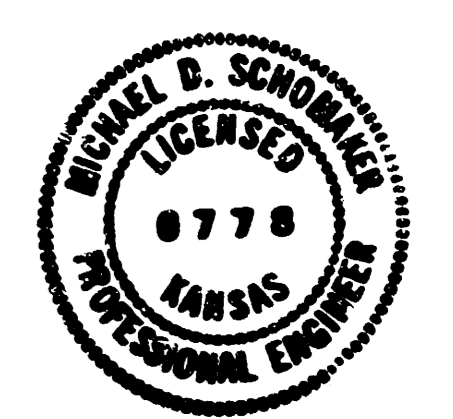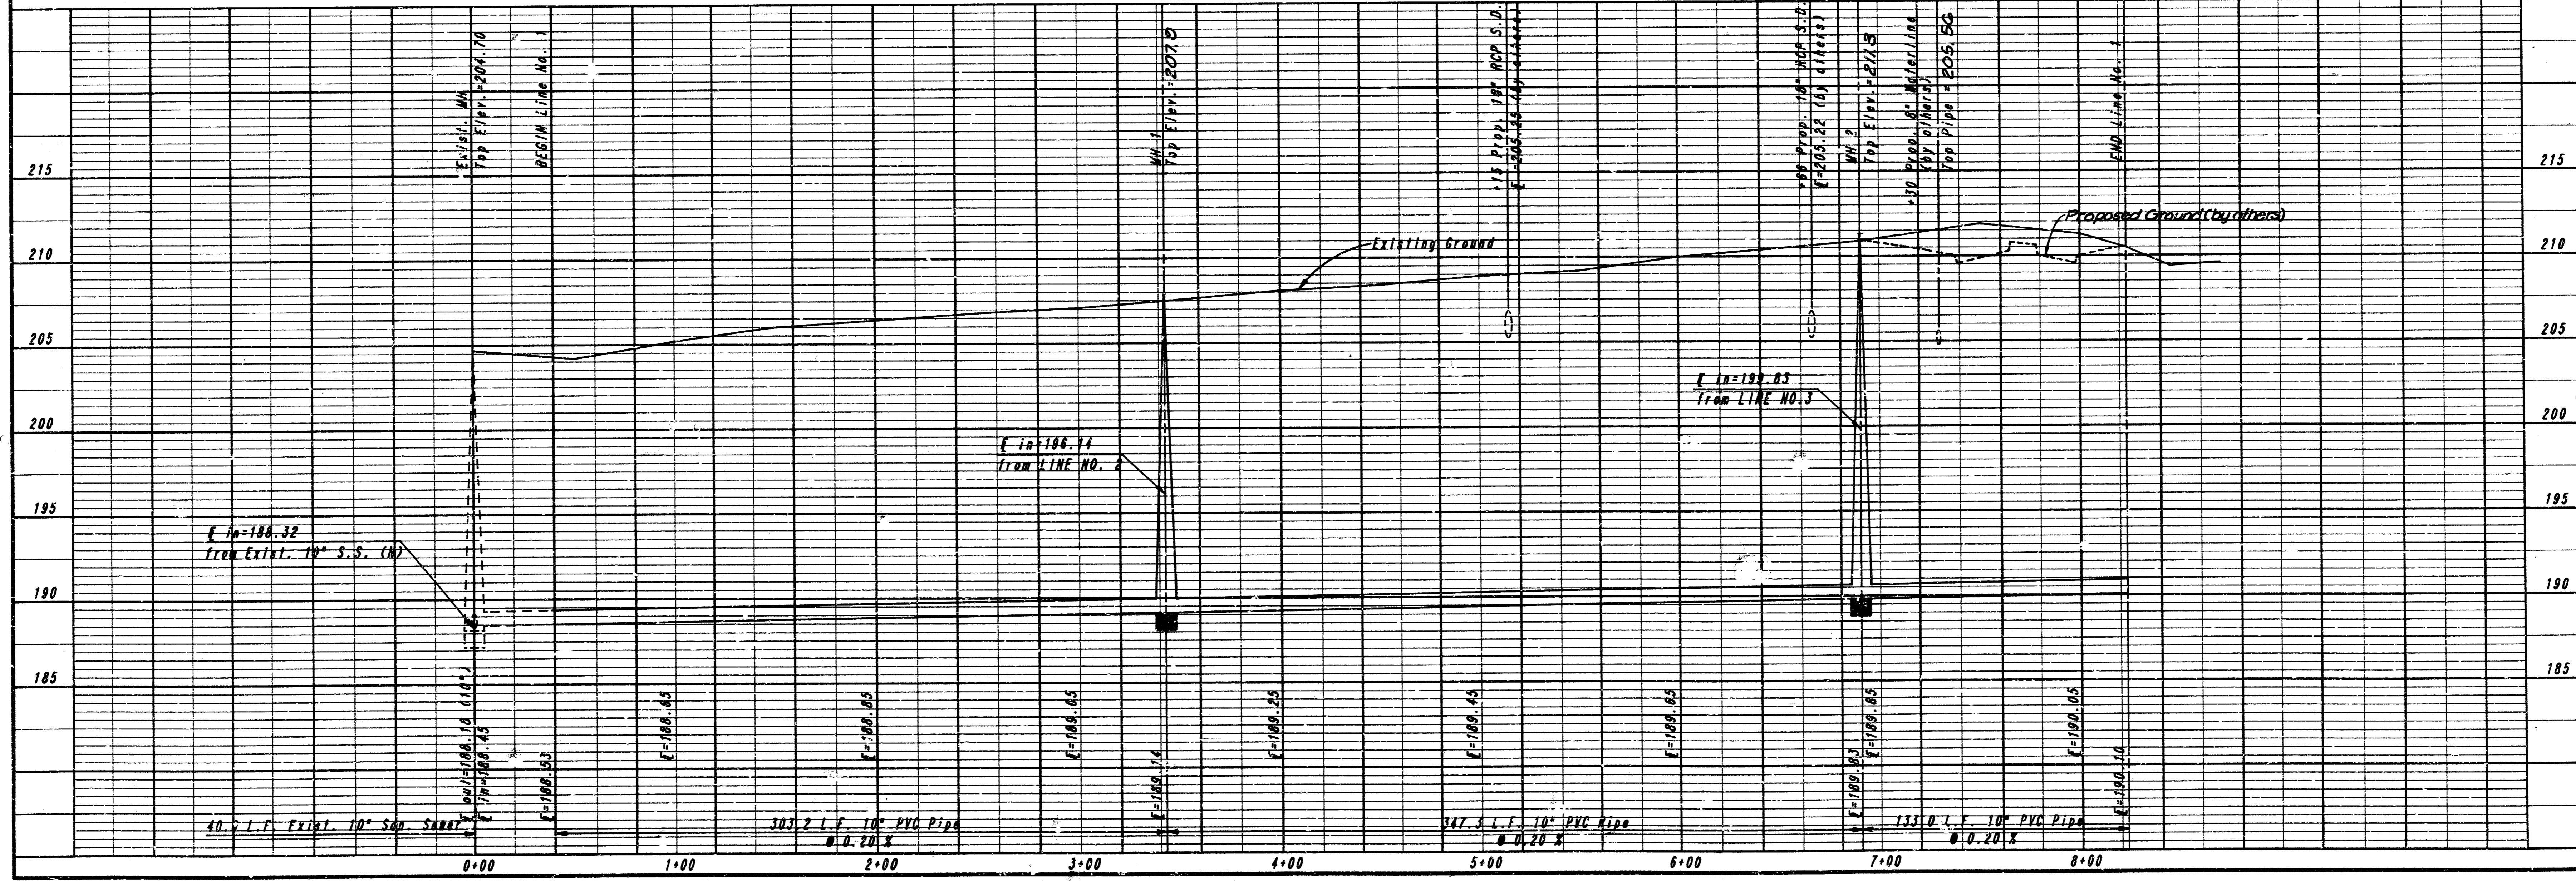

LATERAL 12, MAIN 24 OF THE
WAR INDUSTRIES SEWER

LINE NO. 1

PROFESSIONAL ENGINEERING CONSULTANTS, P.A.
ENGINEERS
WICHITA, KANSAS



Job No. 34-88189-1
Designed By: MDS, CRY
Drawn By: TW, G.M

MICHAEL E. LINDBAK, P.E. - CITY ENGINEER
CITY OF WICHITA PROJECT NO. 488-76-245-01888-000-000-001

Date: APRIL, 1988

Sheet 4 of 12


FILMED FROM THE BEST AVAILABLE COPY

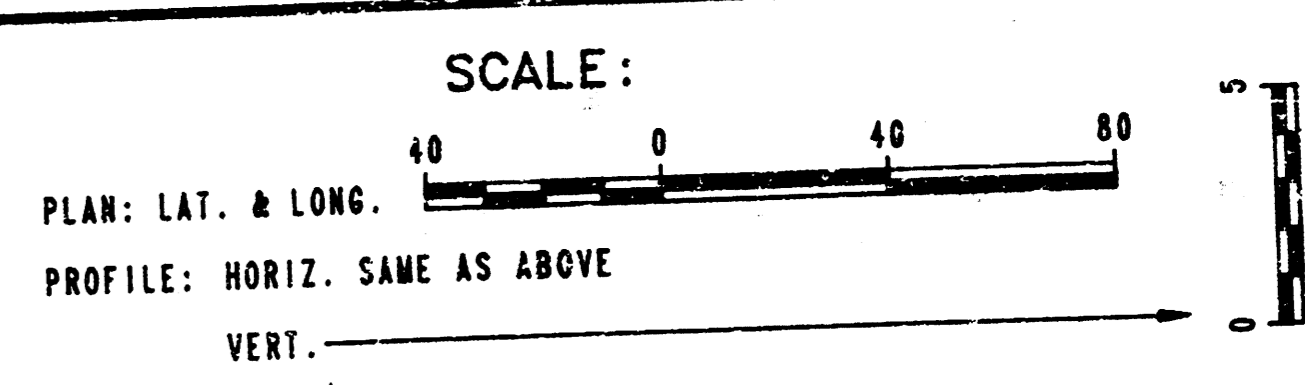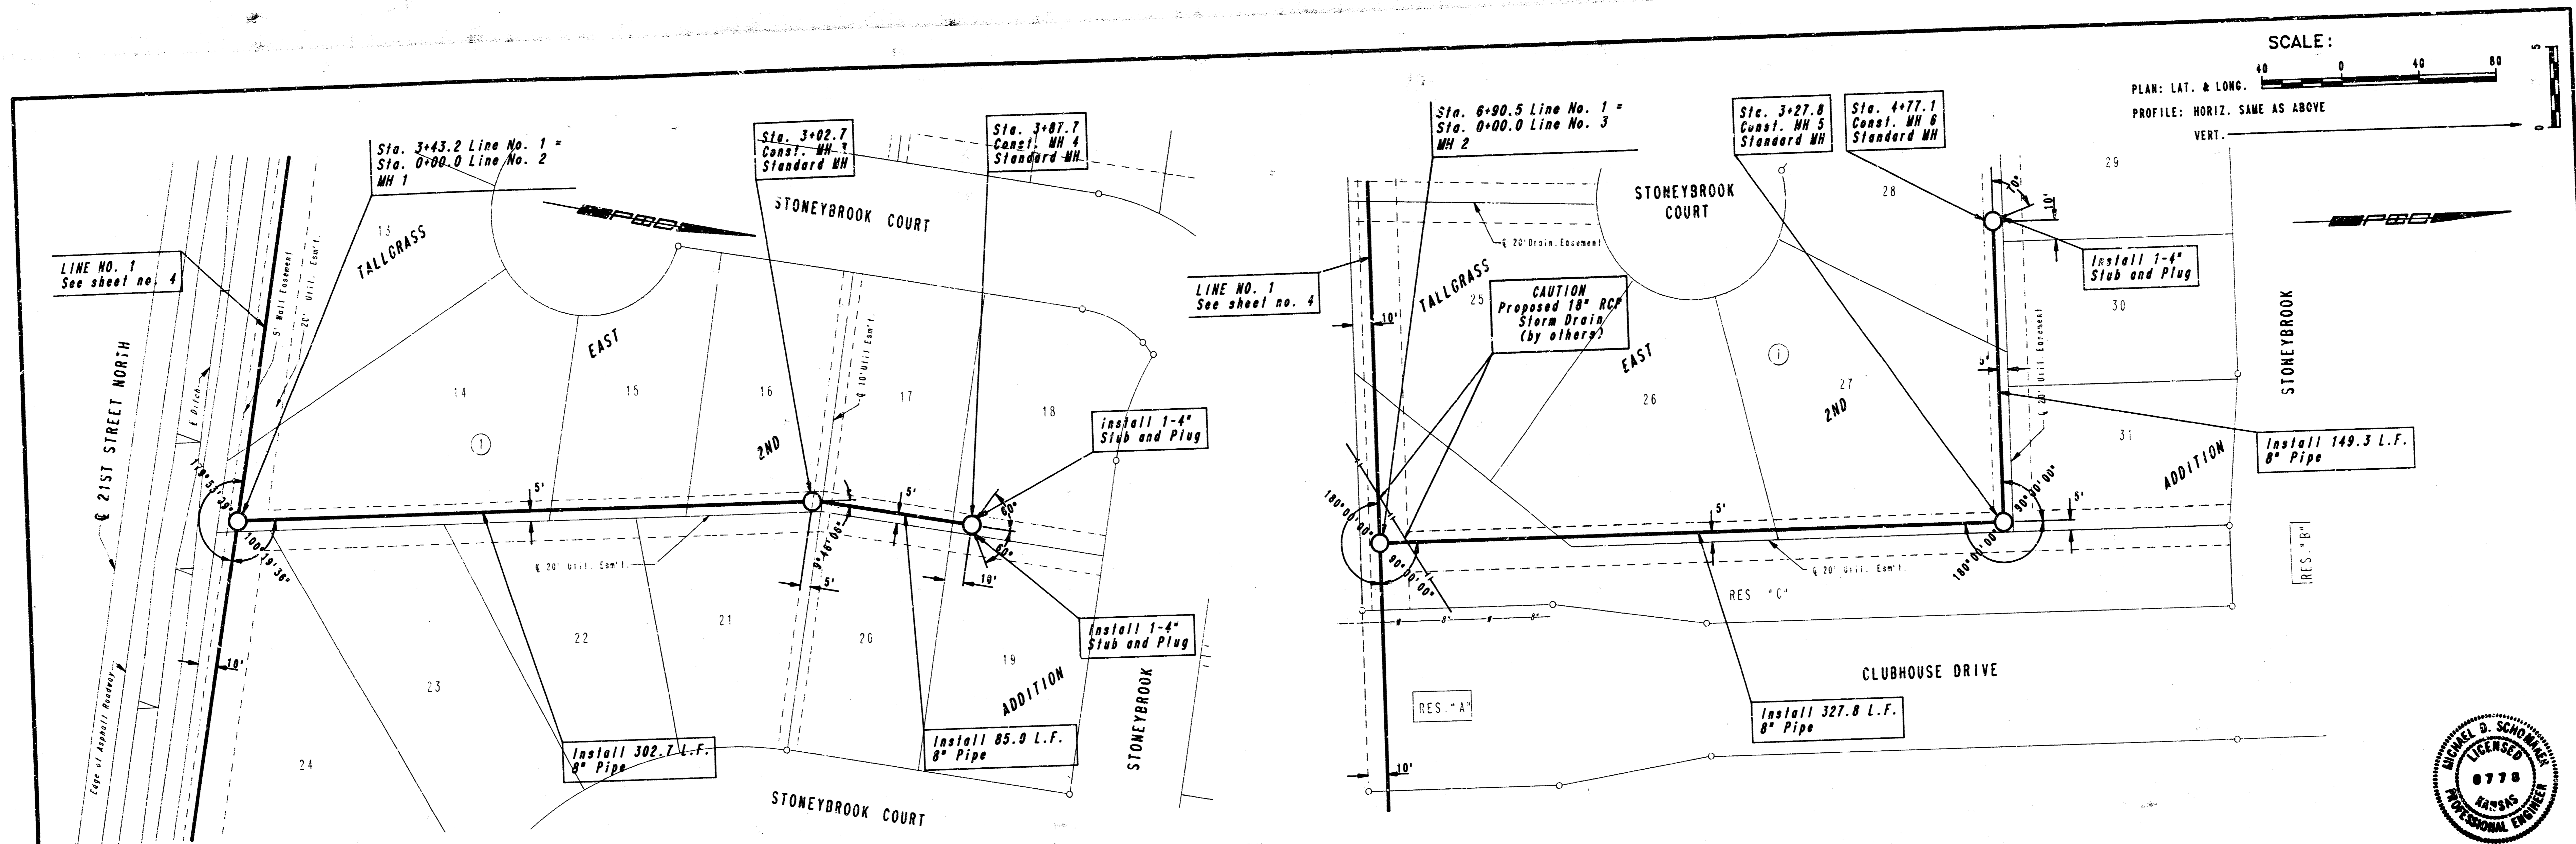

LINE NO. 2

LINE NO. 3



BM - CHISELED "C" NORTHEAST CORNER RCB HEADWALL APPROXIMATELY 150 FEET WEST OF THE WEST LINE OF TALLGRASS EAST 2ND ADDITION ON 21ST STREET NORTH. ELEV = 202.55

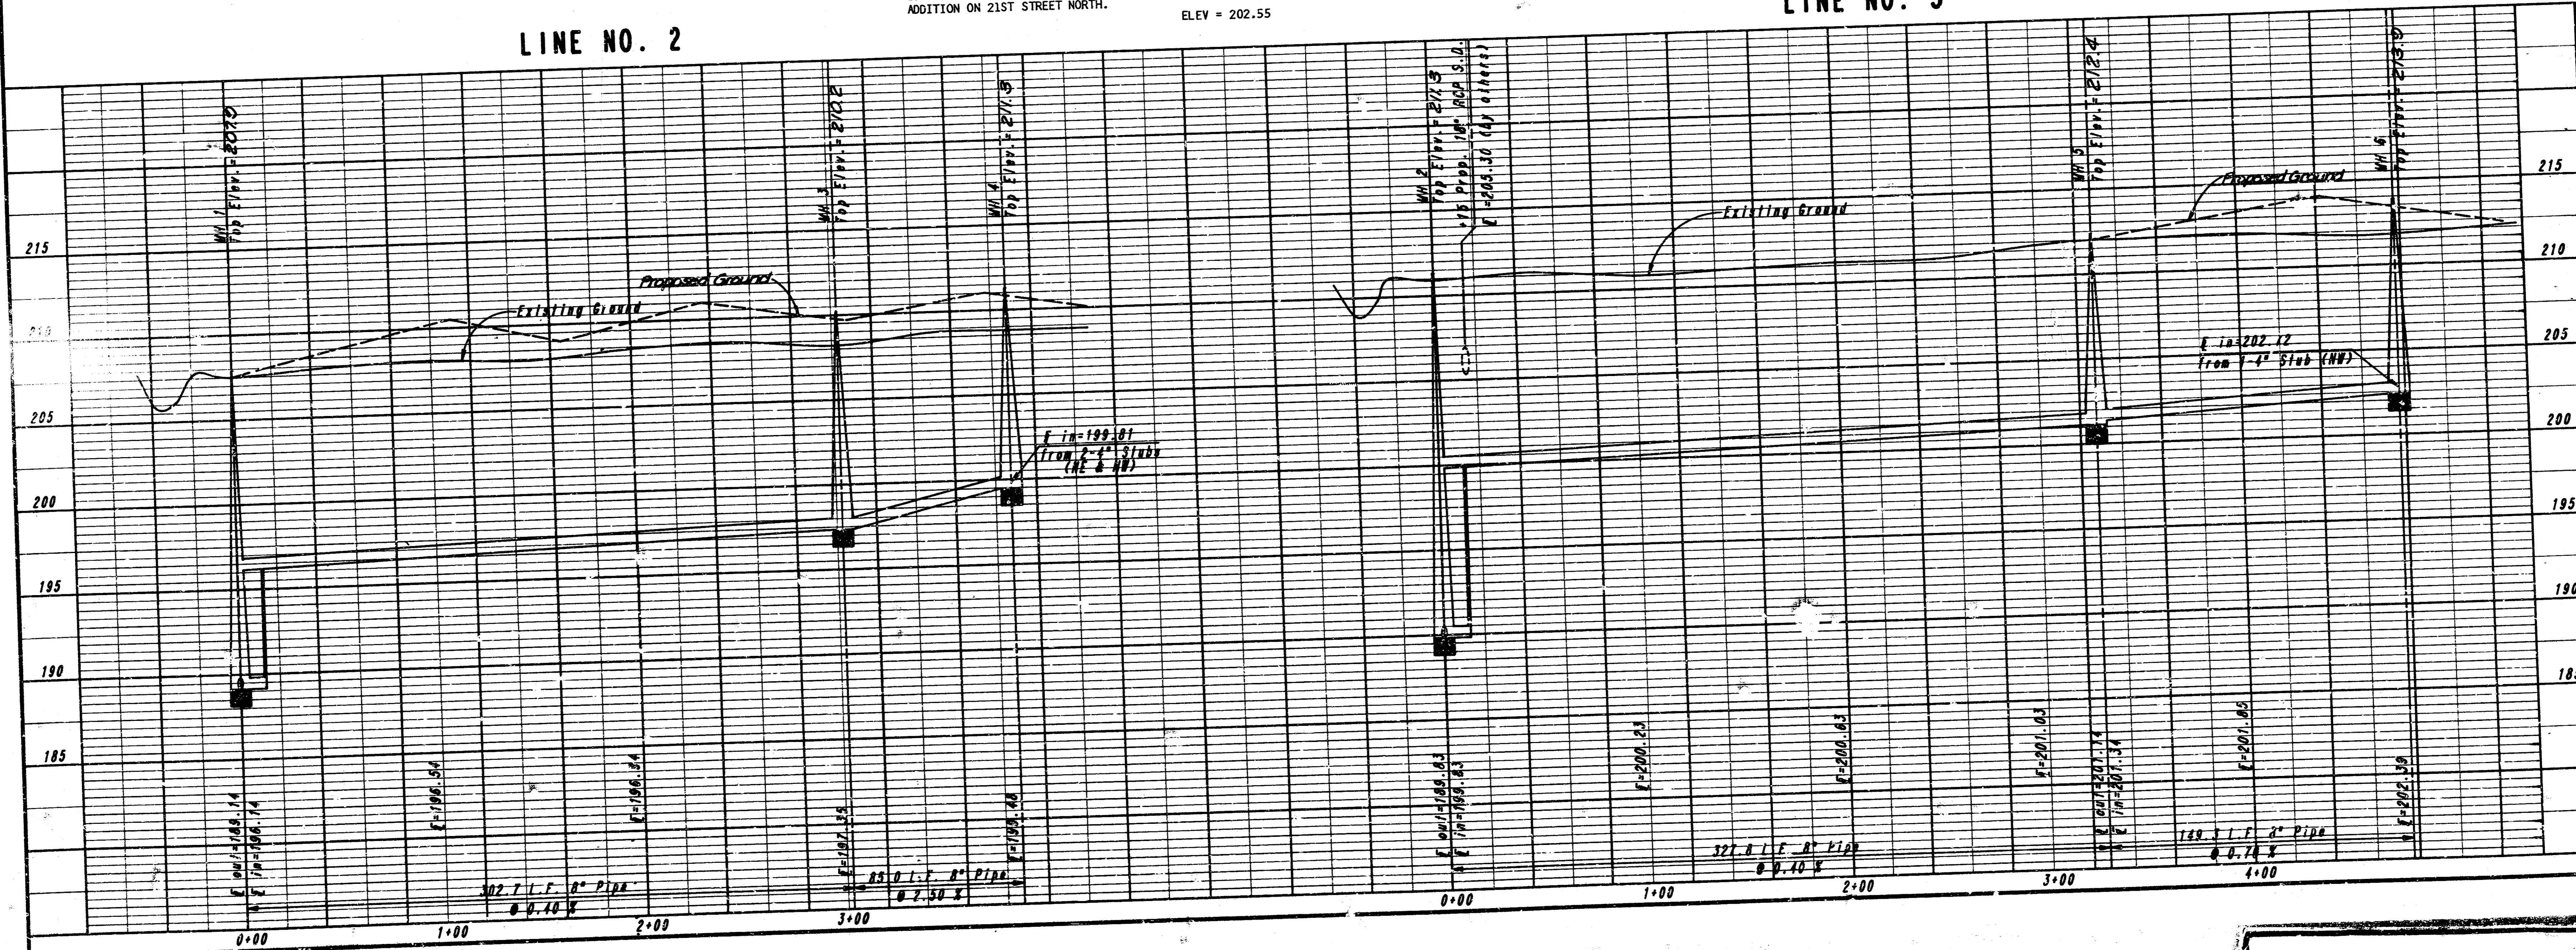

LINES NO. 2 and 3
 LATERAL 12, MAIN 24 OF THE
 WAR INDUSTRIES SEWER
 MICHAEL E. LINDEMAN, P.E. - CITY ENGINEER
 CITY OF WICHITA PROJECT NO. 448-76-245-5100A-000-001-001
 PROFESSIONAL ENGINEERING CONSULTANTS, P.A.
 WICHITA, KANSAS
 Designed By: MDS:CRJ Job No. 34-88189-1
 Drawn By: TWJ,GLM Date: APRIL, 1988
 Sheet 5 of 12


FILMED FROM THE BEST AVAILABLE COPY

Feb 13, 1989 Tallgrass East 2 SS PPG

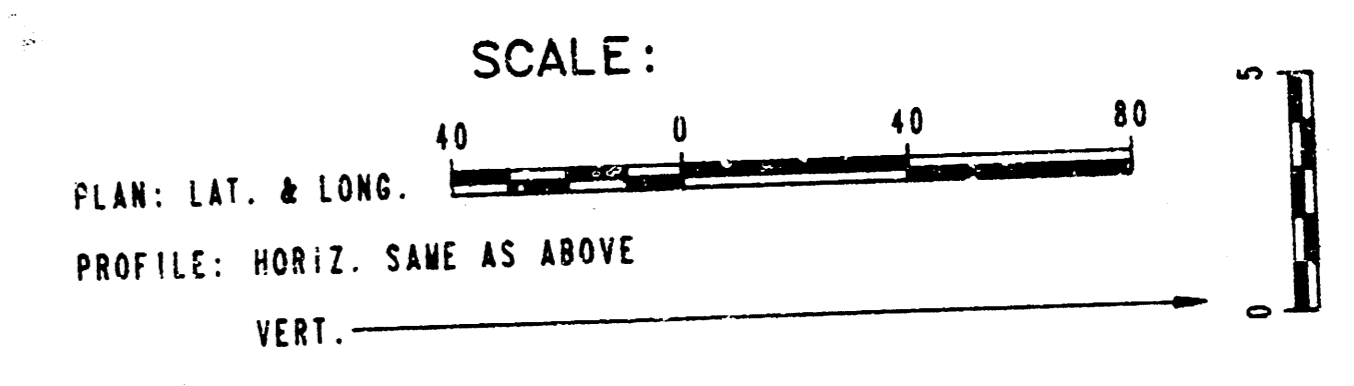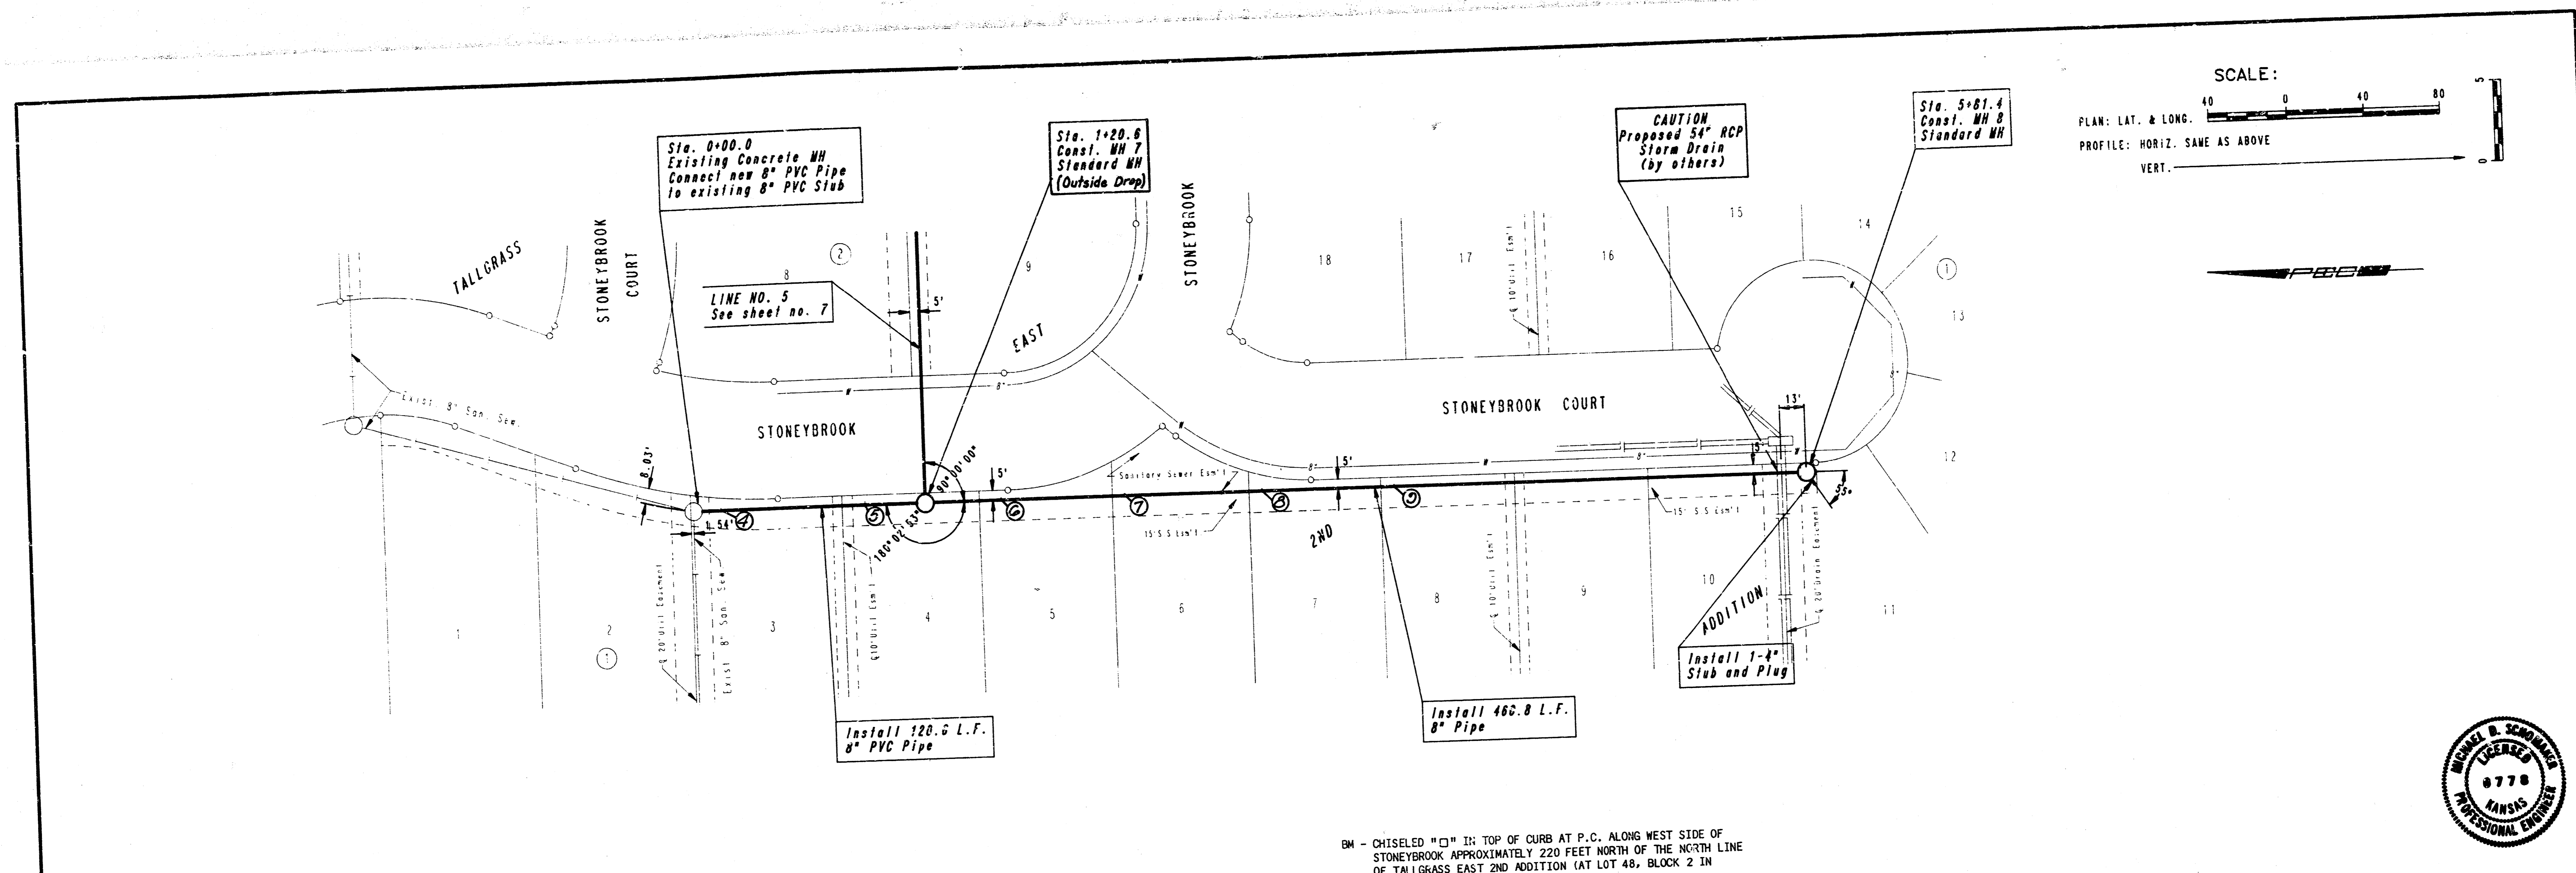

BM - CHISELED "□" IN TOP OF CURB AT P.C. ALONG WEST SIDE OF STONEYBROOK APPROXIMATELY 220 FEET NORTH OF THE NORTH LINE OF TALLGRASS EAST 2ND ADDITION (AT LOT 48, BLOCK 2 IN TALLGRASS EAST ADDITION).
ELEV = 209.55


LINE NO. 4

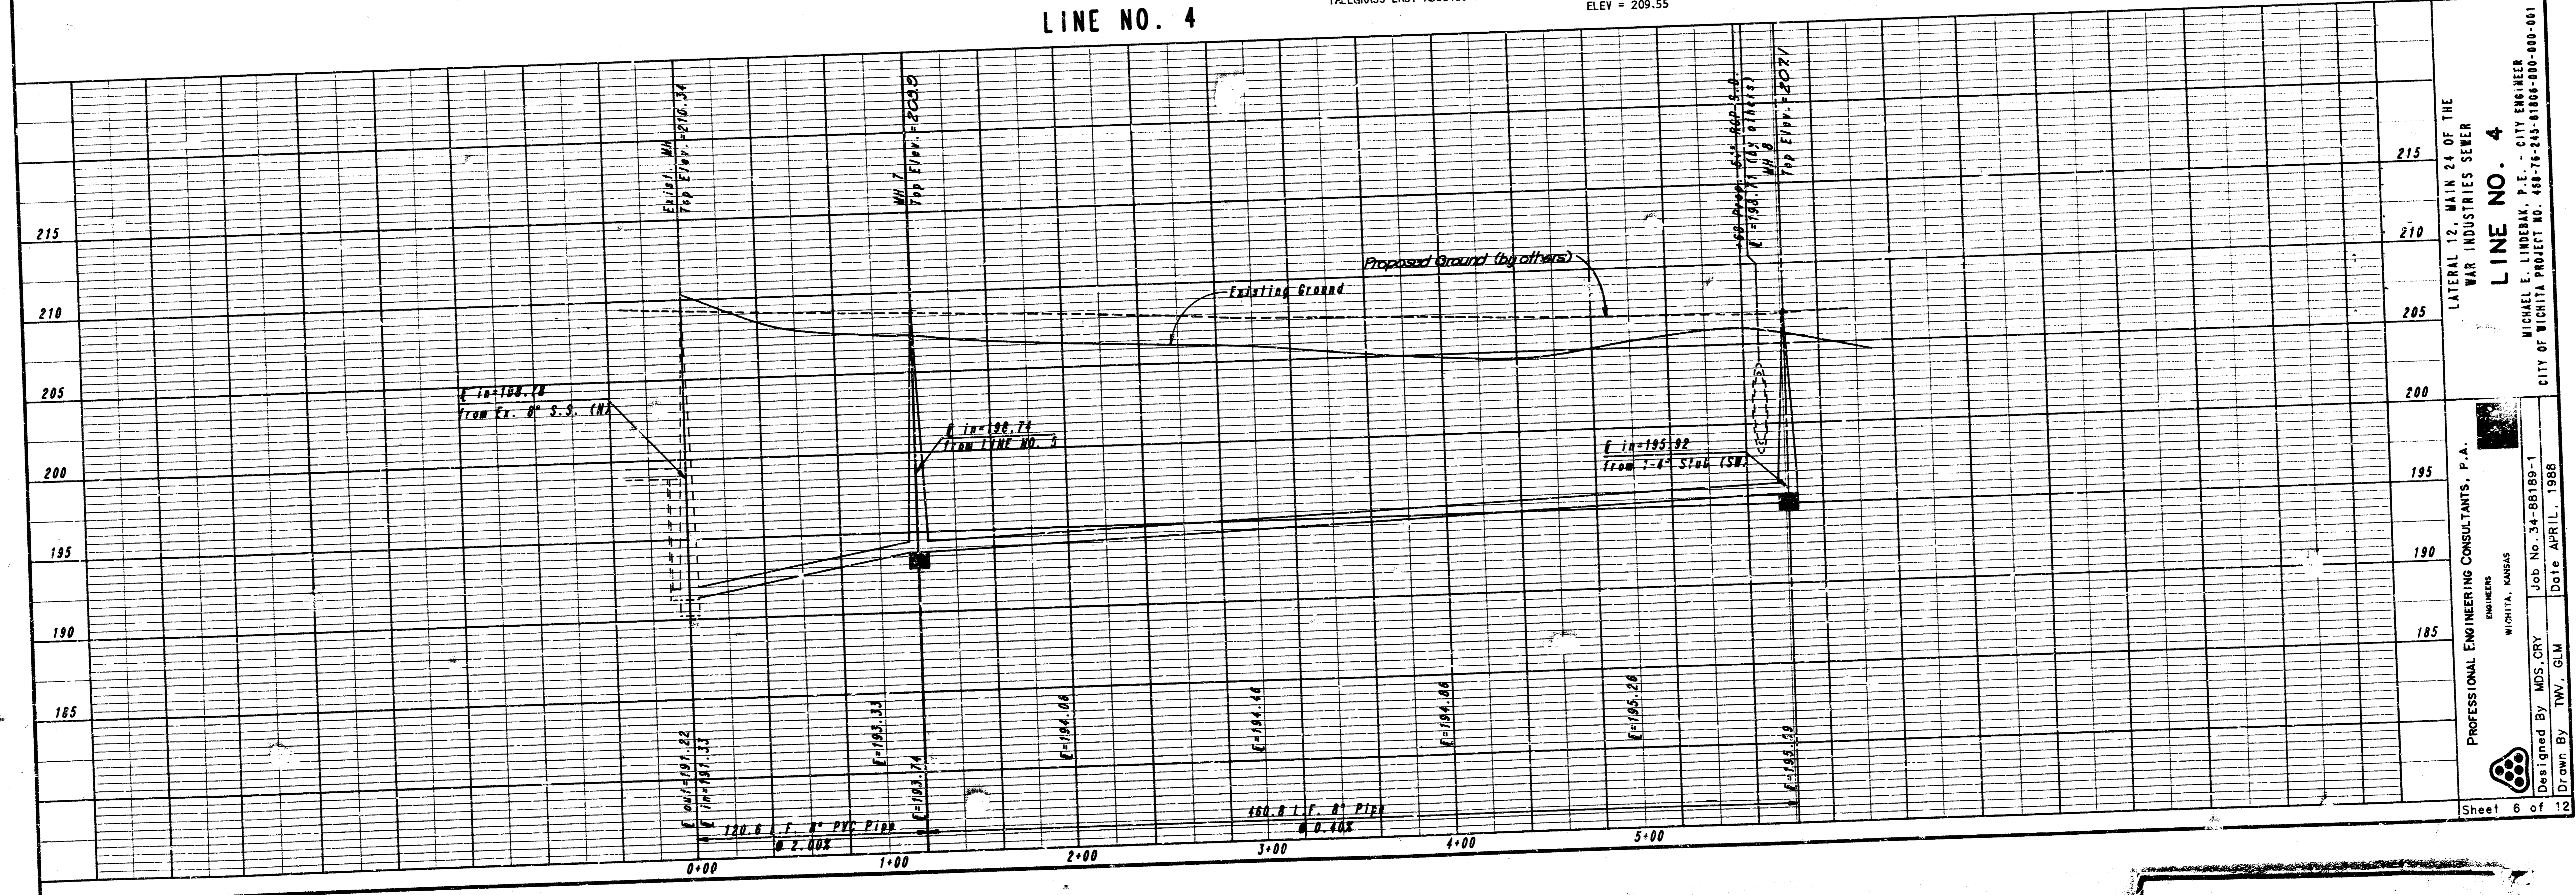

LINE NO. 4
LATERAL 12, MAIN 24 OF THE
WAR INDUSTRIES SEWER
MICHAEL E. LINDERAK, P.E. - CITY ENGINEER
CITY OF WICHITA PROJECT NO. 468-76-245-81005-000-001


PROFESSIONAL ENGINEERING CONSULTANTS, P.A.
ENGINEERS
WICHITA, KANSAS
Job No. 34-88189-1
Designed By MDS,CRY
Drawn By TWJ, GLM
Date APRIL, 1988

FILMED FROM THE BEST AVAILABLE COPY

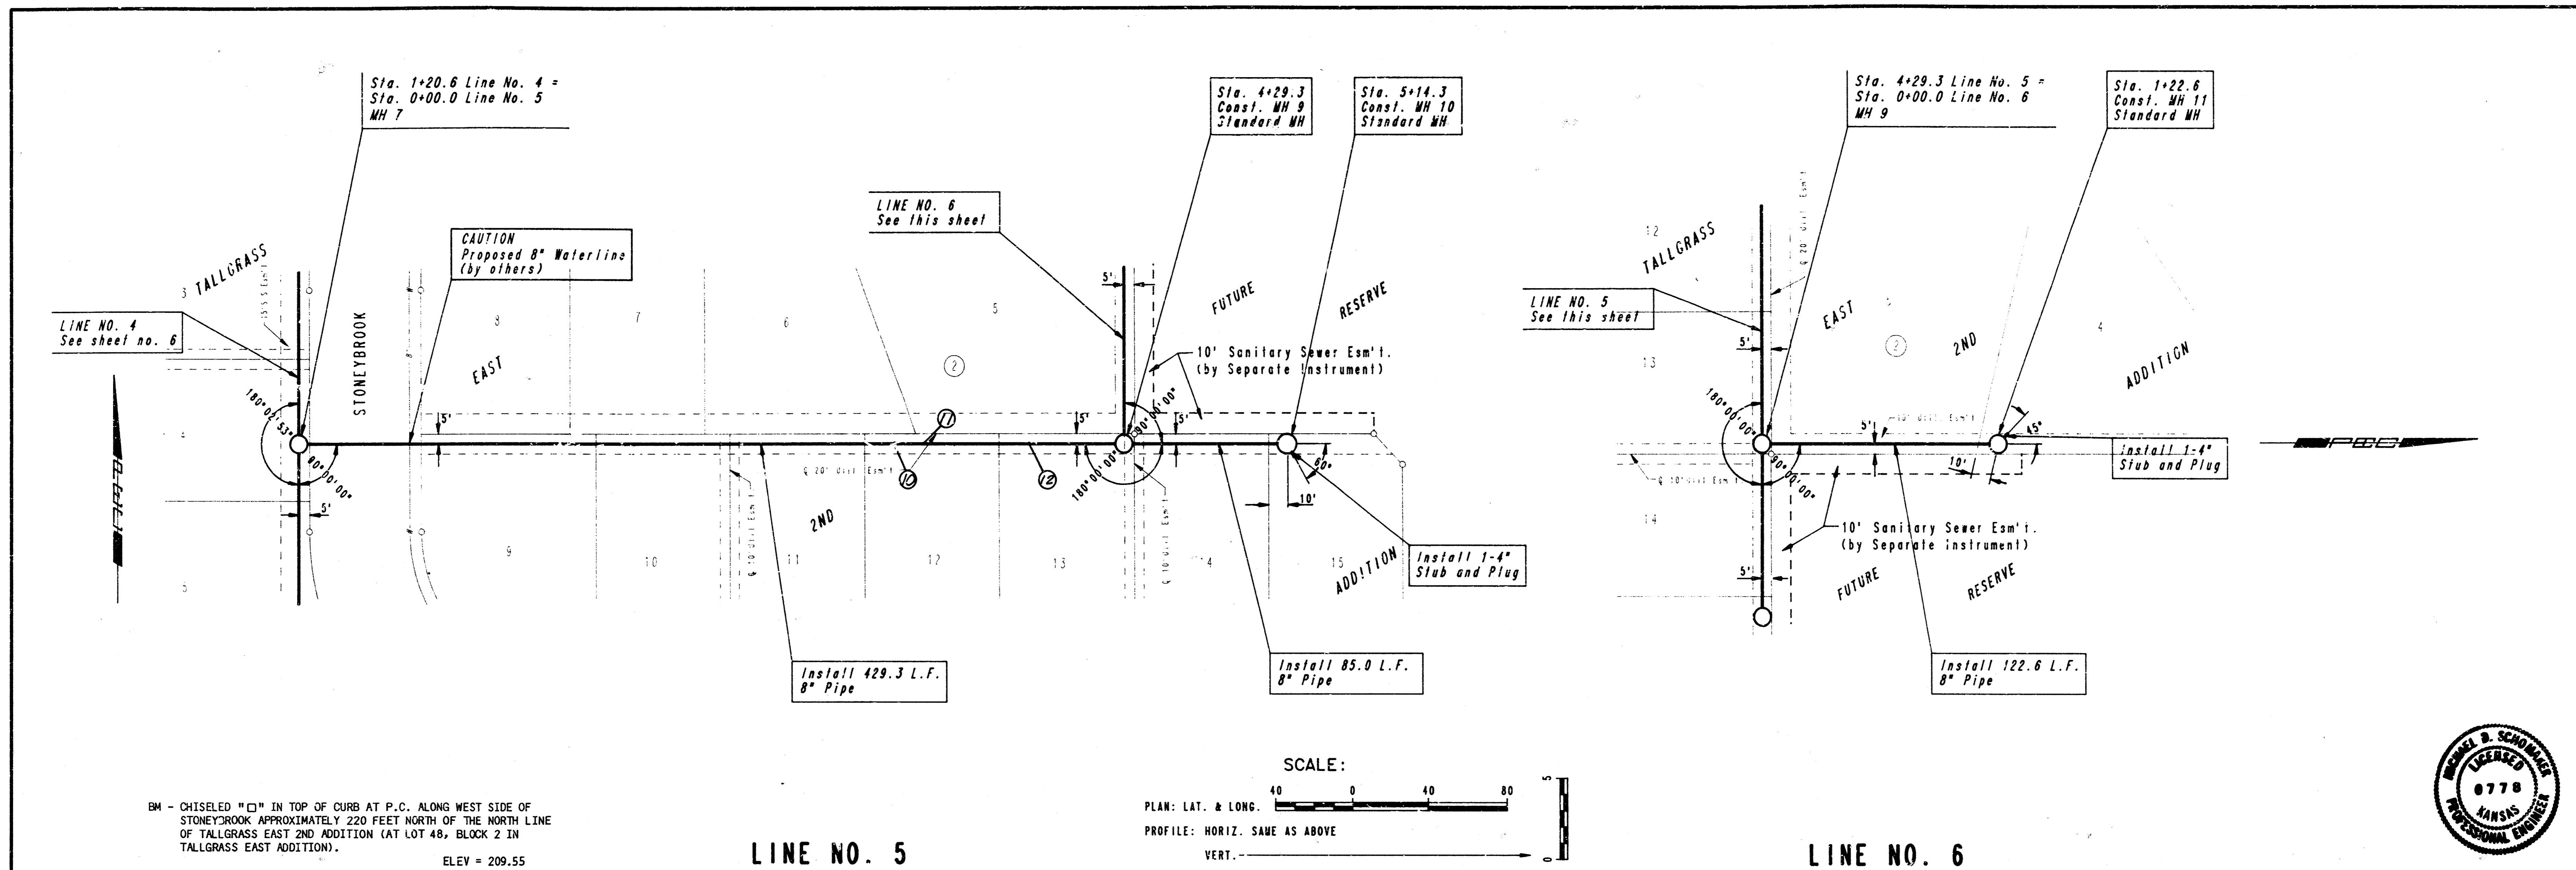


BM - CHISELED "C" IN TOP OF CURB AT P.C. ALONG WEST SIDE OF STONEYBROOK APPROXIMATELY 220 FEET NORTH OF THE NORTH LINE OF TALLGRASS EAST 2ND ADDITION (AT LOT 48, BLOCK 2 IN TALLGRASS EAST ADDITION).
ELEV = 209.55

SCALE:
PLAN: LAT. & LONG. 40 0 40 80
PROFILE: HORIZ. SAME AS ABOVE
VERT. —————

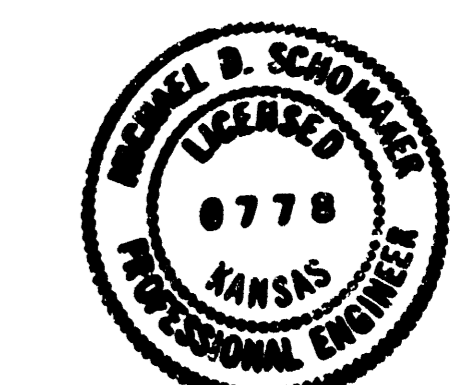

LINE NO. 5

LINE NO. 6

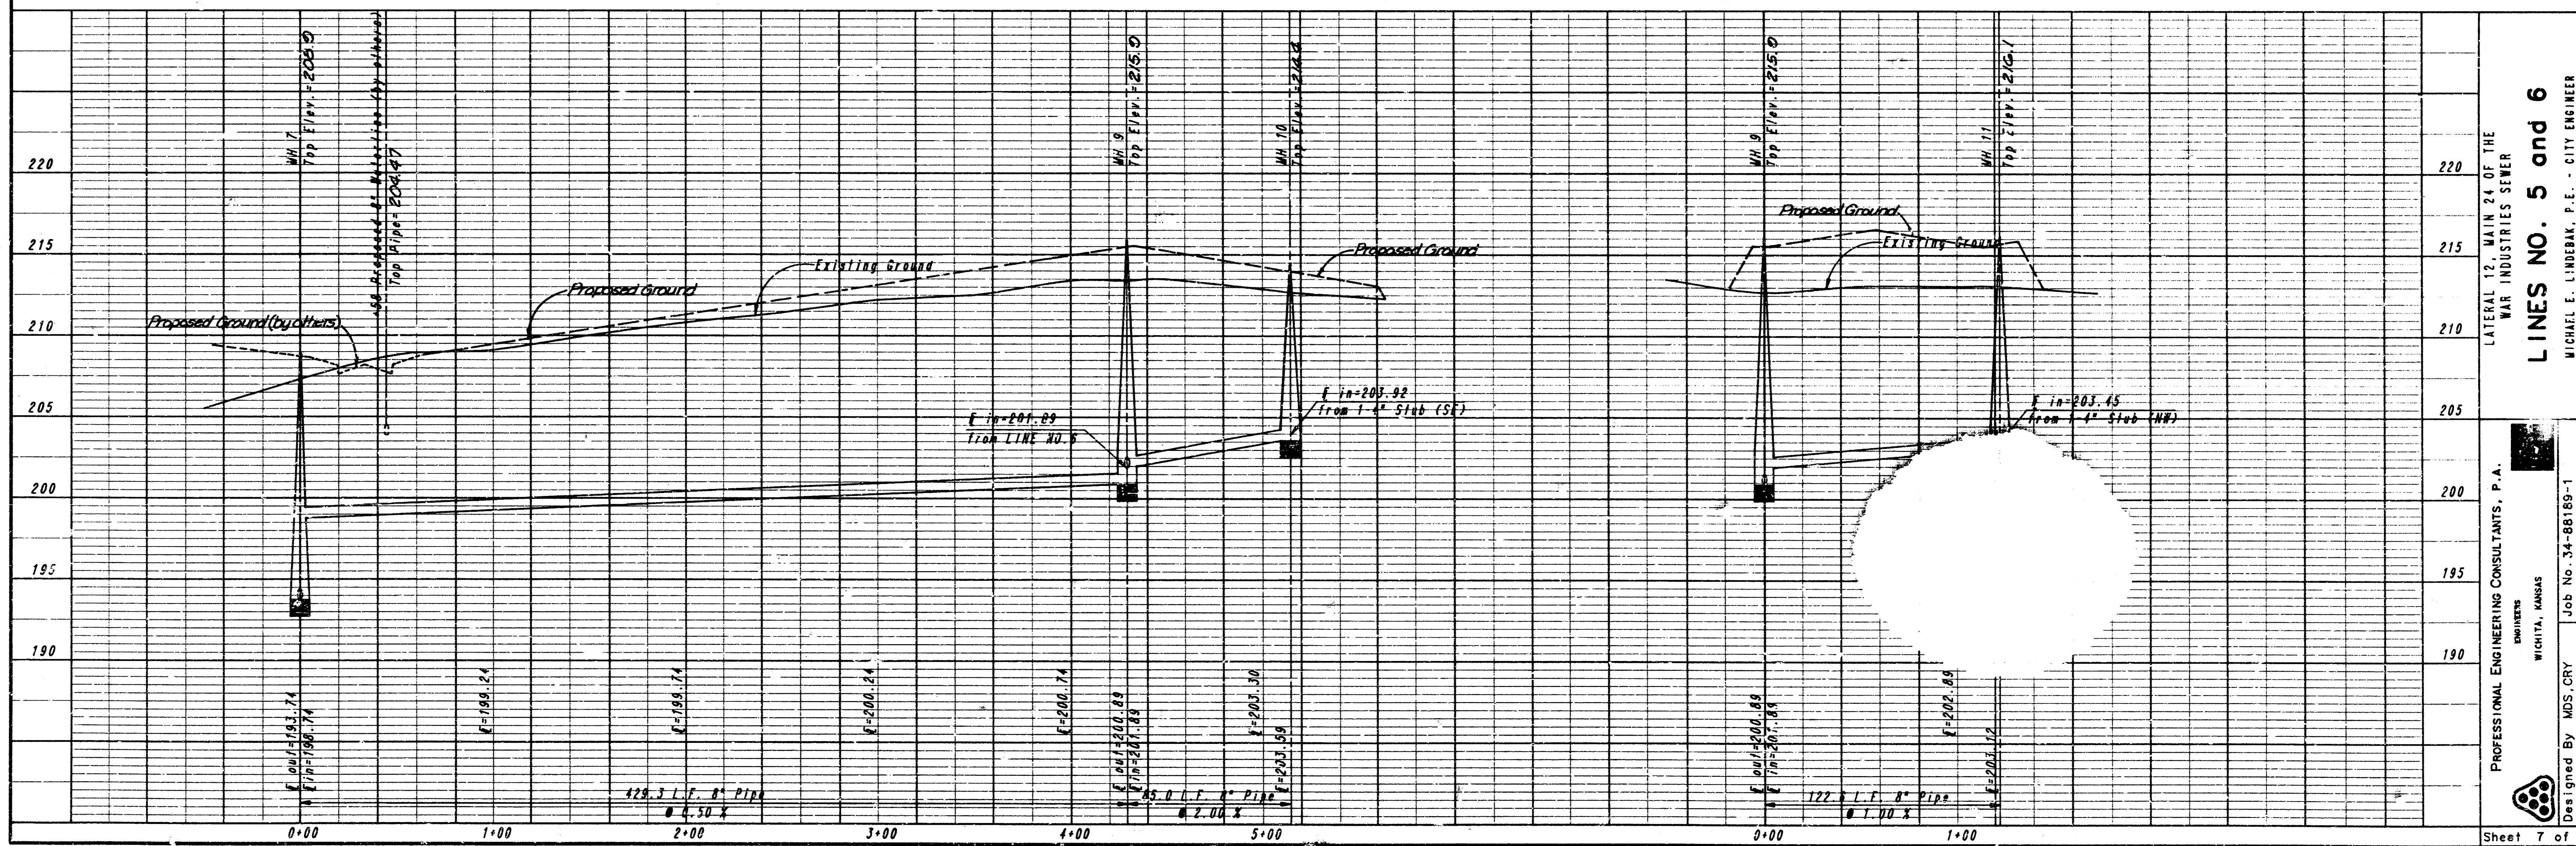

LATERAL 12' MAIN 24" OF THE WAR INDUSTRIES SEWER
LINE NO. 5 and 6
MICHAEL E. LINDBERK, P.E. - CITY ENGINEER
CITY OF WICHITA PROJECT NO. 488-76-215-01800-000-001
PROFESSIONAL ENGINEERING CONSULTANTS, P.A.
ENGINEERS
WICHITA, KANSAS
Job No. 34-88189-1
Designed By: MDS, CRJ
Date: APRIL, 1988
Drawn By: TWV, GJM
Sheet 7 of 12


FILMED FROM THE BEST AVAILABLE COPY

SEWER APPURTENANCES DETAILS

ADOPTED AS STANDARD DESIGN

BY

CITY OF WICHITA

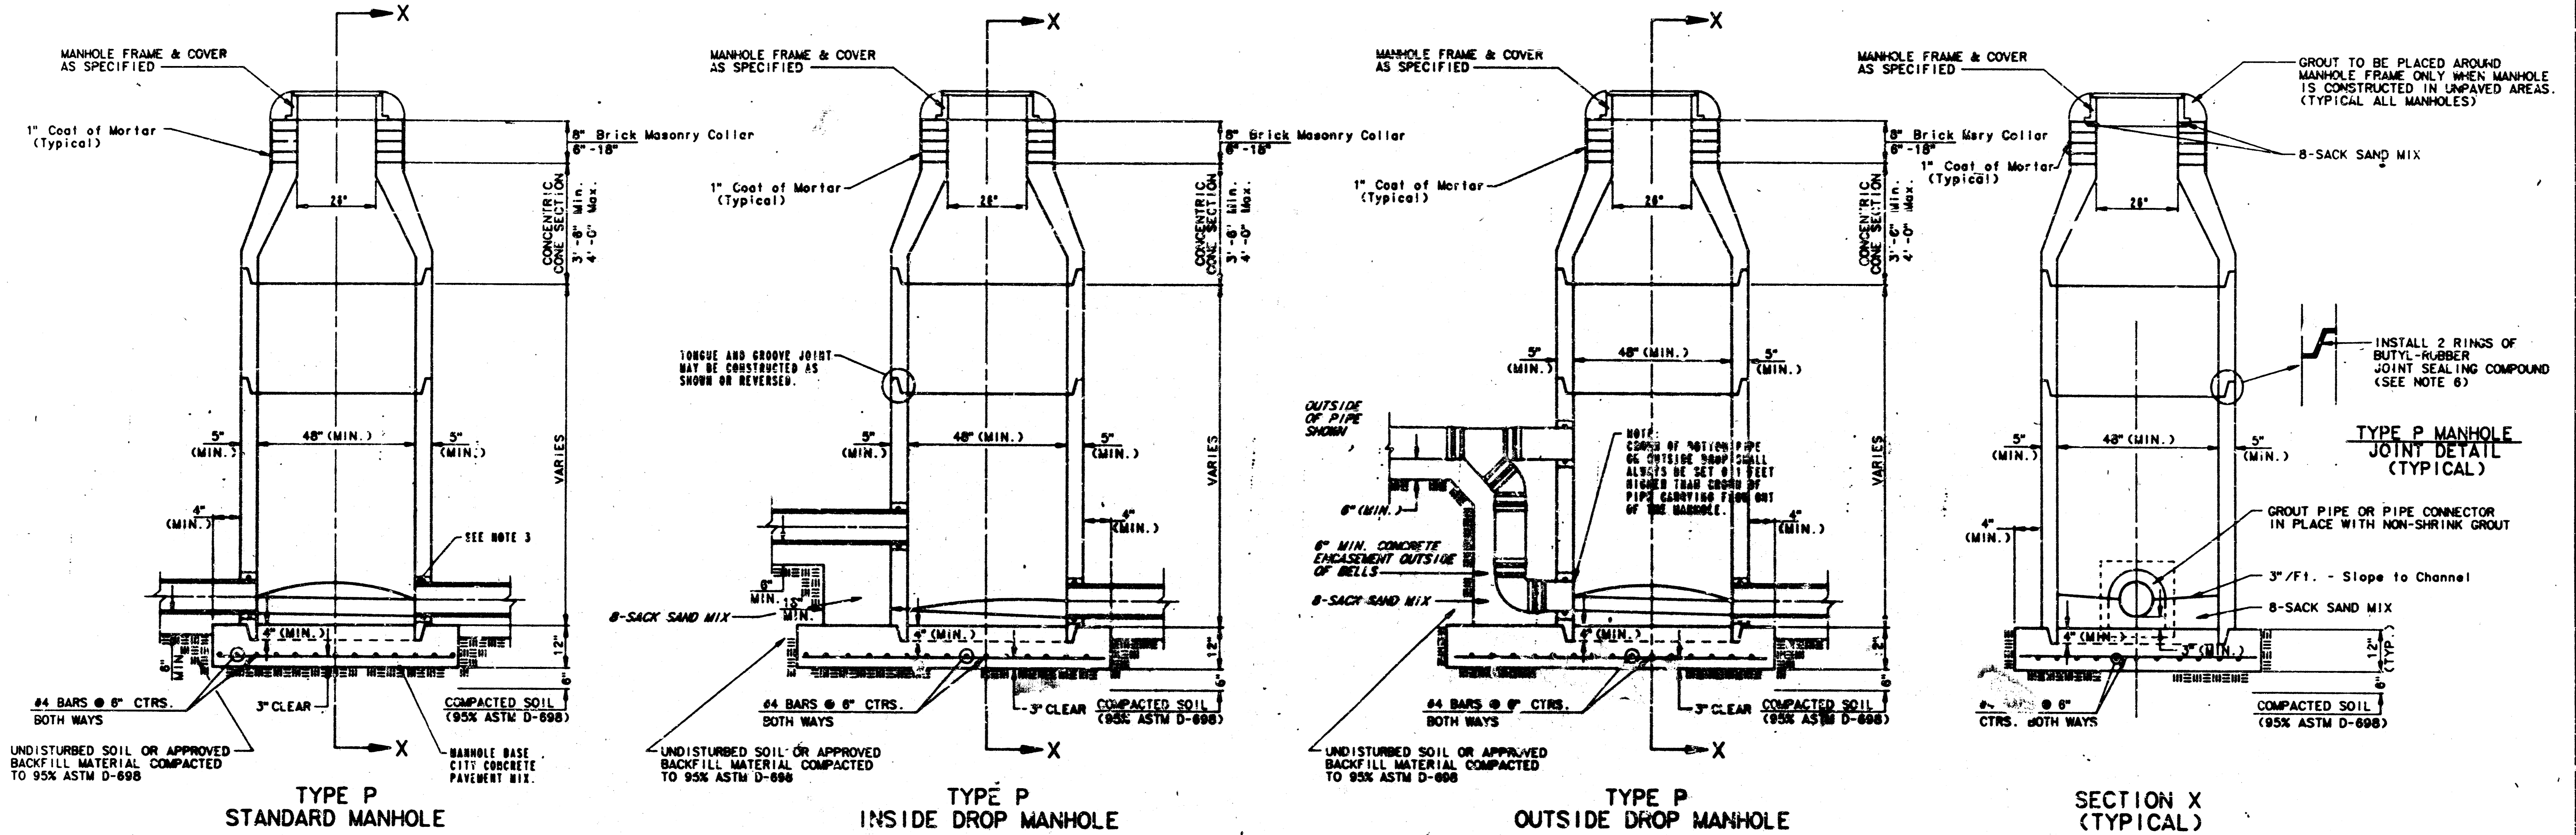

- GENERAL NOTES
- PRECAST MANHOLE NOTES
1. ALL PRECAST CONCRETE MANHOLE SECTIONS SHALL CONFORM TO THE LATEST REVISION OF A. S. I. B. C478 AS MODIFIED BY THE SPECIFICATIONS.
 2. NON-SHRINK GROUT SHALL BE NON-METALLIC TYPE.
 3. APPROVED FLEXIBLE WATERSTOP GASKETS SHALL BE INSTALLED TO JOIN THE SEWER TO THE MANHOLE WALL WHEN A. S. I. B. COMPOSITE PIPE OR P. V. C. PIPE IS USED. FOR OTHER TYPES OF PIPE THE SEWER SHALL BE GROUTED IN PLACE WITH NON-SHRINK GROUT. THE SEWER PIPE SHALL BE SUPPORTED WITH CONCRETE ENCASEMENT A MINIMUM OF 3 FEET FROM THE MANHOLE WALL AND TO THE FIRST JOINT FOR V. C. P. SUCH THAT THE JOINT REMAINS FLEXIBLE.
 4. ALL INSIDE SURFACES OF THE CONCRETE MANHOLE WHICH WOULD BE EXPOSED TO SEWER GAS SHALL BE COATED WITH 2 COATS THEMIC SERIES 66 NI-BUILD EPOXYLINE, DRY THICKNESS OF 8 MILS (MIN.).
 5. EXTERIOR MANHOLE WALLS SHALL BE COATED WITH 1 COAT MOBILARMA 633 BITUMINOUS COATING.
 6. JOINT SEALING COMPOUND SHALL BE KENT SEAL NO. 2 OR APPROVED EQUAL.
 7. PRECAST MANHOLES SHALL BE SET AT LEAST 4 INCHES INTO THE MANHOLE BASE.
 8. TOP OF MANHOLE FLOOR SLAB SHALL BE AT LEAST 3 INCHES BELOW THE FLOW LINE OF THE OUTLET PIPE TO INSURE SUFFICIENT MINIMUM THICKNESS OF SHAPED INVERT.
 9. LIFTING HOLES SHALL BE FILLED WITH NON-SHRINK GROUT AND THE INTERIOR SURFACE COATED AS SPECIFIED.
 10. MORTAR USED IN MASONRY CONSTRUCTION SHALL CONTAIN 8 SACKS OF CEMENT PER CUBIC YARD. CONCRETE USED IN MANHOLE BASES SHALL CONFORM TO THE REQUIREMENTS OF CONCRETE FOR CONCRETE PAVEMENT CONSTRUCTION AS SPECIFIED IN THE CITY STANDARD PAVING SPECIFICATIONS USING CITY CONCRETE PAVEMENT MIX WITHOUT AIR ENTRAINING ADMIXTURE. MORTAR SHALL BE PLACED AROUND THE MANHOLE RING AS SHOWN ON THE DRAWINGS WHEN MANHOLES ARE CONSTRUCTED IN UNPAVED AREAS. MANHOLES CONSTRUCTED WHERE PIPE SIZES ARE SMALLER THAN 24" SHALL HAVE AN INSIDE DIAMETER OF 4". MANHOLES CONSTRUCTED WHERE PIPE SIZES ARE 24" OR LARGER SHALL HAVE AN INSIDE DIAMETER OF 5". COMPLETED MANHOLE SHALL BE WITHOUT LEAKS AND WATER TIGHT.

11. REINFORCING STEEL SHALL BE INSTALLED IN THE MANHOLE BASES AND SHALL CONSIST OF NO. 4 BARS PLACED ON 6" CENTERS IN BOTH DIRECTIONS. THE MANHOLE BASE REINFORCEMENT SHALL BE PLACED AT LEAST 3" ABOVE THE BOTTOM OF THE MANHOLE BASE. ALL COSTS FOR FURNISHING AND INSTALLING REINFORCING STEEL SHALL BE INCLUDED IN THE UNIT PRICE BID FOR THE MANHOLE.
12. OPENINGS SHALL BE CUT INTO THE MANHOLE WALL WHEN OUTSIDE DROPS ARE CONSTRUCTED ON EXISTING MANHOLES. SUCH OPENINGS CUT INTO EXISTING MANHOLES SHALL BE AS SMALL AS PRACTICAL TO FACILITATE INSTALLING AND GROUTING THE NEW PIPE IN PLACE. WATERSTOP GASKETS SHALL BE USED WITH P. V. C. AND A. S. I. B. COMPOSITE PIPE. THE NEW PIPE SHALL BE GROUTED INTO THE OPENING USING AN APPROVED NONSHRINK GROUT FOR THE FULL MANHOLE WALL THICKNESS. THE EXTERIOR OF THE COMPLETED CONNECTION SHALL BE SEALED WITH AN APPROVED BITUMINOUS COATING SUCH THAT THE CONNECTION WILL BE WATER TIGHT. FLOOR OF MANHOLE SHALL BE MODIFIED TO FORM NEW FLOW CHANNEL FOR THE NEW CONNECTION AS INDICATED BY THE DRAWING. THIS WORK, INCLUDING MODIFICATION OF MANHOLE FLOOR, SHALL BE PAID FOR AT THE UNIT PRICE BID FOR OUTSIDE DROP STACK CONSTRUCTED ON EXISTING MANHOLE.
13. THE FLOORS OF ALL MANHOLES SHALL BE SHAPED WITH FLOW CHANNELS SUCH THAT THE MANHOLES WILL BE SELF-CLEANING AND FREE OF AREAS WHERE SOLIDS COULD BE DEPOSITED AS SEWAGE FLOWS THROUGH THE MANHOLE FROM ALL INLET PIPES TO THE OUTLET PIPE. FLOW CHANNELS SHALL BE FORMED TO MATCH THE BOTTOM HALVES OF THE INFLOWING PIPES AND THE OUTFLOWING PIPES AS SHOWN BY THE DRAWINGS EXCEPT FOR INSIDE DROP MANHOLES. FLOW CHANNELS FOR INSIDE DROP MANHOLES SHALL BE CONSTRUCTED AS INDICATED BY THE DRAWING. MANHOLE FLOORS SHALL HAVE SLOPES OF 3 INCHES PER FOOT IN THE AREAS OUTSIDE OF THE FLOW CHANNELS SLOPED TOWARD THE FLOW CHANNELS. PIPES LAID THROUGH MANHOLES SHALL HAVE THE TOP HALF REMOVED TO REVEAL LINES FOR THE FULL INSIDE DIAMETER OF THE MANHOLE. MANHOLE FLOORS SHALL THEN BE SHAPED AROUND THE BOTTOM HALF OF THE PIPE WHICH FORMS THE FLOW CHANNEL.
14. PIPES INSTALLED WITHIN THE EXCAVATION MADE FOR THE MANHOLE SHALL BE CRADLED WITH CONCRETE TO THE LIMITS OF THE MANHOLE EXCAVATION. WHEN CLAY PIPE IS USED, THE CRADLE SHALL EXTEND TO THE FIRST JOINT OUTSIDE THE MANHOLE. THE CRADLE SHALL BE TERMINATED AT THE CLAY PIPE JOINT WITH A WEDGE WHICH WILL MAINTAIN THE FLEXIBILITY OF THE JOINT. COST OF CRADLE WITHIN MANHOLE EXCAVATION OR TO CLAY PIPE JOINTS ADJACENT TO MANHOLE SHALL BE INCLUDED IN THE UNIT PRICE BID FOR THE MANHOLE.

15. MANHOLE COVER CASTINGS AND MANHOLE FRAME CASTINGS SHALL CONFORM TO THE REQUIREMENTS AS INDICATED IN THE STANDARD SPECIFICATIONS AND AS SHOWN IN THE STANDARD DETAIL DRAWING.
16. THE VERTICAL DROP IN INSIDE DROP MANHOLES SHALL NOT EXCEED 4' FOR INFLOWING PIPES SIZED 12" OR SMALLER AND 2' FOR INFLOWING PIPES LARGER THAN 12". THE CROWNS OF INFLOWING PIPES SHALL NEVER BE SET LOWER THAN THE CROWN OF THE OUTFLOWING PIPE.
17. STANDARD MANHOLES AND STANDARD INSIDE DROP MANHOLES SHALL BE BID AS STANDARD MANHOLES FOR THE TYPE AND DIAMETER INDICATED. OUTSIDE DROP MANHOLES SHALL BE BID AS STANDARD OUTSIDE DROP MANHOLES FOR THE TYPE AND DIAMETER INDICATED. ALL MANHOLE DIAMETERS WILL BE 4' UNLESS INDICATED OTHERWISE.
18. A BRICK MASONRY COLLAR SHALL BE INSTALLED BETWEEN THE CAST IRON FRAME AND THE CONCENTRIC CORE. THE COLLAR WILL HAVE 6" WALLS AND A VERTICAL HEIGHT OF 8" MINIMUM AND 18" MAXIMUM. A 1" COAT OF MORTAR WILL BE PLASTERED ON THE OUTSIDE OF THE COLLAR.

Sht. 8 of 12
Revised: June 12, 1986

FILMED FROM THE BEST AVAILABLE COPY


SEWER APPURTENANCES DETAILS

ADOPTED AS STANDARD DESIGN


BY

CITY OF WICHITA, KANSAS


TYPE "D" MANHOLE

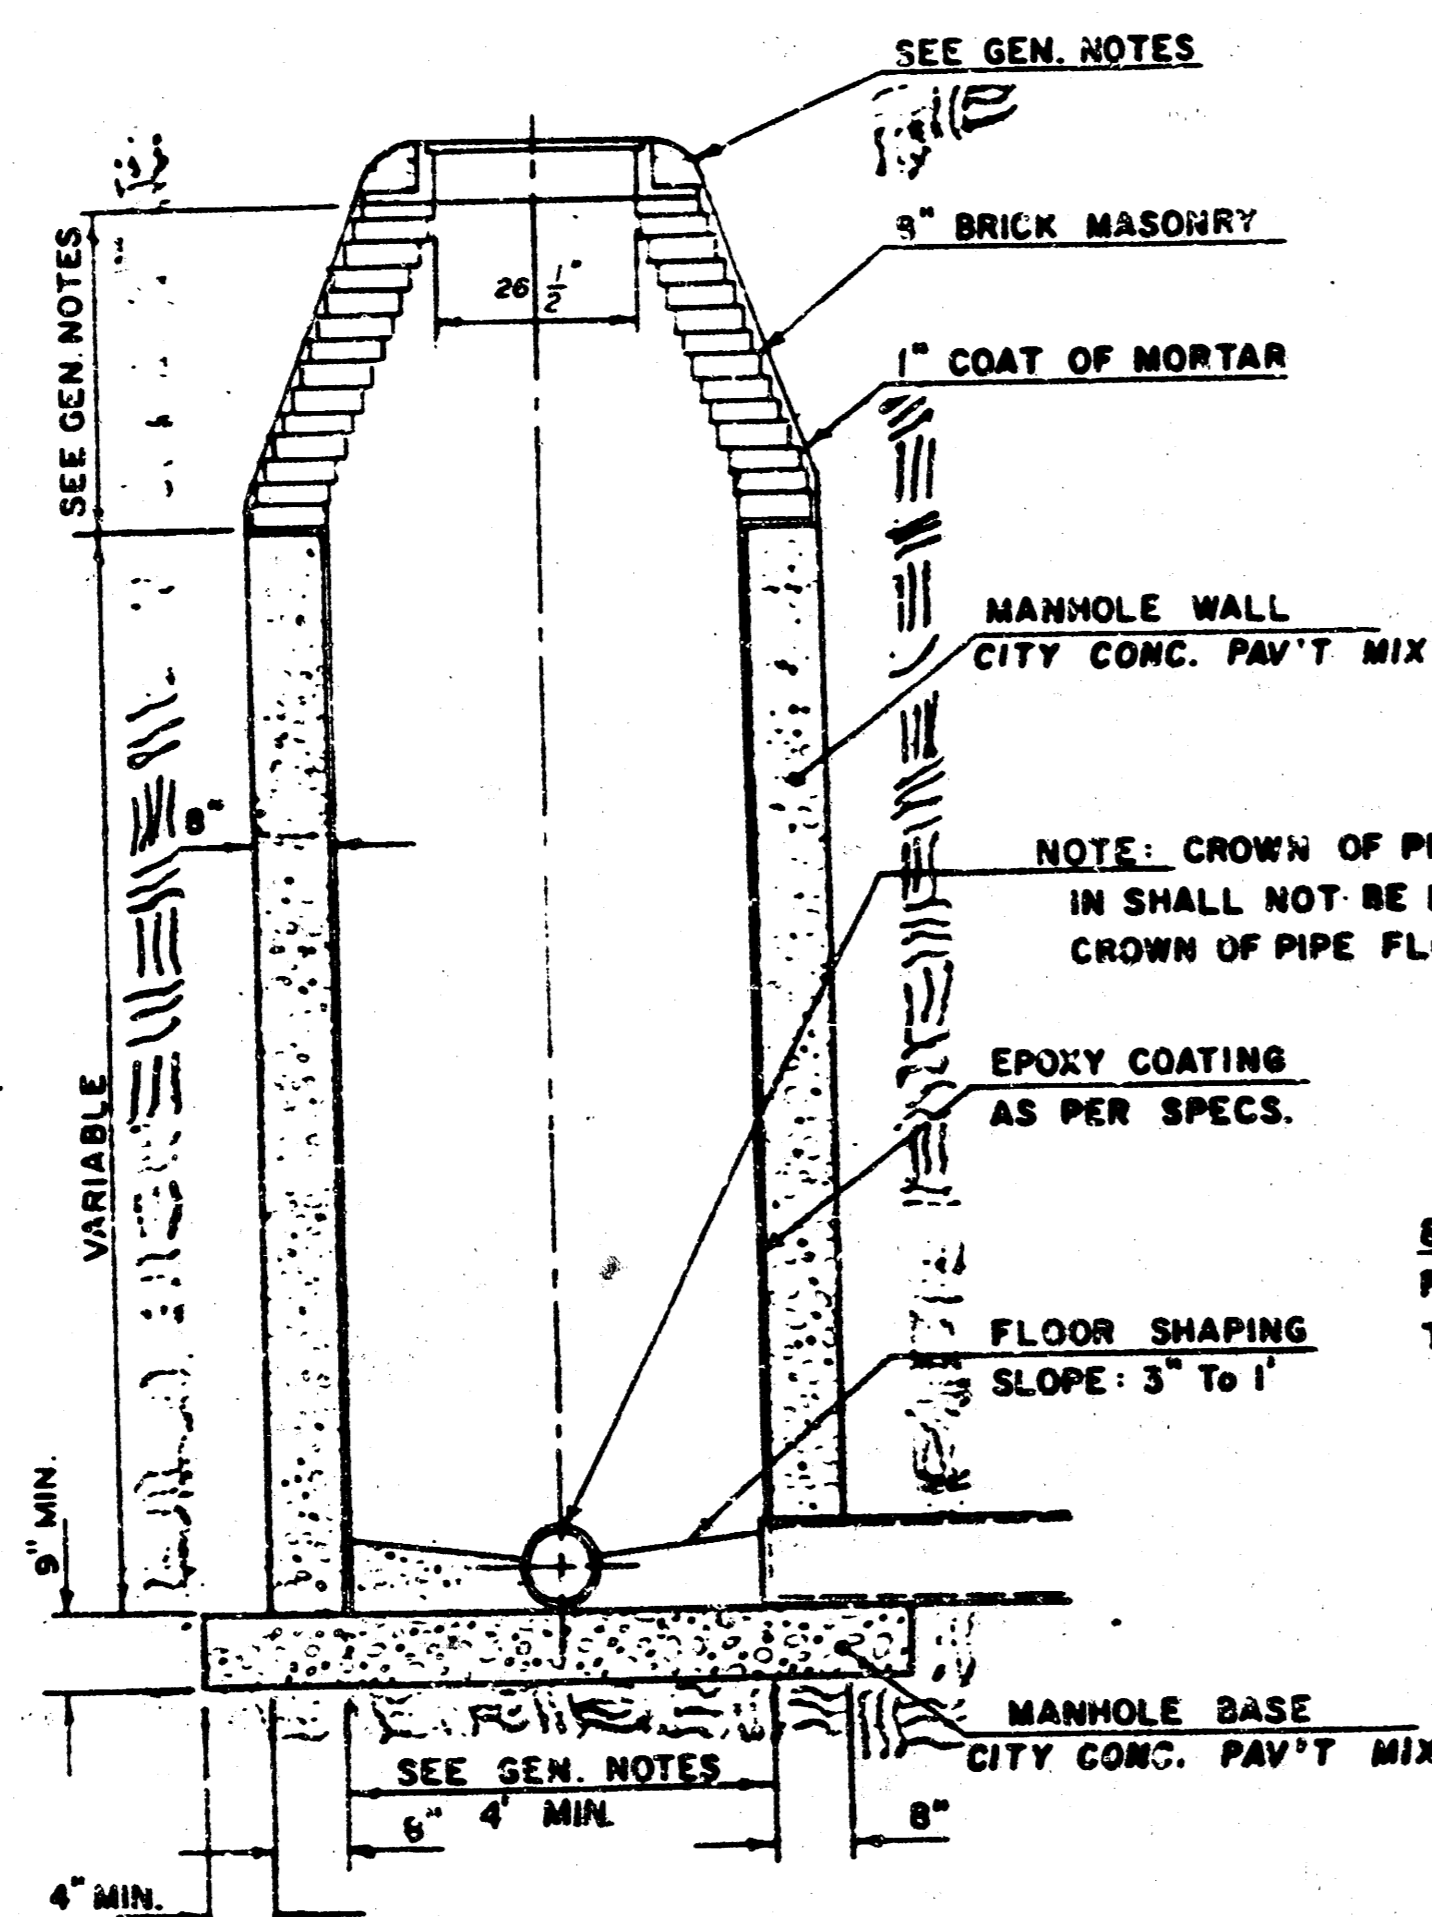

TYPE "D" INSIDE DROP MANHOLE

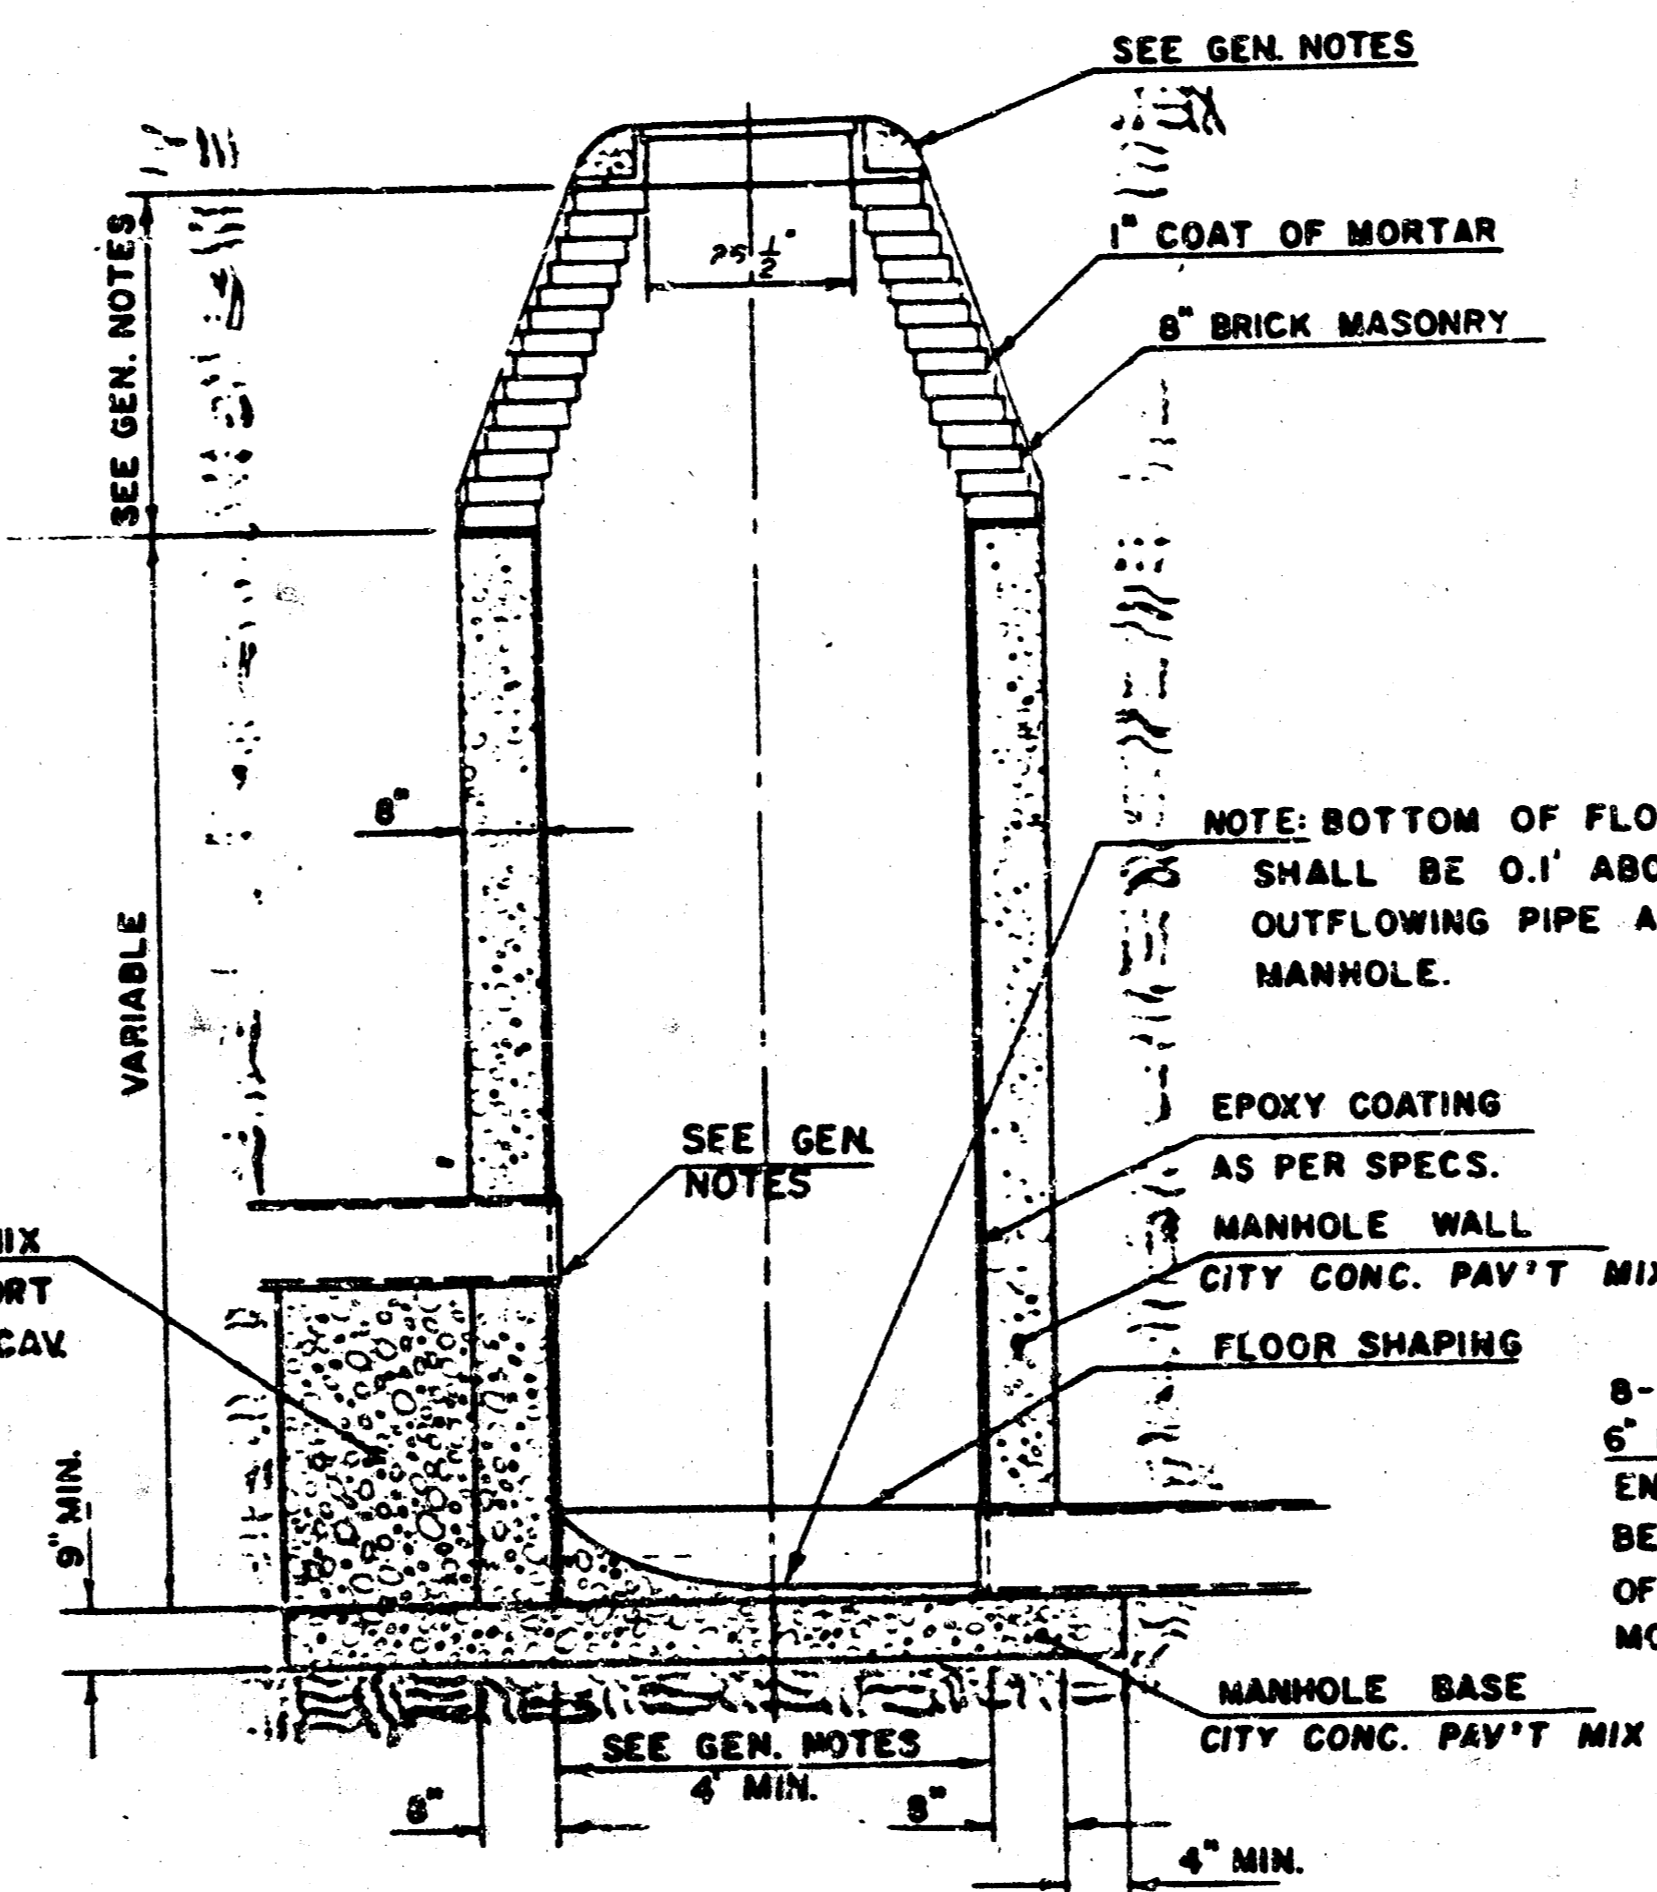

TYPE "D" OUTSIDE DROP MANHOLE

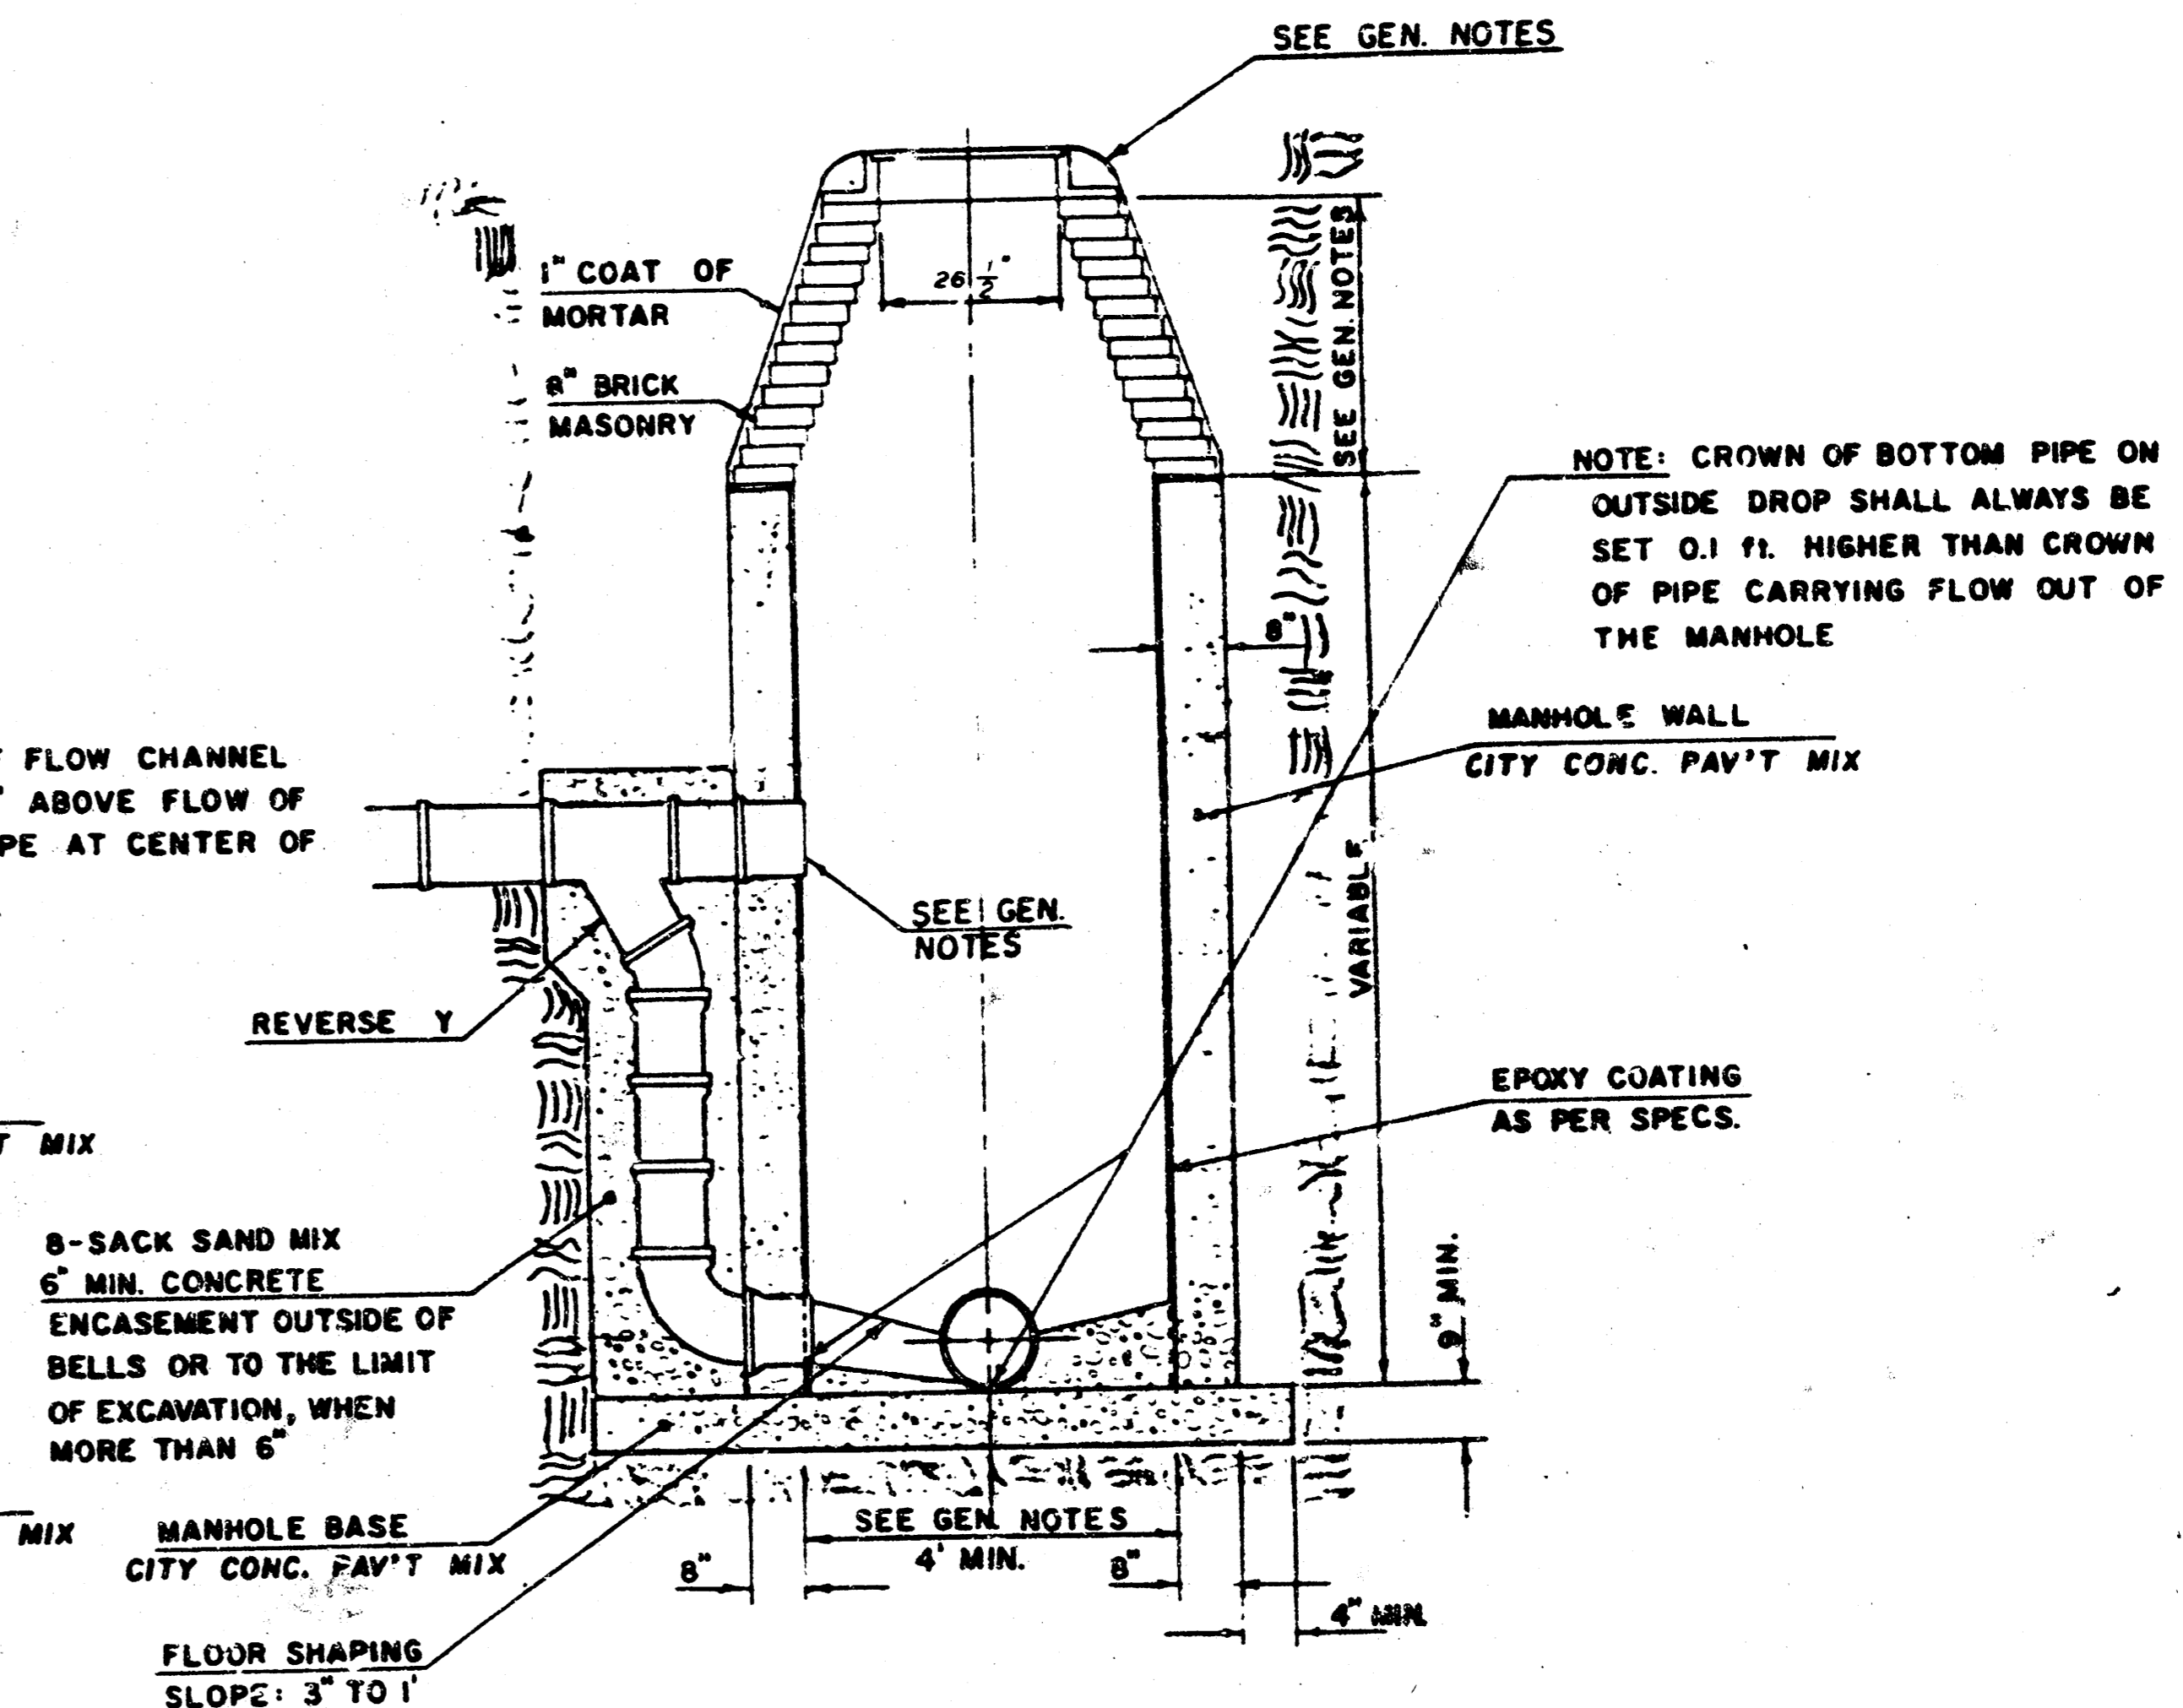

GENERAL NOTES

1. MORTAR USED IN MASONRY CONSTRUCTION SHALL CONTAIN 8 SACKS OF CEMENT PER CUBIC YARD. CONCRETE USED IN MANHOLE WALLS AND BASES SHALL CONFORM TO THE REQUIREMENTS OF CONCRETE FOR CONCRETE PAVEMENT CONSTRUCTION AS SPECIFIED IN THE CITY STANDARD PAVING SPECIFICATIONS USING CITY CONCRETE PAVEMENT MIX WITHOUT AIR ENTRAINING ADMIXTURE. MORTAR SHALL BE PLACED AROUND THE MANHOLE RING AS SHOWN ON THE DRAWINGS WHEN MANHOLES ARE CONSTRUCTED IN UNPAVED AREAS.
ALL INSIDE SURFACES OF THE CONCRETE MANHOLE WALL WHICH WOULD BE EXPOSED TO SEWER GAS SHALL BE PROTECTED BY AN APPROVED EPOXY COATING. TYPE "D" MANHOLES MAY BE USED ON PIPE SIZES 8" TO 36" WHEN THE MANHOLE DEPTH EXCEEDS THE REQUIRED CORBEL HEIGHT BY 1" PLUS THE OUTSIDE DIAMETER OF THE LARGEST PIPE IN THE MANHOLE.
MANHOLES CONSTRUCTED WHERE PIPE SIZES ARE SMALLER THAN 24" SHALL HAVE A DIAMETER OF 4". MANHOLES CONSTRUCTED WHERE THE PIPE SIZES ARE 24" OR LARGER SHALL HAVE A DIAMETER OF 5". THE HEIGHT OF THE CORBELS ON 4" DIAMETER MANHOLES SHALL BE 4". MANHOLES HAVING A DIAMETER OF 5" SHALL HAVE CORBELS 6" IN HEIGHT. COMPLETED MANHOLE SHALL BE WITHOUT LEAKS AND WATER TIGHT.
2. REINFORCING STEEL SHALL BE INSTALLED IN THE MANHOLE BASE. REINFORCING STEEL SHALL CONSIST OF NO. 4 BARS PLACED ON 6" CENTERS IN BOTH DIRECTIONS. REINFORCING STEEL SHALL BE PLACED 6" ABOVE THE BOTTOM OF THE MANHOLE BASE. COST OF FURNISHING AND INSTALLING REINFORCING STEEL SHALL BE INCLUDED IN THE UNIT PRICE BID FOR THE MANHOLE.
3. AN OPENING SHALL BE CUT IN THE MANHOLE WALL FOR THE UPPER INLET PIPE FOR INSIDE AND OUTSIDE DROP MANHOLES. THE UPPER INLET PIPE SHALL BE GROUTED INTO THIS OPENING WITH NON-SHRINK GROUT. THE EXTERIOR OF THIS COMPLETED CONNECTION SHALL BE SEALED WITH AN APPROVED BITUMINOUS COATING SUCH THAT THE CONNECTION WILL BE WATER TIGHT. THE INTERIOR PLASTIC LINING SHALL BE SEALED AROUND THE INLET PIPE OPENING IN SUCH A MANNER THAT WILL EFFECTIVELY MAINTAIN THE INTEGRITY OF THE PROTECTIVE PLASTIC LINER.
4. THE FLOORS OF ALL MANHOLES SHALL BE SHAPED WITH FLOW CHANNELS SUCH THAT THE MANHOLES WILL BE SELF-CLEANING AND FREE OF AREAS WHERE SOLIDS COULD BE DEPOSITED AS SEWAGE FLOWS THROUGH THE MANHOLE FROM ALL INLET PIPES TO THE

- OUTLET PIPE. FLOW CHANNELS SHALL BE FORMED TO MATCH THE BOTTOM HALVES OF THE INFLOWING PIPES AND THE OUTFLOWING PIPE AS SHOWN BY THE DRAWINGS EXCEPT FOR INSIDE DROP MANHOLES. FLOW CHANNELS FOR INSIDE DROP MANHOLES SHALL BE CONSTRUCTED AS INDICATED BY THE DRAWING. MANHOLE FLOORS SHALL HAVE SLOPES OF 3 INCHES PER FOOT IN THE AREAS OUTSIDE OF THE FLOW CHANNELS SLOPED TOWARD THE FLOW CHANNELS. PIPES GOING THROUGH MANHOLES SHALL HAVE THE TOP HALF REMOVED TO NEAR LINES FOR THE FULL INSIDE DIAMETER OF THE MANHOLE. MANHOLE FLOORS SHALL THEN BE SHAPED AROUND THE BOTTOM HALF OF THE PIPE WHICH FORMS THE FLOW CHANNEL.
5. PIPES INSTALLED WITHIN THE EXCAVATION MADE FOR THE MANHOLE SHALL BE GRADED WITH CONCRETE TO THE LIMITS OF THE MANHOLE EXCAVATION. WHEN CLAY PIPE IS USED, THE CRADLE SHALL EXTEND TO THE FIRST JOINT OUTSIDE THE MANHOLE. THE CRADLE SHALL BE TERMINATED AT THE CLAY PIPE JOINT IN A MANNER WHICH WILL MAINTAIN THE FLEXIBILITY OF THE JOINT. COST OF CRADLE WITHIN MANHOLE EXCAVATION OR TO CLAY PIPE JOINTS ADJACENT TO MANHOLE SHALL BE INCLUDED IN THE UNIT PRICE BID FOR THE MANHOLE.
6. MANHOLE COVER CASTINGS AND MANHOLE FRAME CASTINGS SHALL CONFORM TO THE REQUIREMENTS AS INDICATED IN THE STANDARD SPECIFICATIONS AND AS SHOWN IN THE STANDARD DETAIL DRAWING.
7. THE VERTICAL DROP IN INSIDE DROP MANHOLES SHALL NOT EXCEED 4' FOR INFLOWING PIPES SIZED 12" OR SMALLER AND 2' FOR INFLOWING PIPES LARGER THAN 12". THE CROWNS OF INFLOWING PIPES SHALL NEVER BE SET LOWER THAN THE CROWN OF THE OUTFLOWING PIPE.
8. STANDARD MANHOLES TYPE "D" AND STANDARD INSIDE DROP MANHOLES TYPE "D" SHALL BE BID AS STANDARD MANHOLES FOR THE TYPE AND DIAMETER INDICATED. OUTSIDE DROP MANHOLES TYPE "D" SHALL BE BID AS STANDARD OUTSIDE DROP MANHOLES FOR THE TYPE AND DIAMETER INDICATED. ALL MANHOLE DIAMETERS WILL BE 4' UNLESS INDICATED OTHERWISE.

NOTE: EPOXY COATING ON INTERIOR CONCRETE SURFACES MAY BE DELETED WHEN TYPE "D" MANHOLES ARE CONSTRUCTED ON SEWERS WITH DIAMETERS SMALLER THAN 10".


SEWER APPURTENANCES DETAILS

ADOPTED AS STANDARD DESIGN


BY

City of Wichita, Kansas


STANDARD MANHOLE TYPE "C"

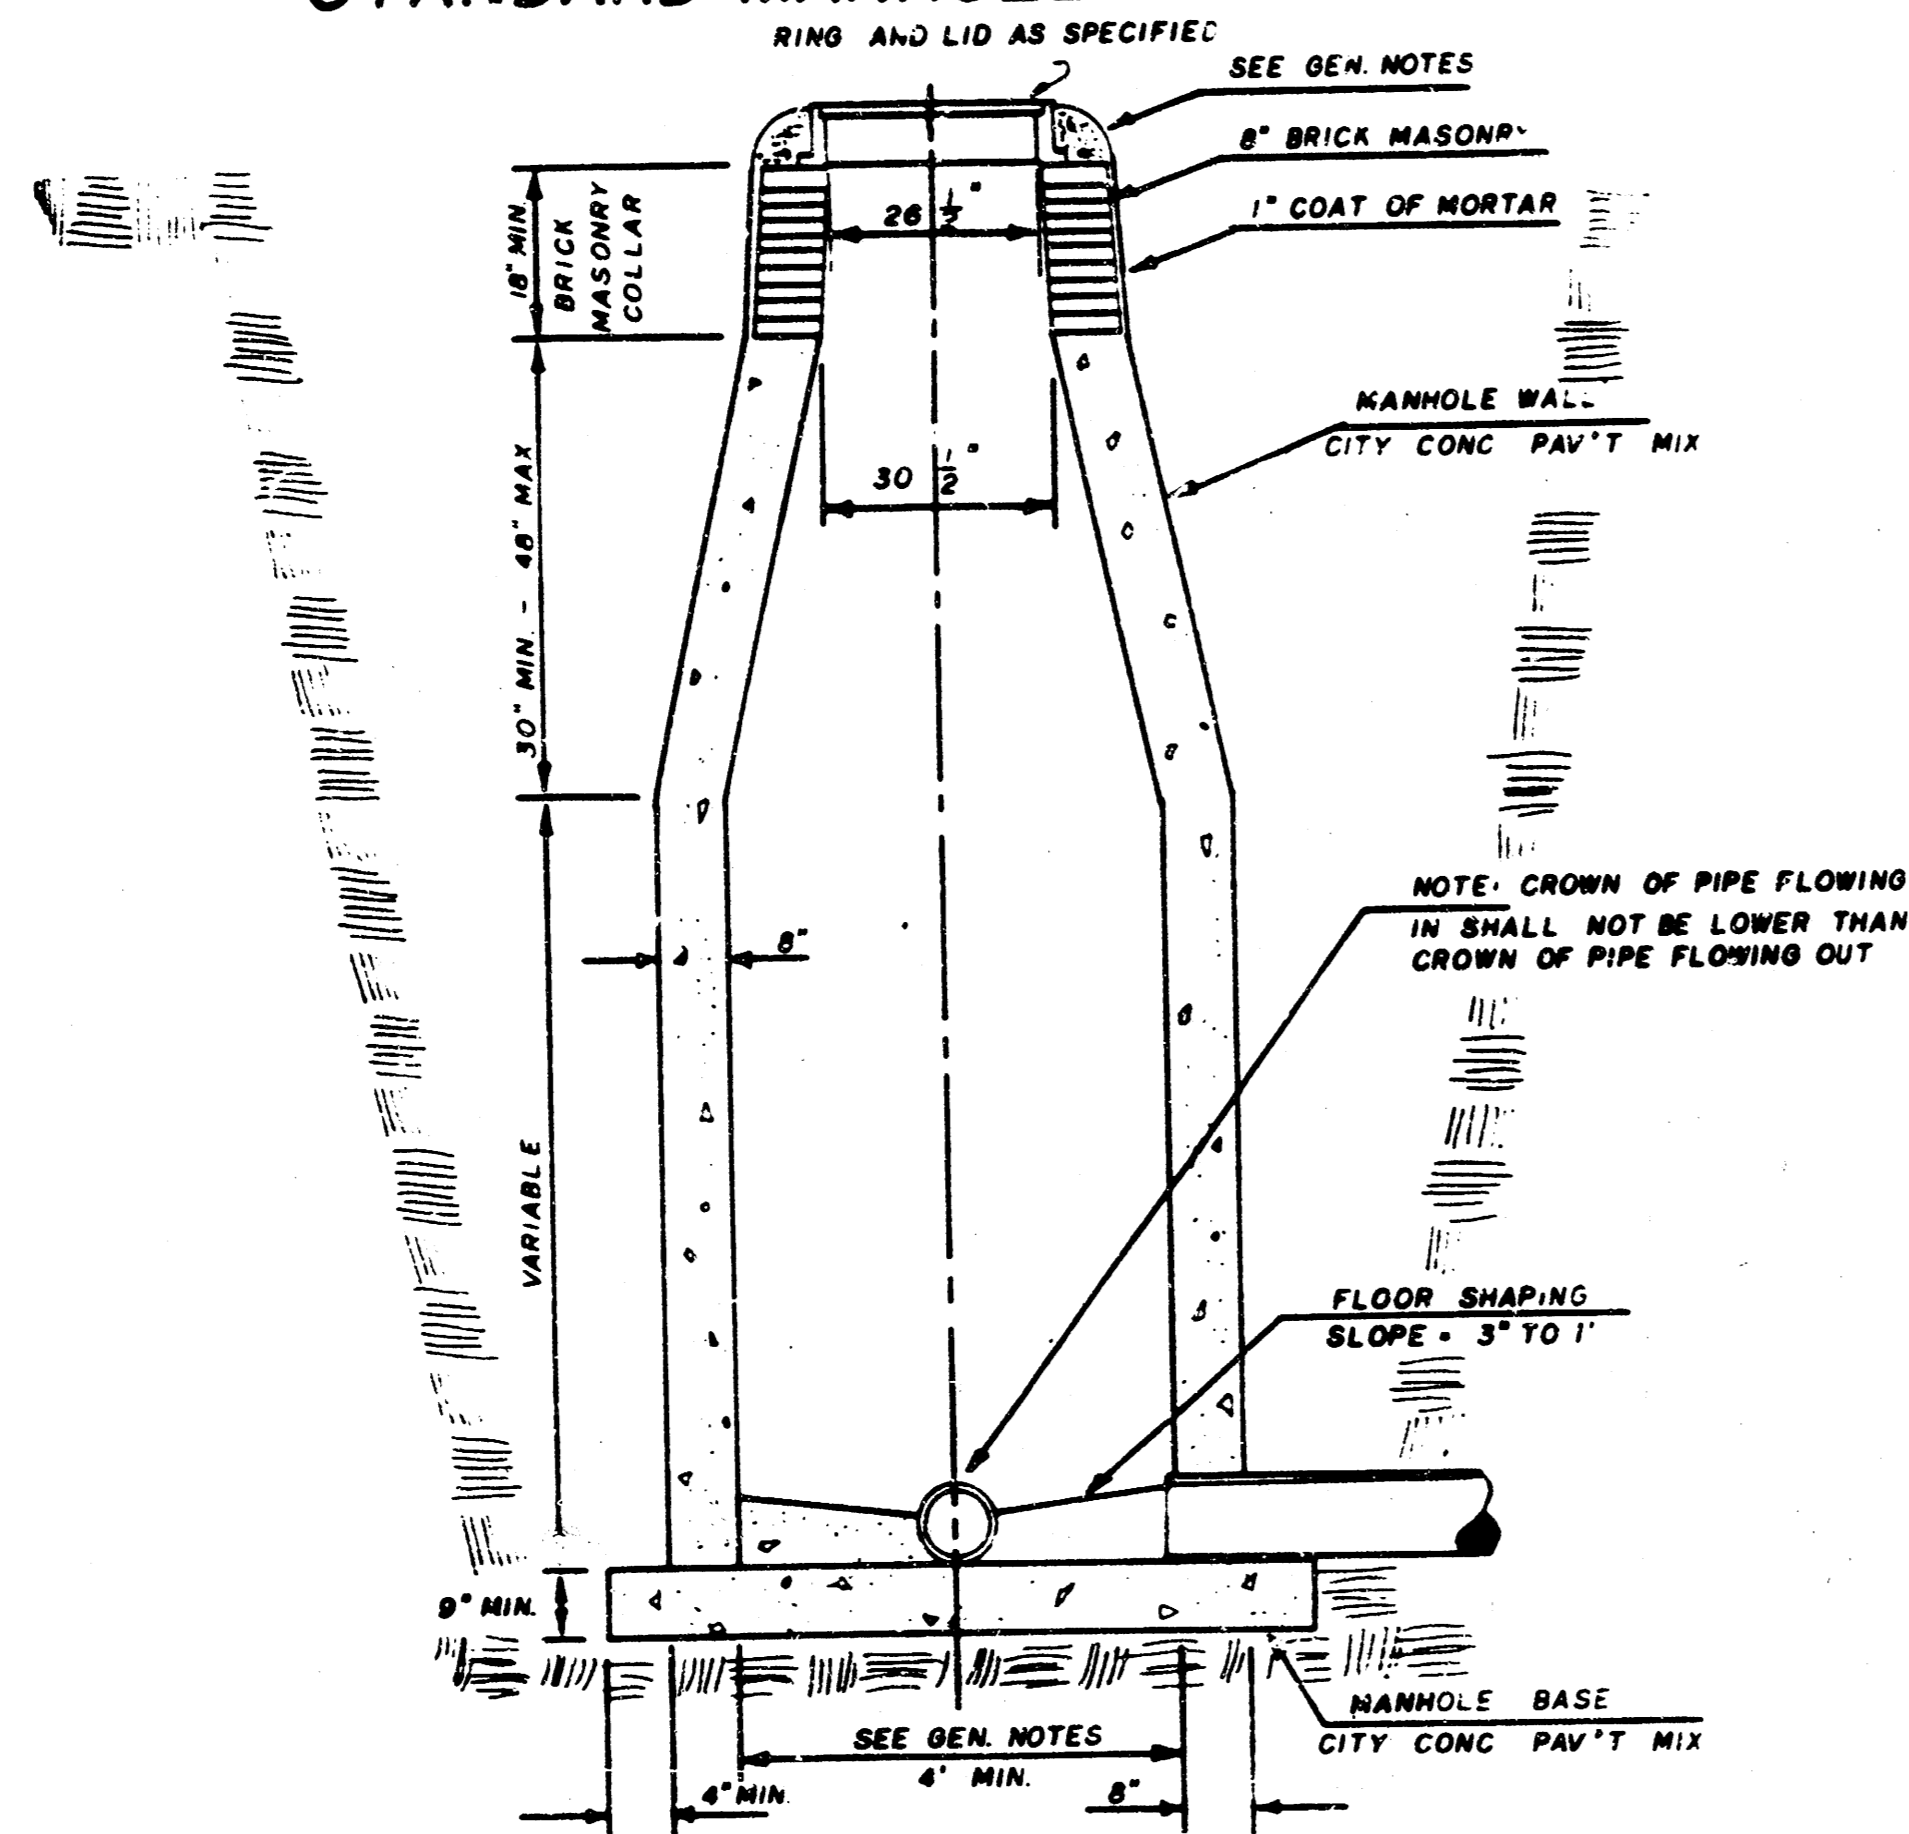

INSIDE DROP MANHOLE TYPE "C"

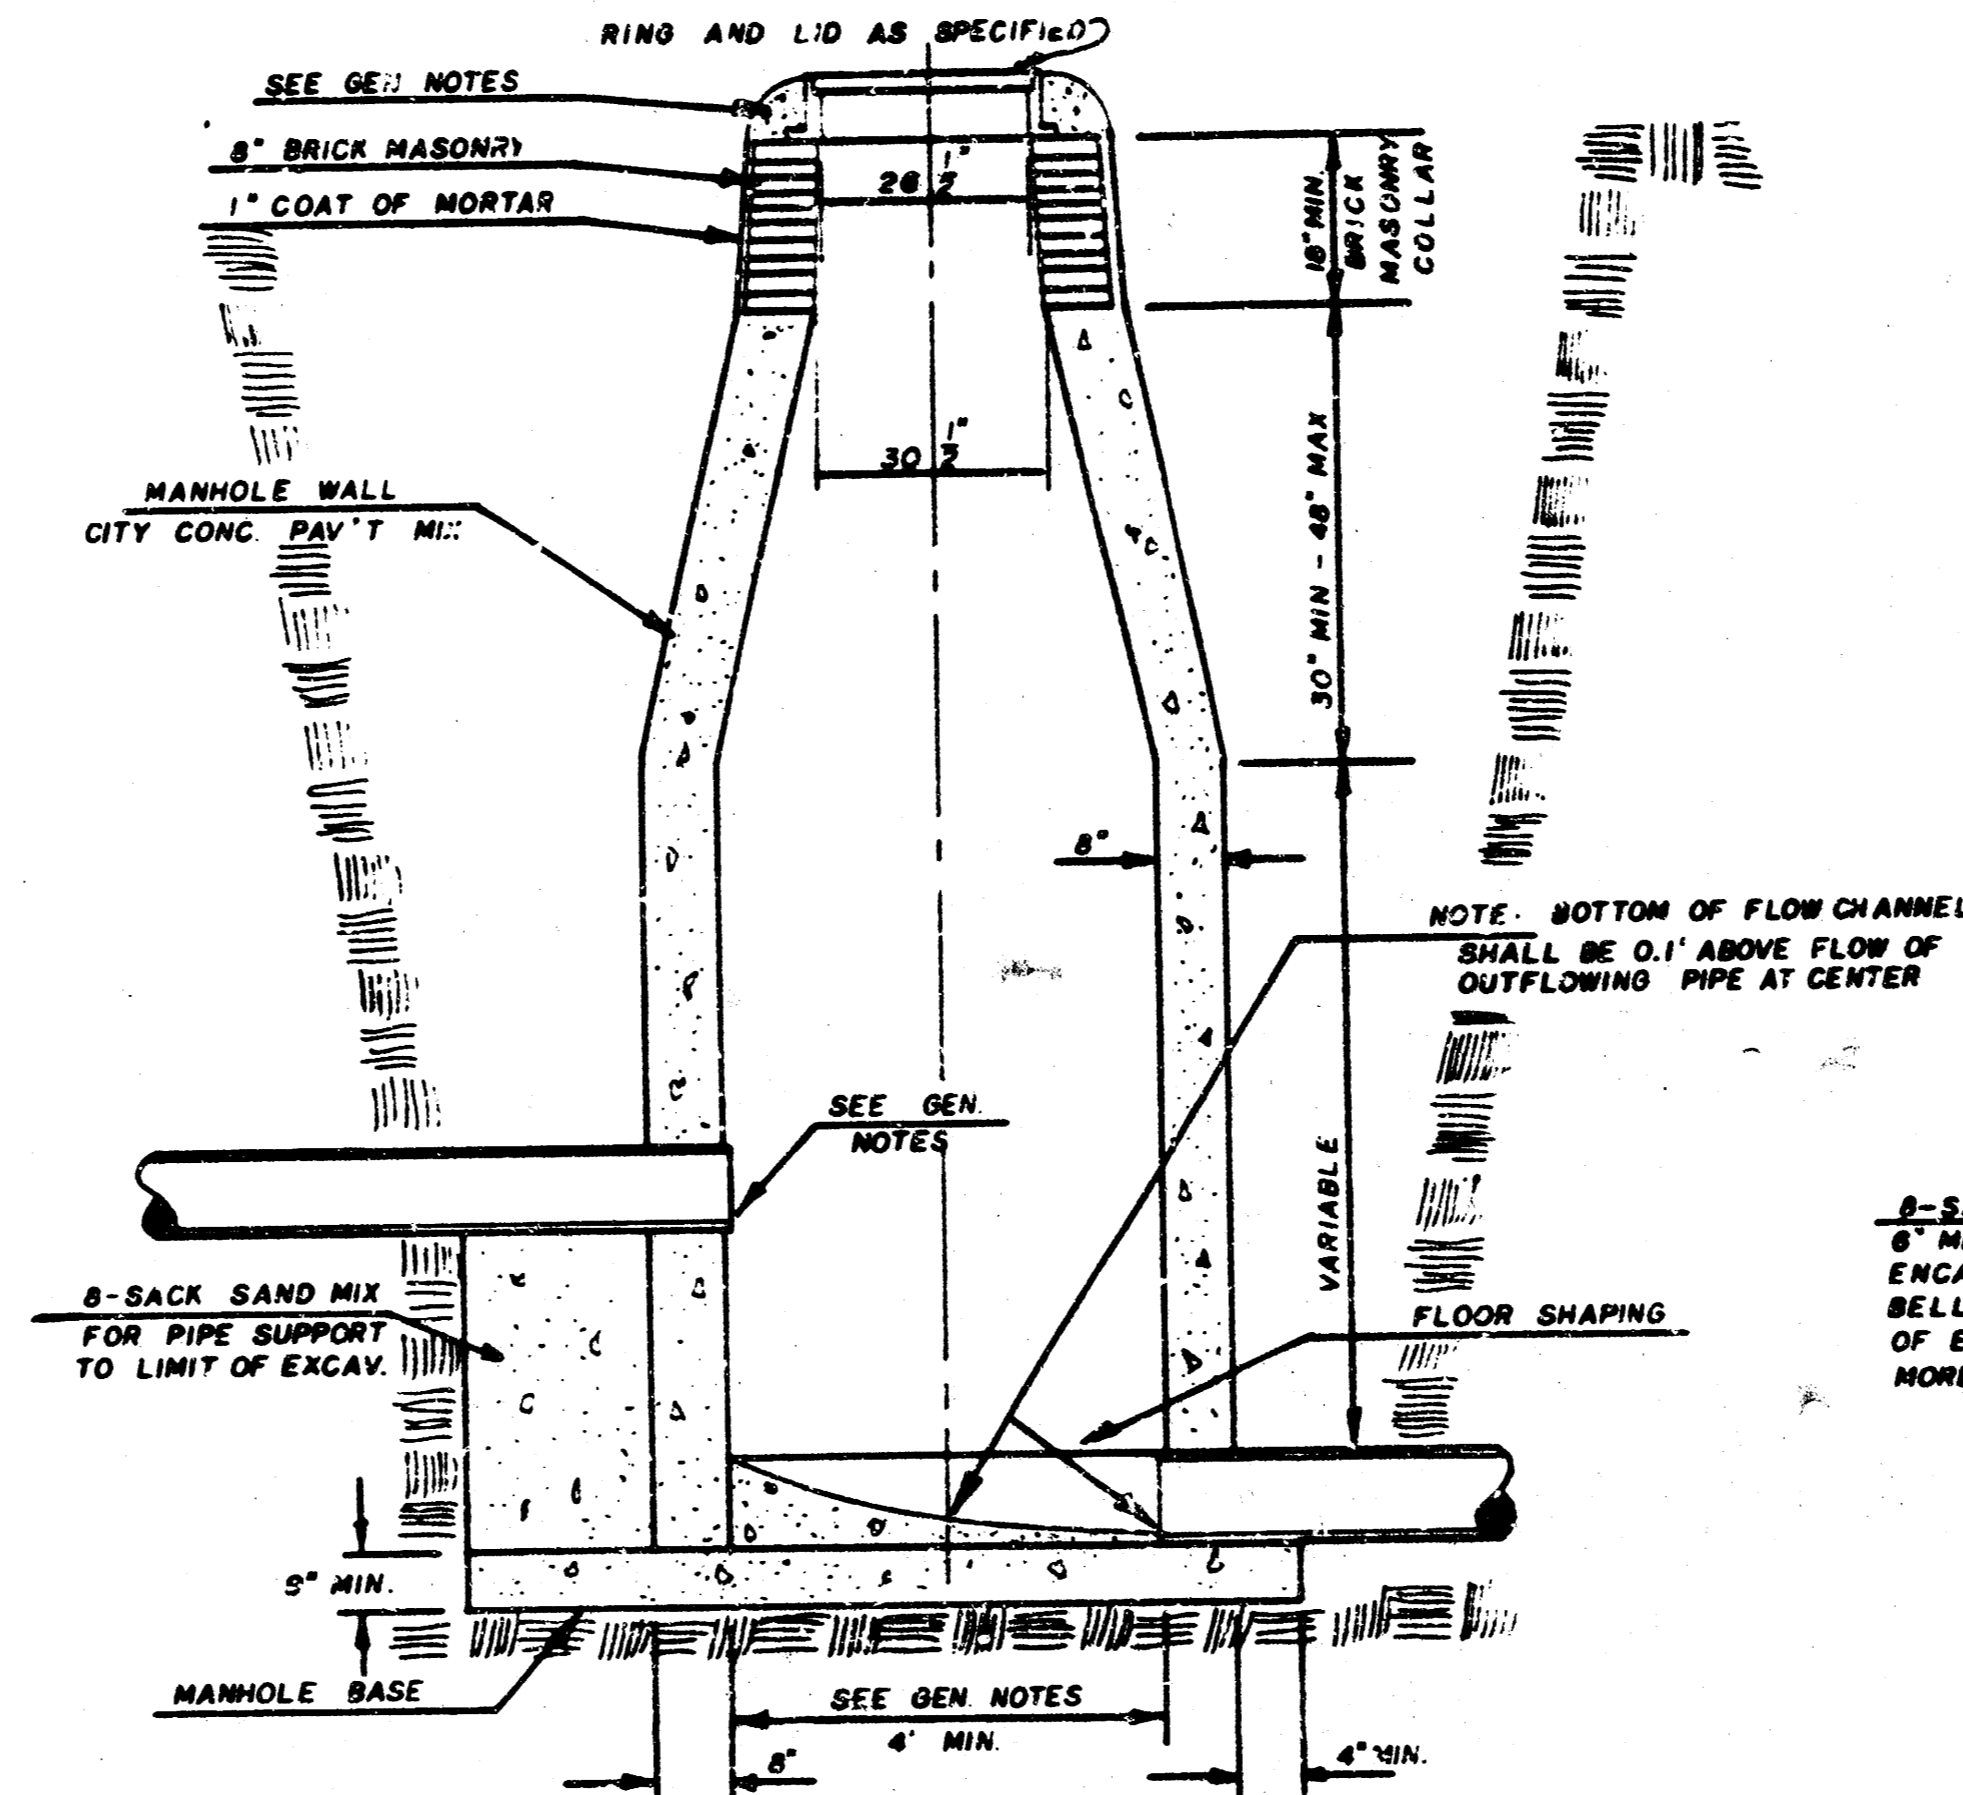

OUTSIDE DROP MANHOLE TYPE "C"

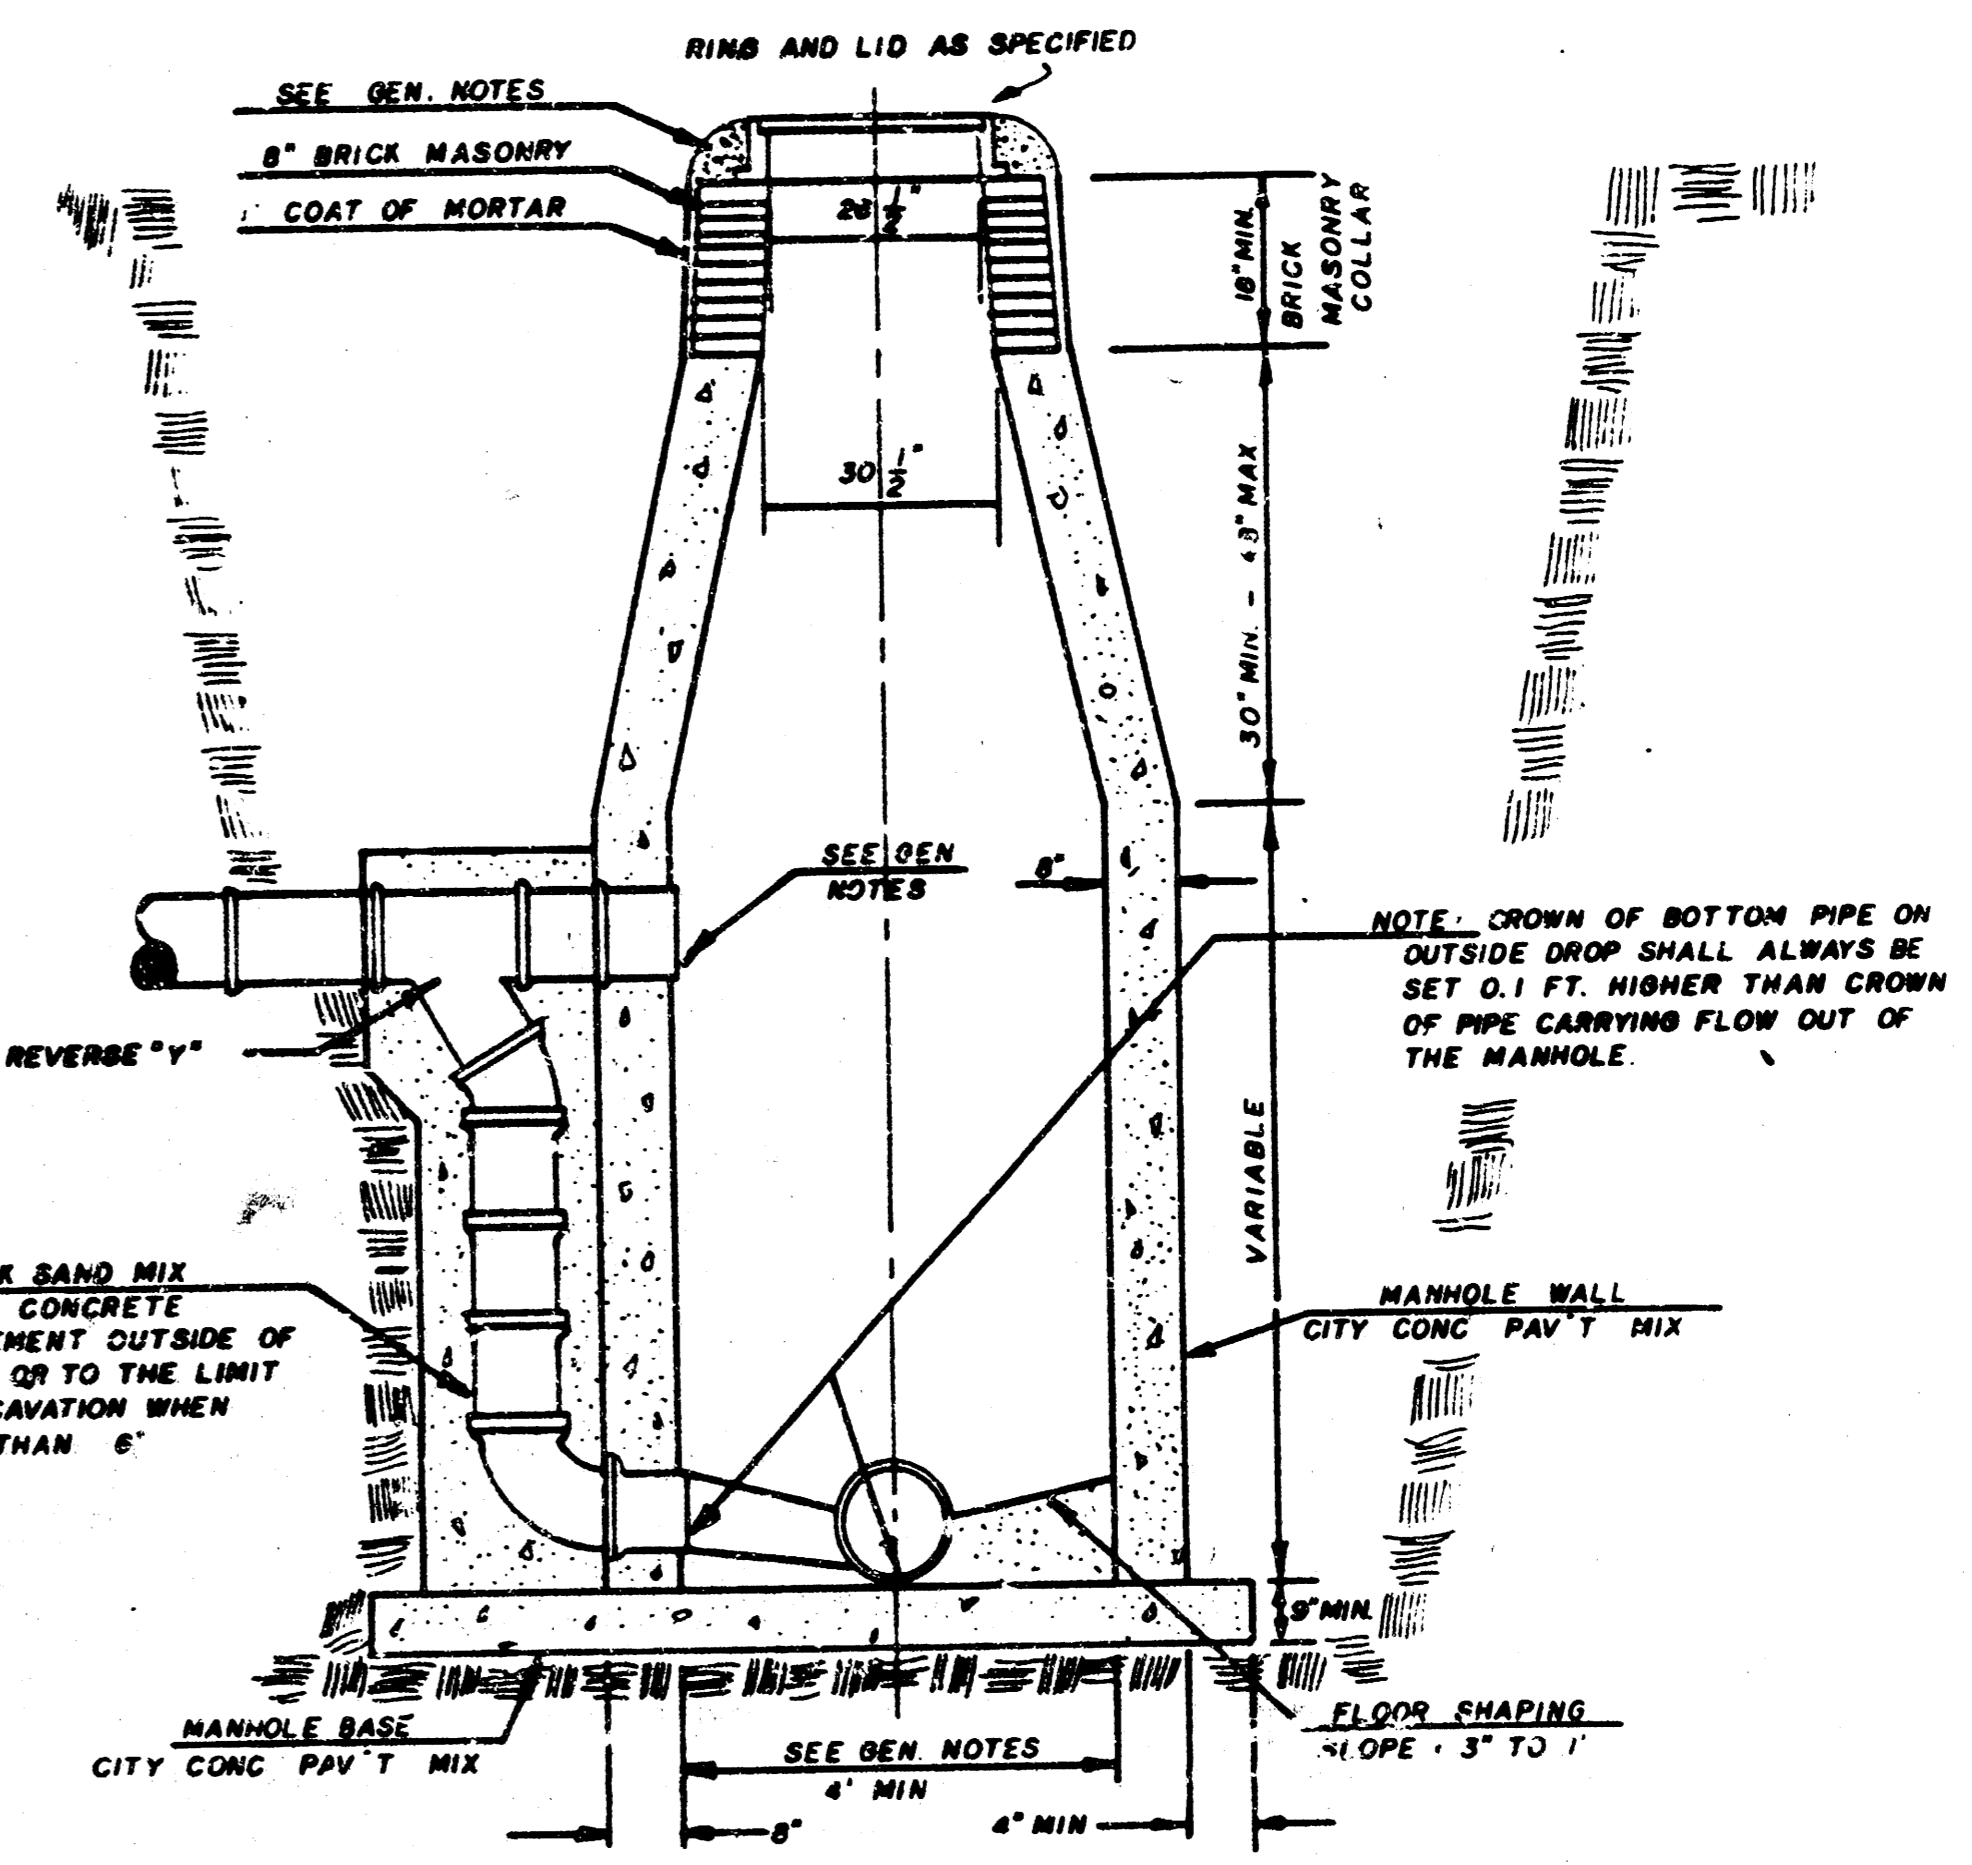

GENERAL NOTES

- MORTAR USED IN MASONRY CONSTRUCTION SHALL CONTAIN 8 SACKS OF CEMENT PER CUBIC YARD. CONCRETE USED IN MANHOLE WALLS AND BASES SHALL CONFORM TO THE REQUIREMENTS OF CONCRETE FOR CONCRETE PAVEMENT CONSTRUCTION AS SPECIFIED IN THE CITY STANDARD PAVING SPECIFICATIONS USING CITY CONCRETE PAVEMENT MIX WITHOUT AIR ENTRAINING ADMIXTURE. MORTAR SHALL BE PLACED AROUND THE MANHOLE RING AS SHOWN ON THE DRAWINGS WHEN MANHOLES ARE CONSTRUCTED IN UNPAVED AREAS. TYPE "C" MANHOLES CAN BE CONSTRUCTED ONLY WHERE PIPE SIZES ARE 8" OR SMALLER. THE INSIDE DIAMETER OF TYPE "C" MANHOLES SHALL BE 4'. COMPLETED MANHOLE SHALL BE WITHOUT LEAKS AND WATER TIGHT.
- REINFORCING STEEL SHALL BE INSTALLED IN THE MANHOLE BASE. REINFORCING STEEL SHALL CONSIST OF NO. 4 BARS PLACED ON 6" CENTERS IN BOTH DIRECTIONS. REINFORCING STEEL SHALL BE PLACED 8" ABOVE THE BOTTOM OF THE MANHOLE BASE. COST OF FURNISHING AND INSTALLING REINFORCING STEEL SHALL BE INCLUDED IN THE UNIT PRICE BID FOR THE MANHOLE.
- AN OPENING SHALL BE CUT IN THE MANHOLE WALL FOR THE UPPER INLET PIPE FOR INSIDE AND OUTSIDE DROP MANHOLES. THE UPPER INLET PIPE SHALL BE GROUTED INTO THIS OPENING WITH NON-SHRINKING GROUT. THE EXTERIOR OF THIS COMPLETED CONNECTION SHALL BE SEALED WITH AN APPROVED BITUMINOUS COATING SUCH THAT THE CONNECTION WILL BE WATER TIGHT.
- THE FLOORS OF ALL MANHOLES SHALL BE SHAPED WITH FLOW CHANNELS SUCH THAT THE MANHOLES WILL BE SELF-CLEANING AND FREE OF AREAS WHERE SOLIDS COULD BE DEPOSITED AS SEWAGE FLOWS THROUGH THE MANHOLE FROM ALL INLET PIPES TO THE OUTLET PIPE. FLOW CHANNELS SHALL BE FORMED TO MATCH THE BOTTOM HALVES OF THE INFLOWING PIPES AND THE OUTFLOWING PIPE AS SHOWN BY THE DRAWINGS EXCEPT FOR INSIDE DROP MANHOLES. FLOW CHANNELS FOR INSIDE DROP MANHOLES SHALL BE CONSTRUCTED AS INDICATED BY THE DRAWING. MANHOLE FLOORS SHALL HAVE SLOPES OF 3 INCHES PER FOOT IN THE AREAS OUTSIDE OF THE FLOW CHANNELS SLOPED TOWARD THE FLOW CHANNELS. PIPES LAID THROUGH MANHOLES SHALL HAVE THE TOP HALF REMOVED TO NEAT LINES FOR THE FULL INSIDE DIAMETER OF THE MANHOLE. MANHOLE FLOORS SHALL THEN BE SHAPED AROUND THE BOTTOM HALF OF THE PIPE WHICH FORMS THE FLOW CHANNEL.
- PIPES INSTALLED WITHIN THE EXCAVATION MADE FOR THE MANHOLE SHALL BE CRADLED WITH CONCRETE TO THE LIMITS OF THE MANHOLE EXCAVATION. WHEN CLAY PIPE IS USED, THE CRADLE SHALL EXTEND TO THE FIRST JOINT OUTSIDE THE MANHOLE. THE CRADLE SHALL BE TERMINATED AT THE CLAY PIPE JOINT IN A MANNER WHICH WILL MAINTAIN THE FLEXIBILITY OF THE JOINT. COST OF CRADLE WITHIN MANHOLE EXCAVATION OR TO CLAY PIPE JOINTS ADJACENT TO MANHOLE SHALL BE INCLUDED IN THE UNIT PRICE BID FOR THE MANHOLE.
- MANHOLE COVER CASTINGS AND MANHOLE FRAME CASTINGS SHALL CONFORM TO THE REQUIREMENTS AS INDICATED IN THE STANDARD SPECIFICATIONS AND AS SHOWN IN THE STANDARD DETAIL DRAWING.
- THE VERTICAL DROP IN INSIDE DROP MANHOLES SHALL NOT EXCEED 4' FOR INFLOWING PIPES SIZED 12" OR SMALLER AND 2' FOR INFLOWING PIPES LARGER THAN 12". THE CROWNS OF INFLOWING PIPES SHALL NEVER BE SET LOWER THAN THE CROWN OF THE OUTFLOWING PIPE.
- STANDARD MANHOLES TYPE "C" AND STANDARD INSIDE DROP MANHOLES TYPE "C" SHALL BE BID AS STANDARD MANHOLES FOR THE TYPE AND DIAMETER INDICATED. OUTSIDE DROP MANHOLES TYPE "C" SHALL BE BID AS STANDARD OUTSIDE DROP MANHOLES FOR THE TYPE AND DIAMETER INDICATED. ALL MANHOLE DIAMETERS WILL BE 4' UNLESS INDICATED OTHERWISE.

MANHOLE FRAME AND COVER DETAIL


ADOPTED AS STANDARD DESIGN

BY


City of Wichita, Kansas

MANHOLE COVER


Weight: 180 Lbs.

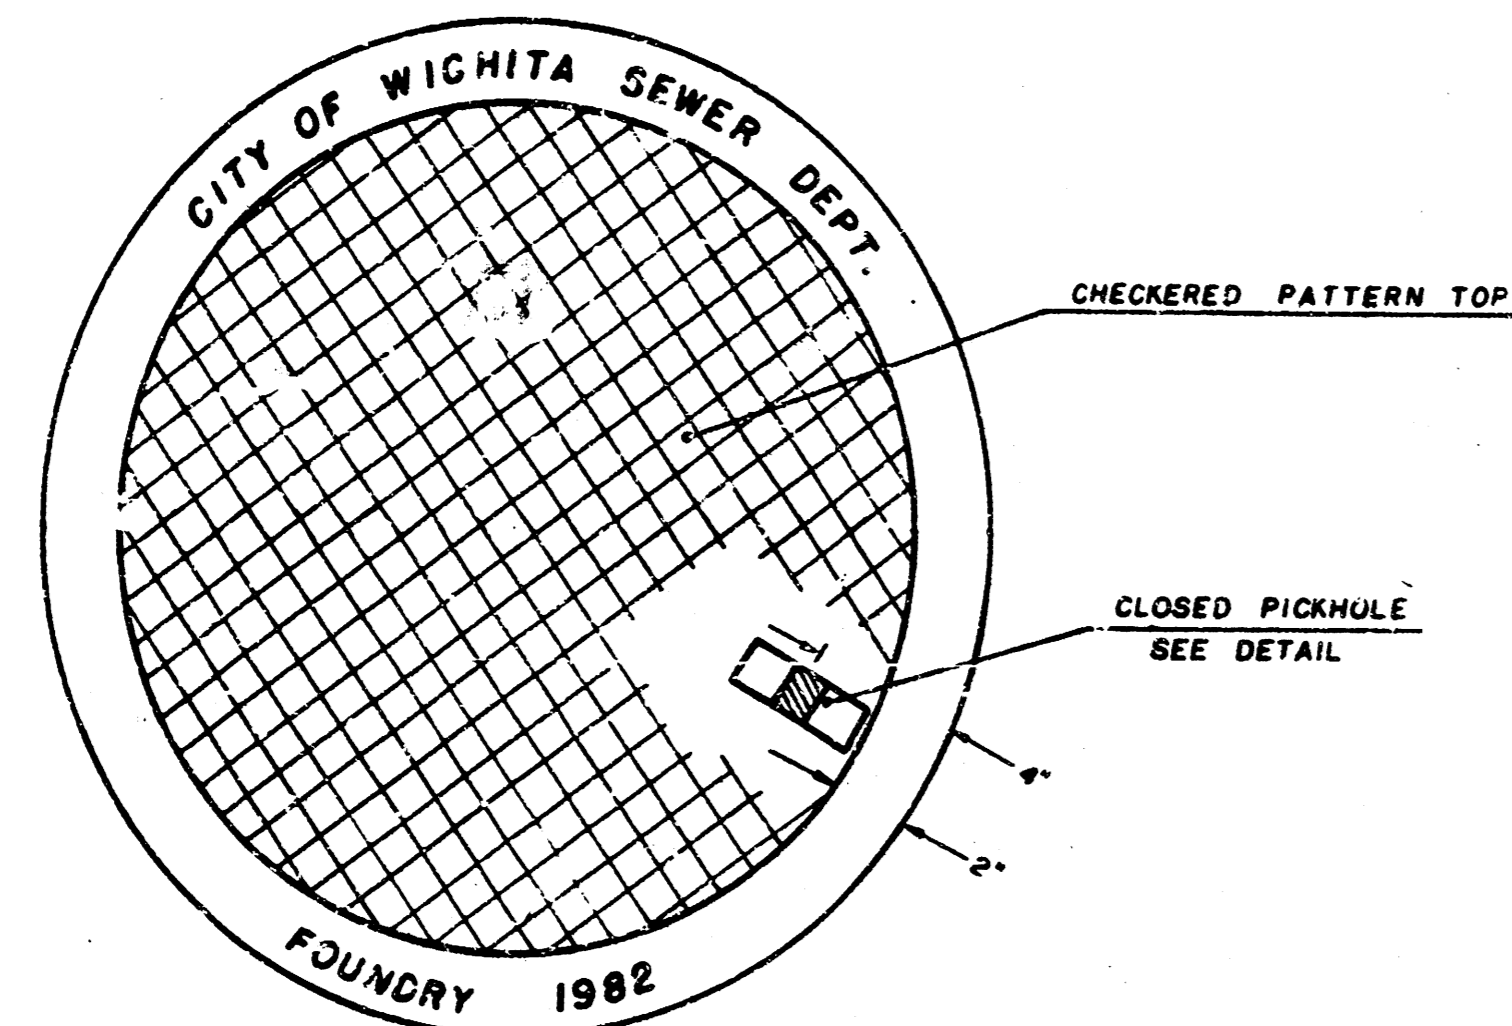

TOP VIEW

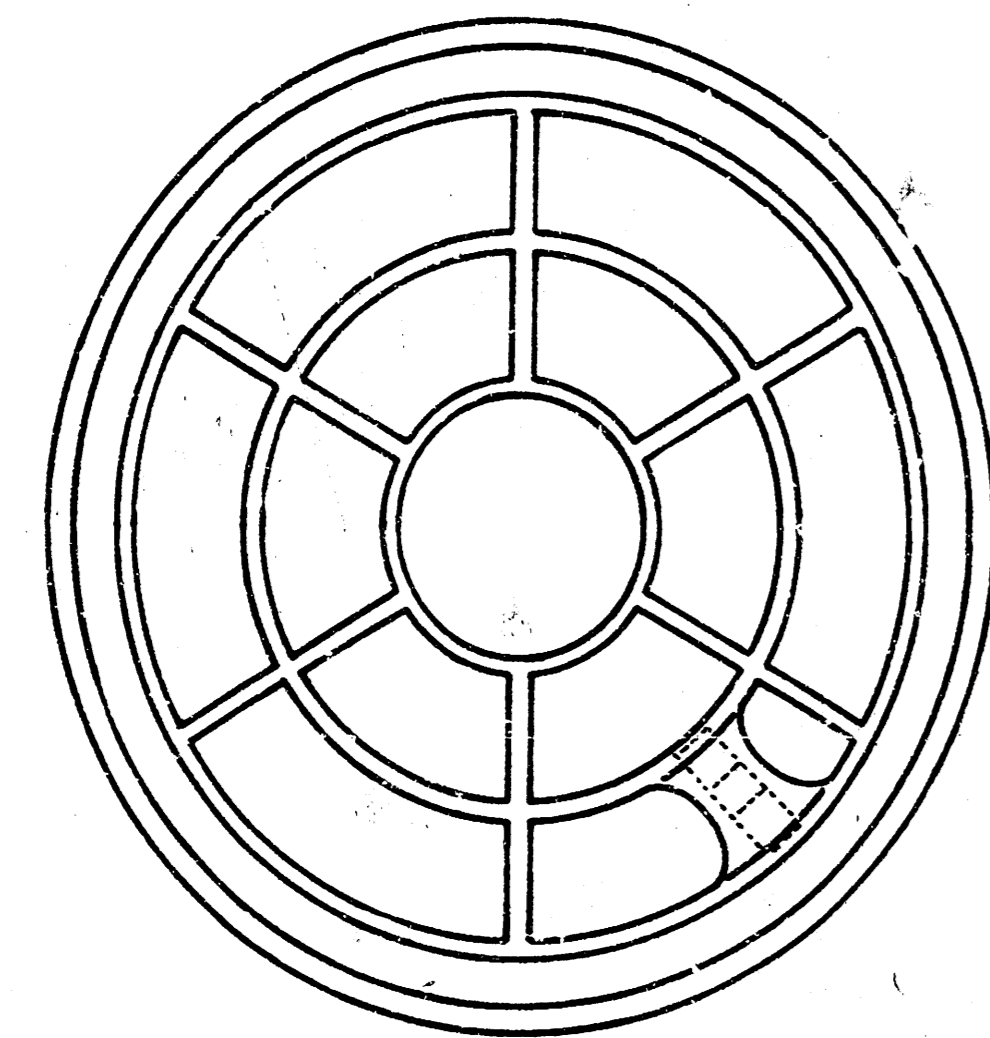


BOTTOM VIEW

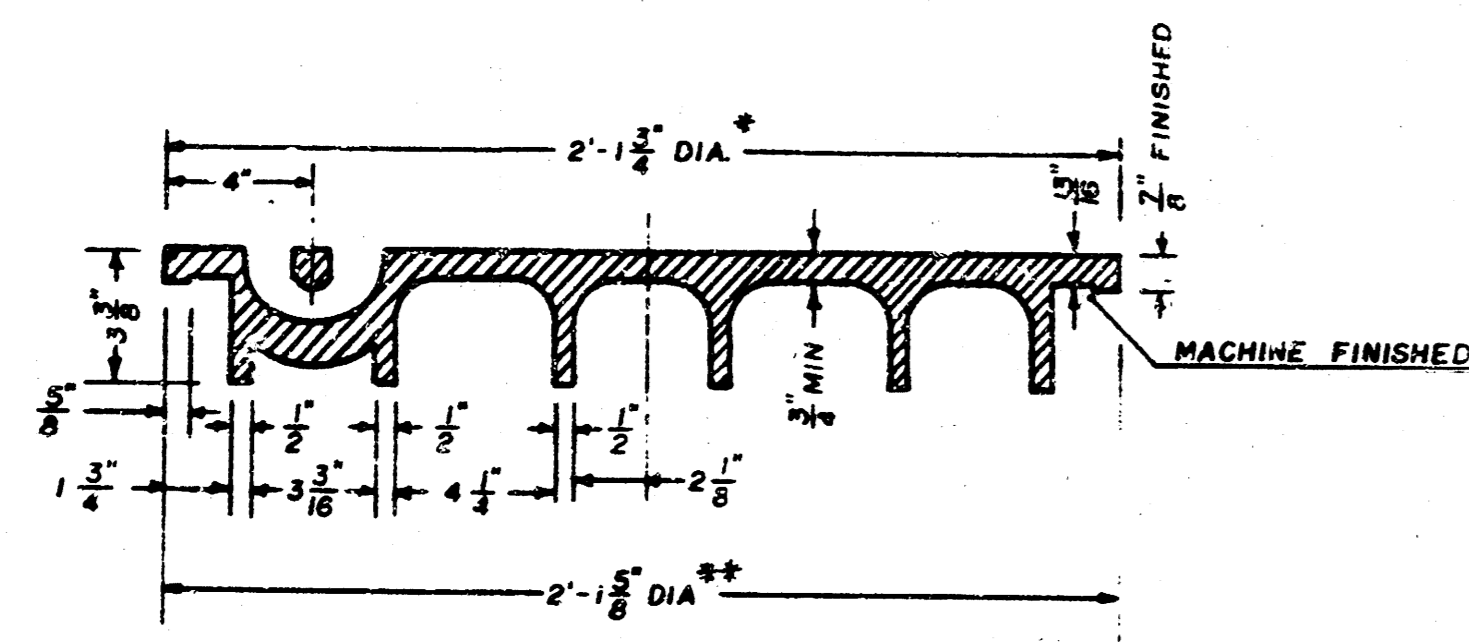

SECTION VIEW

* OUTSIDE DIA. TOP OF COVER
** OUTSIDE DIA. BOTTOM OF COVER


PICKHOLE DETAIL

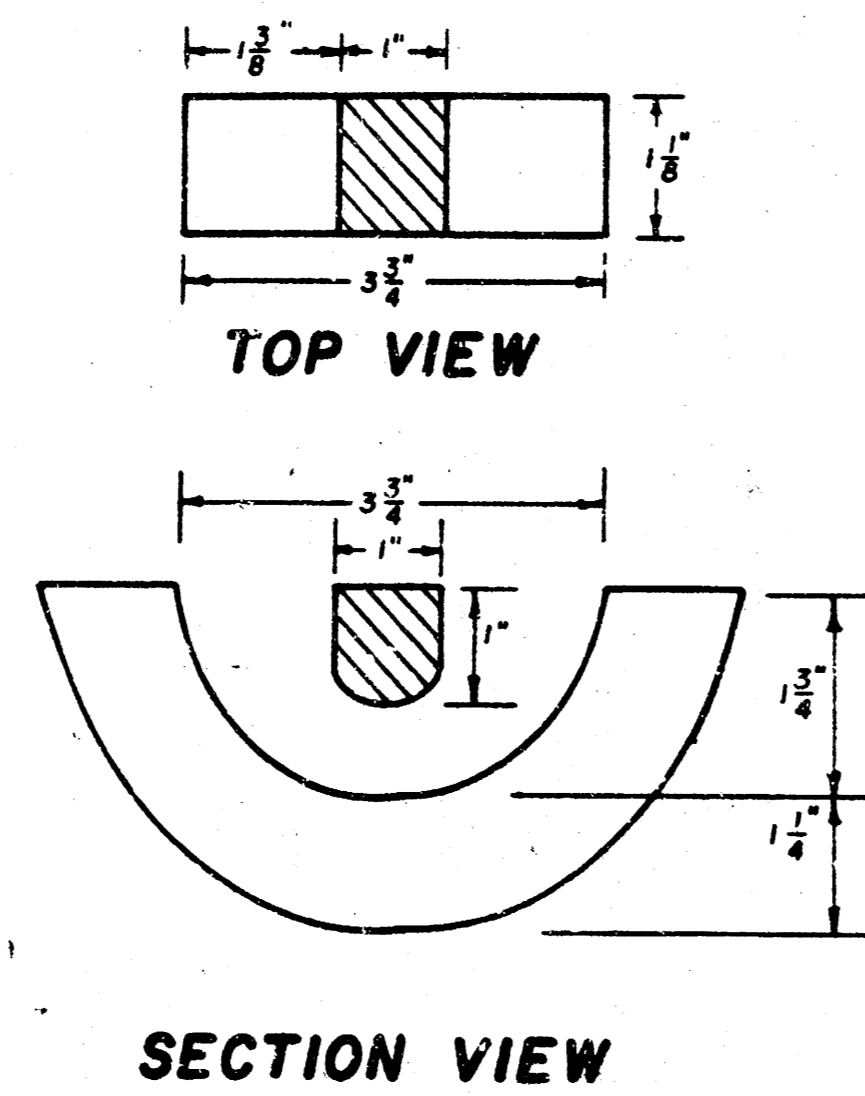


SECTION VIEW

MANHOLE FRAME

Weight: 240 Lbs.

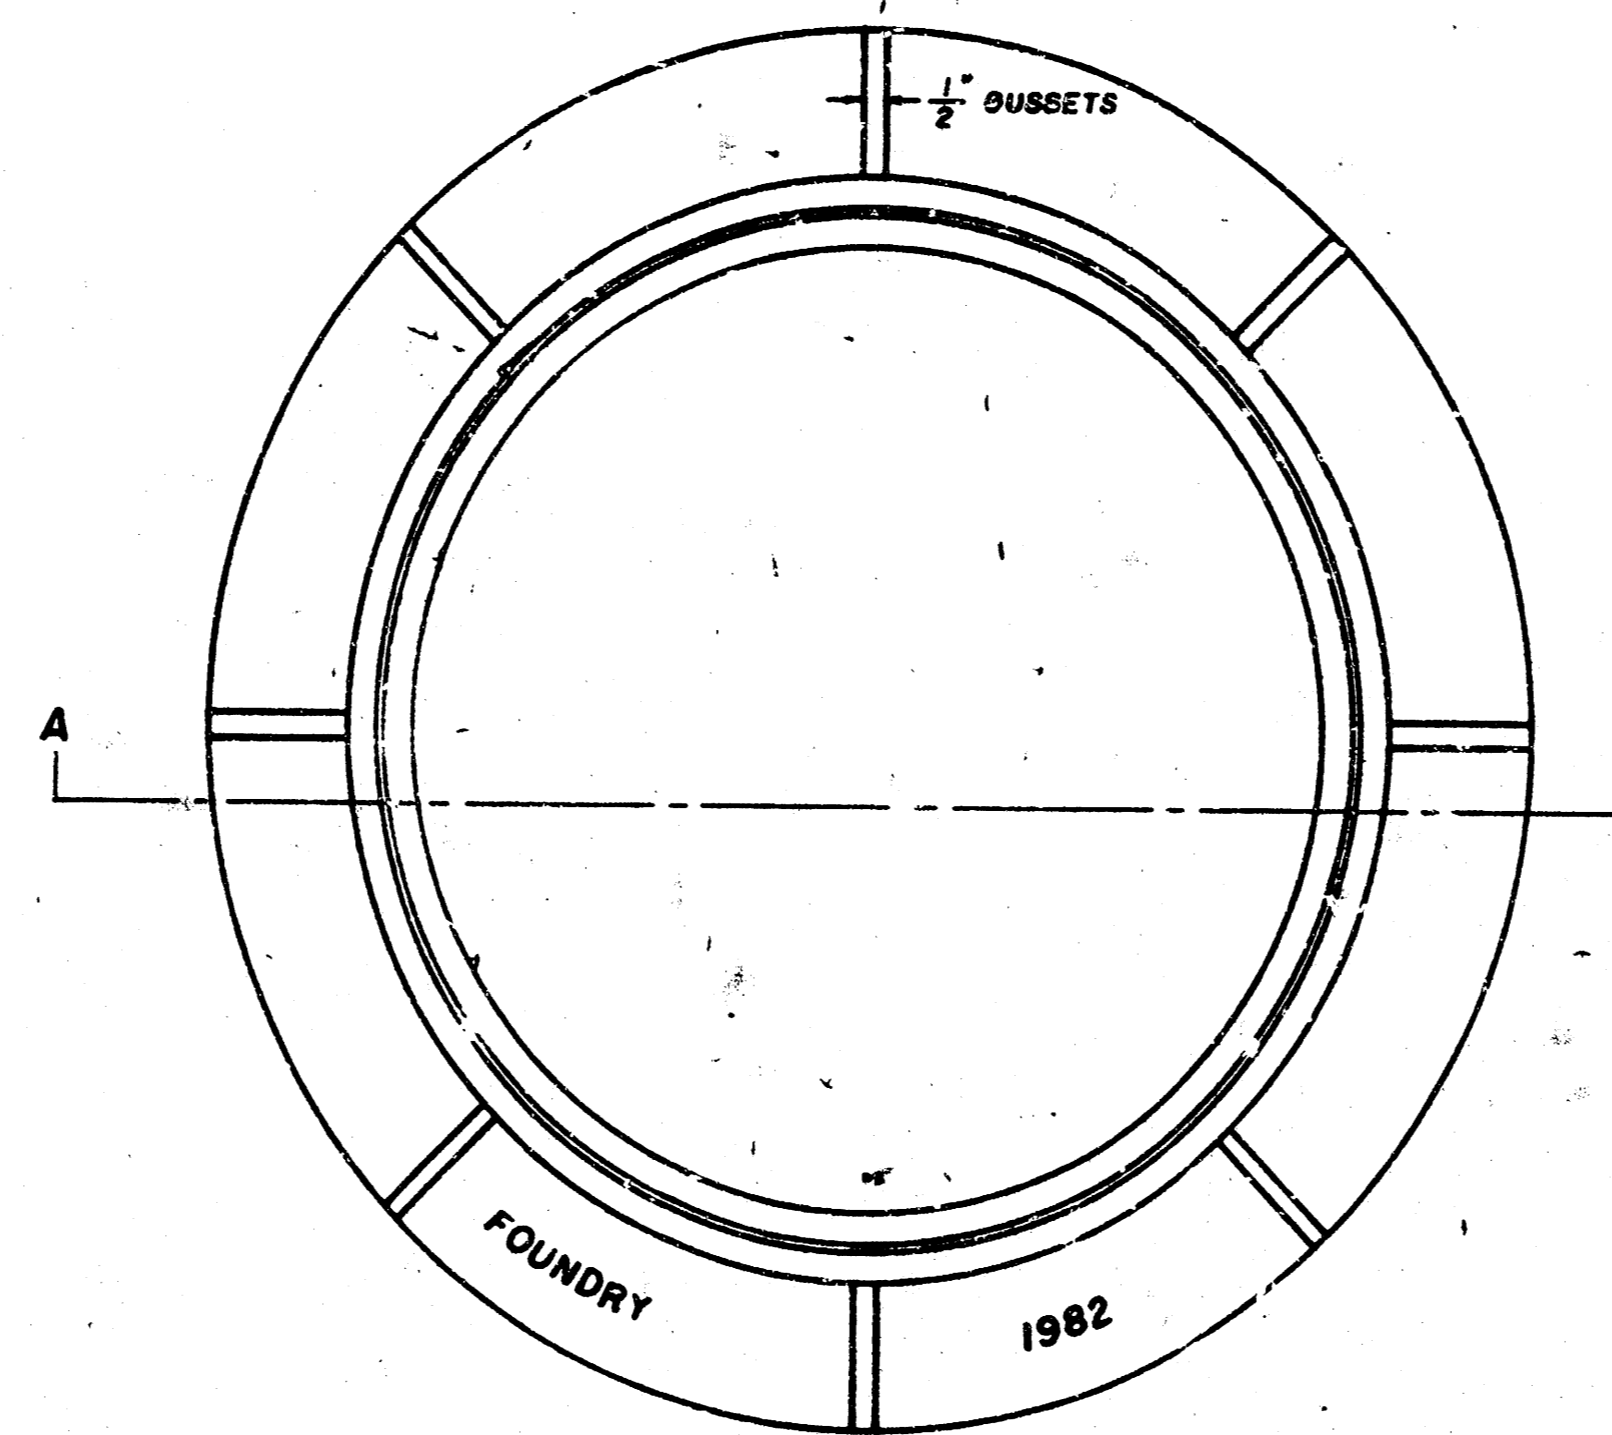

TOP VIEW

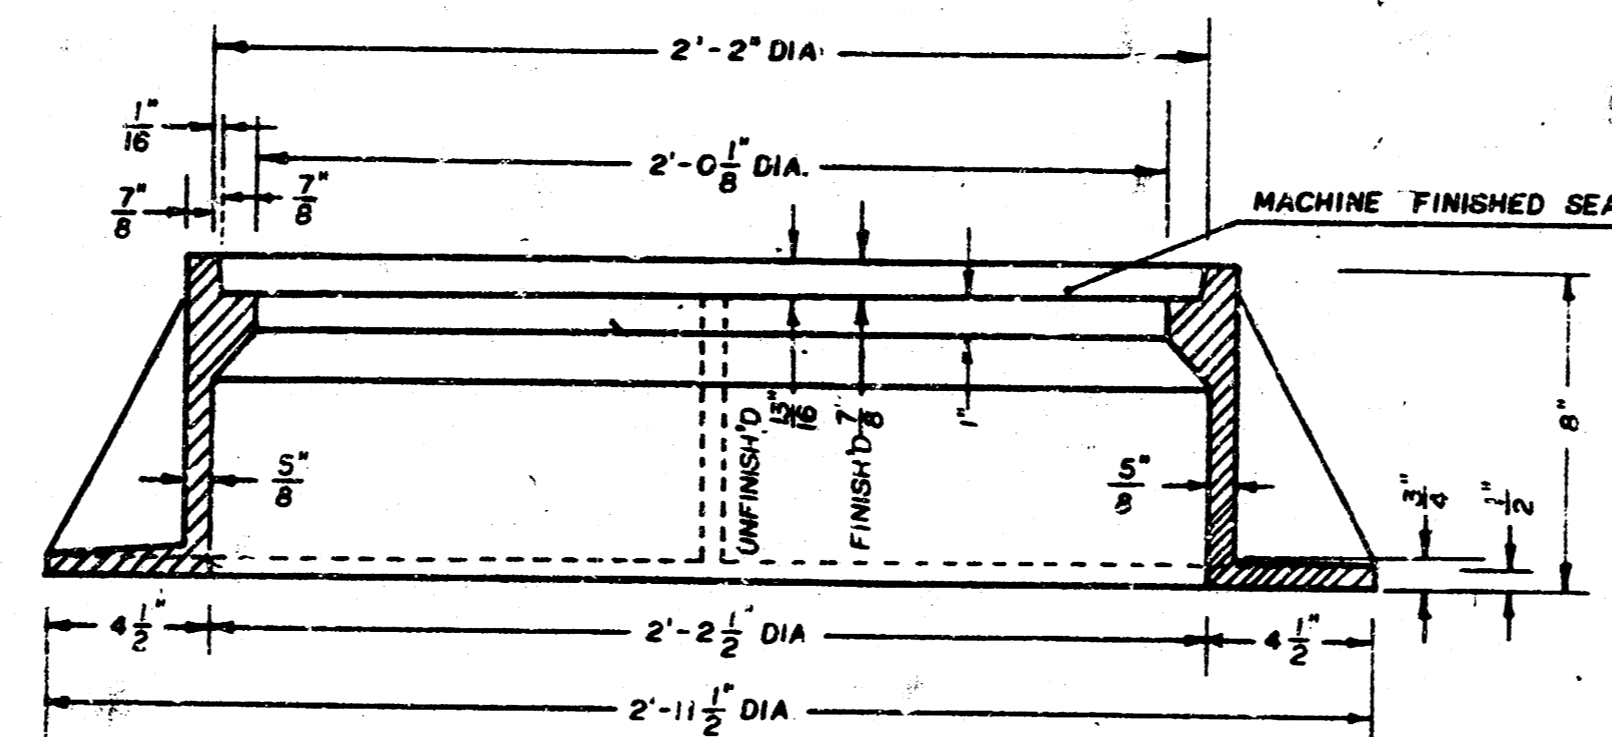

SECTION A-A

GENERAL NOTES


1. MANHOLE CASTINGS SHALL BE MANUFACTURED USING GOOD QUALITY GRAY IRON CONFORMING TO CLASS 30 OF A.S.T.M. DESIGNATION A-48. DIMENSIONS AND WEIGHTS SHOWN ON THE DETAILED DRAWINGS SHALL BE CONSIDERED AS MINIMUM REQUIREMENTS AND ANY DEVIATIONS FROM THE DIMENSIONS SHOWN MUST BE SPECIFICALLY APPROVED. THE FINISHED CASTINGS SHALL BE OF UNIFORM QUALITY, FREE FROM BLOWHOLES, POROSITY, HARD SPOTS, SHRINKAGE DISTORTIONS OR OTHER DEFECTS.
2. MANHOLE CASTINGS SHALL BE COATED WITH AN ASPHALT PAINT RESULTING IN A SMOOTH, TOUGH AND TENACIOUS COATING WHICH IS NOT BRITTLE OR TACKY.
3. MANHOLE CASTINGS SHALL BE MANUFACTURED SUCH THAT A COVER MANUFACTURED BY ANY ONE FOUNDRY WILL FIT INTERCHANGEABLY INTO A FRAME MANUFACTURED BY ANOTHER FOUNDRY AND STILL MEET ALLOWABLE CLEARANCES AND NON-ROCKING REQUIREMENTS. THIS WILL REQUIRE MANUFACTURING OF THE MATCHING FACES ON THE COVER AND THE FRAME TO CLOSE TOLERANCES.
4. THE OUTSIDE CIRCUMFERENCE OF THE VERTICAL FACE OF THE COVER AND THE INSIDE CIRCUMFERENCE OF THE VERTICAL FACE IN THE FRAME RECESS SHALL BE MANUFACTURED TO TOLERANCES SUCH THAT THE CLEARANCE BETWEEN THE COVER AND FRAME WILL NOT EXCEED 1/8" AT ANY POINT AROUND THE CIRCUMFERENCE OF THE COVER. THE SEATING SURFACES BETWEEN THE COVER AND FRAME SHALL BE MACHINED SUCH THAT THESE SURFACES SHALL MAKE FULL CONTACT FOR THEIR FULL CIRCUMFERENCE TO PRECLUDE THE COVER FROM ROCKING IN THE FRAME.
5. THE MANHOLE FRAME AND COVER SHALL BE MARKED WITH LETTERING INDICATING THE NAME OF THE MANUFACTURER AND THE YEAR WHEN THE COVER OR FRAME WAS CAST. THE COVER SHALL BE FURTHER IDENTIFIED WITH REGARDS TO OWNERSHIP USING LETTERS AT LEAST 1" IN HEIGHT. THIS IDENTIFICATION SHALL BE "CITY OF WICHITA SEWER DEPARTMENT". THE WORD DEPARTMENT MAY BE ABBREVIATED. THE TEXTURE OF THE TOP SURFACE OF THE COVER SHALL BE MANUFACTURED IN A CHECKERED PATTERN DESIGN AS INDICATED ON THE DRAWINGS. SMOOTH BLOCKOUTS SHALL BE UTILIZED TO HIGHLIGHT THE LETTERING ON THE COVER SURFACE. THE TOTAL AREA OF SMOOTH SURFACE BLOCKOUT SHALL NOT EXCEED THE AREA AS INDICATED ON THE DRAWING. POSITIONING OF SMOOTH BLOCKOUTS AND LETTERING MAY VARY FROM THAT SHOWN ON THE DETAILED DRAWING.

VERTICAL RISER DETAIL


ADOPTED AS STANDARD DESIGN

BY

CITY OF WICHITA, KANSAS

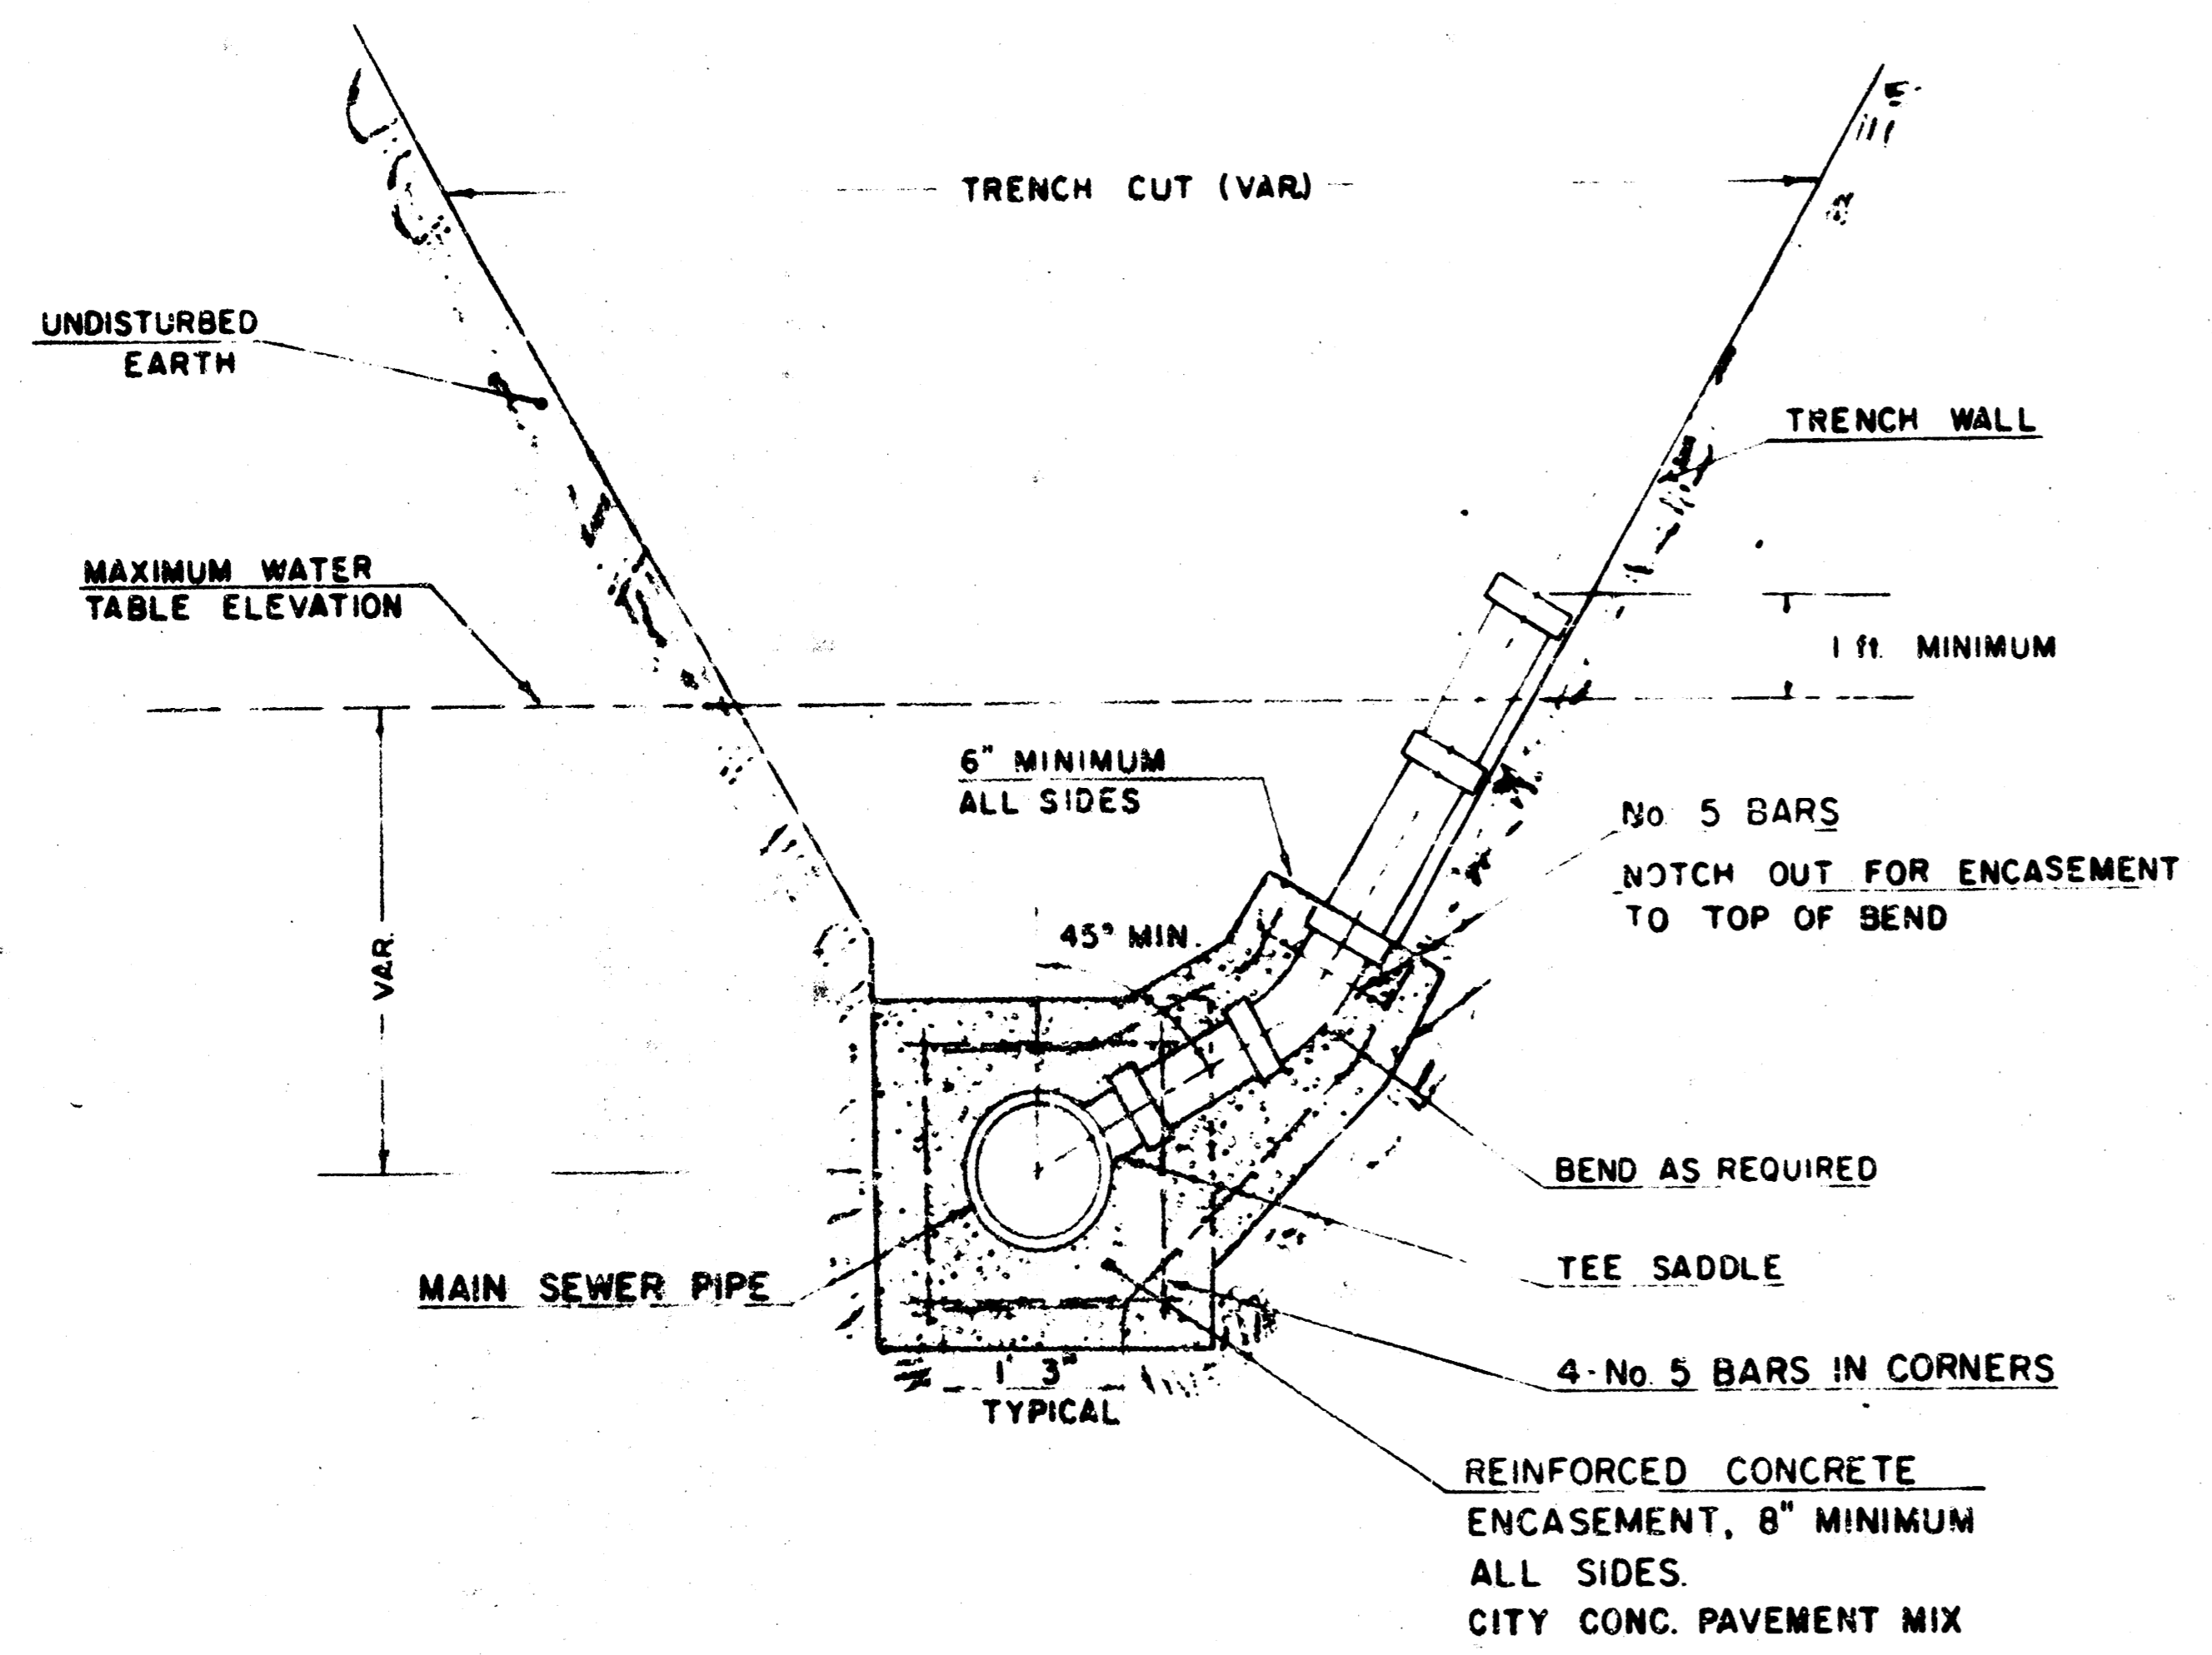


TYPICAL RISER FOR SLOPING TRENCH WALLS

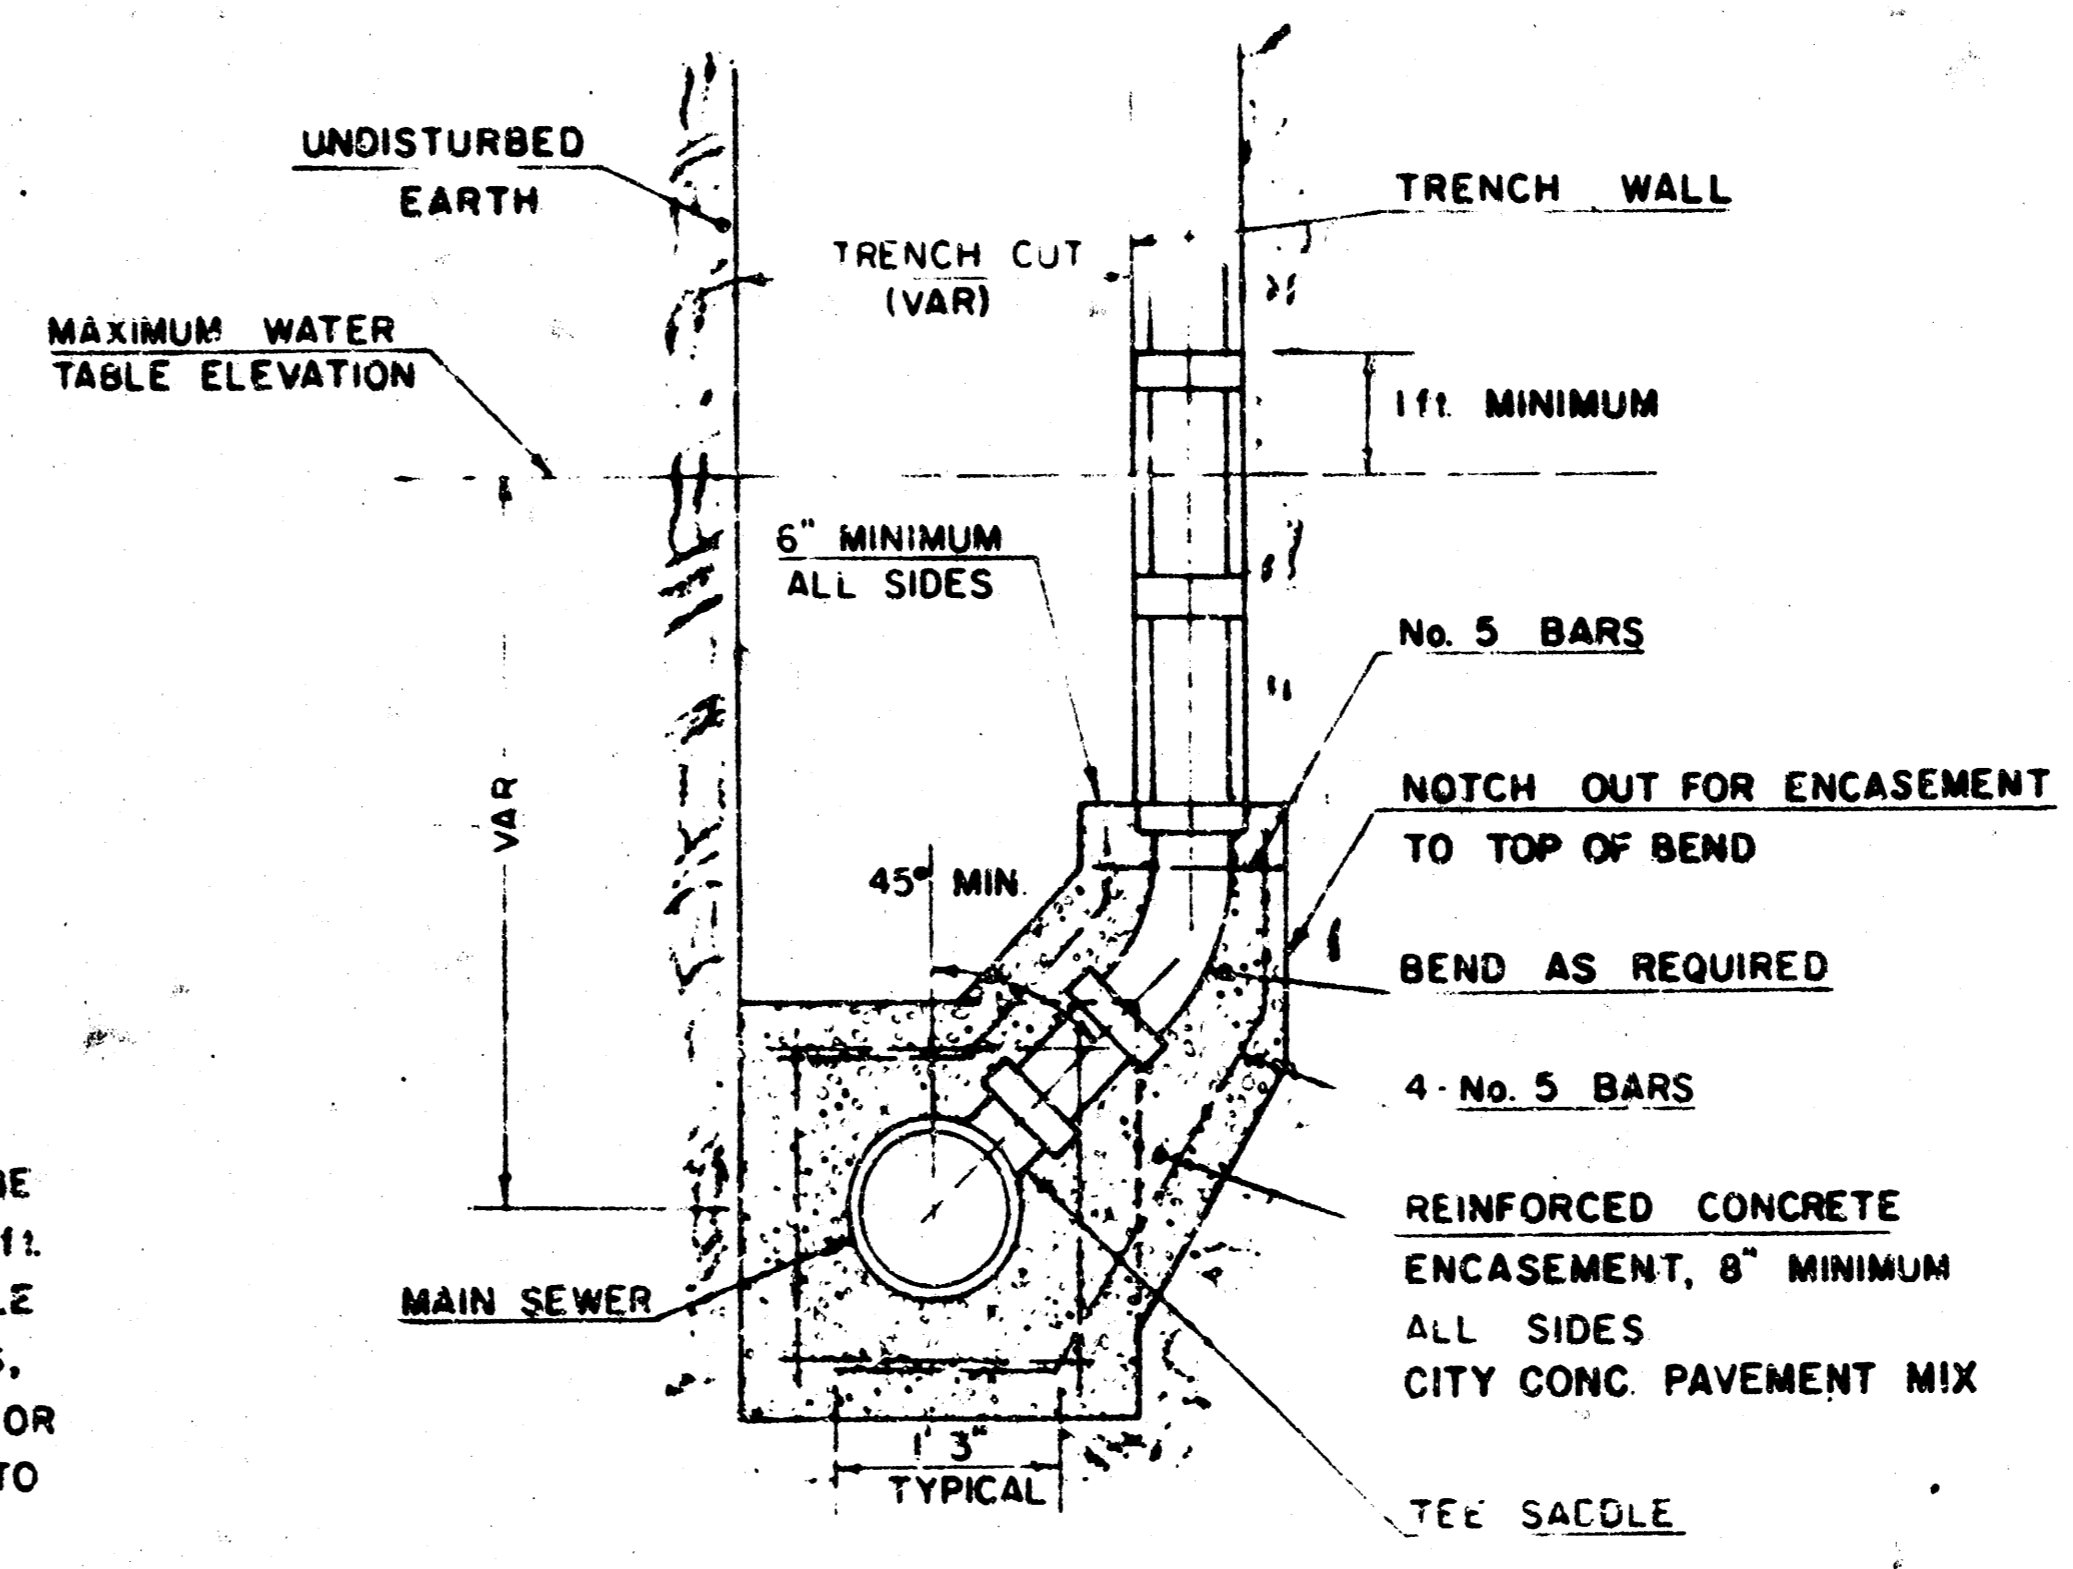

TYPICAL RISER FOR VERTICAL TRENCH WALLS

NOTE:
TOP OF 4" OR 6" RISER PIPE TO BE EXTENDED TO AN ELEVATION OF 1 ft. MINIMUM ABOVE THE WATER TABLE ELEVATION, WHEN WATER EXISTS, OR TO AN ELEVATION SUITABLE FOR PROVIDING SERVICE TO THE LOT TO BE SERVED AND THEN PLUGGED.

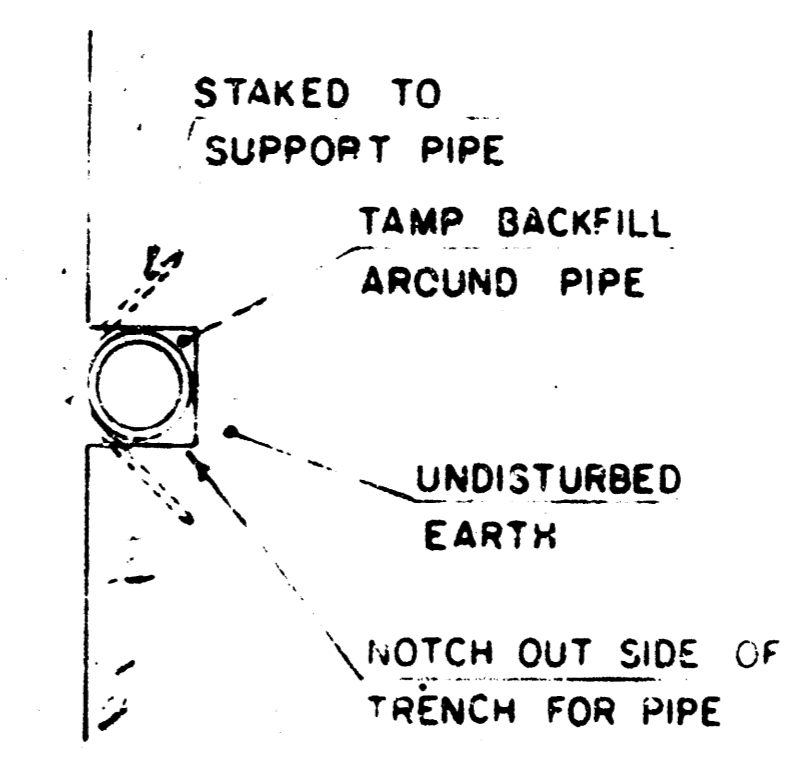

INTERNAL VIEW

PIPE SIZES AND RISERS INSTALLED TO SERVE COMMERCIAL OR INDUSTRIAL PROPERTY SHALL INCLUDE PIPE STUBS AND RISERS INSTALLED TO SERVE RESIDENTIAL PROPERTY MAY BE EITHER 4" OR 6" DIA. DEPENDING UPON AVAILABLE RADIUS AND SHALL BE DETERMINED BY THE FIELD ENGINEER. ENCASEMENT SHALL BE REINFORCED CLAY MAIN SEWER PIPE SHALL BE 12" DIA. AT THE POINT OF THE MAIN SEWER PIPE ON EACH SIDE OF THE RISER IN ALL INSTALLATIONS. ENCASEMENT OF ALL CONDUIT FOR P.V.C. MAIN SEWER PIPE SHALL BE A MINIMUM OF 12" DIA. ON BOTH SIDES OF THE DIA. OF THE RISER. FOUR (4) INCH AND SIX (6) INCH RISER PIPE SHALL BE ENCASED IN CONCRETE. THE TOP OF THE ENCASEMENT SHALL BE AS INDICATED IN THE DRAWINGS. FOUR (4) INCH AND SIX (6) INCH CLAY PIPE FOR RISERS SHALL BE ENCASED IN PIPE CONFORMING TO THE REQUIREMENTS OF THE LATEST REVISIONS OF A.S.T.M. DESIGNATION C-111. COMPRESSION TESTS AS SPECIFIED FOR CLAY PIPE IN THE STANDARD SPECIFICATIONS. FOUR (4) INCH AND SIX (6) INCH A.S.T.M. OR P.V.C. PIPE SHALL BE APPROVED FOR USE IN THE CITY BY THE CHIEF ENGINEER AND THE LOCAL INSPECTOR FOR THE CENTRAL INSPECTION DIVISION OF THE DEPARTMENT OF PUBLIC UTILITIES AND ENGINEERING. THE LOCATION OF THE ENDS OF THE RISERS SHALL BE MARKED BY RED PAINTED PLASTIC TO THE END OF THE RISER WHICH SHALL BE EXTENDED TO THE GROUND SURFACE AS THE EXCAVATION IS BACKFILLED SUCH THAT THE COLORED APPLICABLE IS VISIBLE WHEN THE PROJECT IS COMPLETED. THE ENDS OF THE RISER PIPE AND MANHOLE STUBS SHALL BE CAPPED OR PLUGGED USING PLUGS FURNISHED BY THE MANUFACTURER OF THE PIPE. CONCRETE OR STEEL HOUSING FOR SUPPORTING AND BACKFILLING RISER PIPE SHALL BE APPROVED BY THE ENGINEER.

FOR THE CITY AND INSPECTOR RISERS SHALL BE PAID FOR AT THE UNIT PRICE BID FOR 4" PIPE OR PIPE AND REINFORCED CONCRETE ENCASEMENT FOR THE VARIOUS MAIN SEWER PIPE SIZES INDICATED WHICH PRICE SHALL INCLUDE ALL COSTS FOR COMPLETION OF THIS ITEM INCLUDING SAMPLES, BENDS, CONCRETE REINFORCING STEEL, CAPS OR PLUGS AND ALL OTHER NECESSARY MATERIALS OR WORK. CONCRETE ENCASEMENT OF THE RISER PIPE TO THE TOP OF THE BEND AS SHOWN BY THE DRAWINGS SHALL BE PAID FOR DIRECTLY AND THE COST FOR THIS WORK SHALL BE CONSIDERED AS SUBSIDIARY TO THE OTHER ITEMS OF WORK.

THE PROJECT INSPECTOR SHALL REPORT ON INSPECTION CARDS THE LOCATION OF ALL RISERS CONSIDERED AS MEASURED FROM THE MARKS MANHOLE. THE DIRECTION OF SERVICE, THE ELEVATION OF THE TOP OF THE RISER, AND THE PAY QUANTITIES INVOLVED. THE PROJECT INSPECTOR SHALL ALSO REPORT ON INSPECTION CARDS THE LOCATION, DIRECTION OF SERVICE, AND SIZE OF ALL STUBS INSTALLED IN MANHOLES.

FILMED FROM THE BEST AVAILABLE COPY