



MAIN 13, S.W. INTERCEPTOR SEWER



PROJECT NO.

468-76-245-80932-000-000-001

CITY OF WICHITA, KANSAS

DEAN SELLERS, ACTING CITY ENGINEER

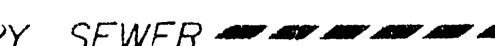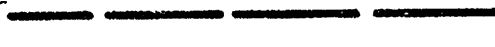LEGEND
EXISTING SANITARY SEWER 
PROPOSED SANITARY SEWER 
BENEFIT DISTRICT 

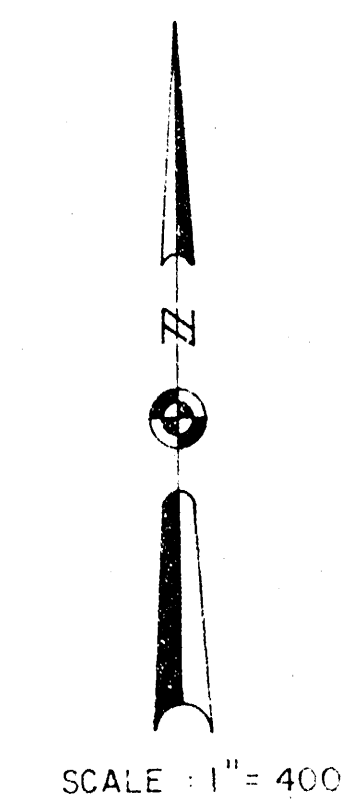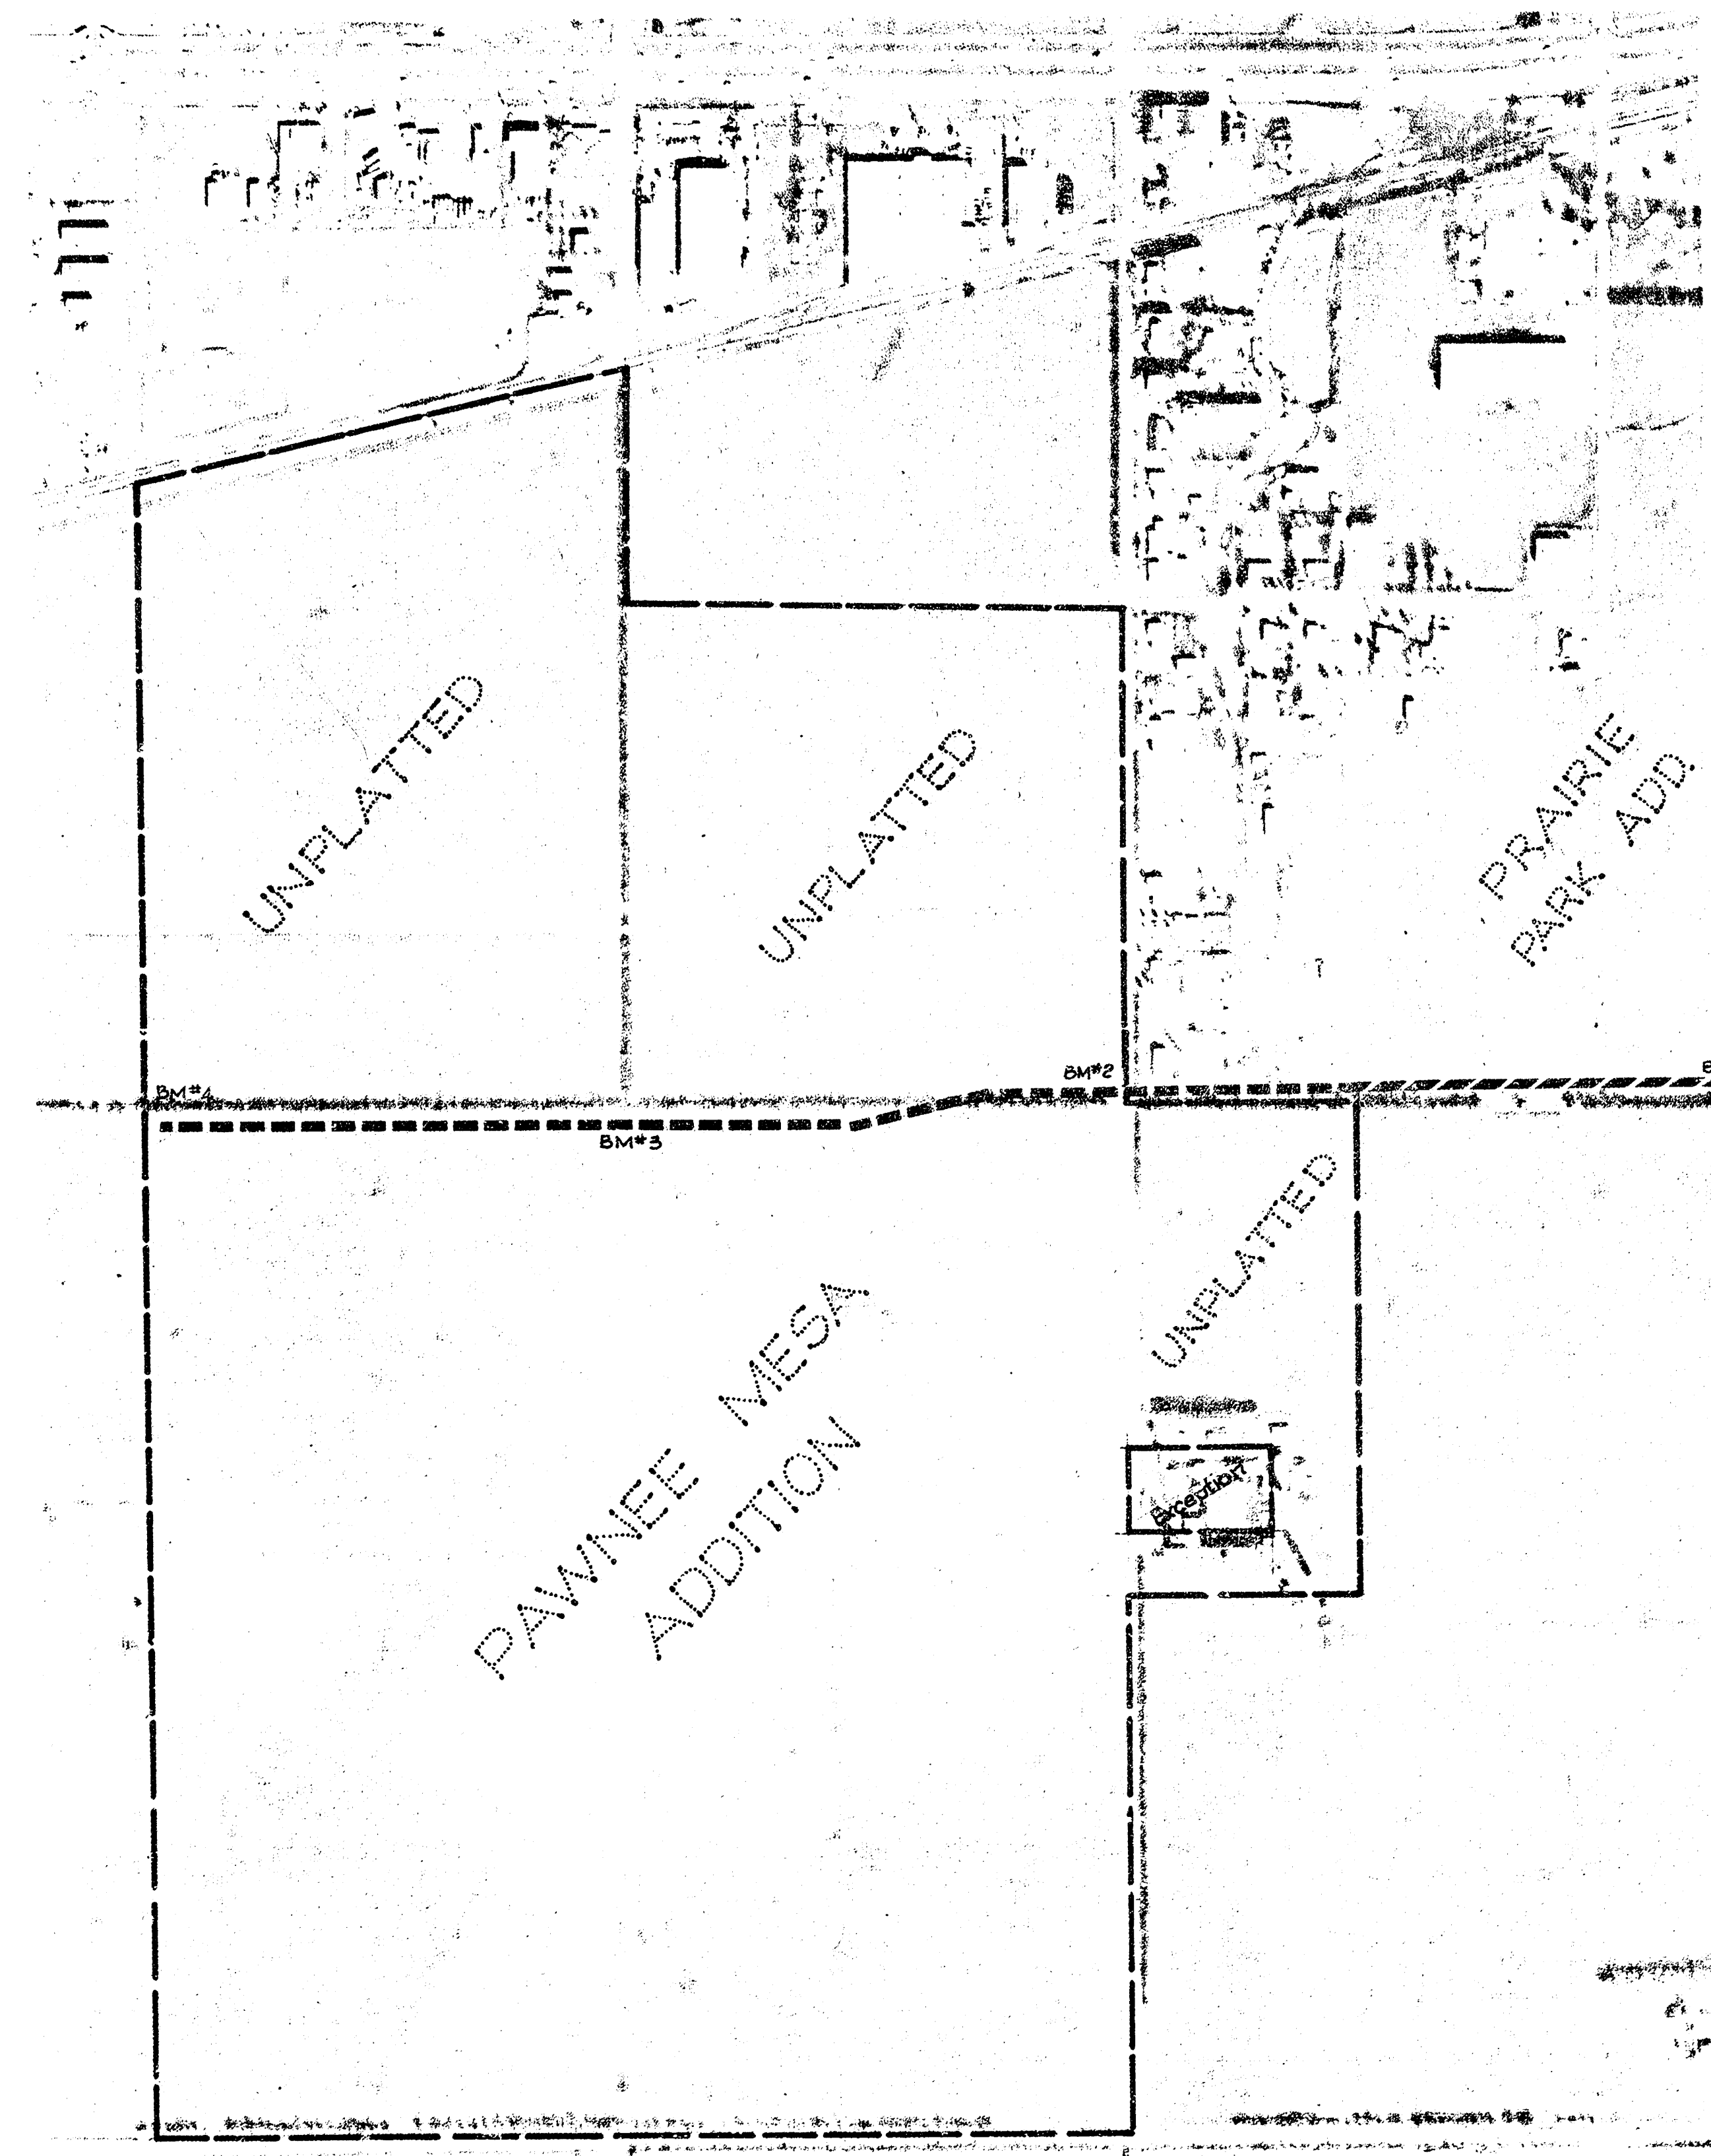

INDEX TO DRAWINGS	
SHEET NO.	DESCRIPTION
1	TITLE SHEET
2-4	PLAN & PROFILE
5-7	DETAILS





Van Doren - Hazard - Stallings
Engineers - Planners
Topeka Wichita Minneapolis

Sheet 1
of 4


PROJECT NO. :
468·76·245·80932·000·000·001

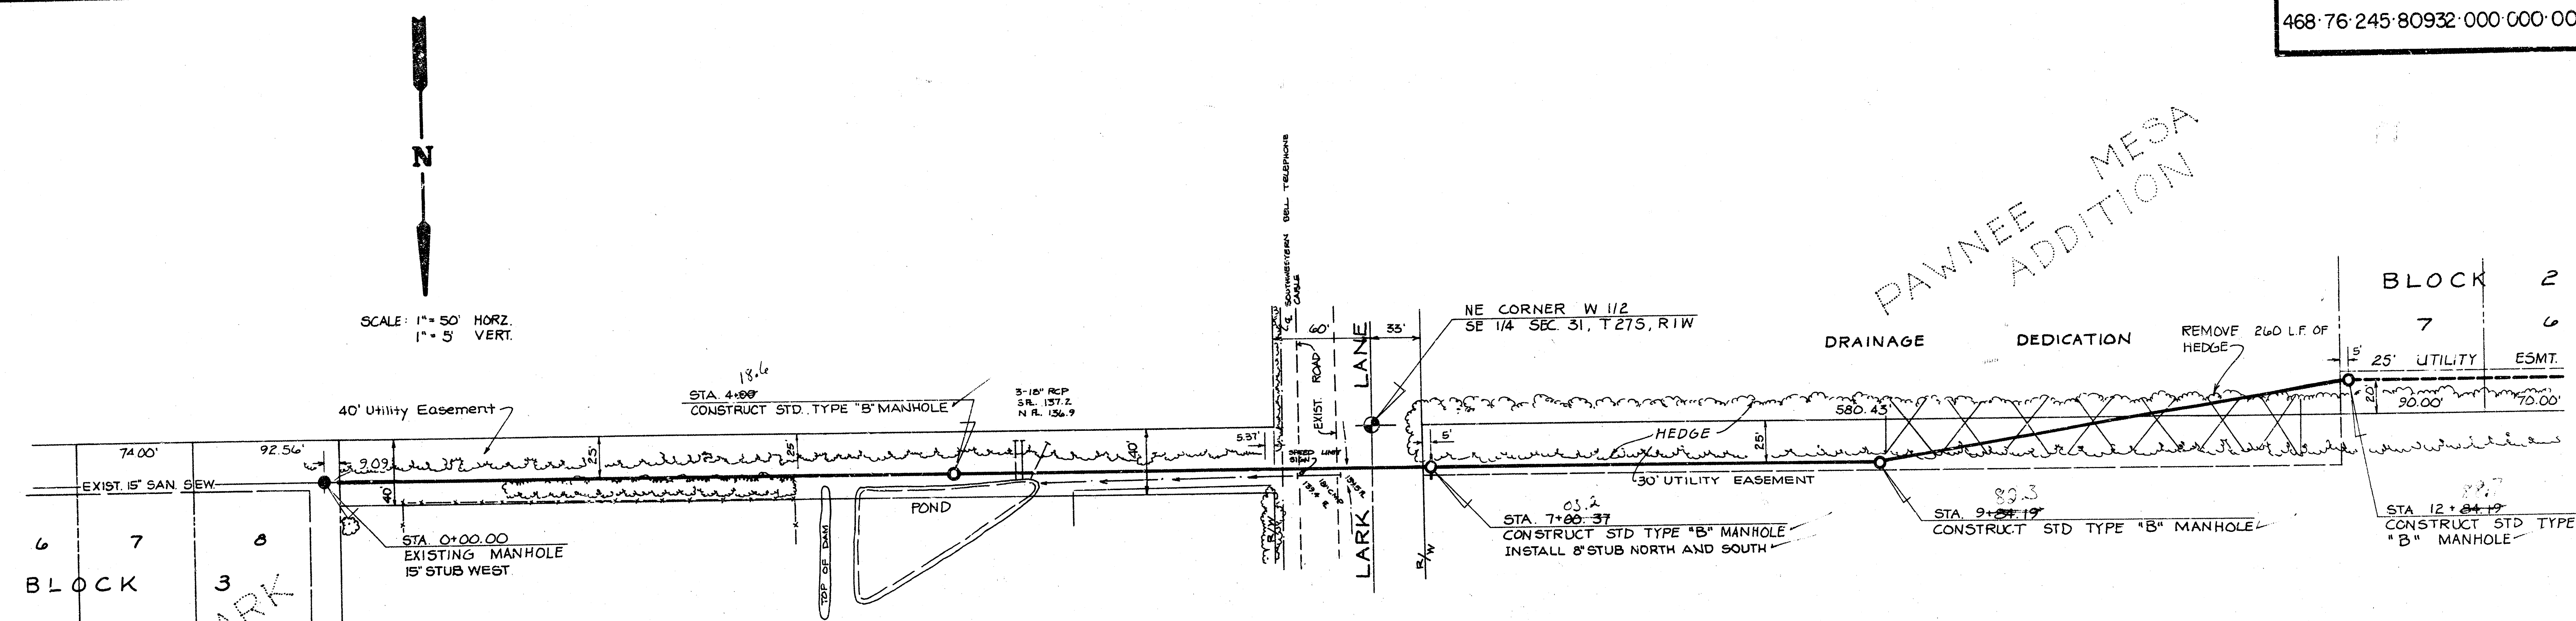


NOTE: REMOVAL AND REPLACEMENT OF 18" PIPE AT STATION 4 + 50 SHALL BE
CONSIDERED AS SUBSIDIARY TO THE OTHER ITEMS OF WORK.


Bench Mark # 1
RR Spike in west face of 2nd PP north of
NE 1/4 Cor. of SE 1/4 of Sec. 31-27S-1W
on east R/W Maize Road. ELEV. 137.96'

Bent Spike in south face of hedge tree at
7 + 25.00, 25' left, ELEV. 142.30'

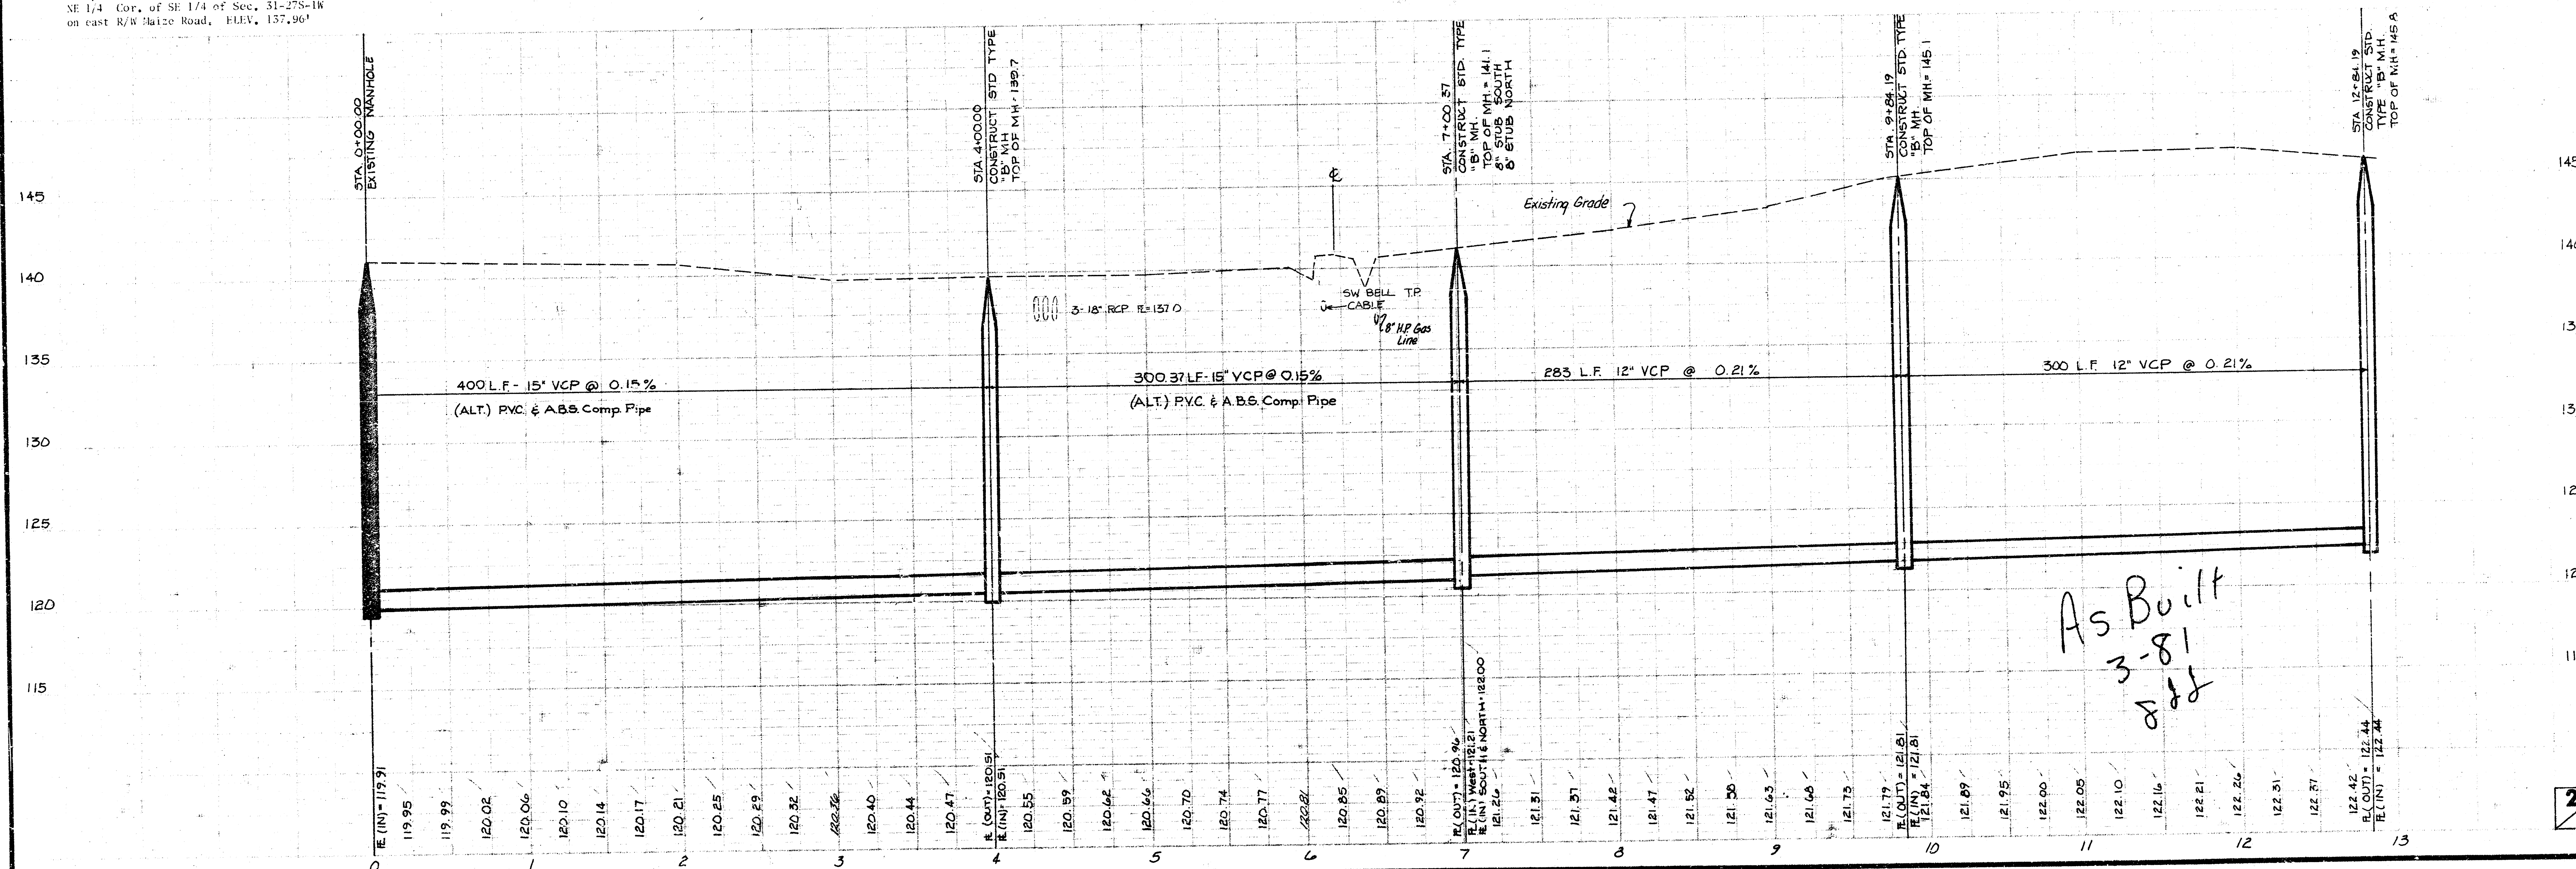

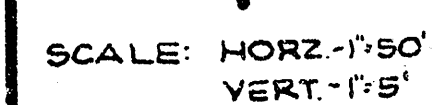

468.76.245.80932.000.000.001

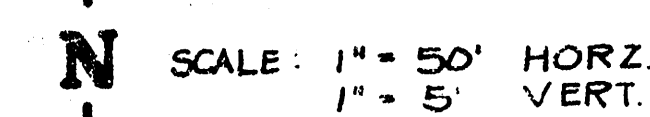

Bench Mark # 4
RR Spike in south face of hedge tree at
32 + 25.00, 20' right. ELEV. 145.91

