

LATERAL I, MAIN I4 SOUTHWEST INTERCEPTOR SEWER

CITY OF WICHITA
M.E. LINDEBAK CITY ENGINEER

PROJET NO. 486 76 245 81502 000 000 001

DATE: JANUARY 1986

INDEX OF SHEETS


SHEET NO.	DESCRIPTION
1	TITLE SHEET
2	PLAN & PROFILES

NOTIFY THE FOLLOWING COMPANIES
PRIOR TO ANY TRENCHING:

ARKLA GAS CO. 942-8350
BELL TELEPHONE 268-3087
CARLEVISION 266-6817
GAS SERVICE CO. 263-7511
KANSAS GAS & ELECTRIC 261-6248



THE CONTRACTOR SHALL BE RESPONSIBLE FOR
PRESERVING PROPERTY IRONS. THE CONTRACTOR
SHALL BE REQUIRED TO RE-ESTABLISH ANY PRO-
PERTY IRONS WHICH ARE DAMAGED OR DESTROYED
BY HIS CONSTRUCTION OPERATIONS. SUCH IRONS
SHALL BE RE-ESTABLISHED BY A LICENSED LAND
SURVEYOR OR A LICENSED PROFESSIONAL ENGINE-
ER IN ACCORDANCE WITH STATE LAWS.

VICINITY MAP
(no scale)

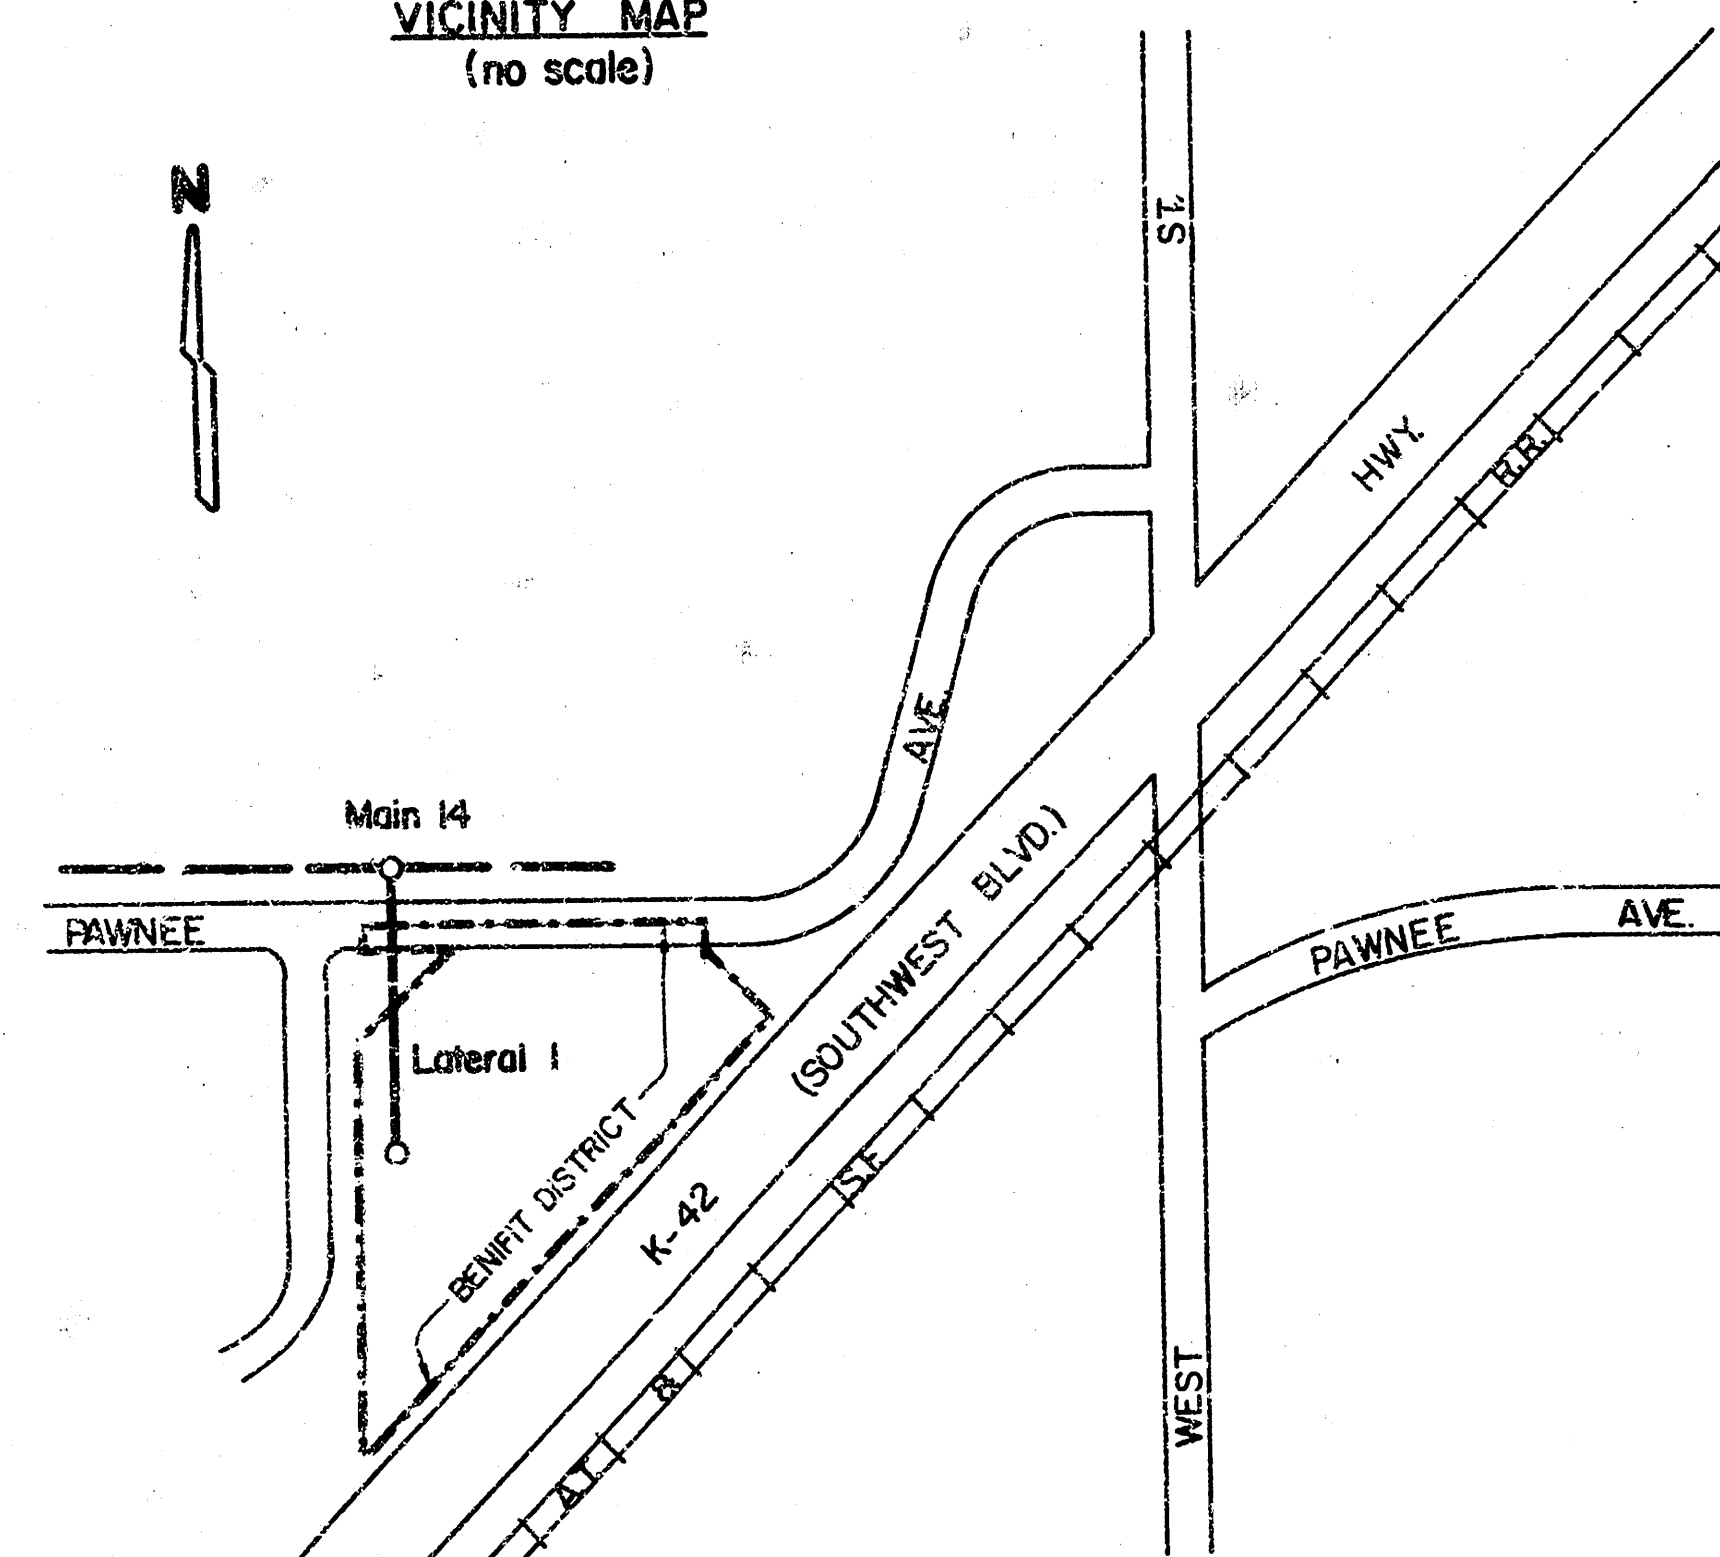


MOEHRING & ASSOCIATES
CONSULTING ENGINEERS
WICHITA, KANSAS



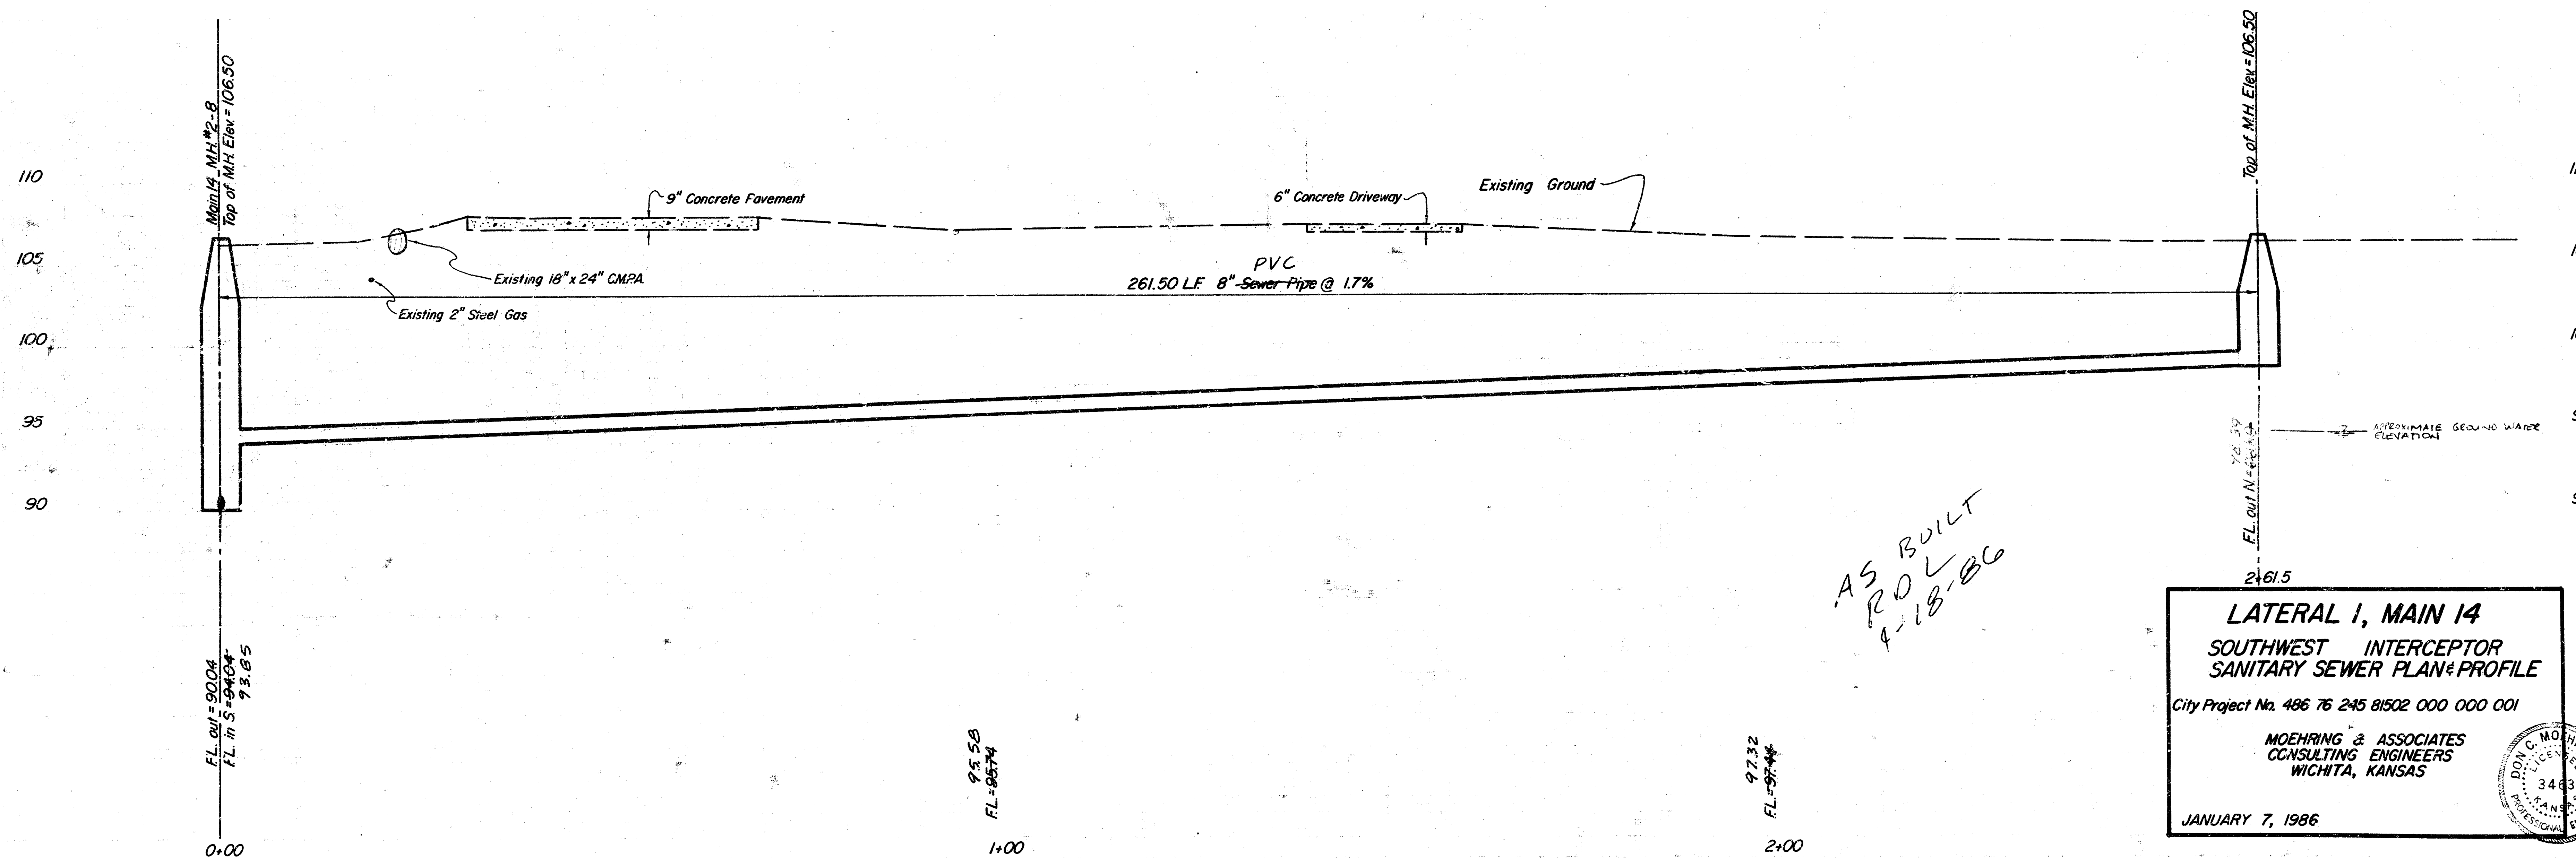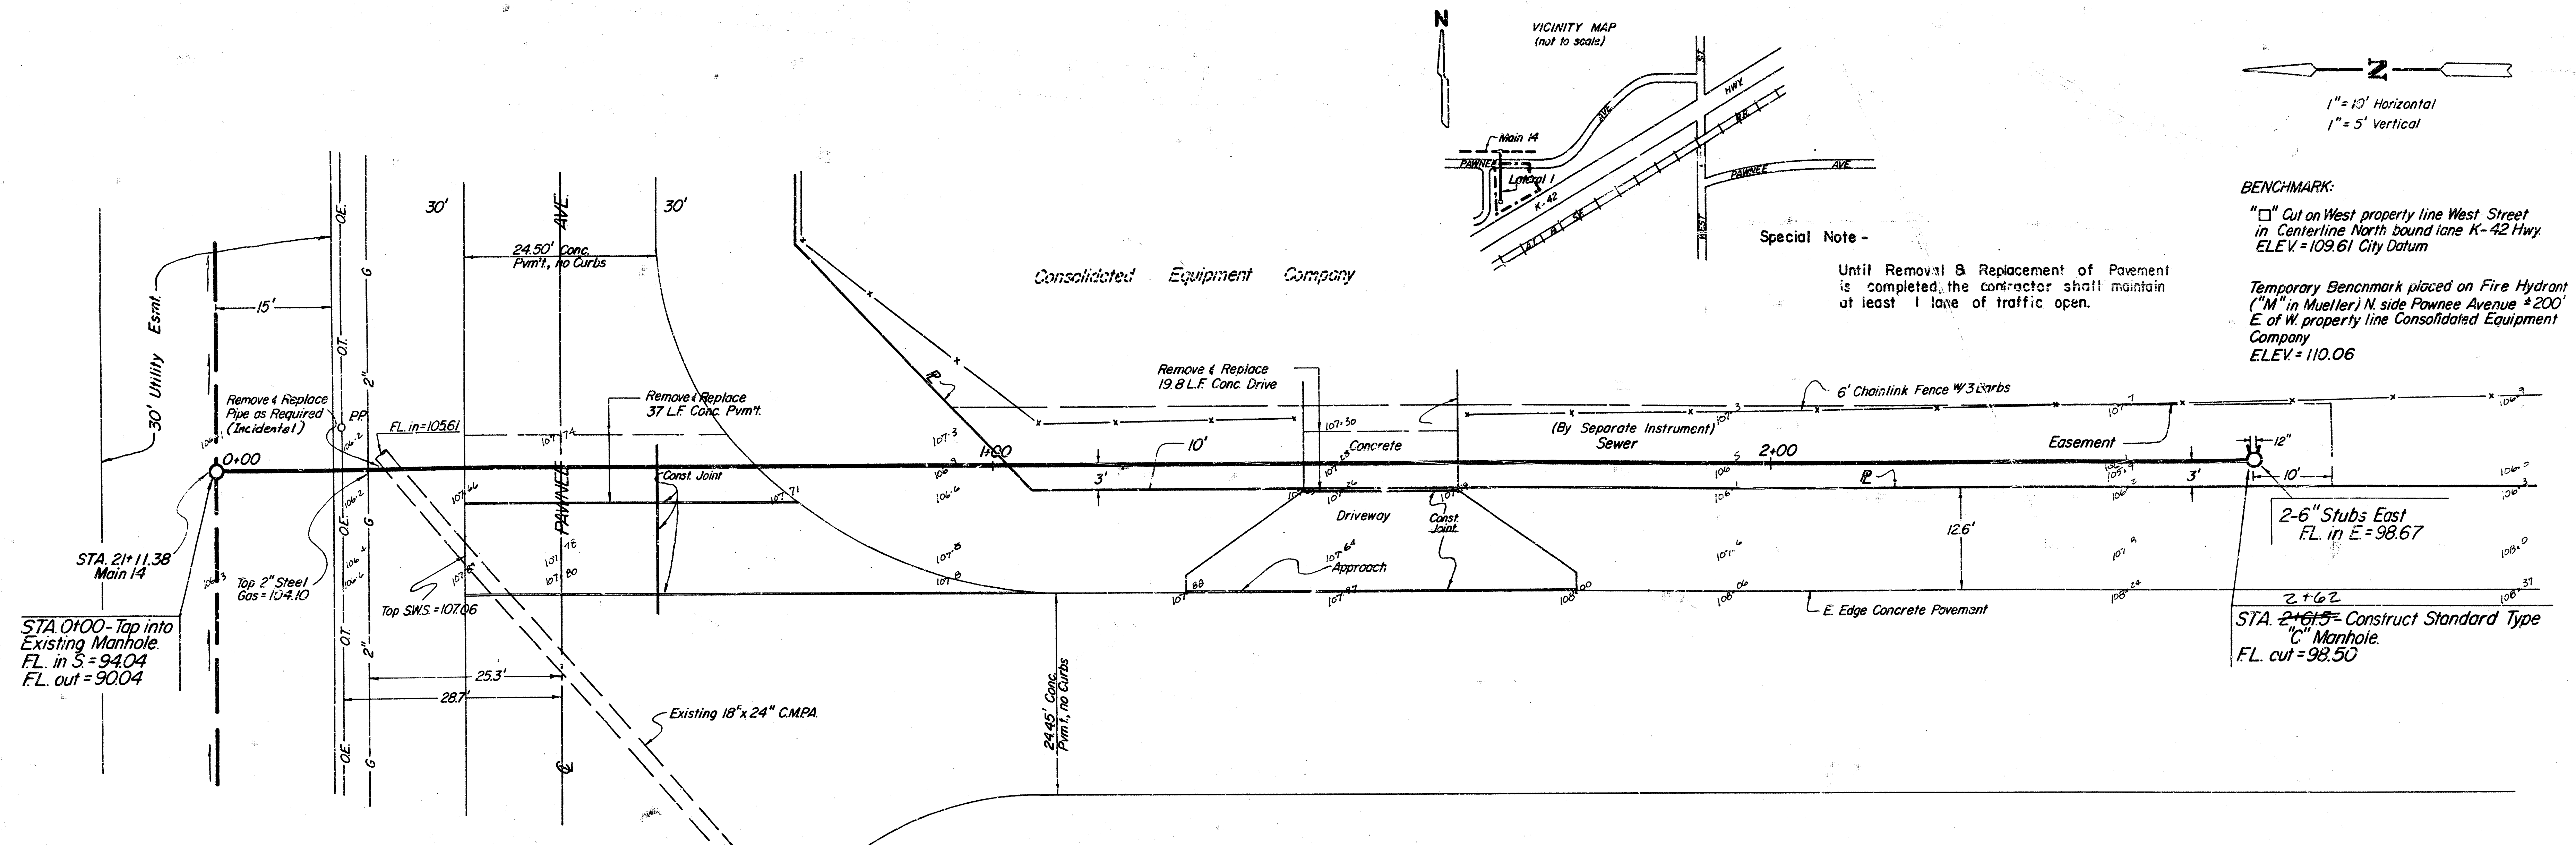

LATERAL 1, MAIN 14
SOUTHWEST INTERCEPTOR
SANITARY SEWER PLAN & PROFILE
 City Project No. 486 76 245 81502 000 000 001
 MOEHRING & ASSOCIATES
 CONSULTING ENGINEERS
 WICHITA, KANSAS
 JANUARY 7, 1986

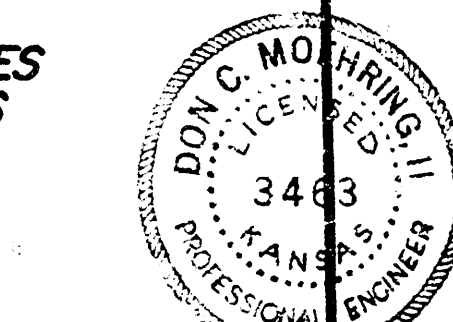

FILMED FROM THE BEST AVAILABLE COPY