



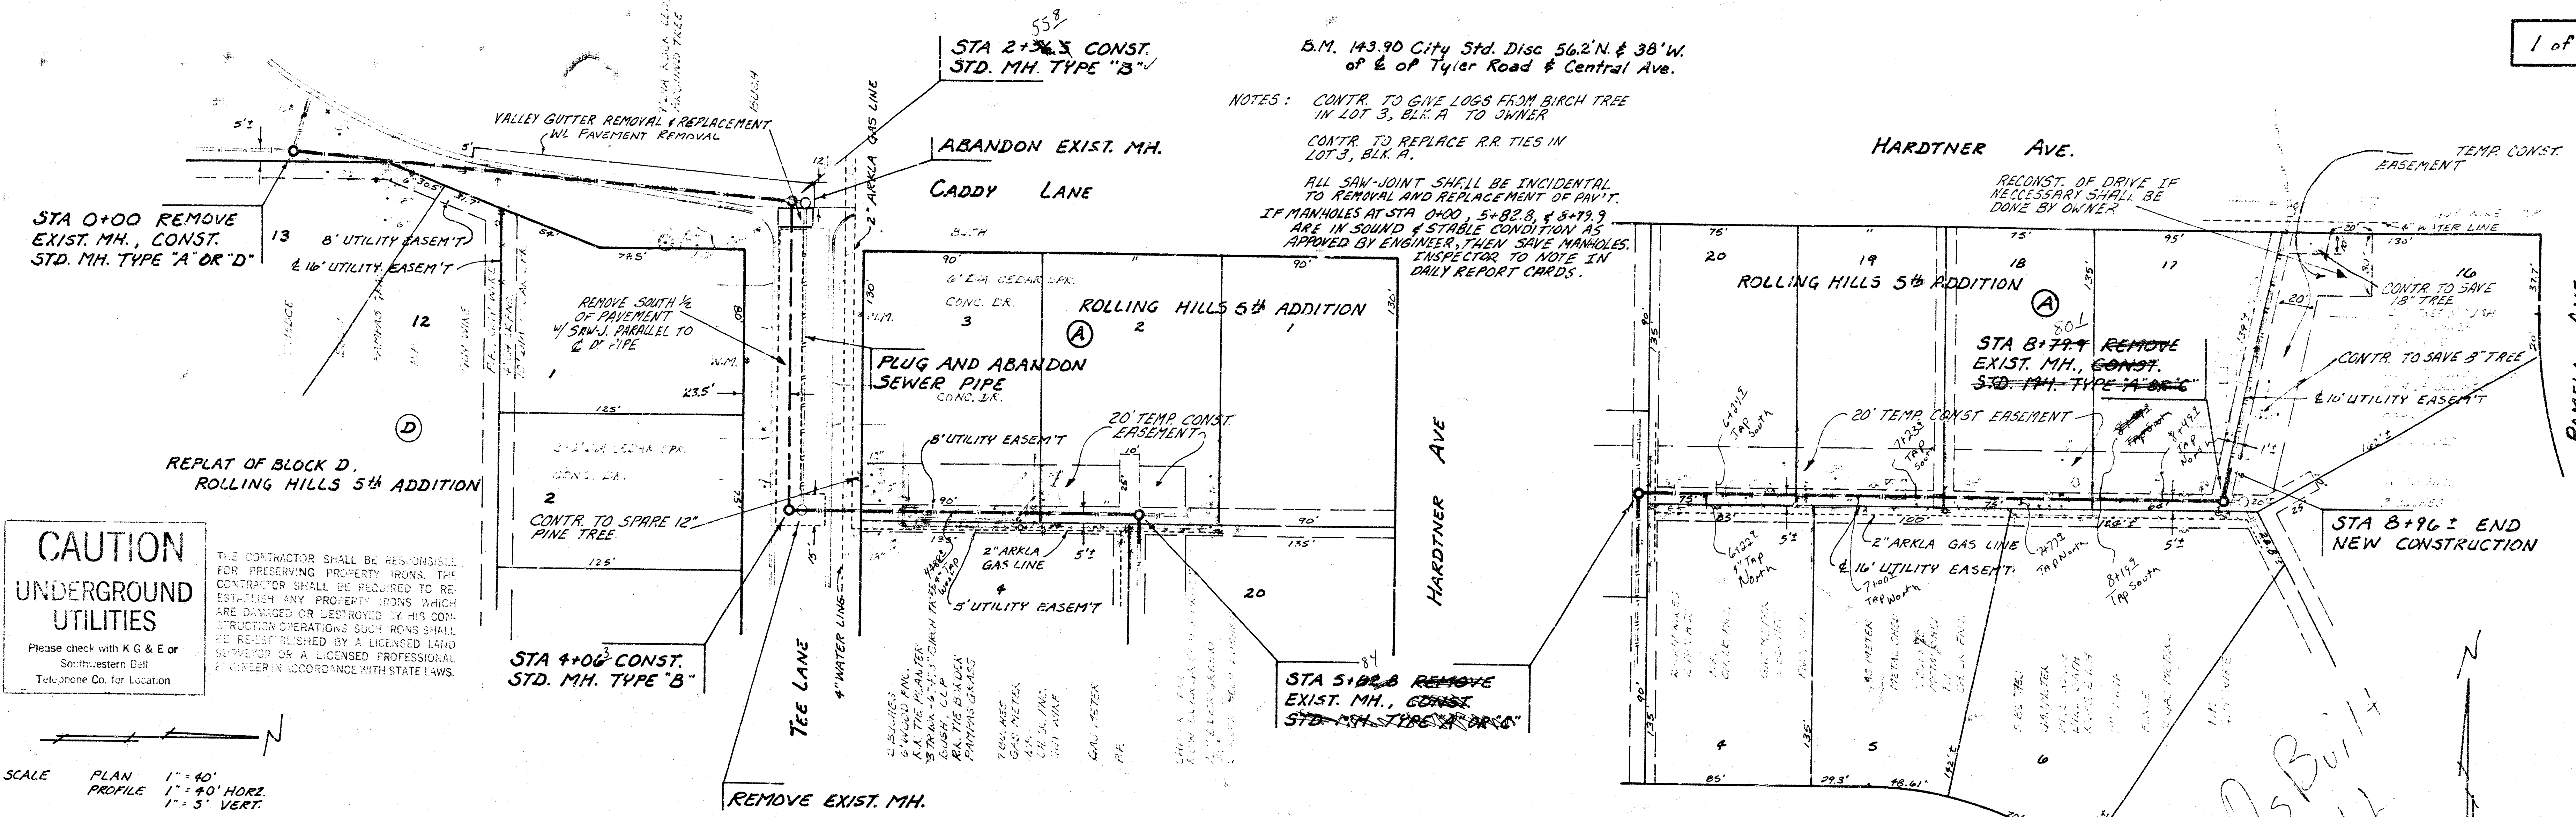

CAUTION
UNDERGROUND UTILITIES
Please check with K & E or Southwestern Bell Telephone Co. for Location.

THE CONTRACTOR SHALL BE RESPONSIBLE FOR PRESERVING PROPERTY IRONS. THE CONTRACTOR SHALL BE REQUIRED TO RE-ESTABLISH ANY PROPERTY IRONS WHICH ARE DAMAGED OR DESTROYED IN HIS CONSTRUCTION OPERATIONS. SUCH IRONS SHALL BE RE-ESTABLISHED BY A LICENSED LAND SURVEYOR OR A LICENSED PROFESSIONAL ENGINEER IN ACCORDANCE WITH STATE LAWS.

SCALE
PLAN 1" = 40'
PROFILE 1" = 40' HORIZ.
1" = 5' VERT.

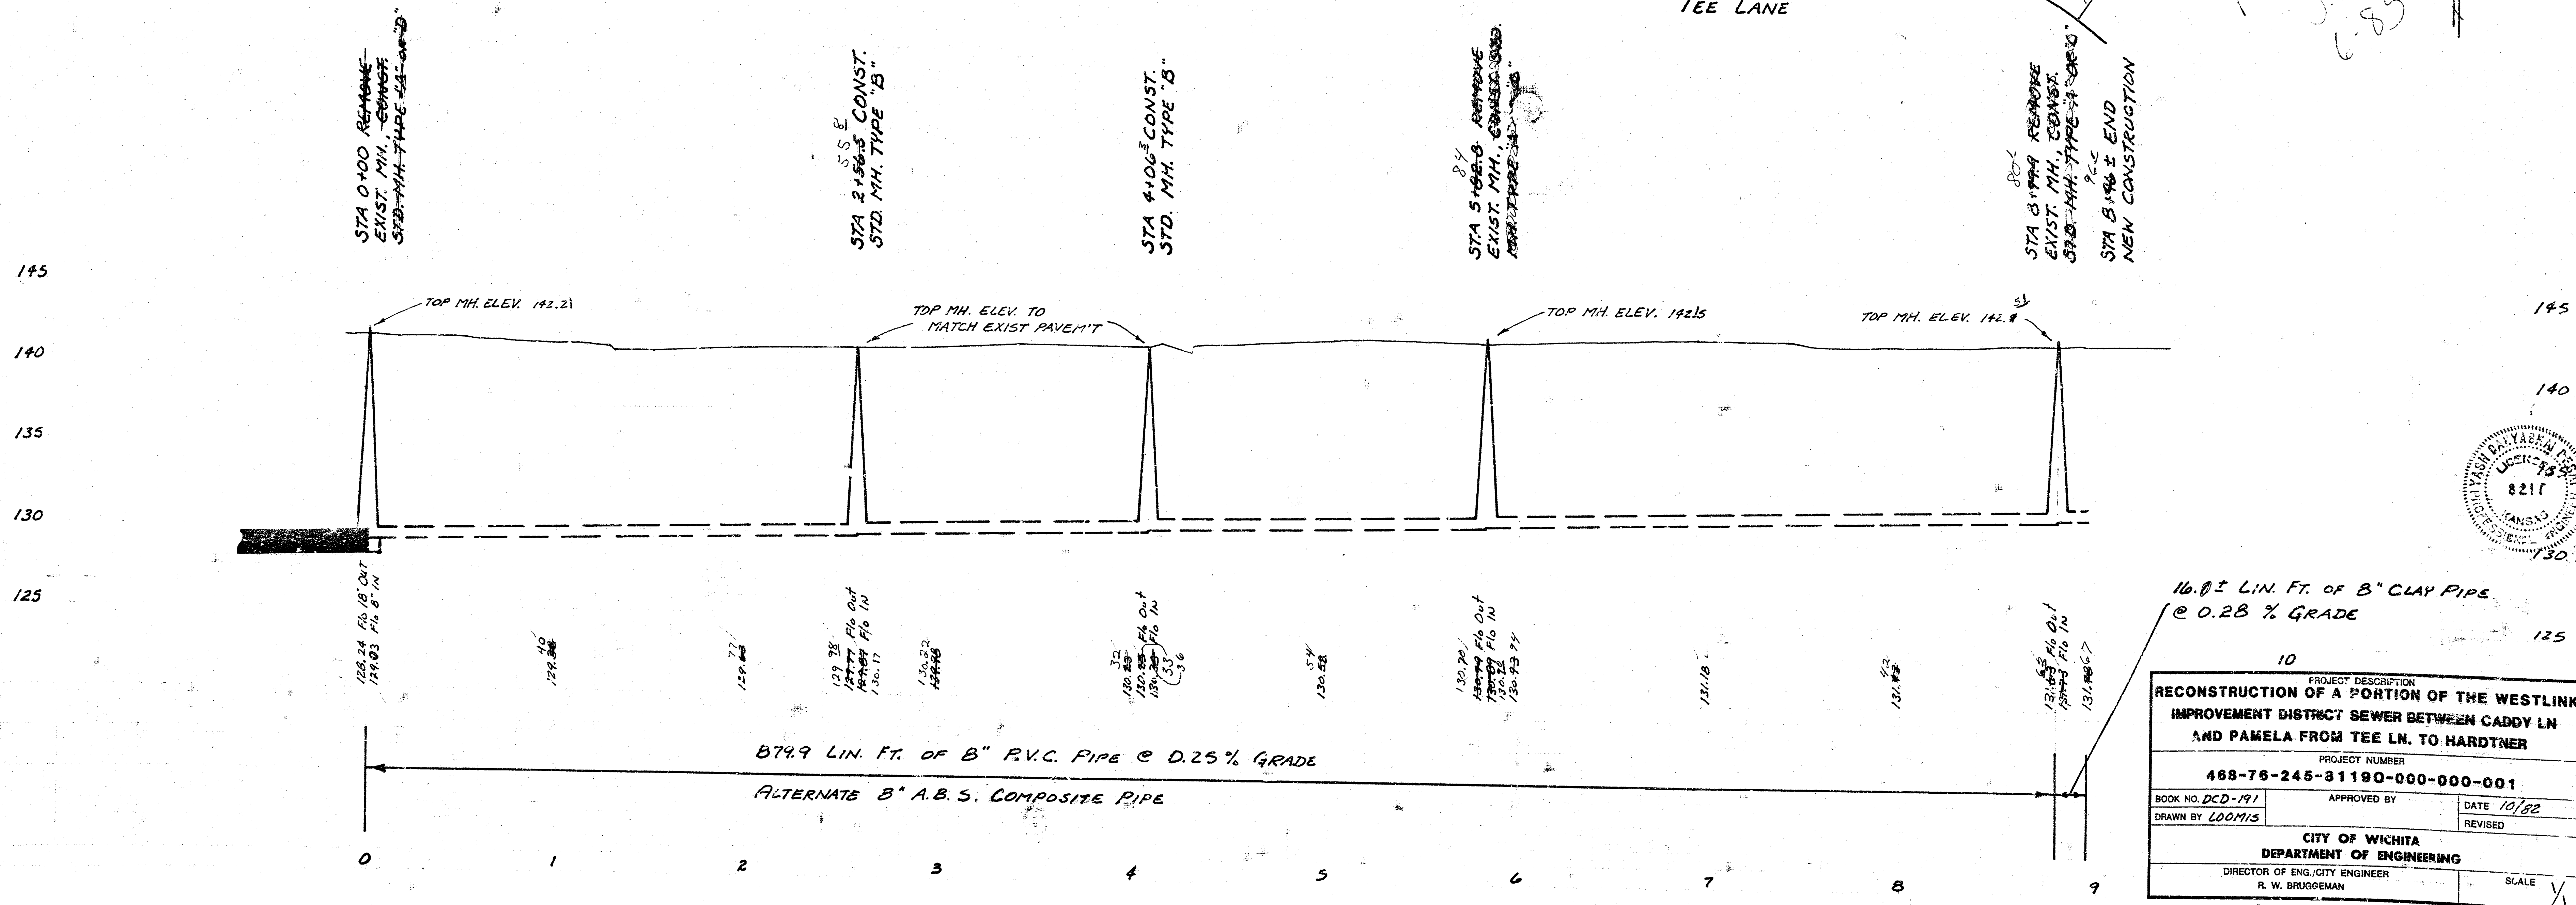

PROJECT DESCRIPTION	
RECONSTRUCTION OF A PORTION OF THE WESTLINK IMPROVEMENT DISTRICT SEWER BETWEEN CADDY LN AND PAMELA FROM TEE LN. TO HARDTNER	
PROJECT NUMBER	
BOOK NO. DCD-191	APPROVED BY
DRAWN BY LDOM/IS	DATE 10/82
CITY OF WICHITA	
DEPARTMENT OF ENGINEERING	
DIRECTOR OF ENG. CITY ENGINEER	
R. W. BRUGEMAN	
SCALE 1/4"	