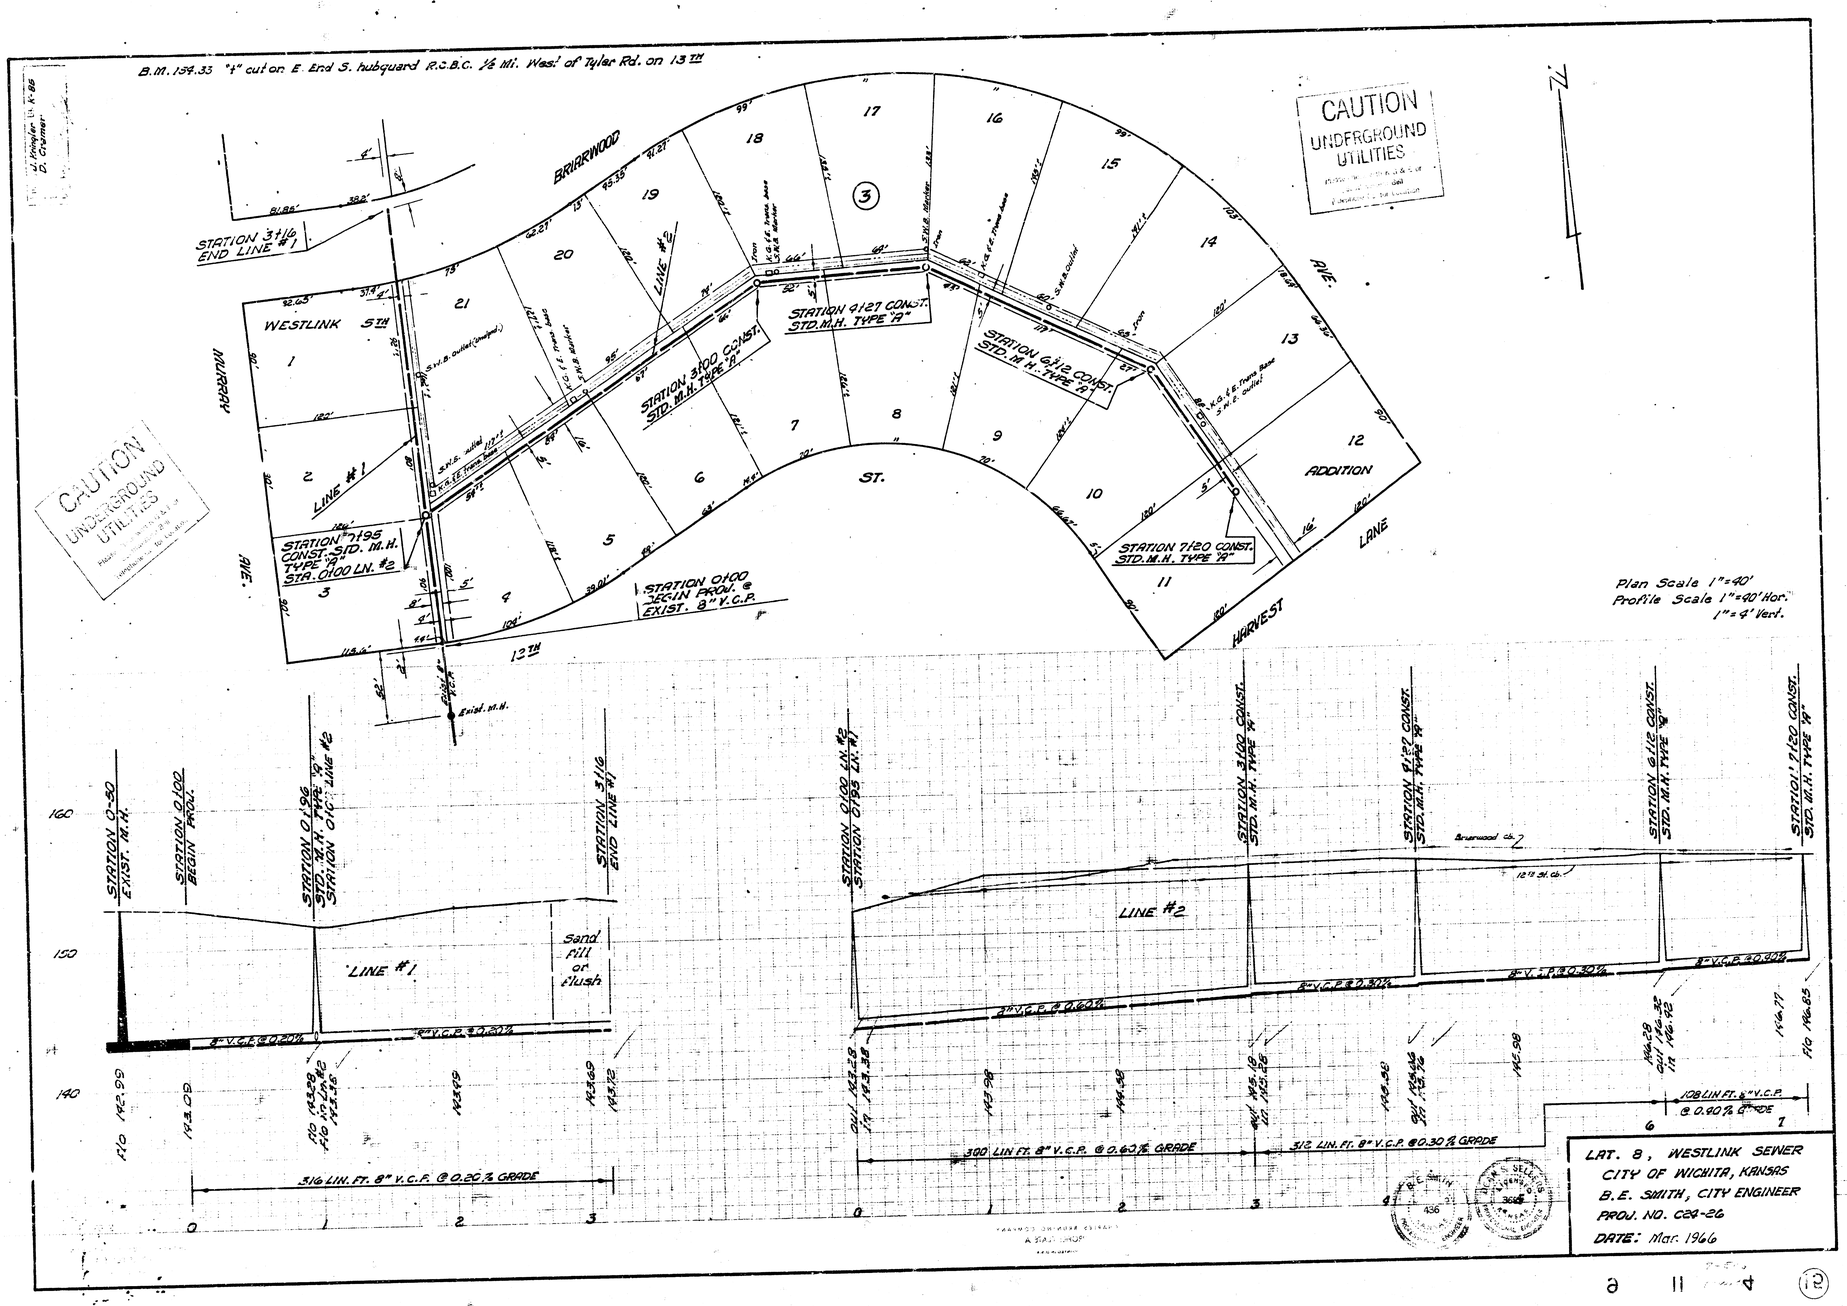
B.M. 154.33 "+" cut on E. End S. subguard R.C.B.C. 1/2 Mi. West of Tyler Rd. on 13TH
J. Ingler
D. Cromer
CAUTION UNDERGROUND UTILITIES
BRIARWOOD
WESTLINK
MURRAY
AVE.
ST.
LANE
HARVEST
ADDITION
13TH
STATION 3+16 END LINE #1
LINE #1
LINE #2
STATION 0+96 CONST. STD. M.H. TYPE "A" STA. 0+00 LN. #2
STATION 0+00 BEGIN PROJ. @ EXIST. 8" V.C.P.
STATION 3+00 CONST. STD. M.H. TYPE "A"
STATION 4+27 CONST. STD. M.H. TYPE "A"
STATION 6+12 CONST. STD. M.H. TYPE "A"
STATION 7+20 CONST. STD. M.H. TYPE "A"
Plan Scale 1"=40'
Profile Scale 1"=40' Hor.
1"=4' Vert.
STATION 0-80 EXIST. M.H.
STATION 0+00 BEGIN PROJ.
STATION 0+96 STD. M.H. TYPE "A" STATION 0+00 LINE #2
STATION 3+16 END LINE #1
Sand Fill or Flush
8" V.C.P. @ 0.20%
8" V.C.P. @ 0.60%
316 LIN. FT. 8" V.C.P. @ 0.20% GRADE
STATION 0+00 LN. #2 STATION 0+96 LN. #1
STATION 3+00 CONST. STD. M.H. TYPE "A"
STATION 4+27 CONST. STD. M.H. TYPE "A"
STATION 6+12 CONST. STD. M.H. TYPE "A"
STATION 7+20 CONST. STD. M.H. TYPE "A"
Briarwood Ch.
12TH St. Ch.
8" V.C.P. @ 0.30%
8" V.C.P. @ 0.40%
300 LIN. FT. 8" V.C.P. @ 0.60% GRADE
LAT. 8, WESTLINK SEWER
CITY OF WICHITA, KANSAS
B.E. SMITH, CITY ENGINEER
PROJ. NO. C24-26
DATE: Mar. 1966