
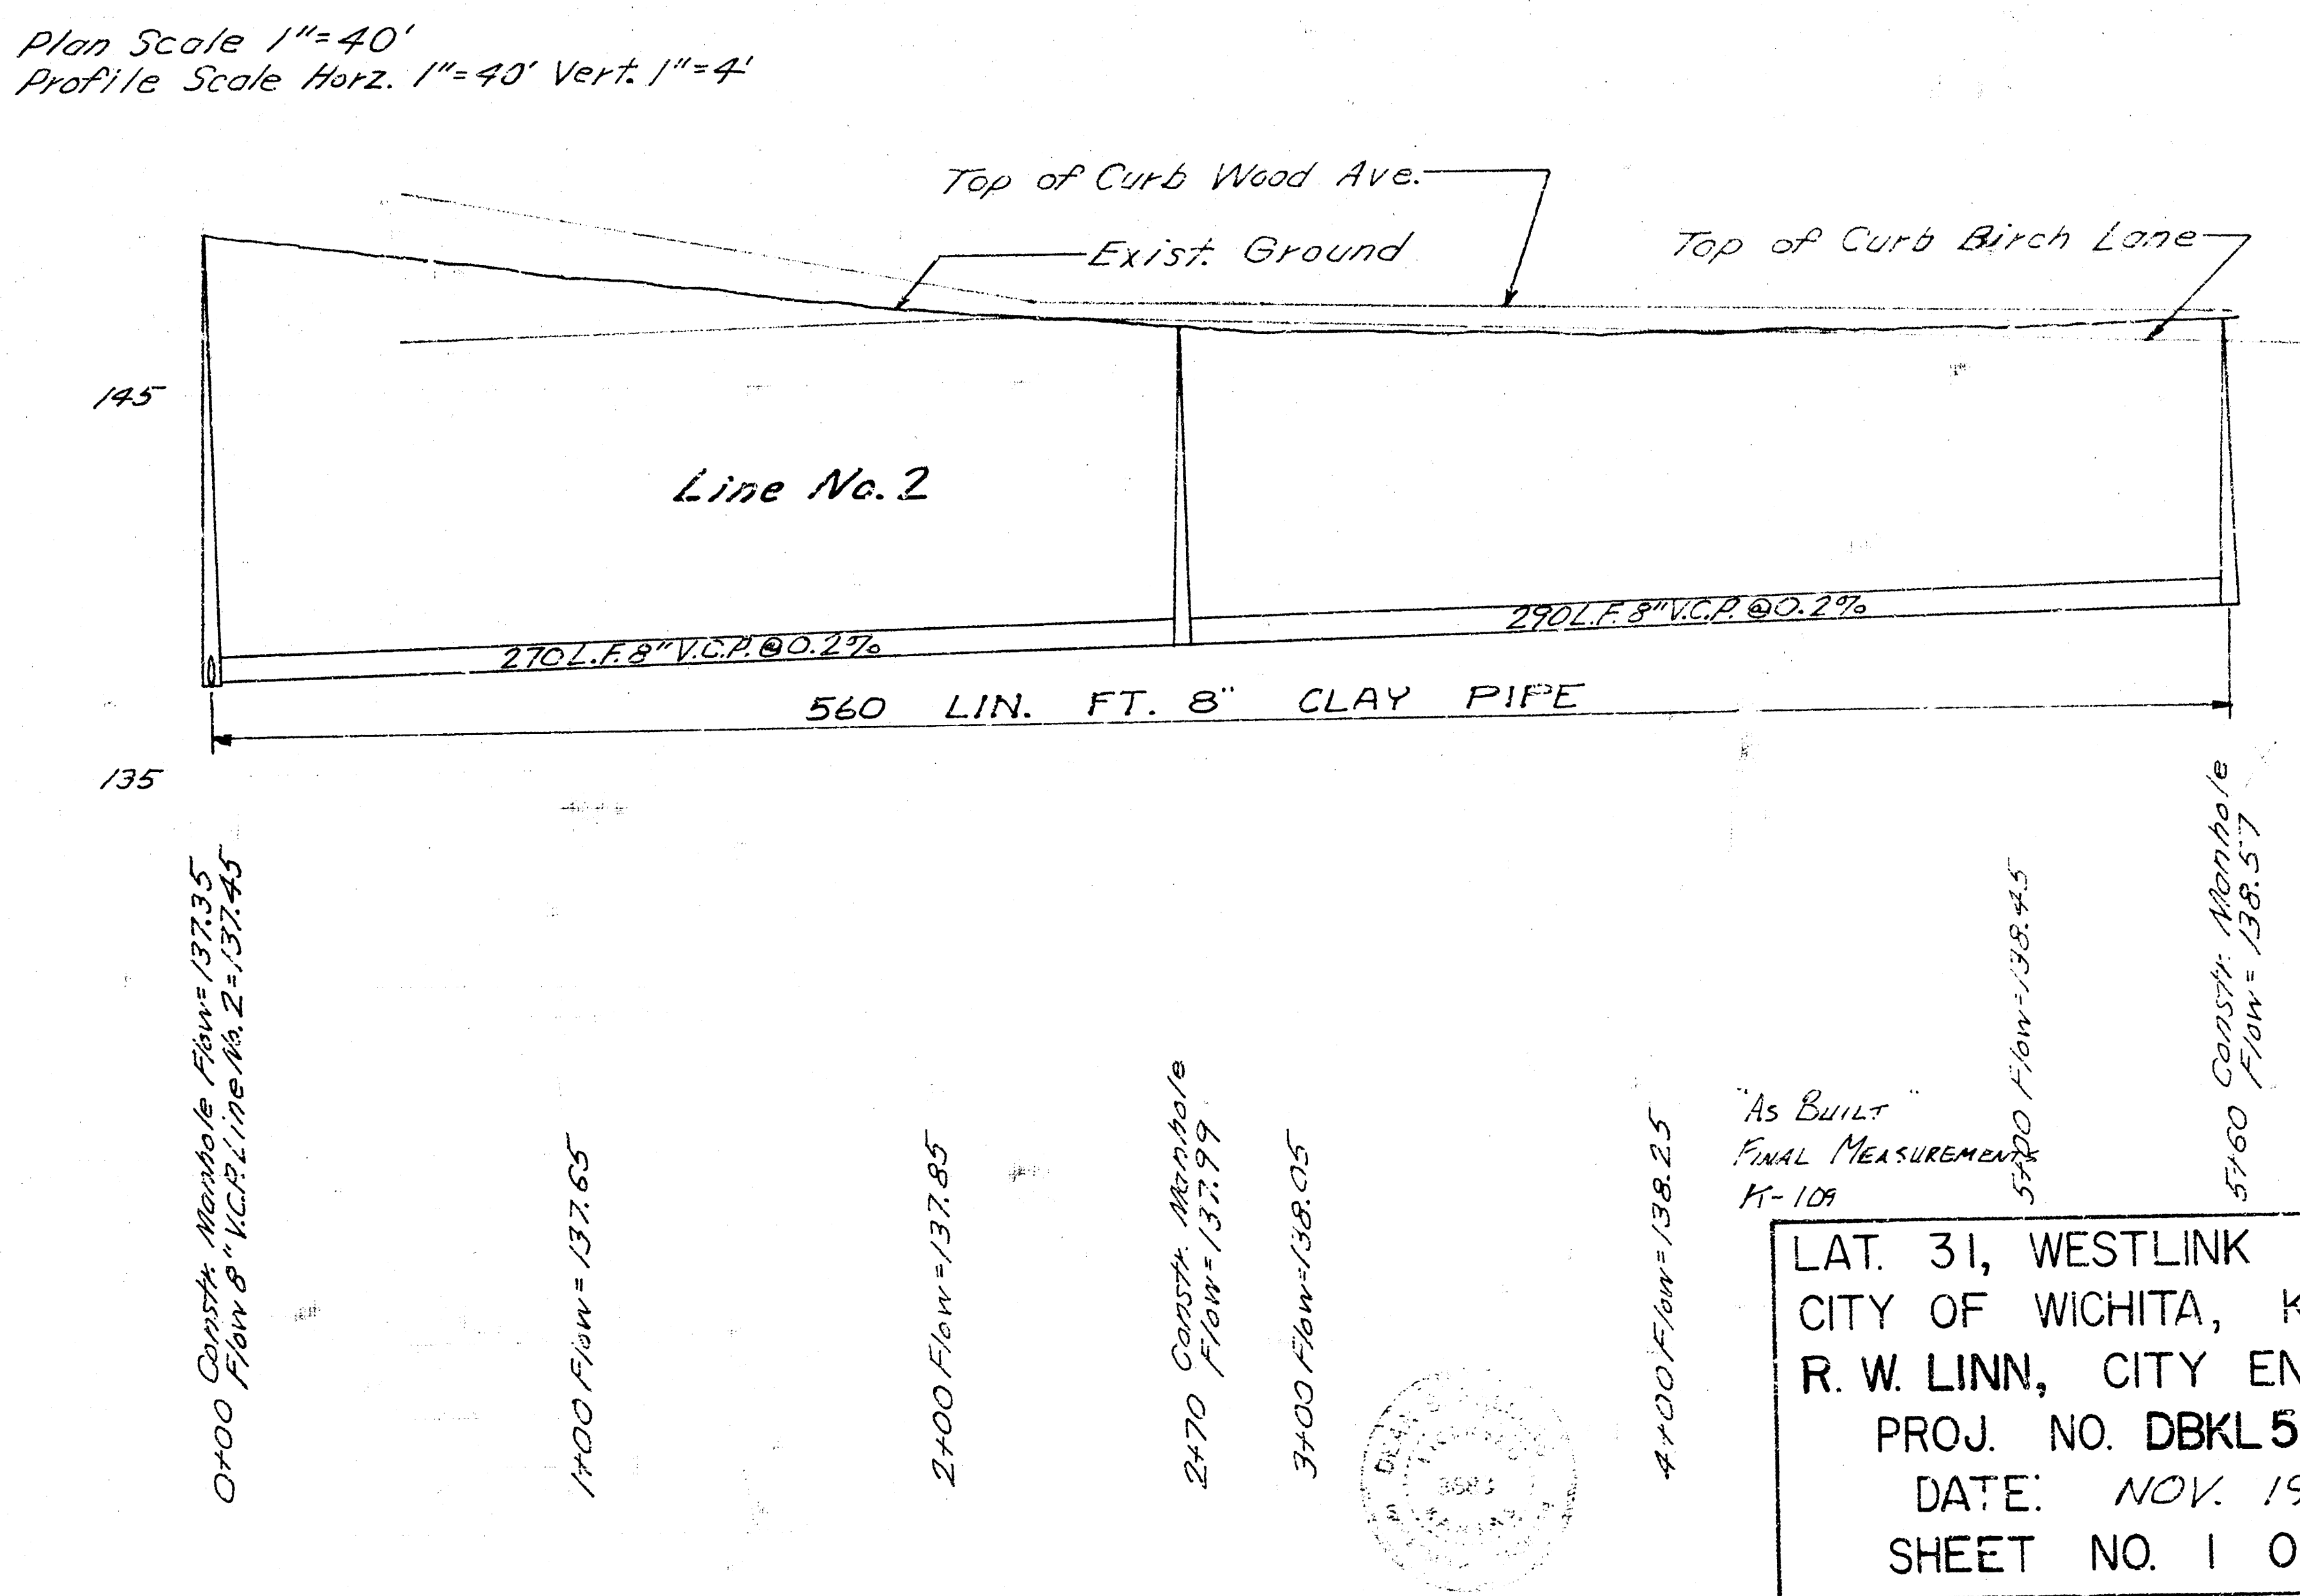
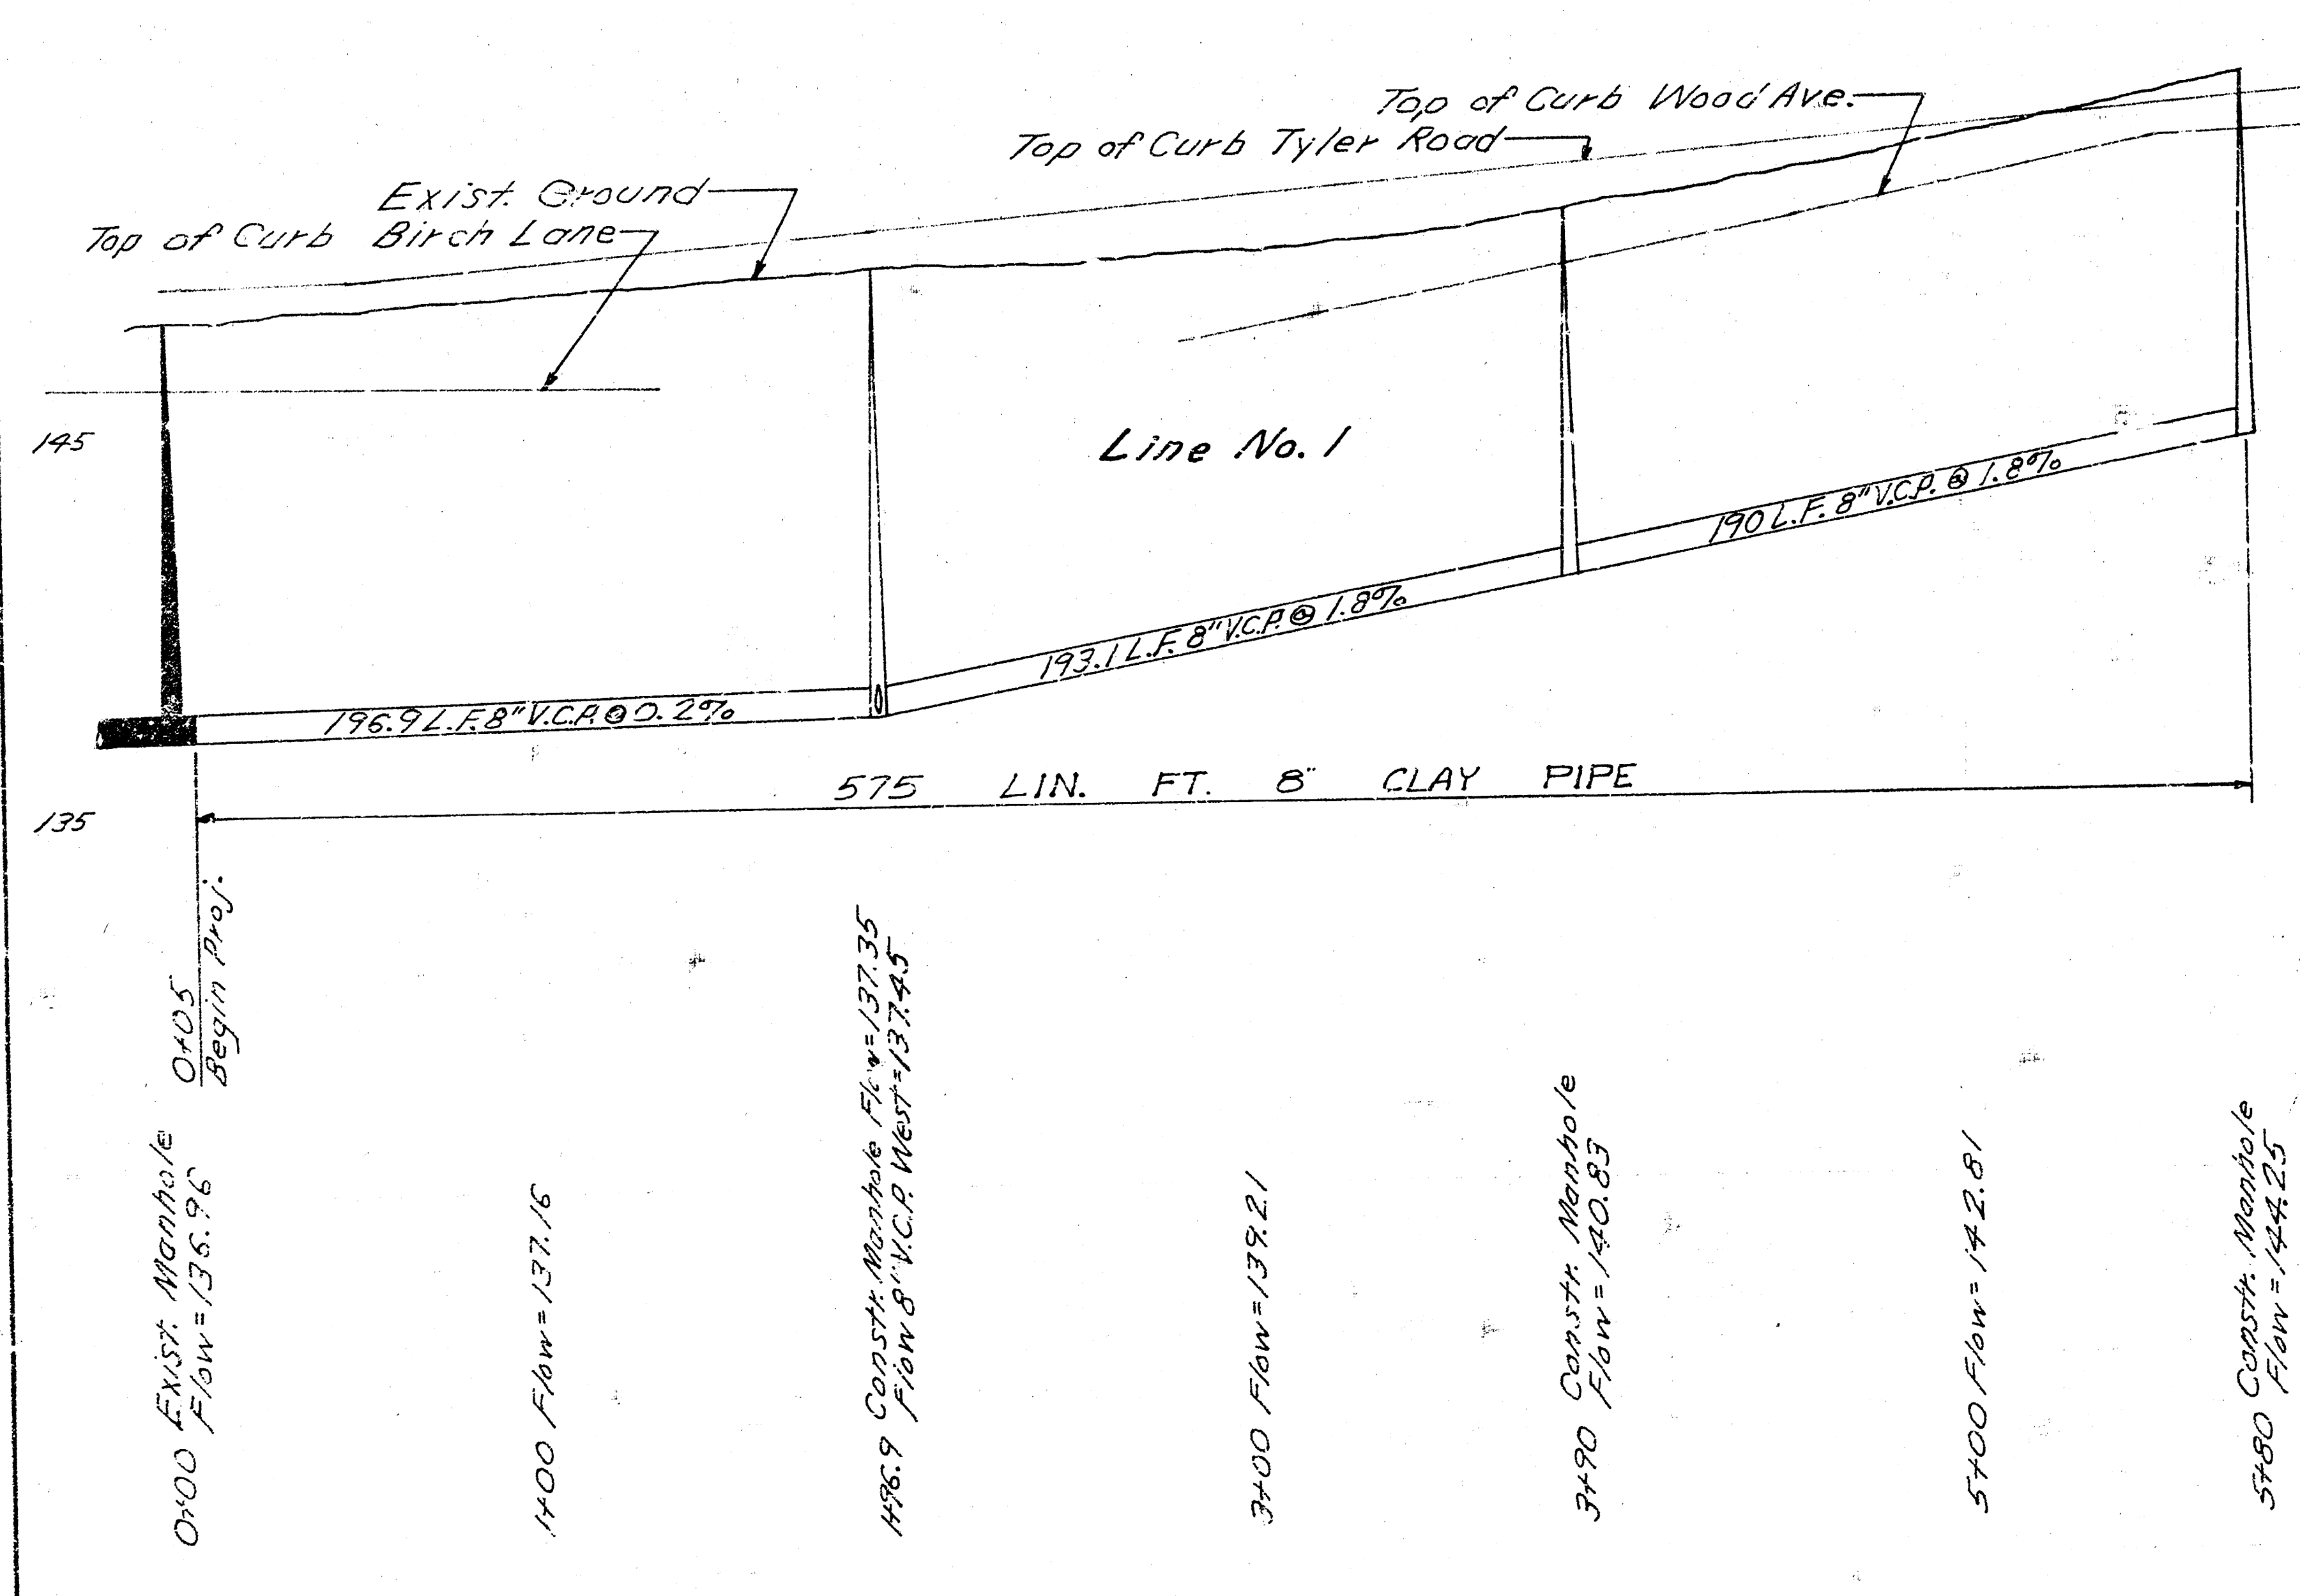


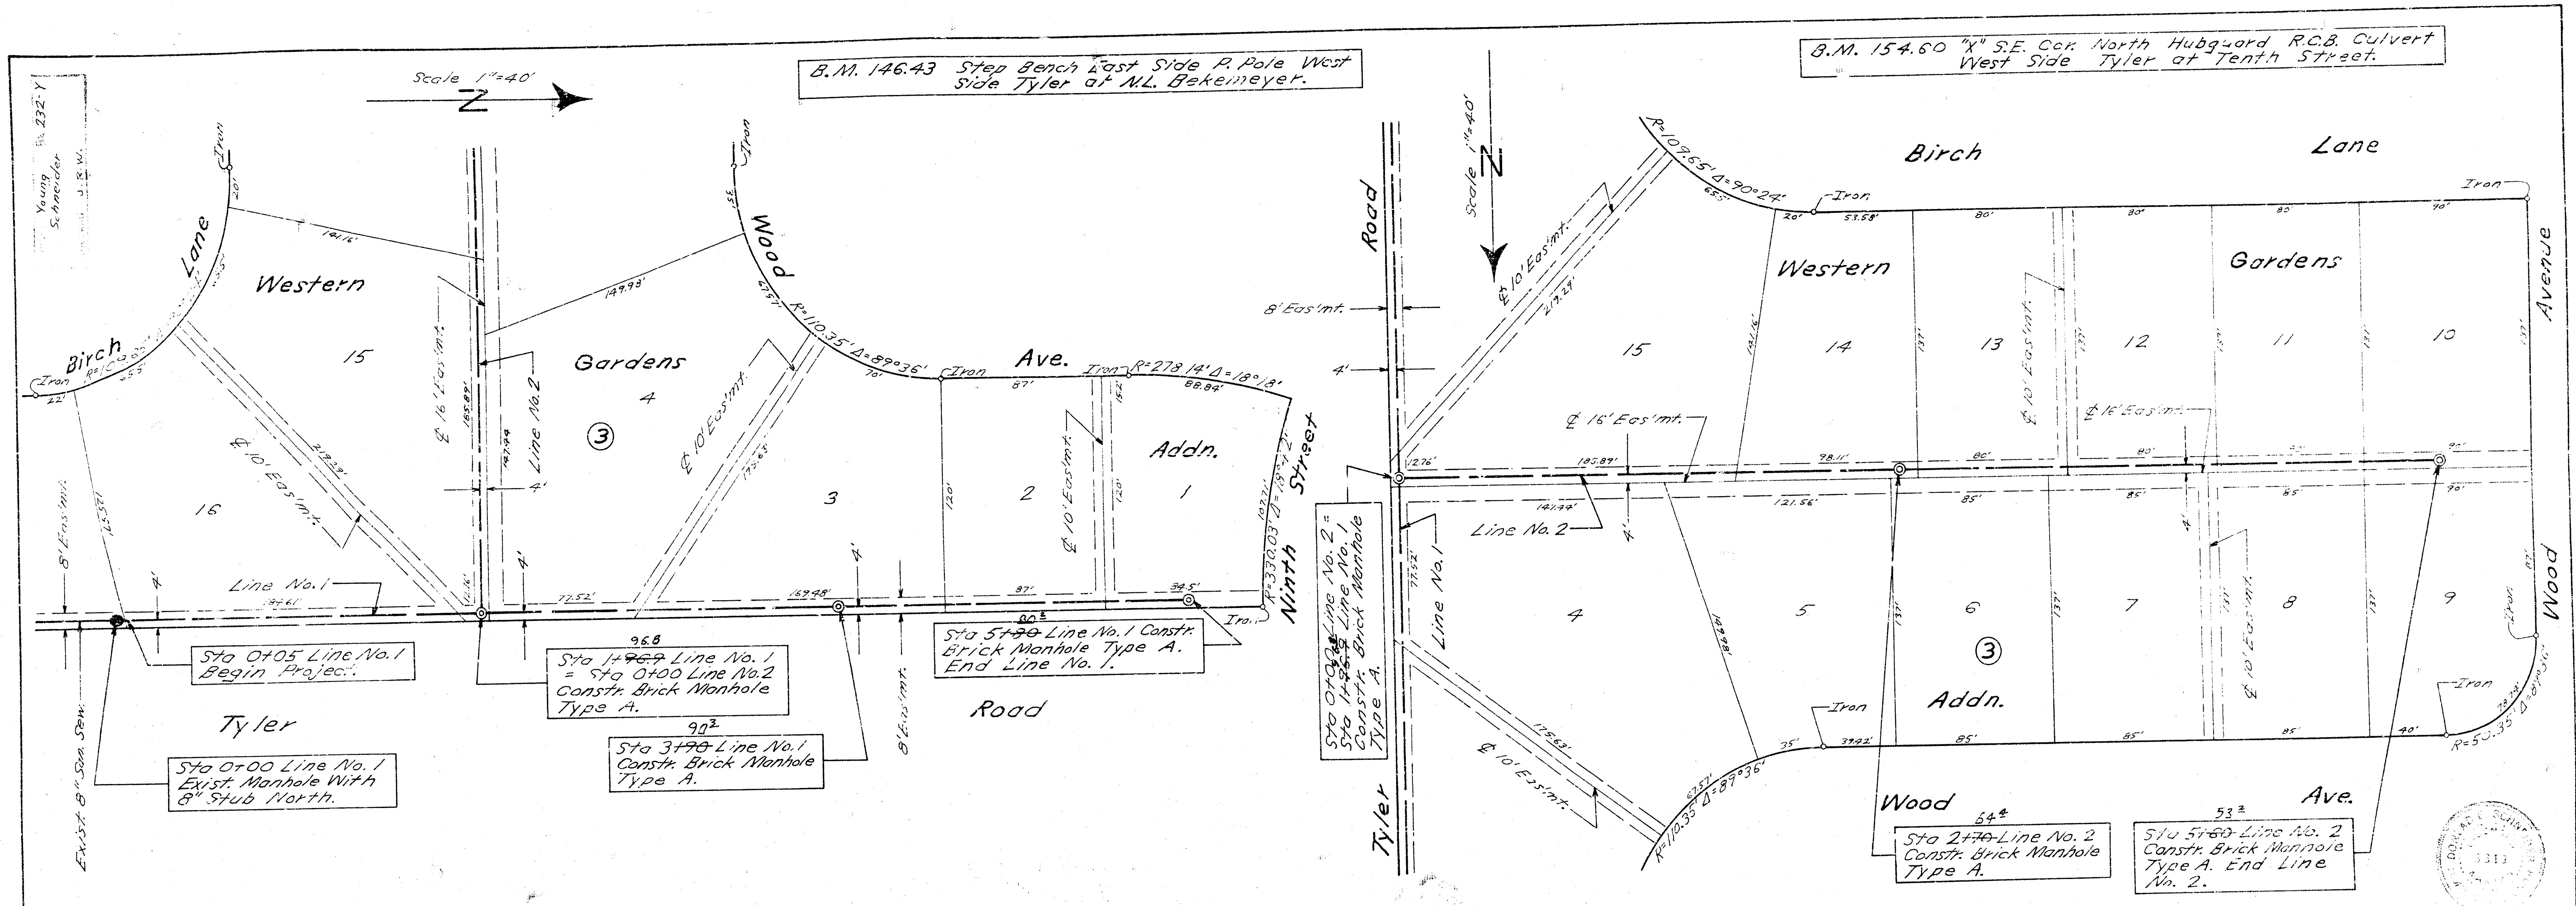

LAT. 31, WESTLINK SEWER  
 CITY OF WICHITA, KANSAS  
 R. W. LINN, CITY ENGINEER  
 PROJ. NO. DBKL 567058  
 DATE: NOV. 1972  
 SHEET NO. 1 OF 1