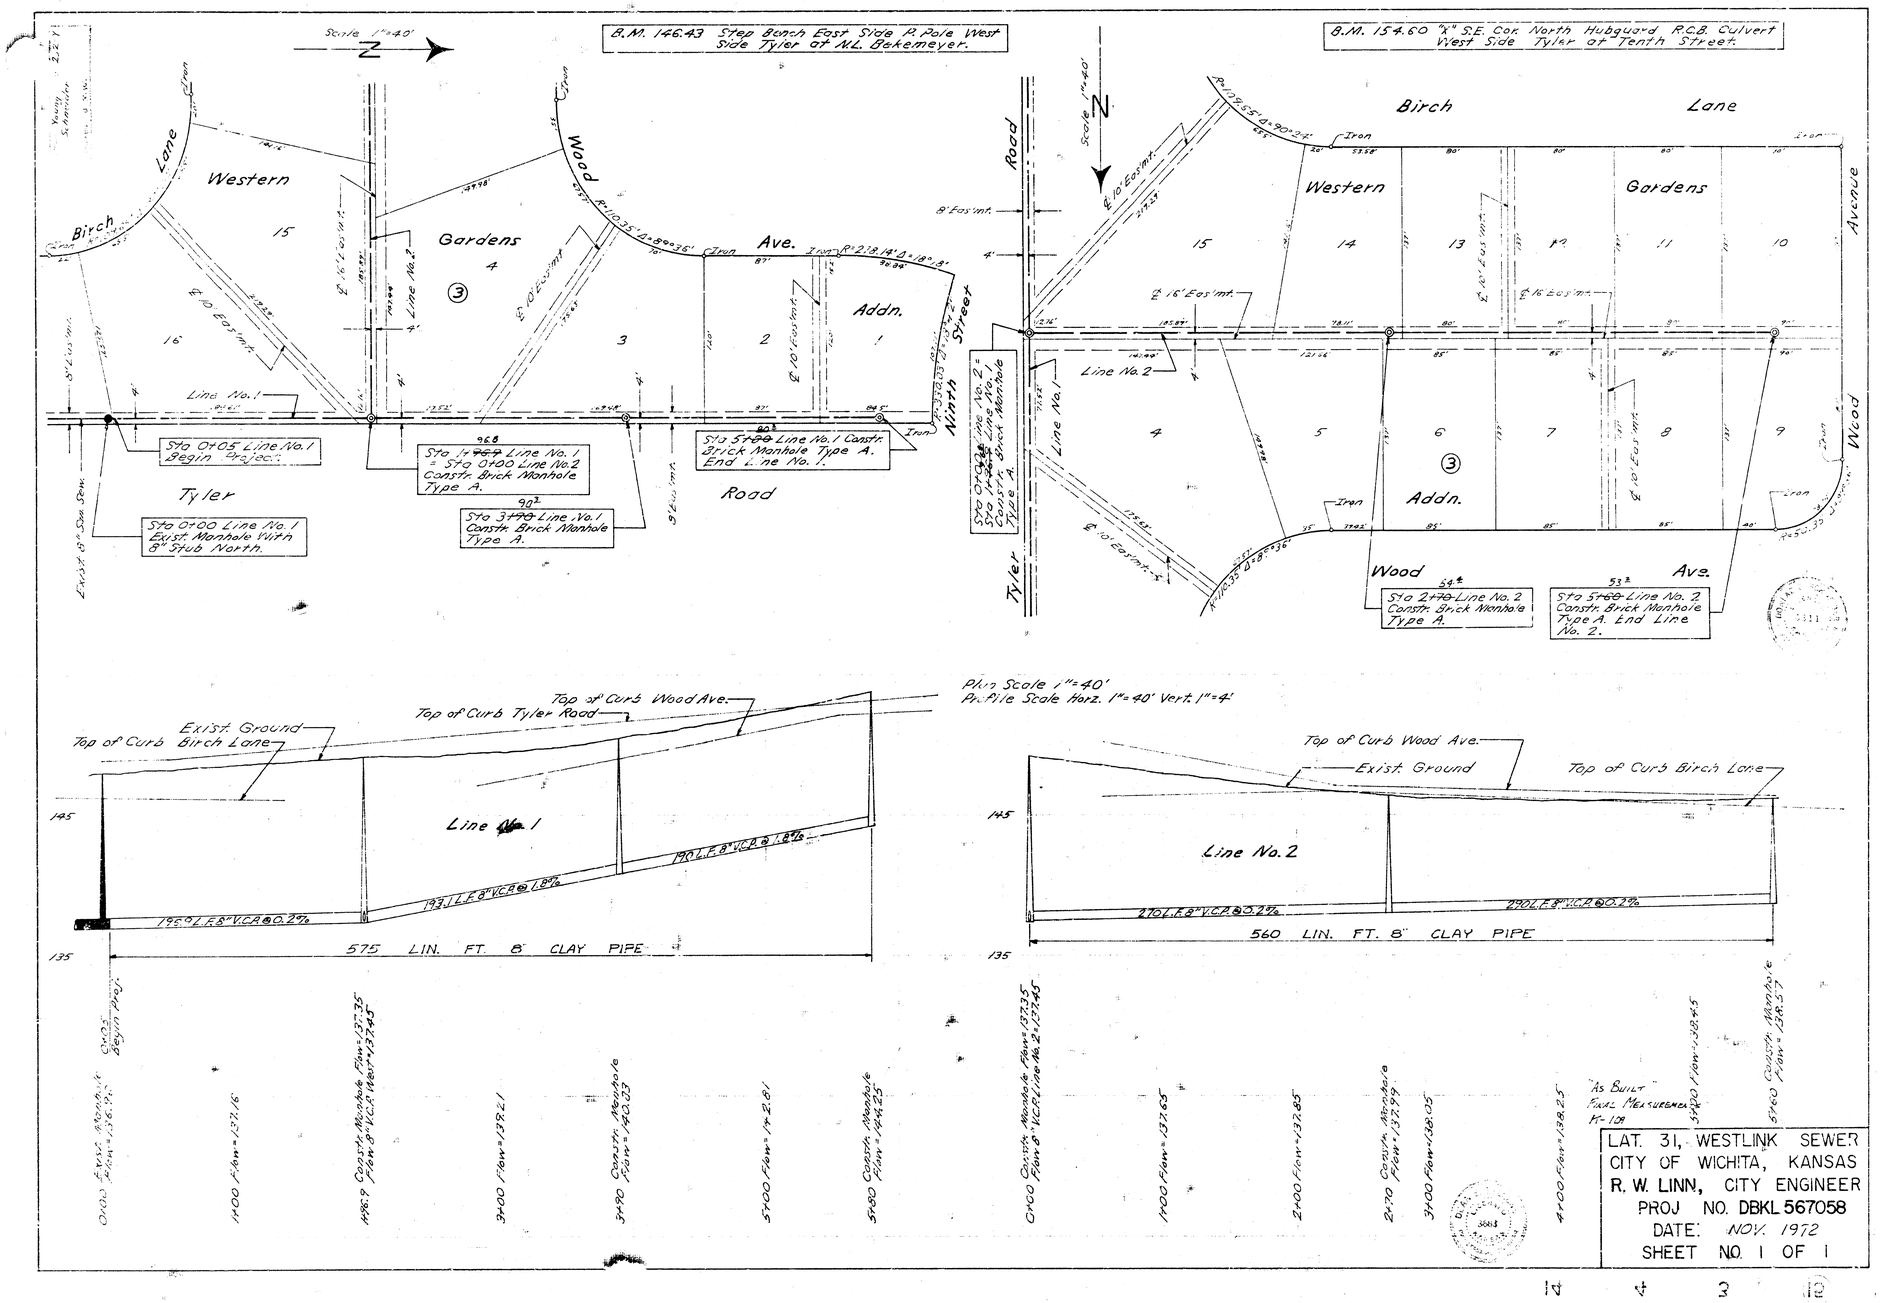
Scale 1"=40'
B.M. 146.43 Step Bench East Side P. Pole West Side Tyler at N.L. Bekemeyer.
B.M. 154.60 "X" S.E. Cor. North Hubguard R.C.B. Culvert West Side Tyler at Tenth Street.
Birch Lane
Western Gardens Addn.
Wood Ave.
Ninth Street
Tyler Road
Line No. 1
Line No. 2
Sta 0+05 Line No. 1 Begin Project
Sta 0+00 Line No. 1 Exist. Manhole With 8" Stub North.
Sta 1+68 Line No. 1 = Sta 0+00 Line No. 2 Constr. Brick Manhole Type A.
Sta 3+90 Line No. 1 Constr. Brick Manhole Type A.
Sta 5+80 Line No. 1 Constr. Brick Manhole Type A. End Line No. 1.
Sta 0+00 Line No. 2 Constr. Brick Manhole Type A.
Sta 2+70 Line No. 2 Constr. Brick Manhole Type A.
Sta 5+60 Line No. 2 Constr. Brick Manhole Type A. End Line No. 2.
Plan Scale 1"=40'
Profile Scale Horz. 1"=40' Vert. 1"=4'
Top of Curb Birch Lane
Exist. Ground
Top of Curb Tyler Road
Top of Curb Wood Ave.
Line No. 1
Line No. 2
575 LIN. FT. 8" CLAY PIPE
560 LIN. FT. 8" CLAY PIPE
As Built Final Measurement
LAT. 31, WESTLINK SEWER
CITY OF WICHITA, KANSAS
R. W. LINN, CITY ENGINEER
PROJ NO. DBKL 567058
DATE: NOV. 1972
SHEET NO. 1 OF 1