




B. M. 155.470 "t" top west curb Chipper Lane
at S. L. Briarwood.

B. M. 157.080 Top ball S.W. cor. H.L.P. base
S-Side K. G. E. Westlink Sub station on 13th.

Plan Scale 1" = 40'
Profile Scale 1" = 40' Horiz.
1" = 5' Vert.

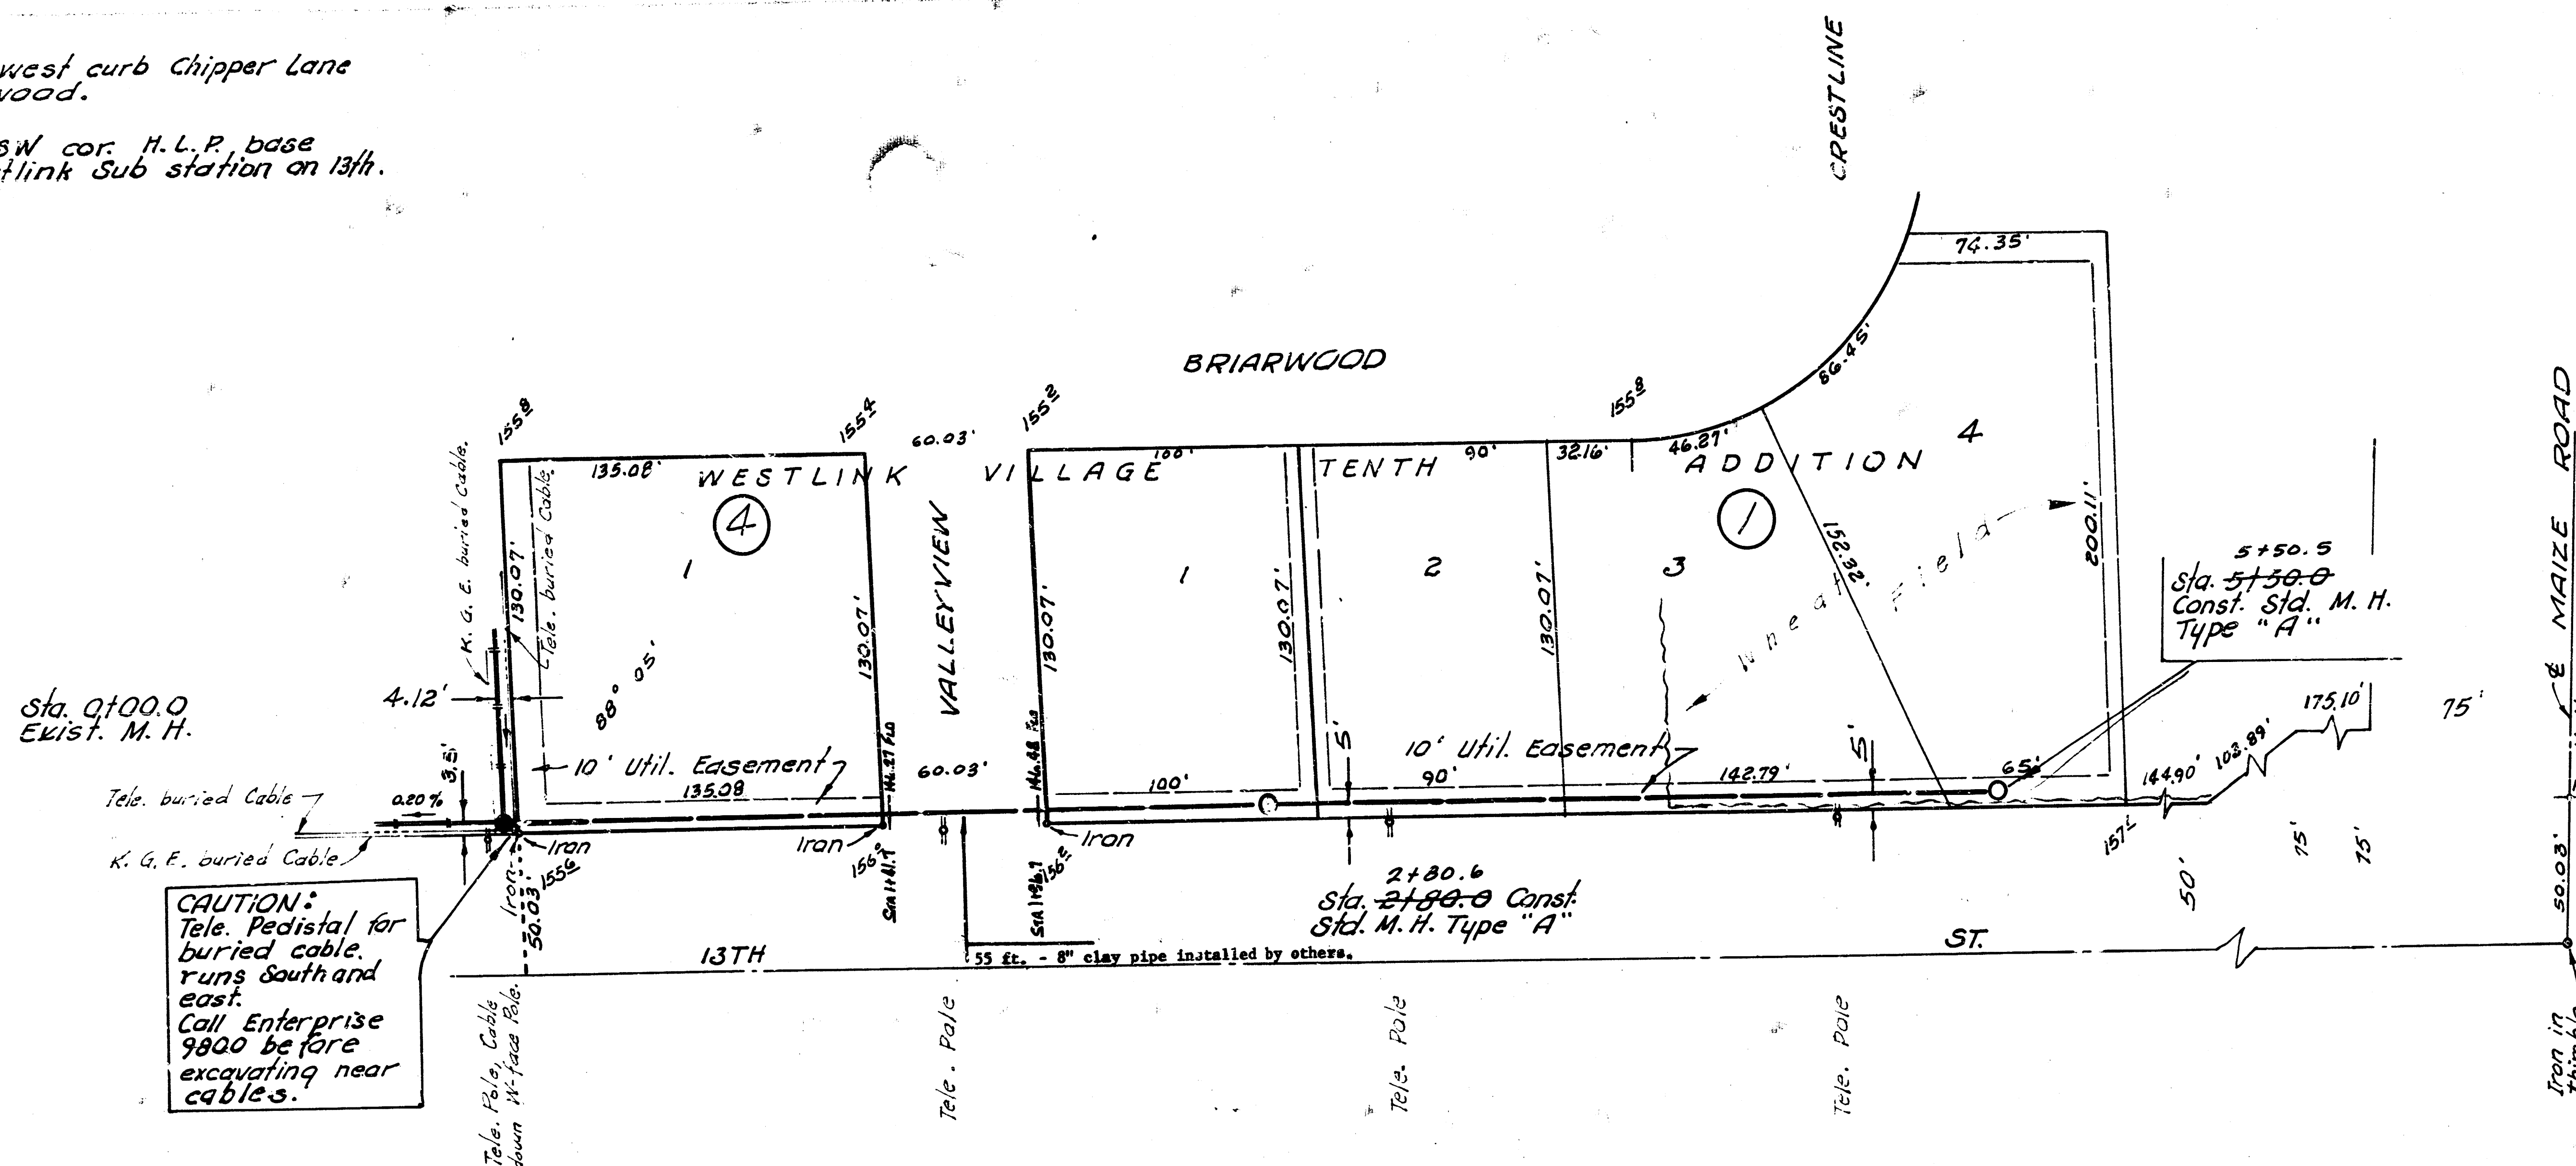

CAUTION:
Tele. Pedestal for
buried cable
runs south and
east.
Call Enterprise
9800 before
excavating near
cables.

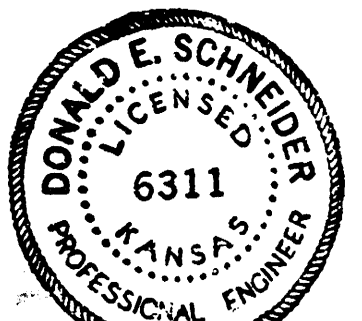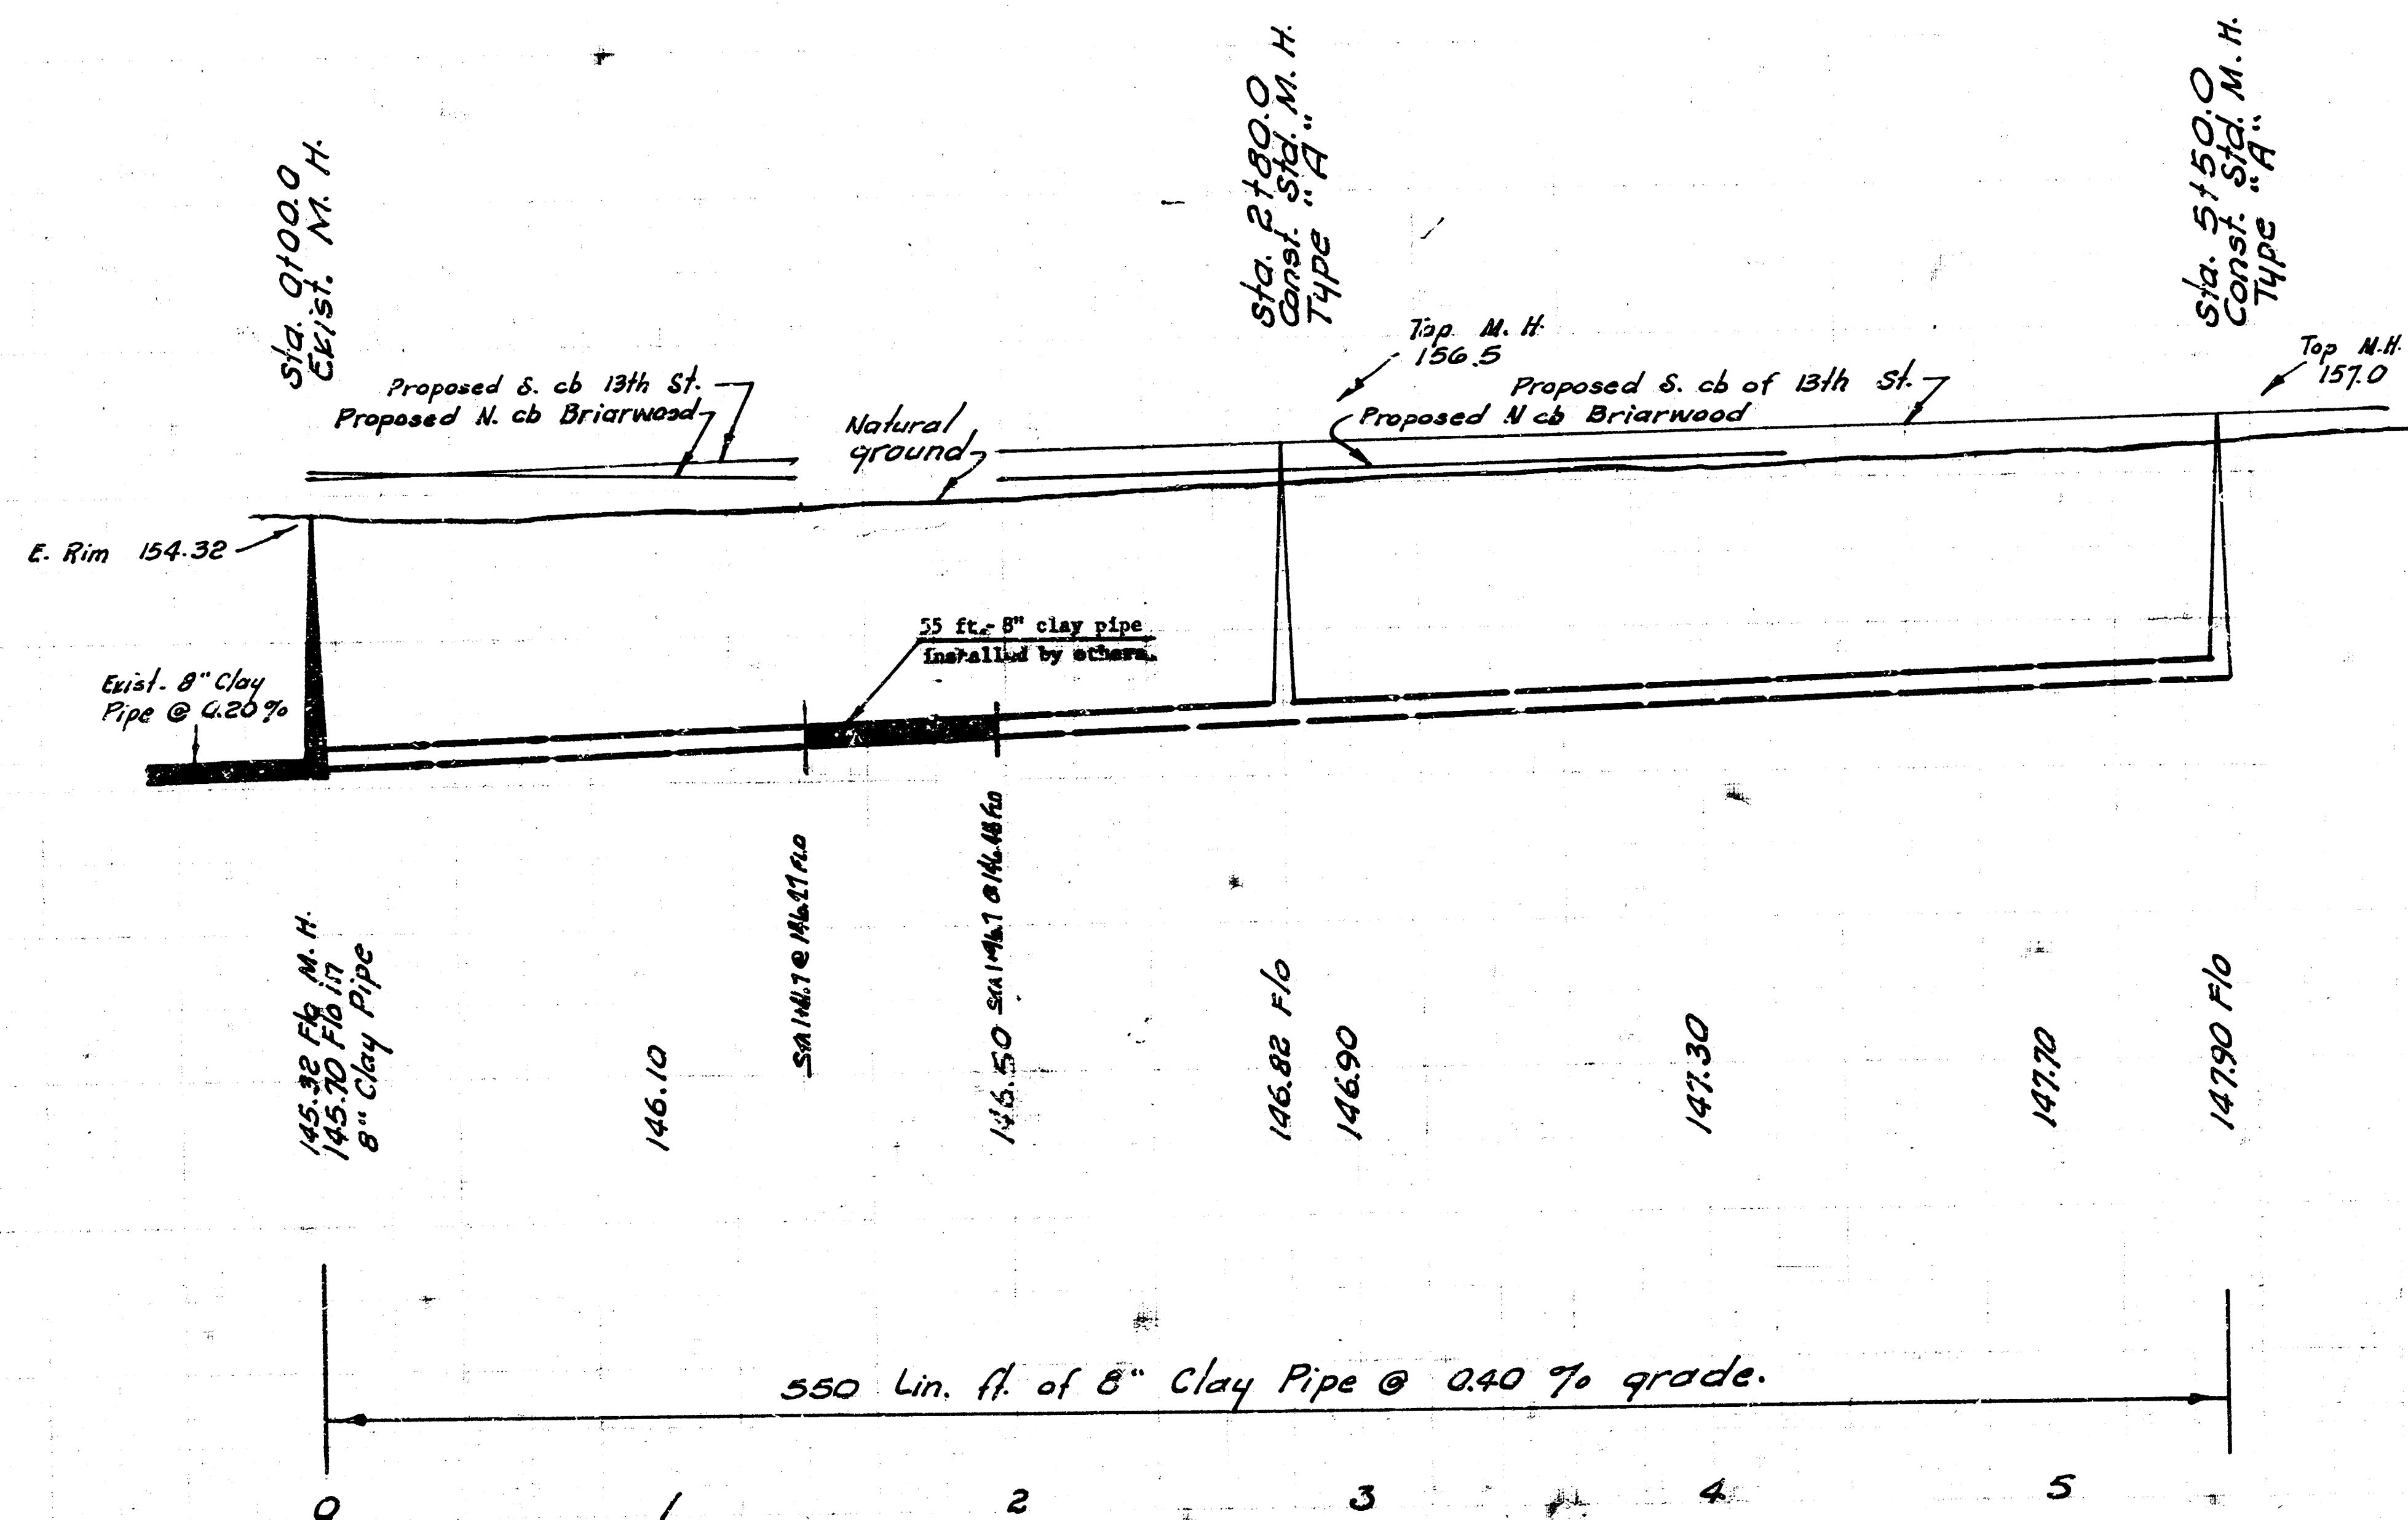

LAT. 55, WESTLINK SEWER
CITY OF WICHITA, KANSAS
R. W. LINN — CITY ENGINEER
AUGUST 1973, PROJECT NO. DBKL572048

FILMED FROM THE BEST
AVAILABLE COPY....