


B.M. 155.470 + Top West curb Chipper Lane at S. L. Briarwood.
 3. M. 157.090 Top bolt SW cor. H.L.P. base S-Side K & E. Westlink Sub station on 13th.

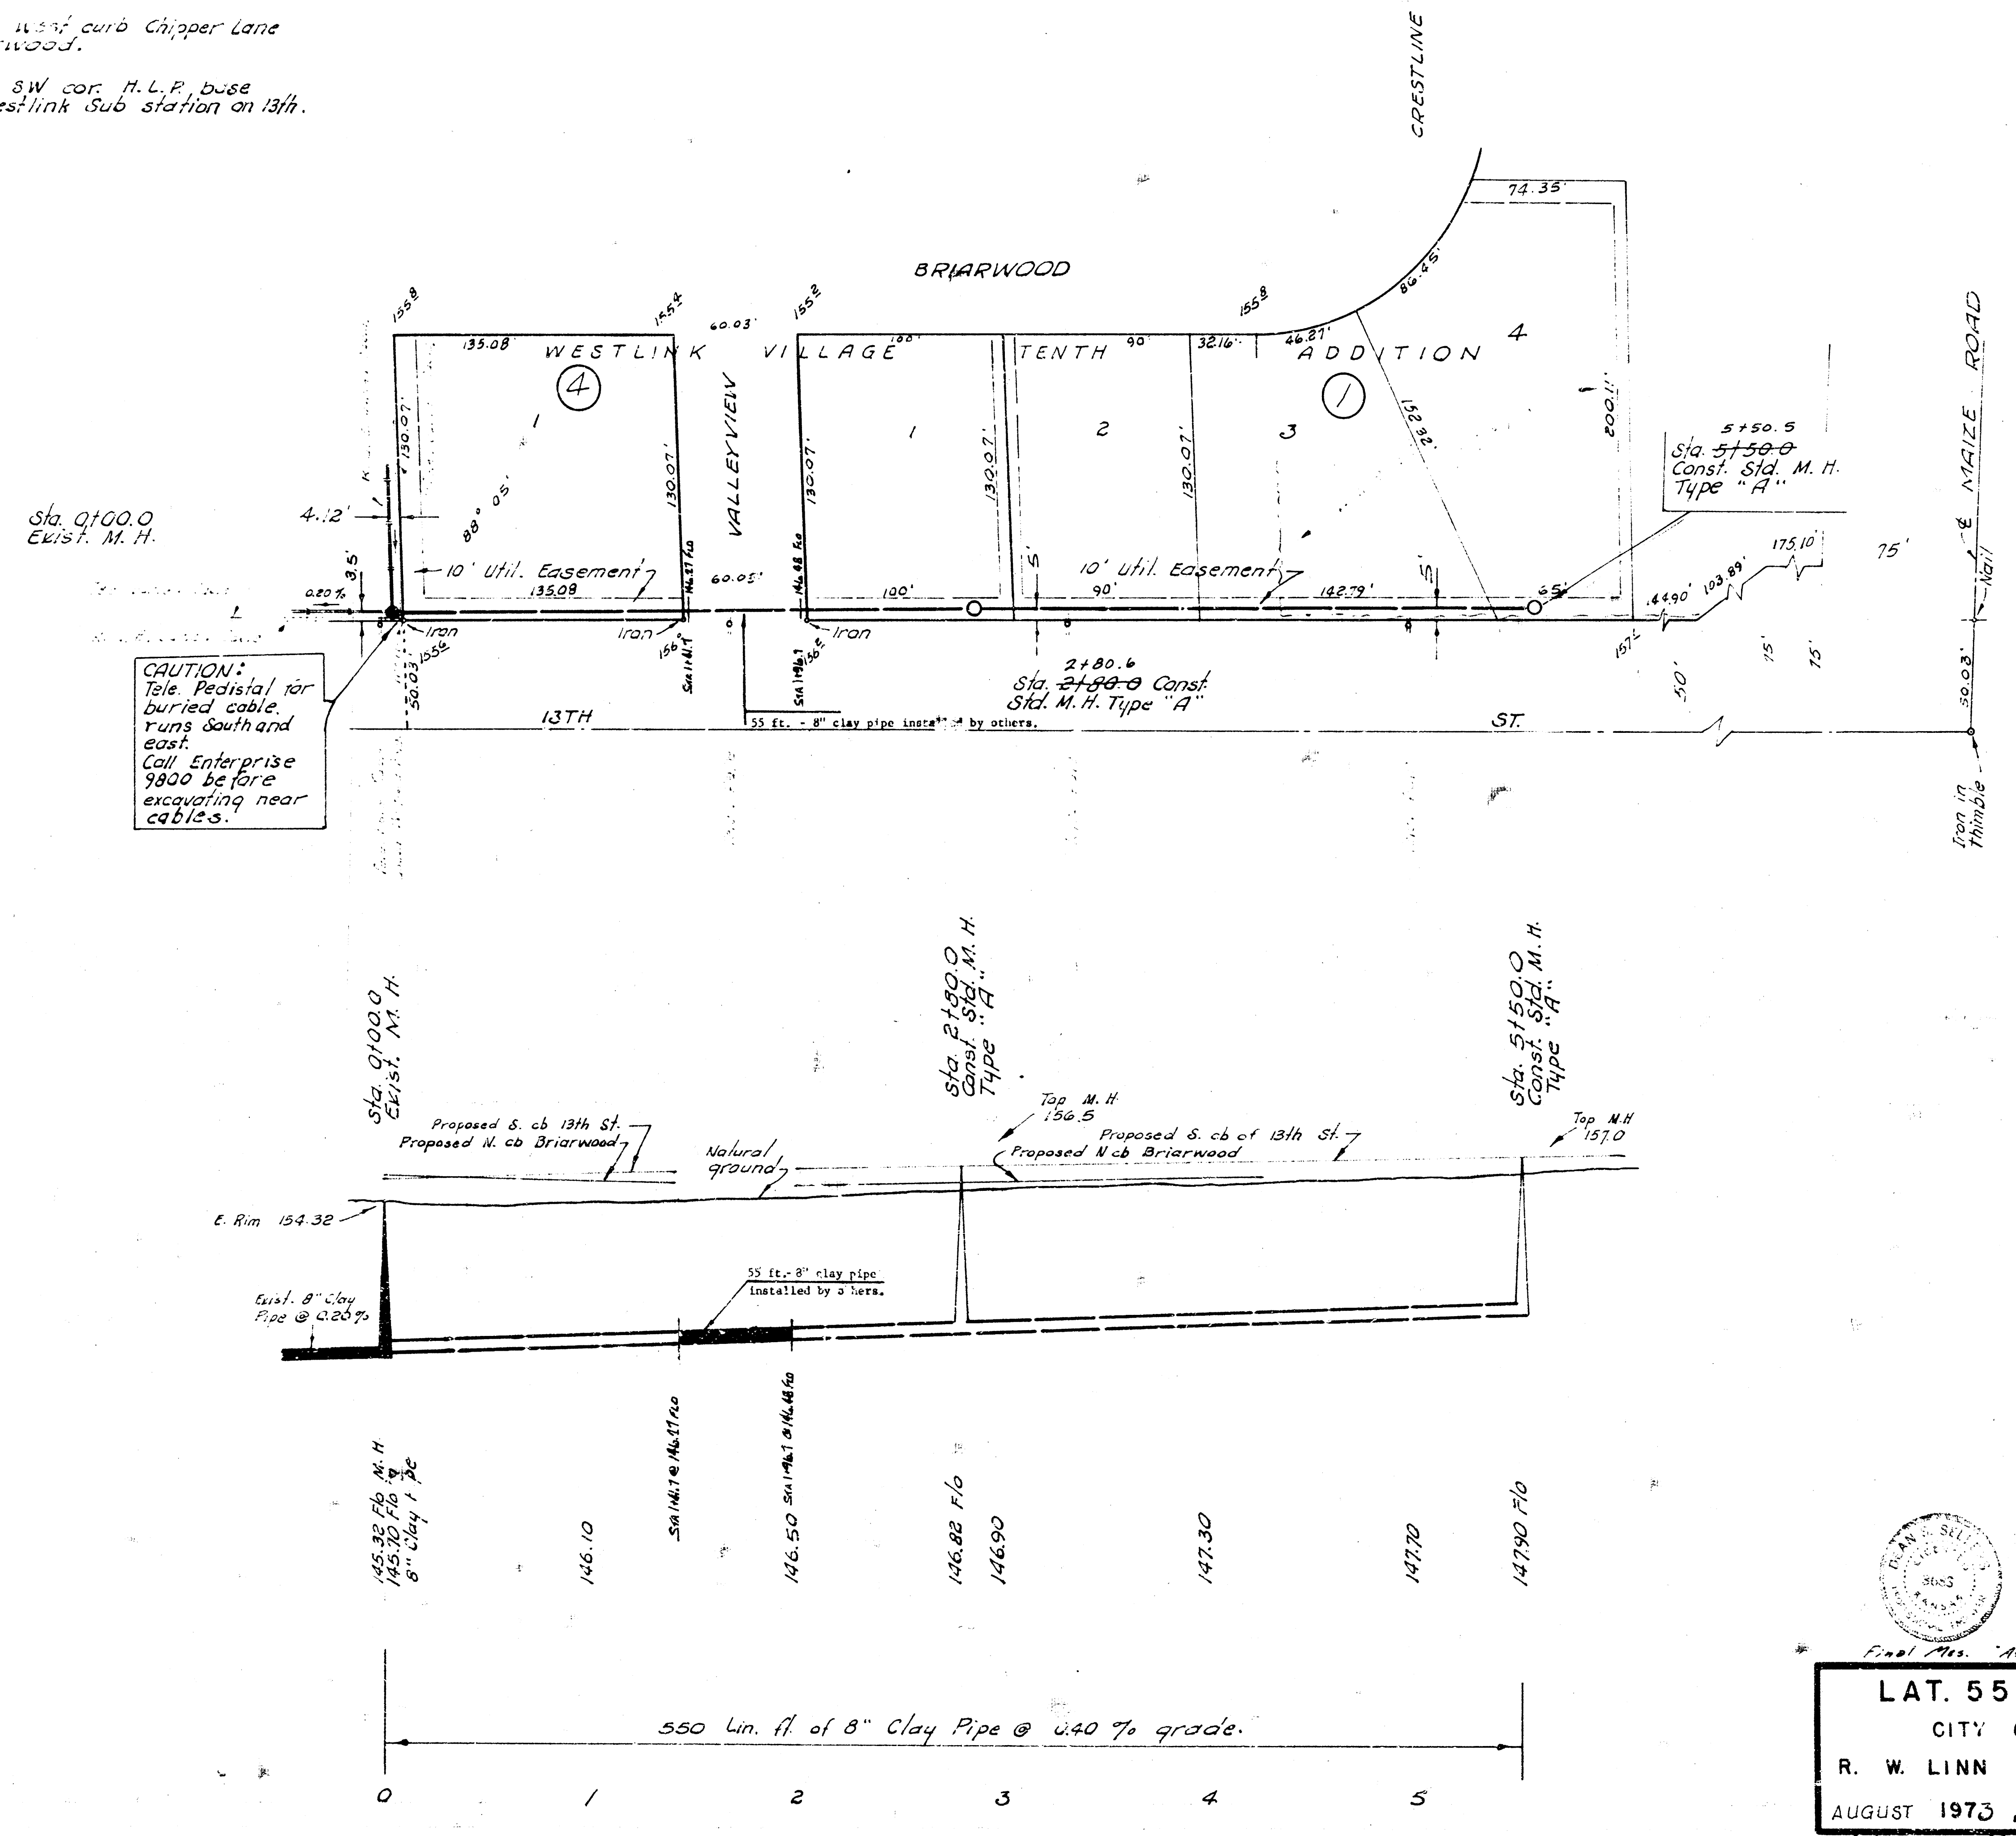

Plan Scale 1" = 40'
 Profile Scale 1" = 40' Horiz.
 1" = 5' Vert.

LAT. 55, WESTLINK SEWER
 CITY OF WICHITA, KANSAS
 R. W. LINN — CITY ENGINEER
 AUGUST 1973, PROJECT NO. DBKL572048