




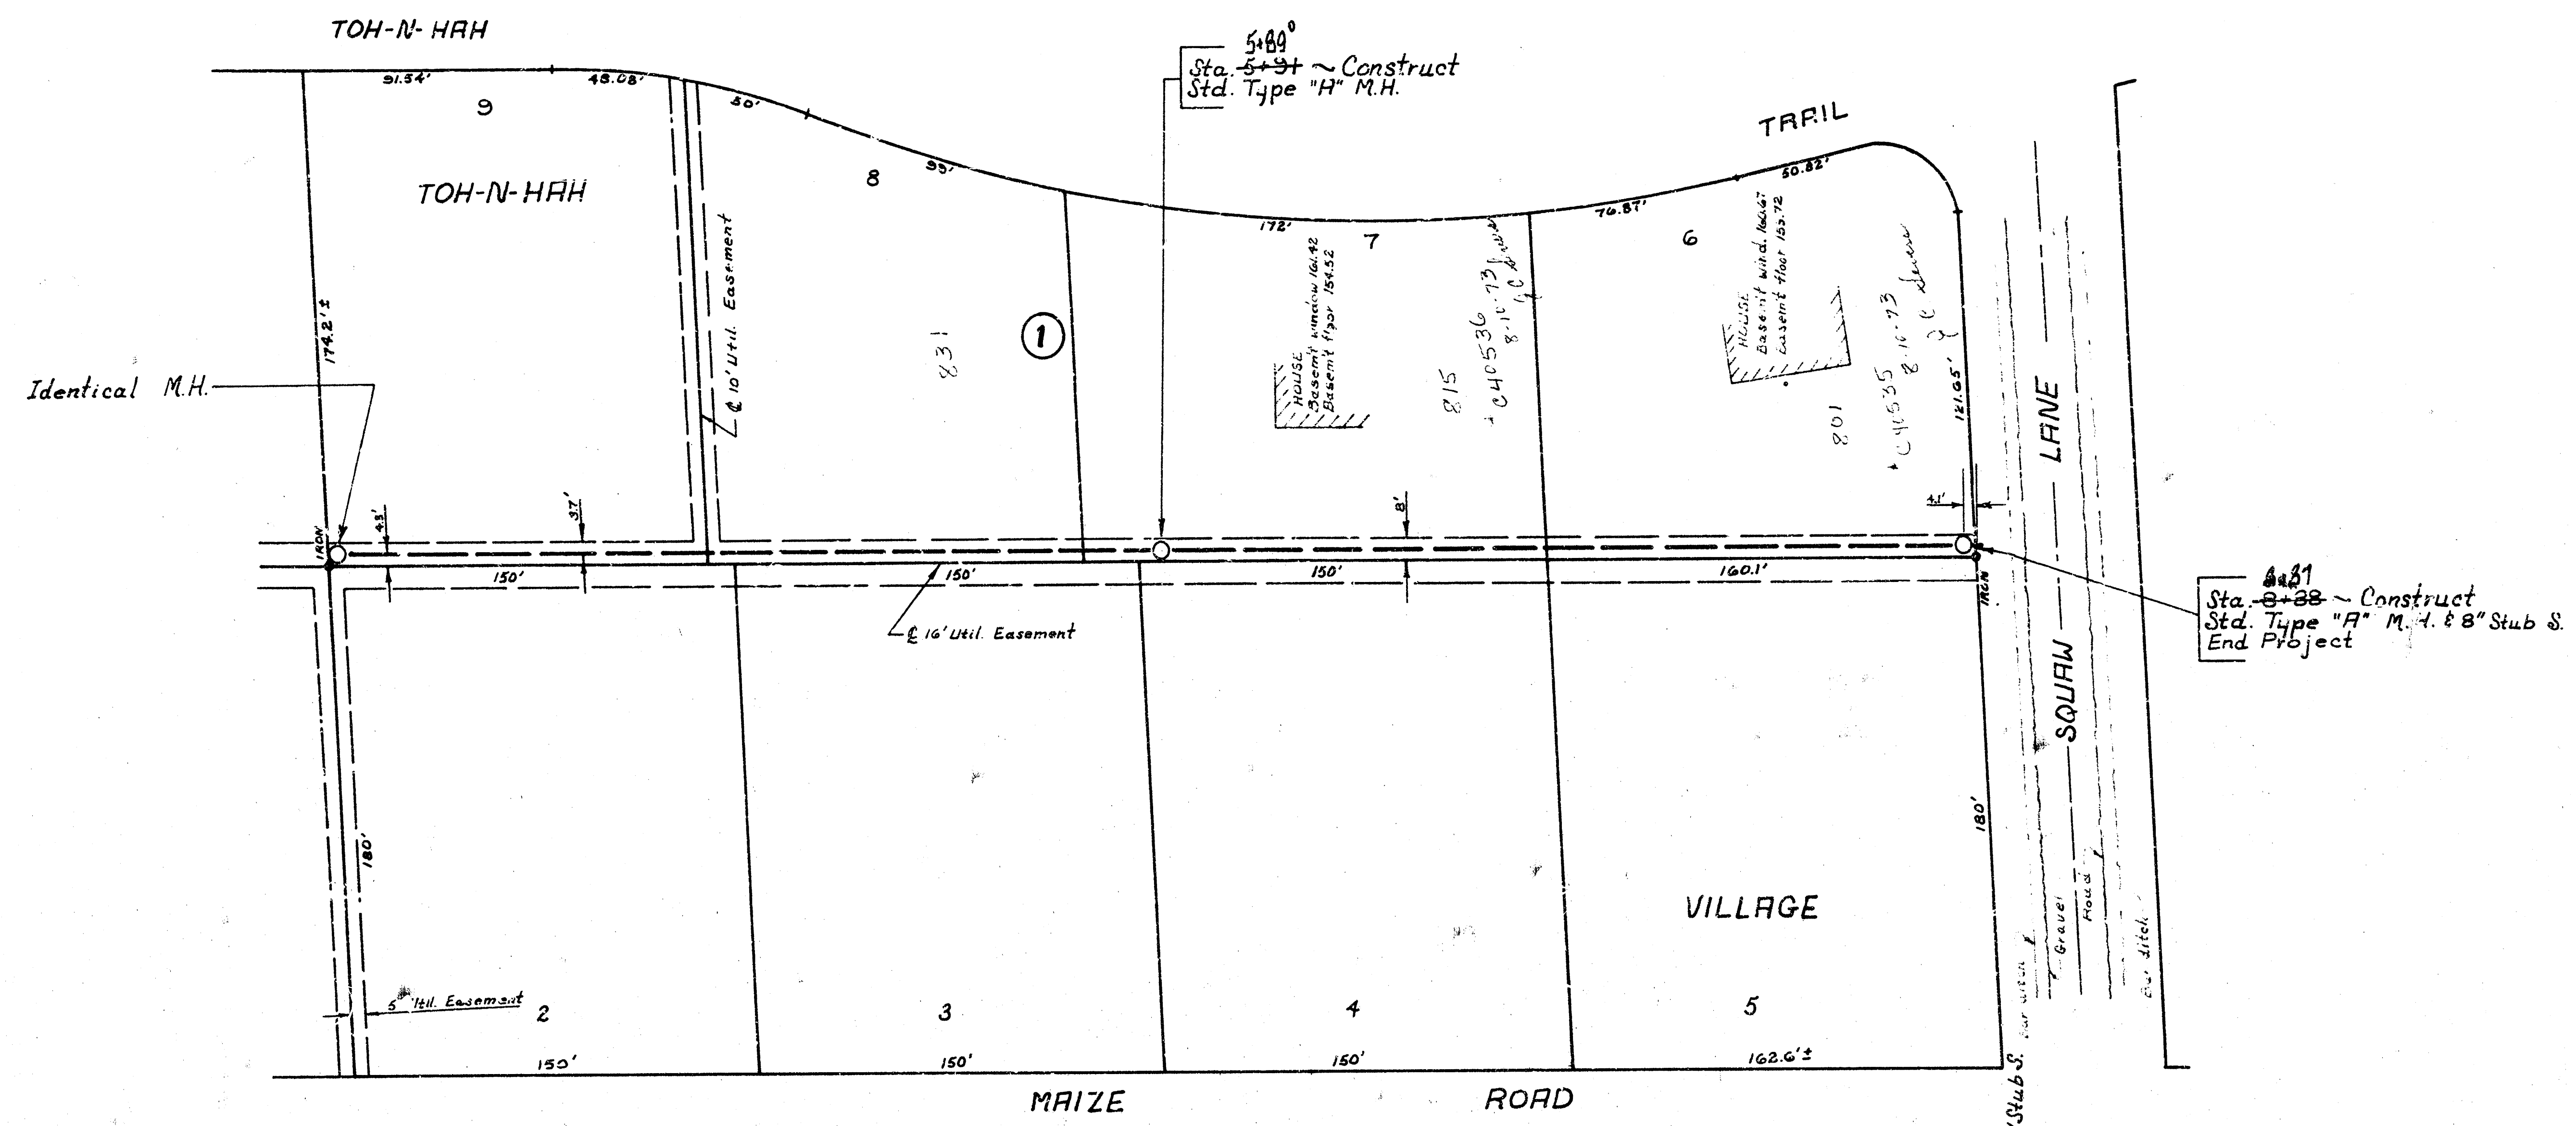

N  
 Plan Scale ~ 1" = 40'  
 Profile Scale ~ Vert. 1" = 5'  
 Horiz. 1" = 40'

