
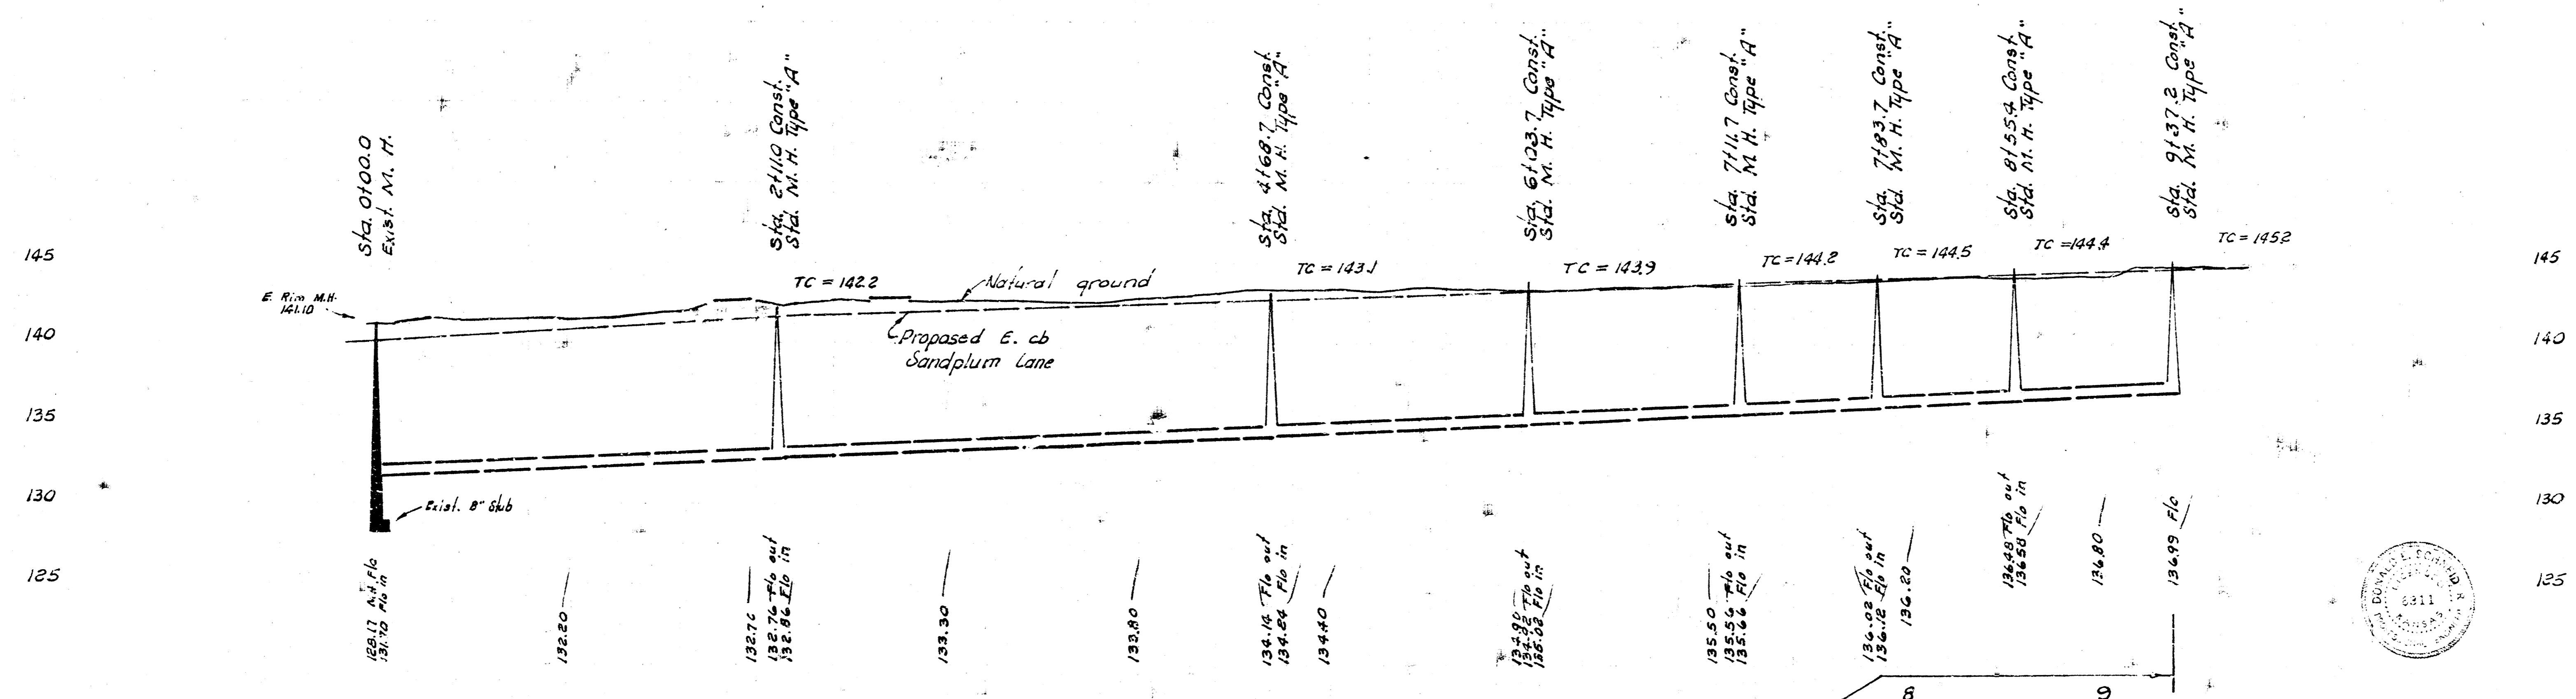


- B. M. 139.19 a top curb 1' west of w. end N.W. Radius Mulberry and Sandplum.
- B. M. 145.44 "M" in Mid Kansas 1 1/2' S. of S. end S.E. Radius Sandplum & Scouller.
- B. M. 143.20 S. S. drive @ garage wall House 1218 Sandplum.

Plan Scale 1" = 40'
Profile Scale 1" = 40' Horiz.
1" = 5' Vert.

NOTE: Replace all conc. drives.

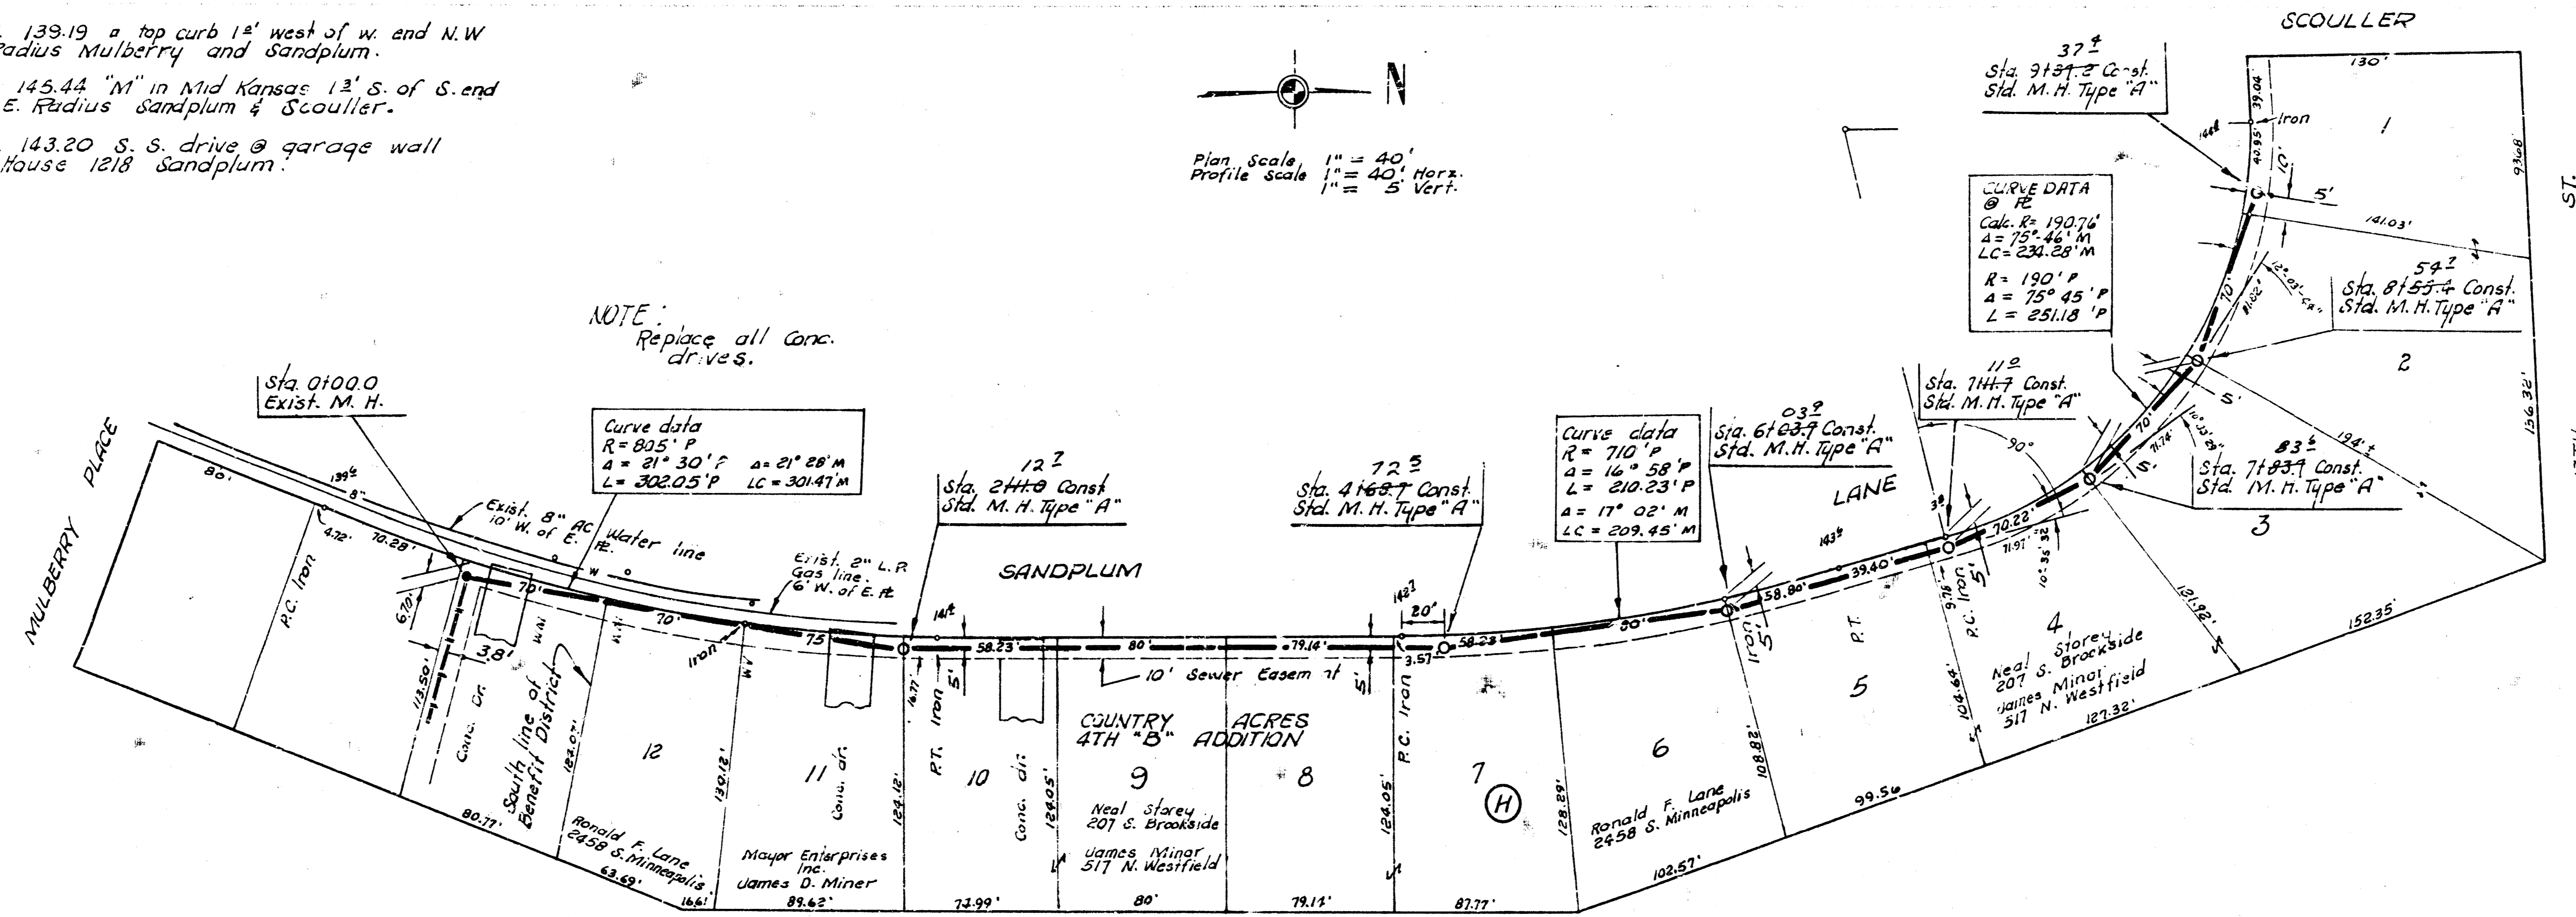

LAT. 59, WESTLINK SEWER
CITY OF WICHITA, KANSAS
R. W. LINN — CITY ENGINEER
APRIL 1974 PROJECT NO. DBKL 573085