
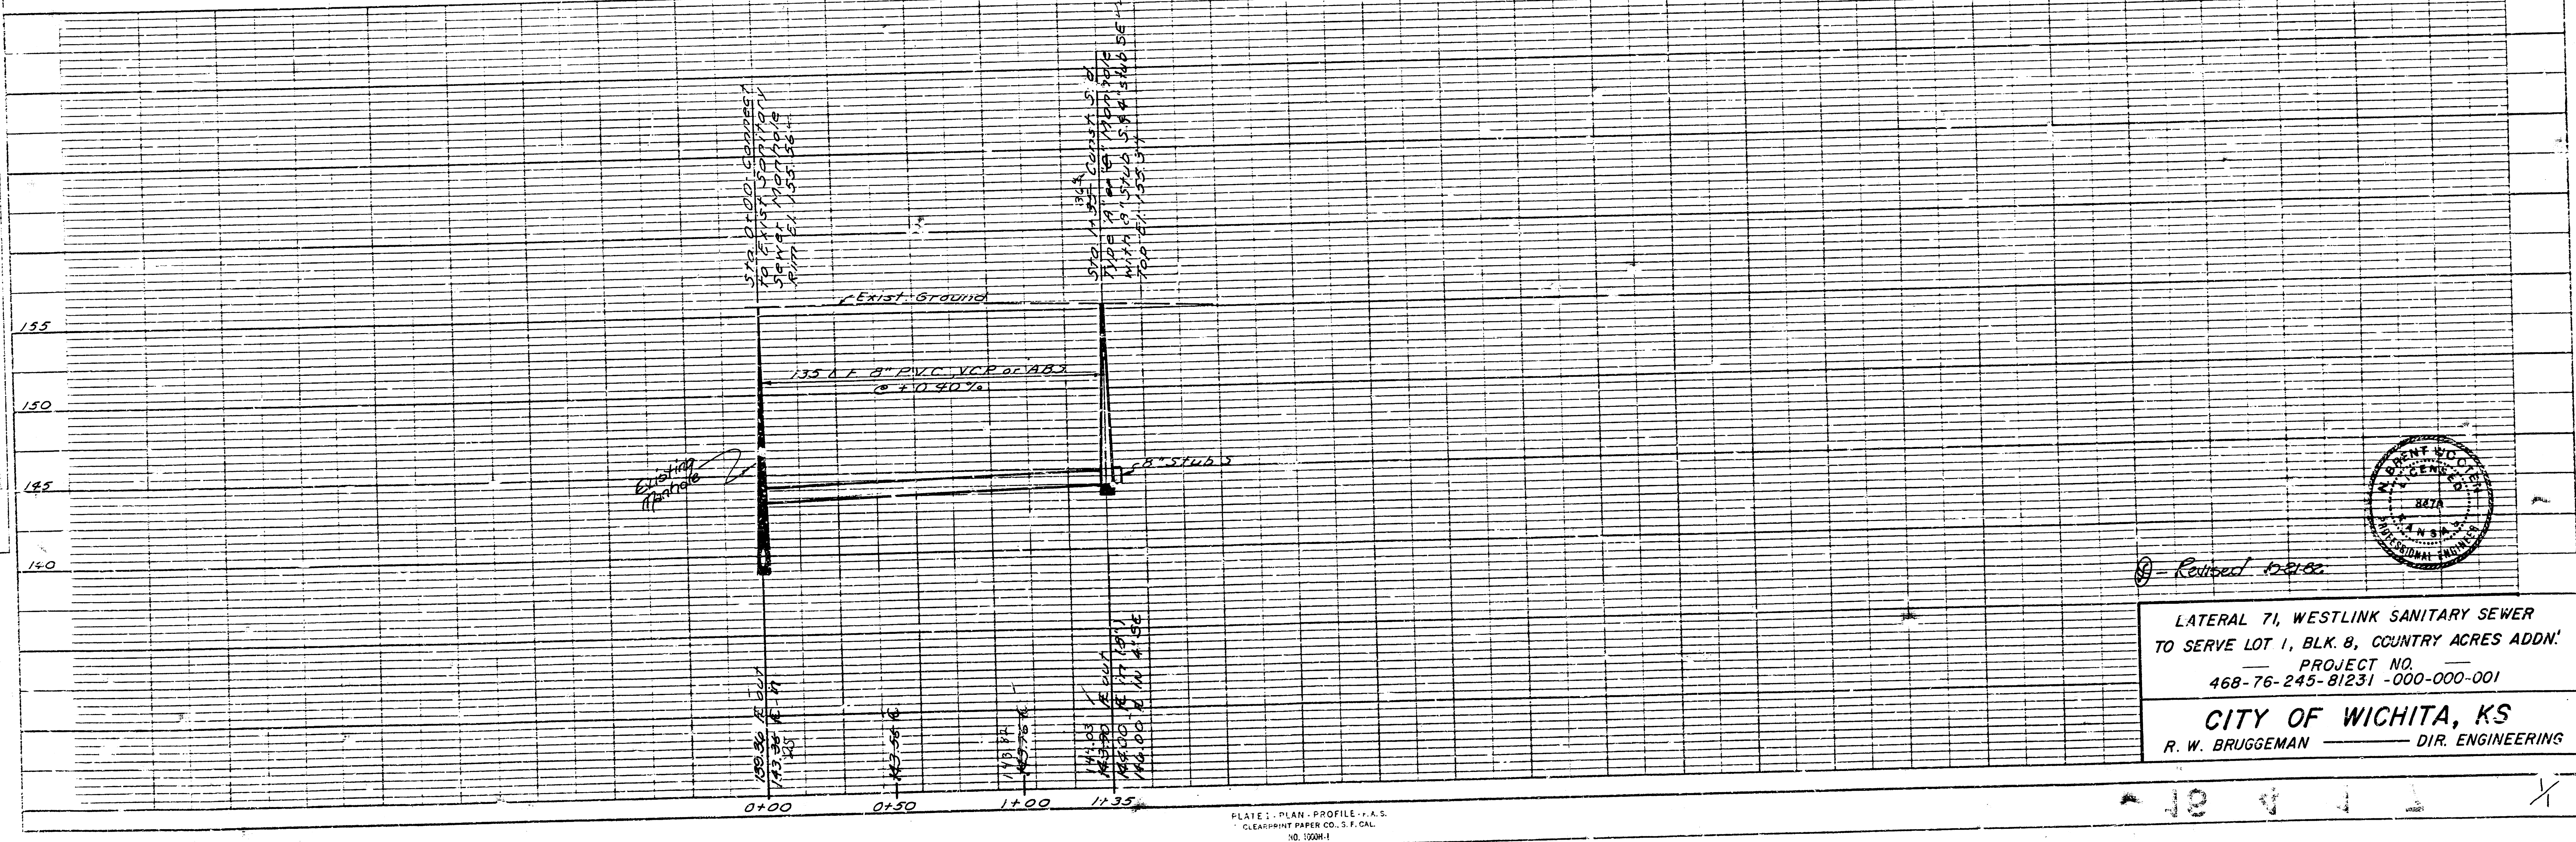


PLAN
 1" = 30'
 1" = 5'

PROFILE
 1" = 10'
 1" = 10'

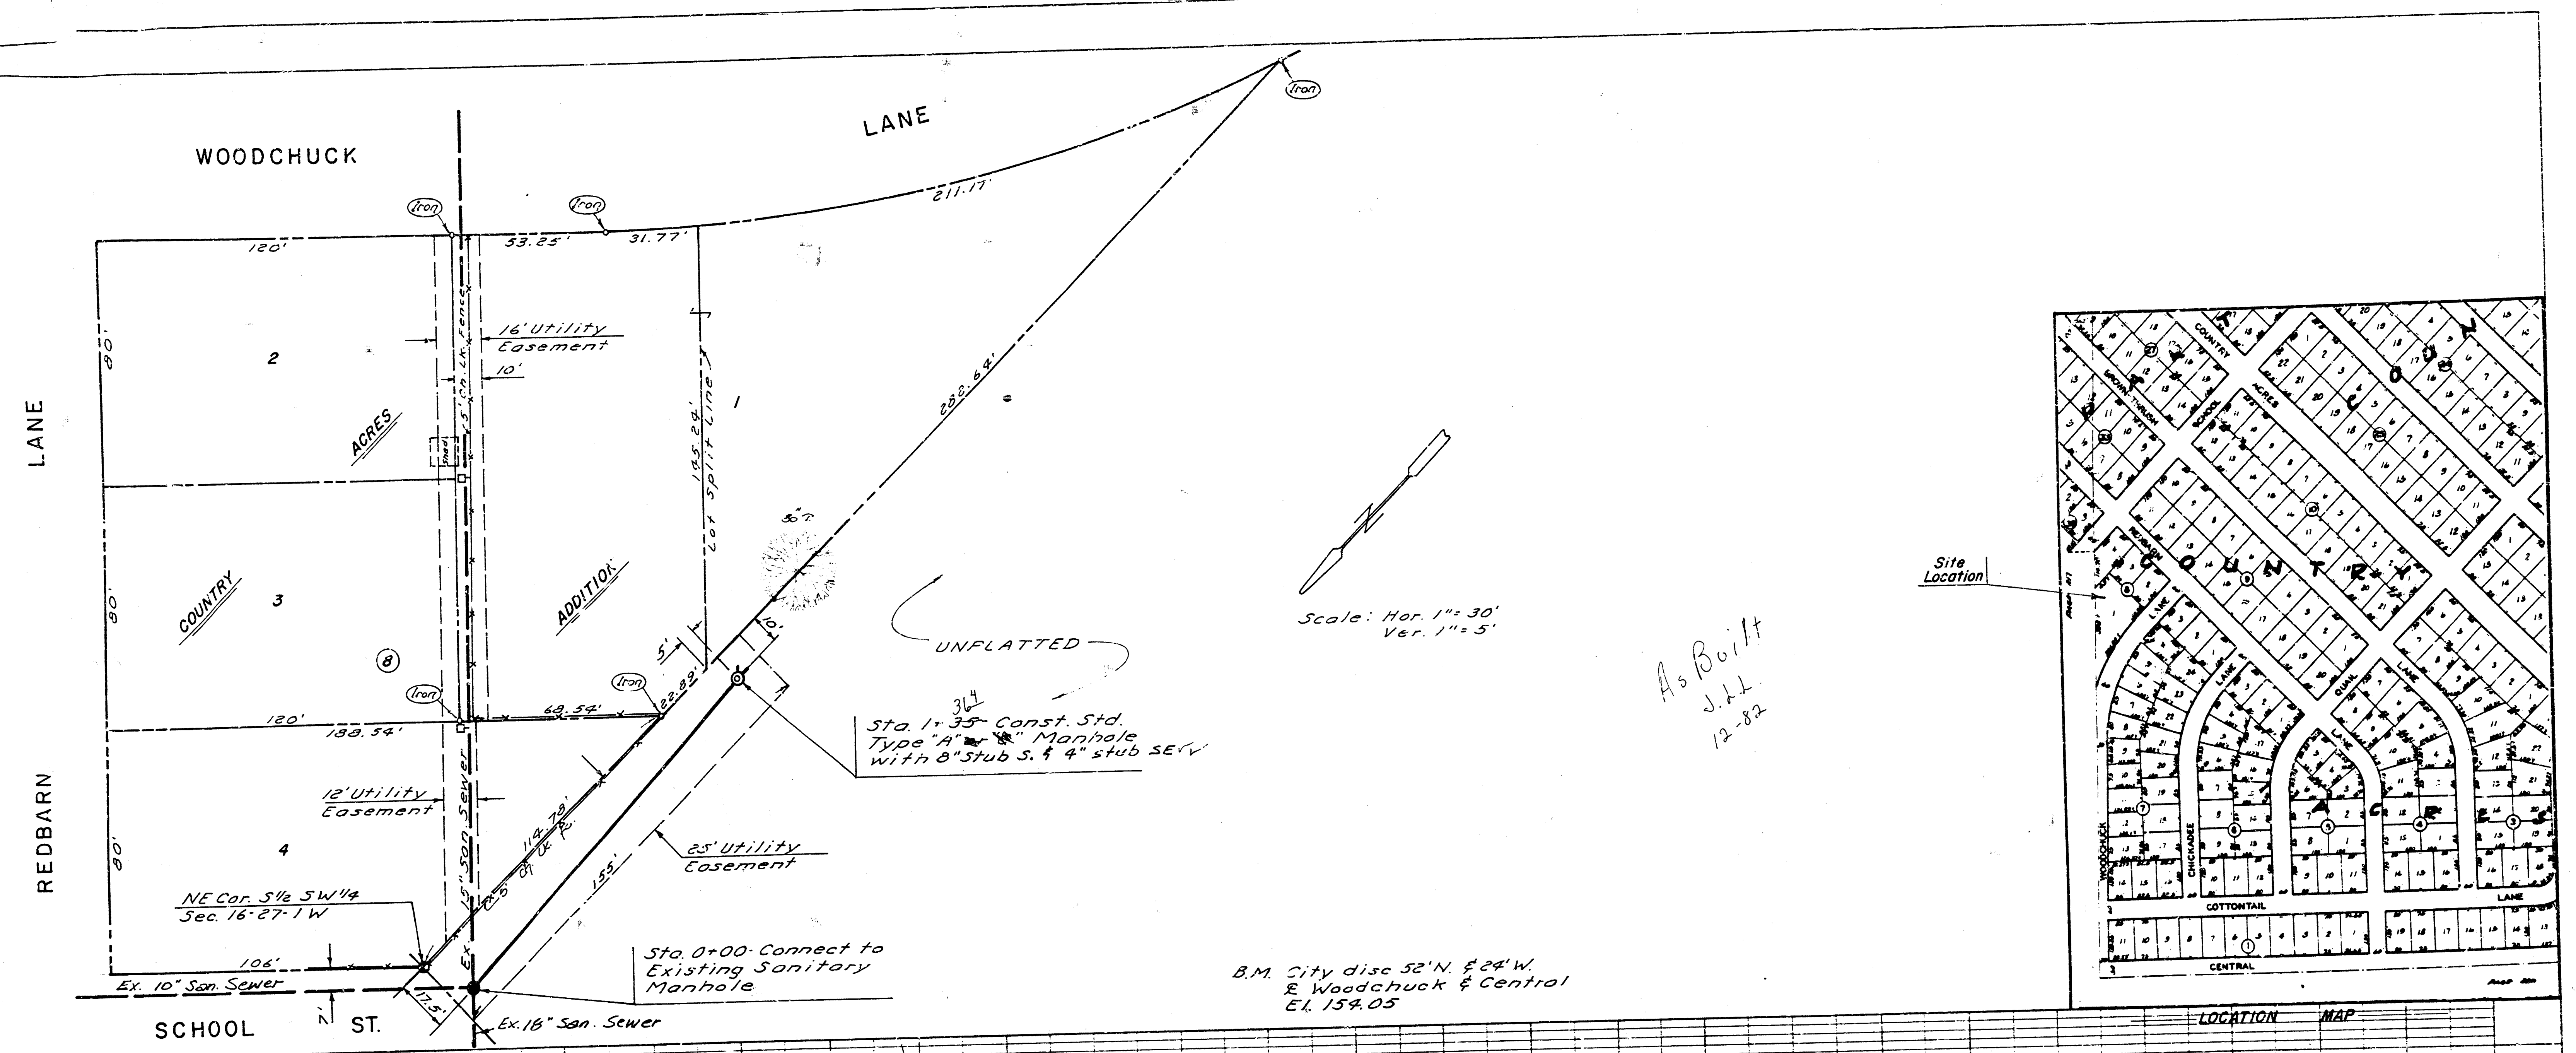

Revised 12-82

LATERAL 71, WESTLINK SANITARY SEWER
 TO SERVE LOT 1, BLK. 8, COUNTRY ACRES ADDN.
 PROJECT NO.
 468-76-245-81231-000-000-001

CITY OF WICHITA, KS
 R. W. BRUGGEMAN — DIR. ENGINEERING