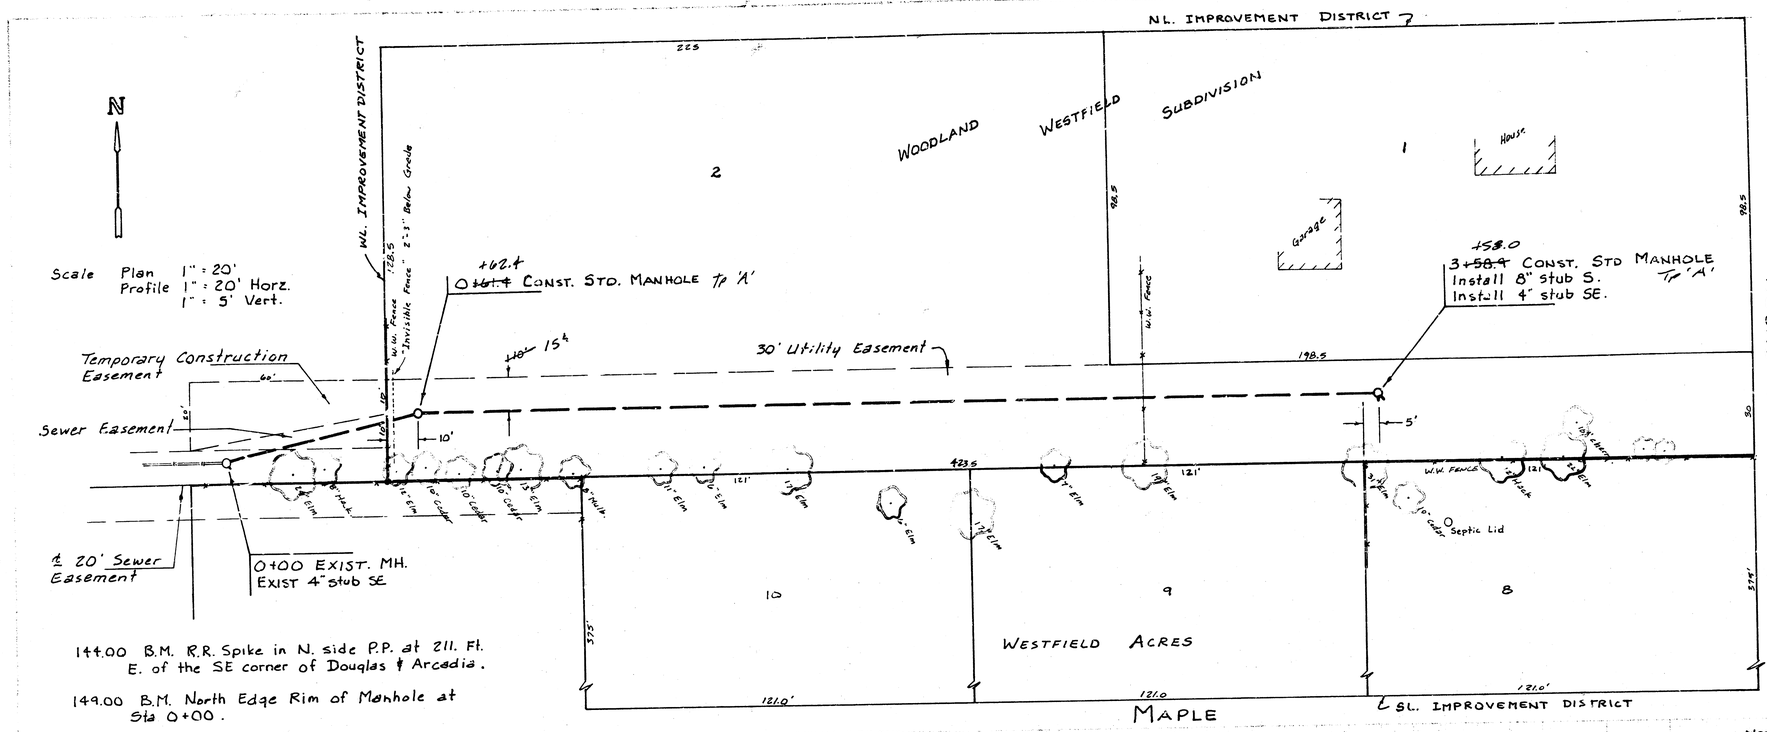

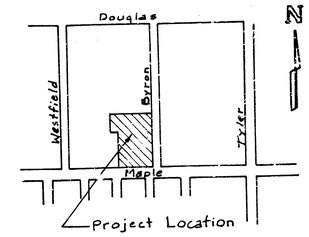

GENERAL NOTES

1. ALL CONSTRUCTION AND MATERIALS TO COMPLY WITH CITY OF WICHITA SPECIFICATIONS AND STANDARDS.
2. ALL ELEVATIONS SHOWN ARE CITY OF WICHITA DATUM (0505-1157.6 = CITY DATUM).
3. THE CONTRACTOR SHALL LIMIT THE EXTENT OF TRENCH TO REMAIN OPEN OVERNIGHT AND WEEKENDS TO LESS THAN 50 FEET.
4. AT LEAST 48 HOURS PRIOR TO BEGINNING EXCAVATION, IF REQUIRED, (EXCLUDING WEEKENDS AND HOLIDAYS) THE CONTRACTOR SHALL CONTACT THE KANSAS ONE-CALL SYSTEM, A UTILITY LOCATION SERVICE, AT (316) 837-8479 TO REQUEST THE FOLLOWING UTILITY COMPANIES TO LOCATE ANY EXISTING LINES WITHIN THE PROJECT AREA: GAS SERVICE COMPANY, S.B.C.SE., THE WICHITA WATER DEPARTMENT, AIR CAPITAL CABLEVISION, AND THE TELEPHONE COMPANY.
5. THE CONTRACTOR SHALL BE RESPONSIBLE FOR PRESERVING PROPERTY CORNERS. THE CONTRACTOR SHALL BE REQUIRED TO RE-ESTABLISH ANY PROPERTY CORNERS WHICH ARE DAMAGED OR DESTROYED BY HIS CONSTRUCTION OPERATIONS. SUCH CORNERS SHALL BE RE-ESTABLISHED BY A LICENSED LAND SURVEYOR IN ACCORDANCE WITH STATE LAWS. ALL COSTS FOR THIS WORK SHALL BE INCIDENTAL TO THE OTHER ITEMS OF WORK.
6. UNLESS OTHERWISE SPECIFIED ON THE PLANS MANHOLES MAY BE TYPE "A", "C", OR "B" MANHOLES. MANHOLES SHALL BE CONSTRUCTED IN ACCORDANCE WITH THE STANDARD SPECIFICATIONS AND THE STANDARD DETAIL DRAWINGS.

NOTE: The Contractor shall not remove any trees and shall avoid trimming of any trees. Where the Contractor believes trimming is unavoidable he shall coordinate such work with the Engineer.

NOTE: Cost of Fence Removed and Replaced shall be incidental to the Project.

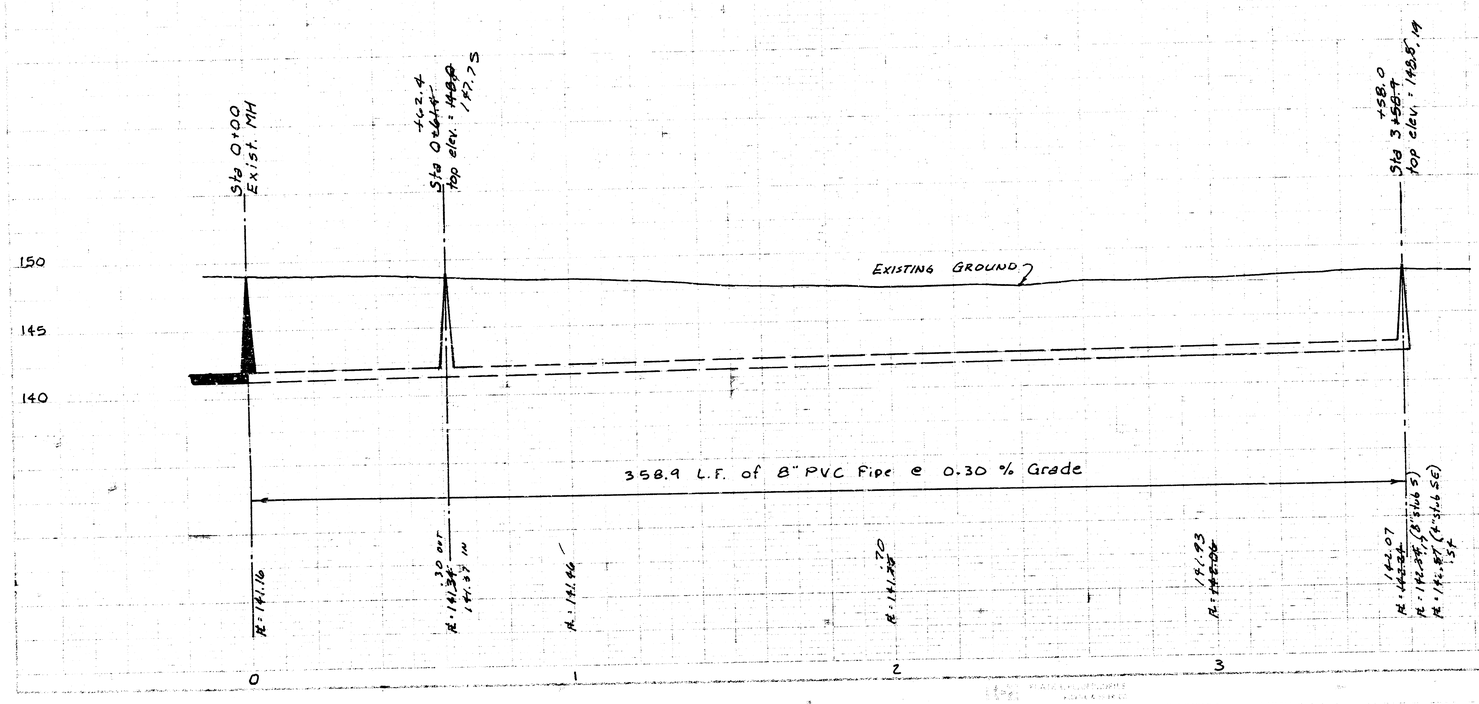

As Built 11-88 RDC

LAT 25, MAIN I, WESTLINK SEWER
CITY OF WICHITA, KANSAS
M. E. LINDEBAK – CITY ENGINEER
PROJ. NO. 468-76-245-81861-000-000-001