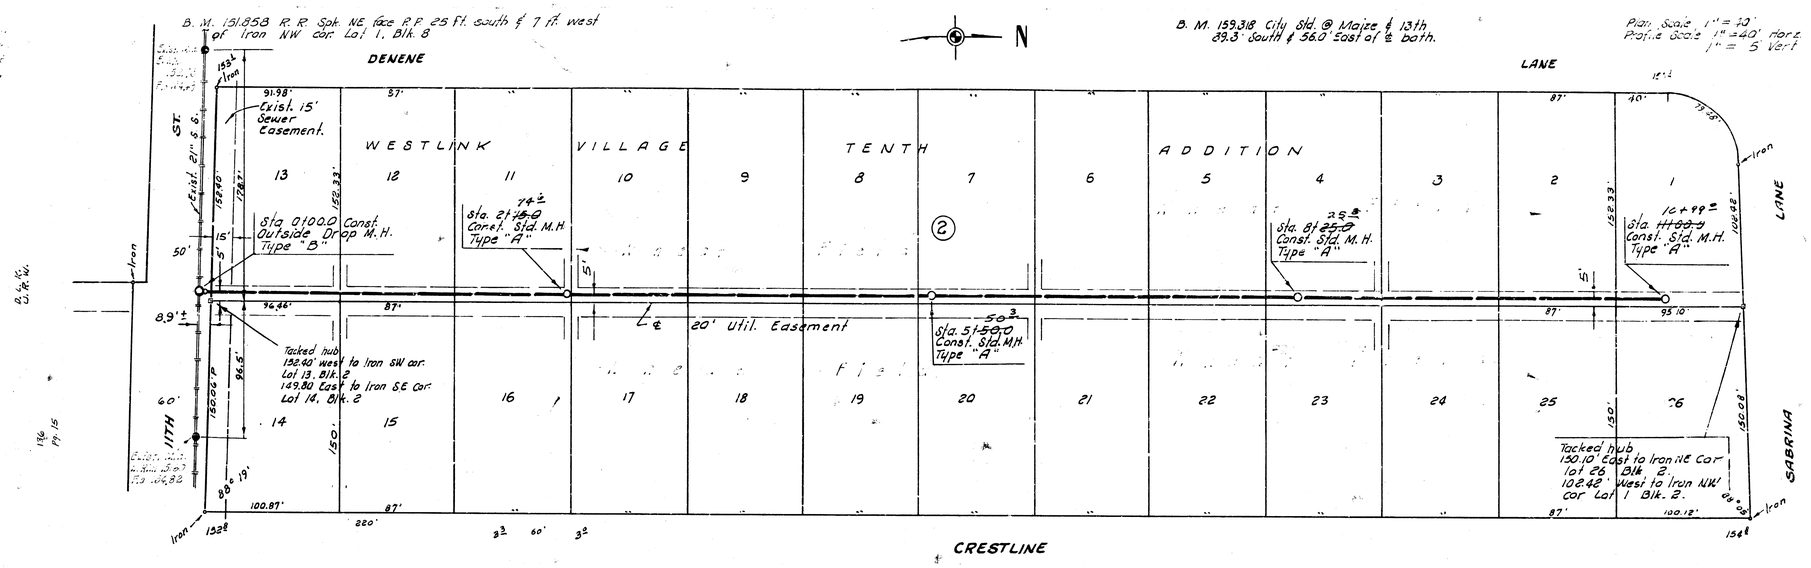

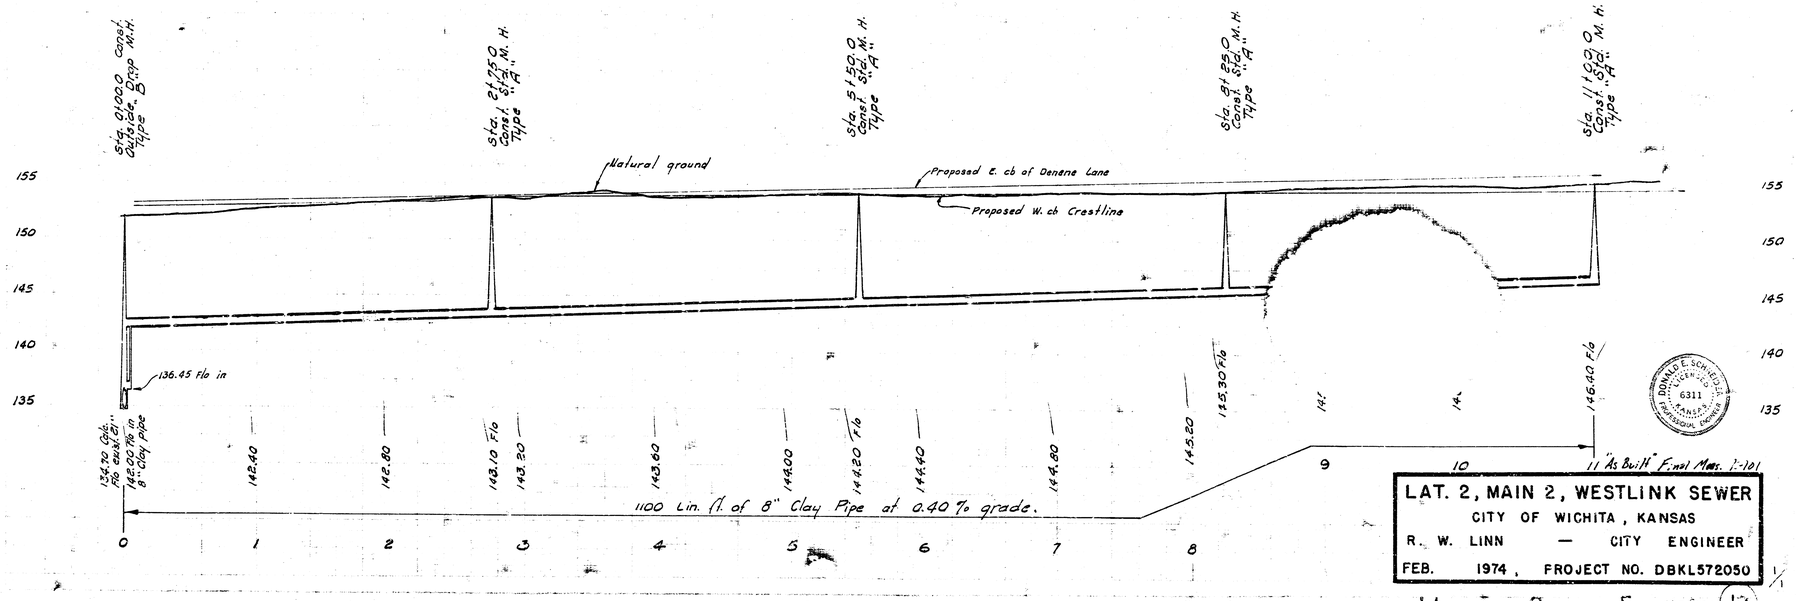

LAT. 2, MAIN 2, WESTLINK SEWER
CITY OF WICHITA, KANSAS
R. W. LINN — CITY ENGINEER
FEB. 1974, PROJECT NO. DBKL572050

FILMED FROM THE BEST AVAILABLE COPY