



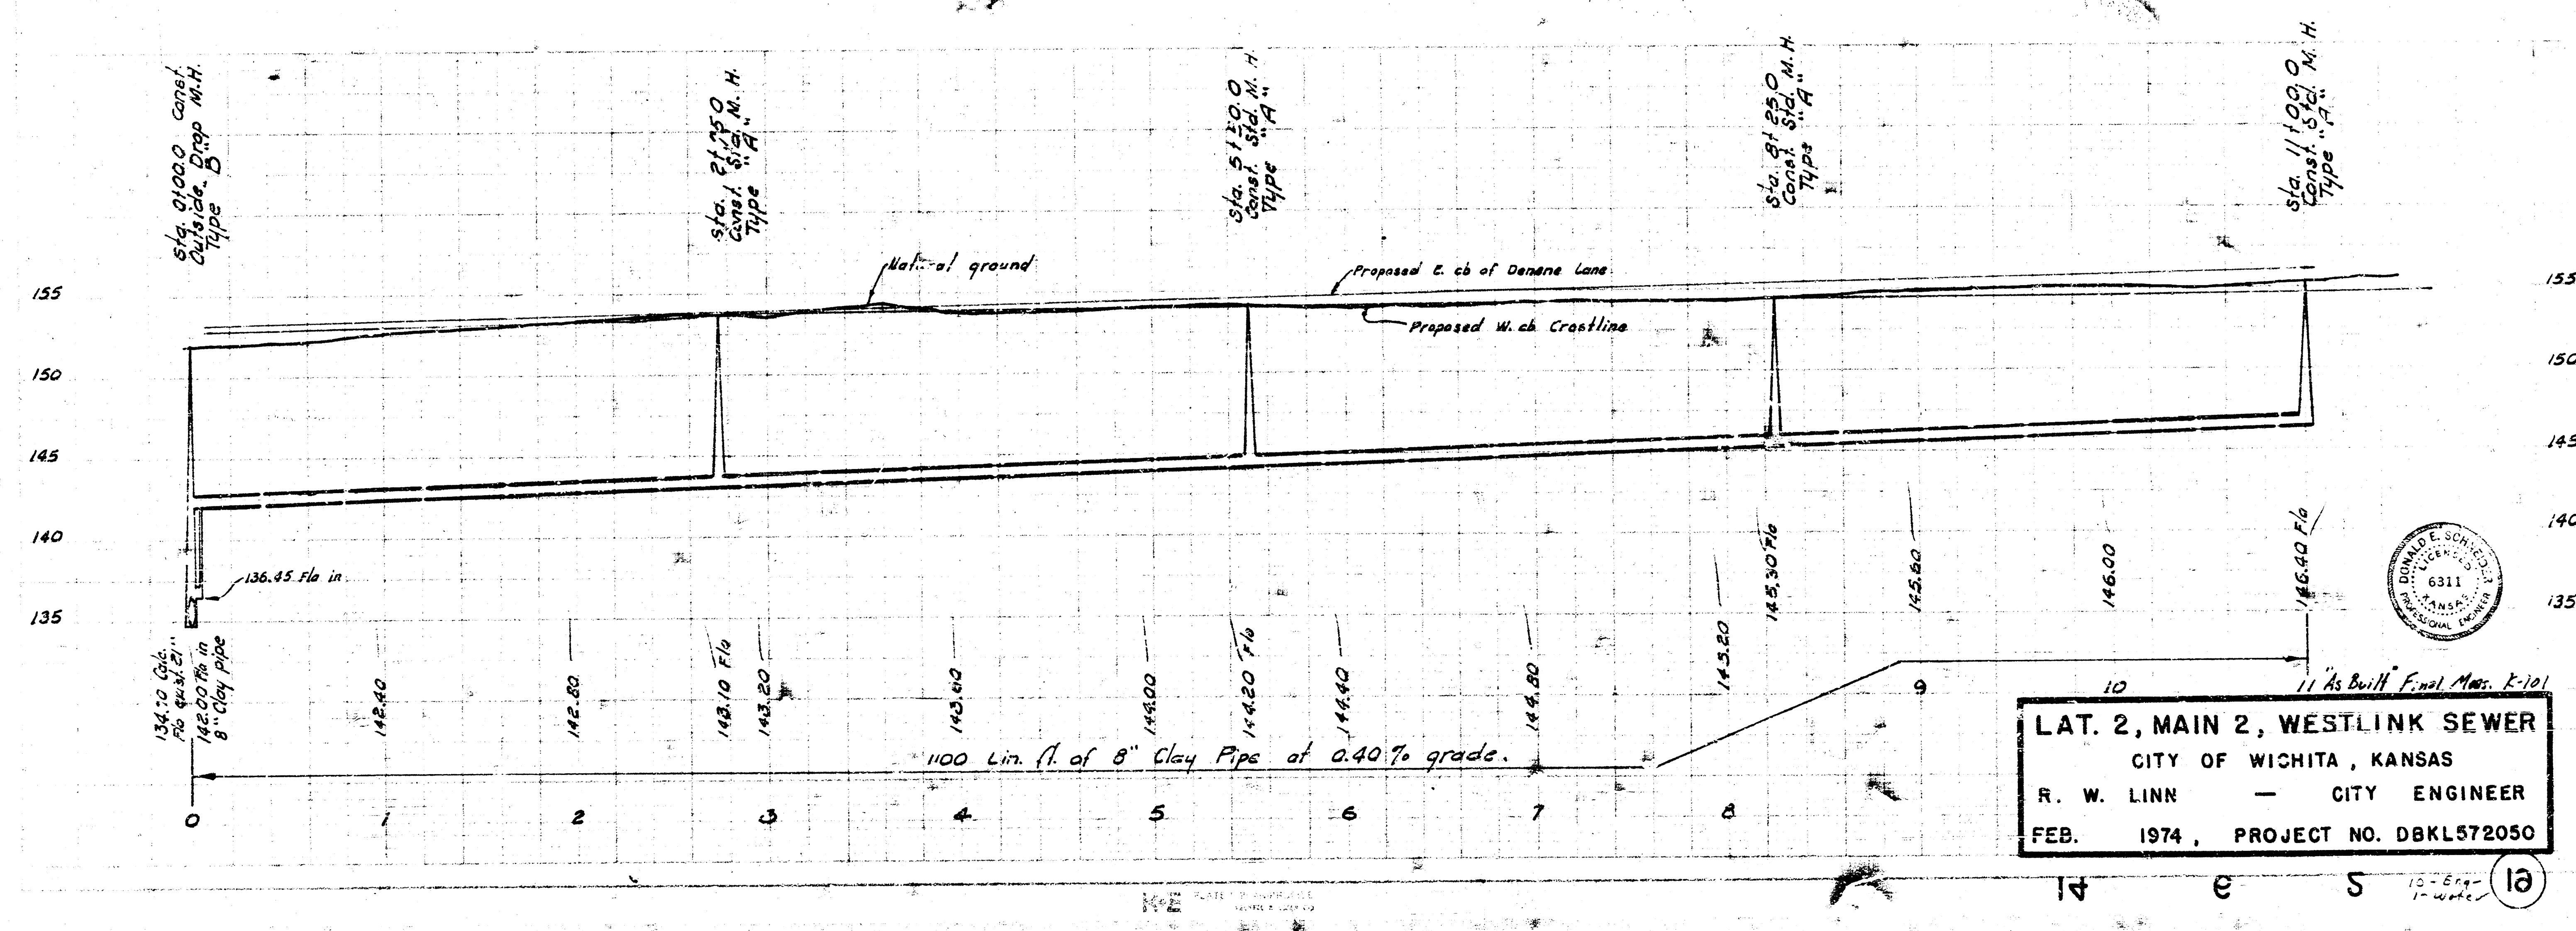

LAT. 2, MAIN 2, WESTLINK SEWER
 CITY OF WICHITA, KANSAS
 R. W. LINN — CITY ENGINEER
 FEB. 1974, PROJECT NO. DBKL572050

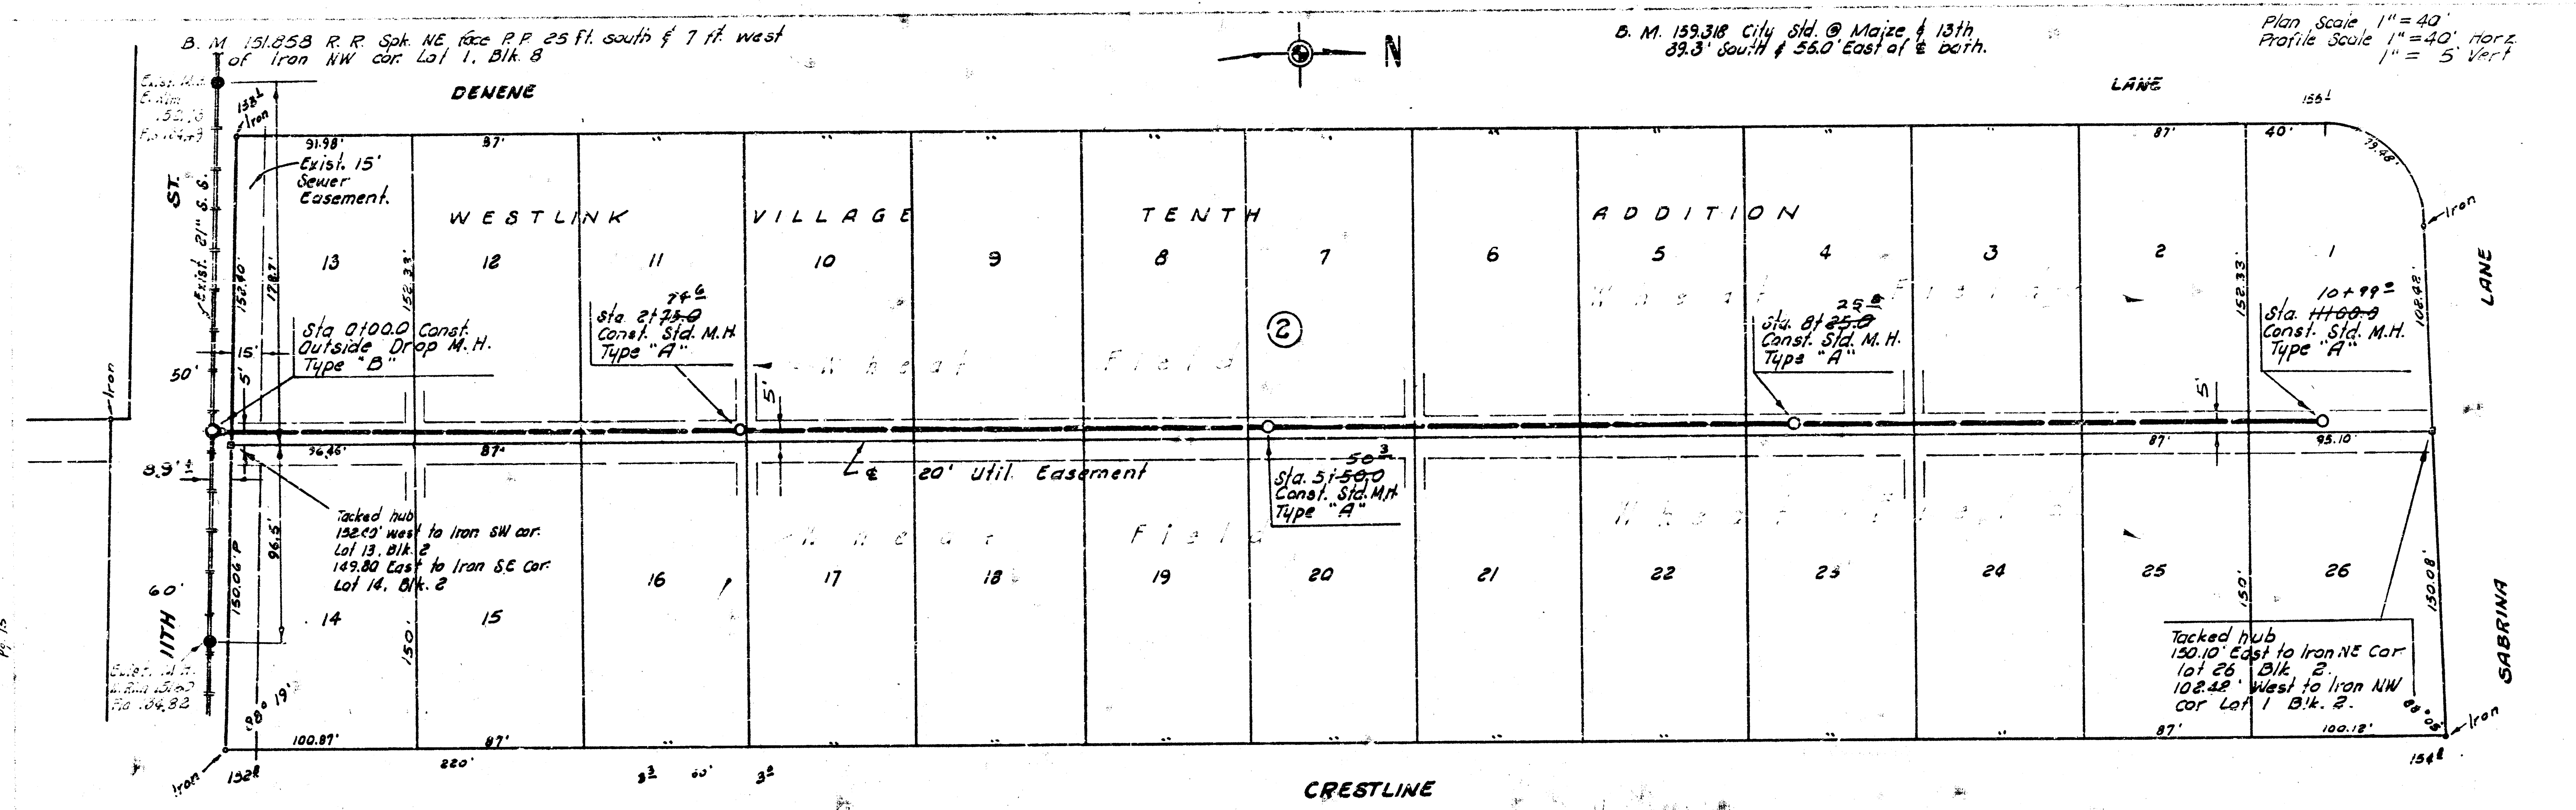