


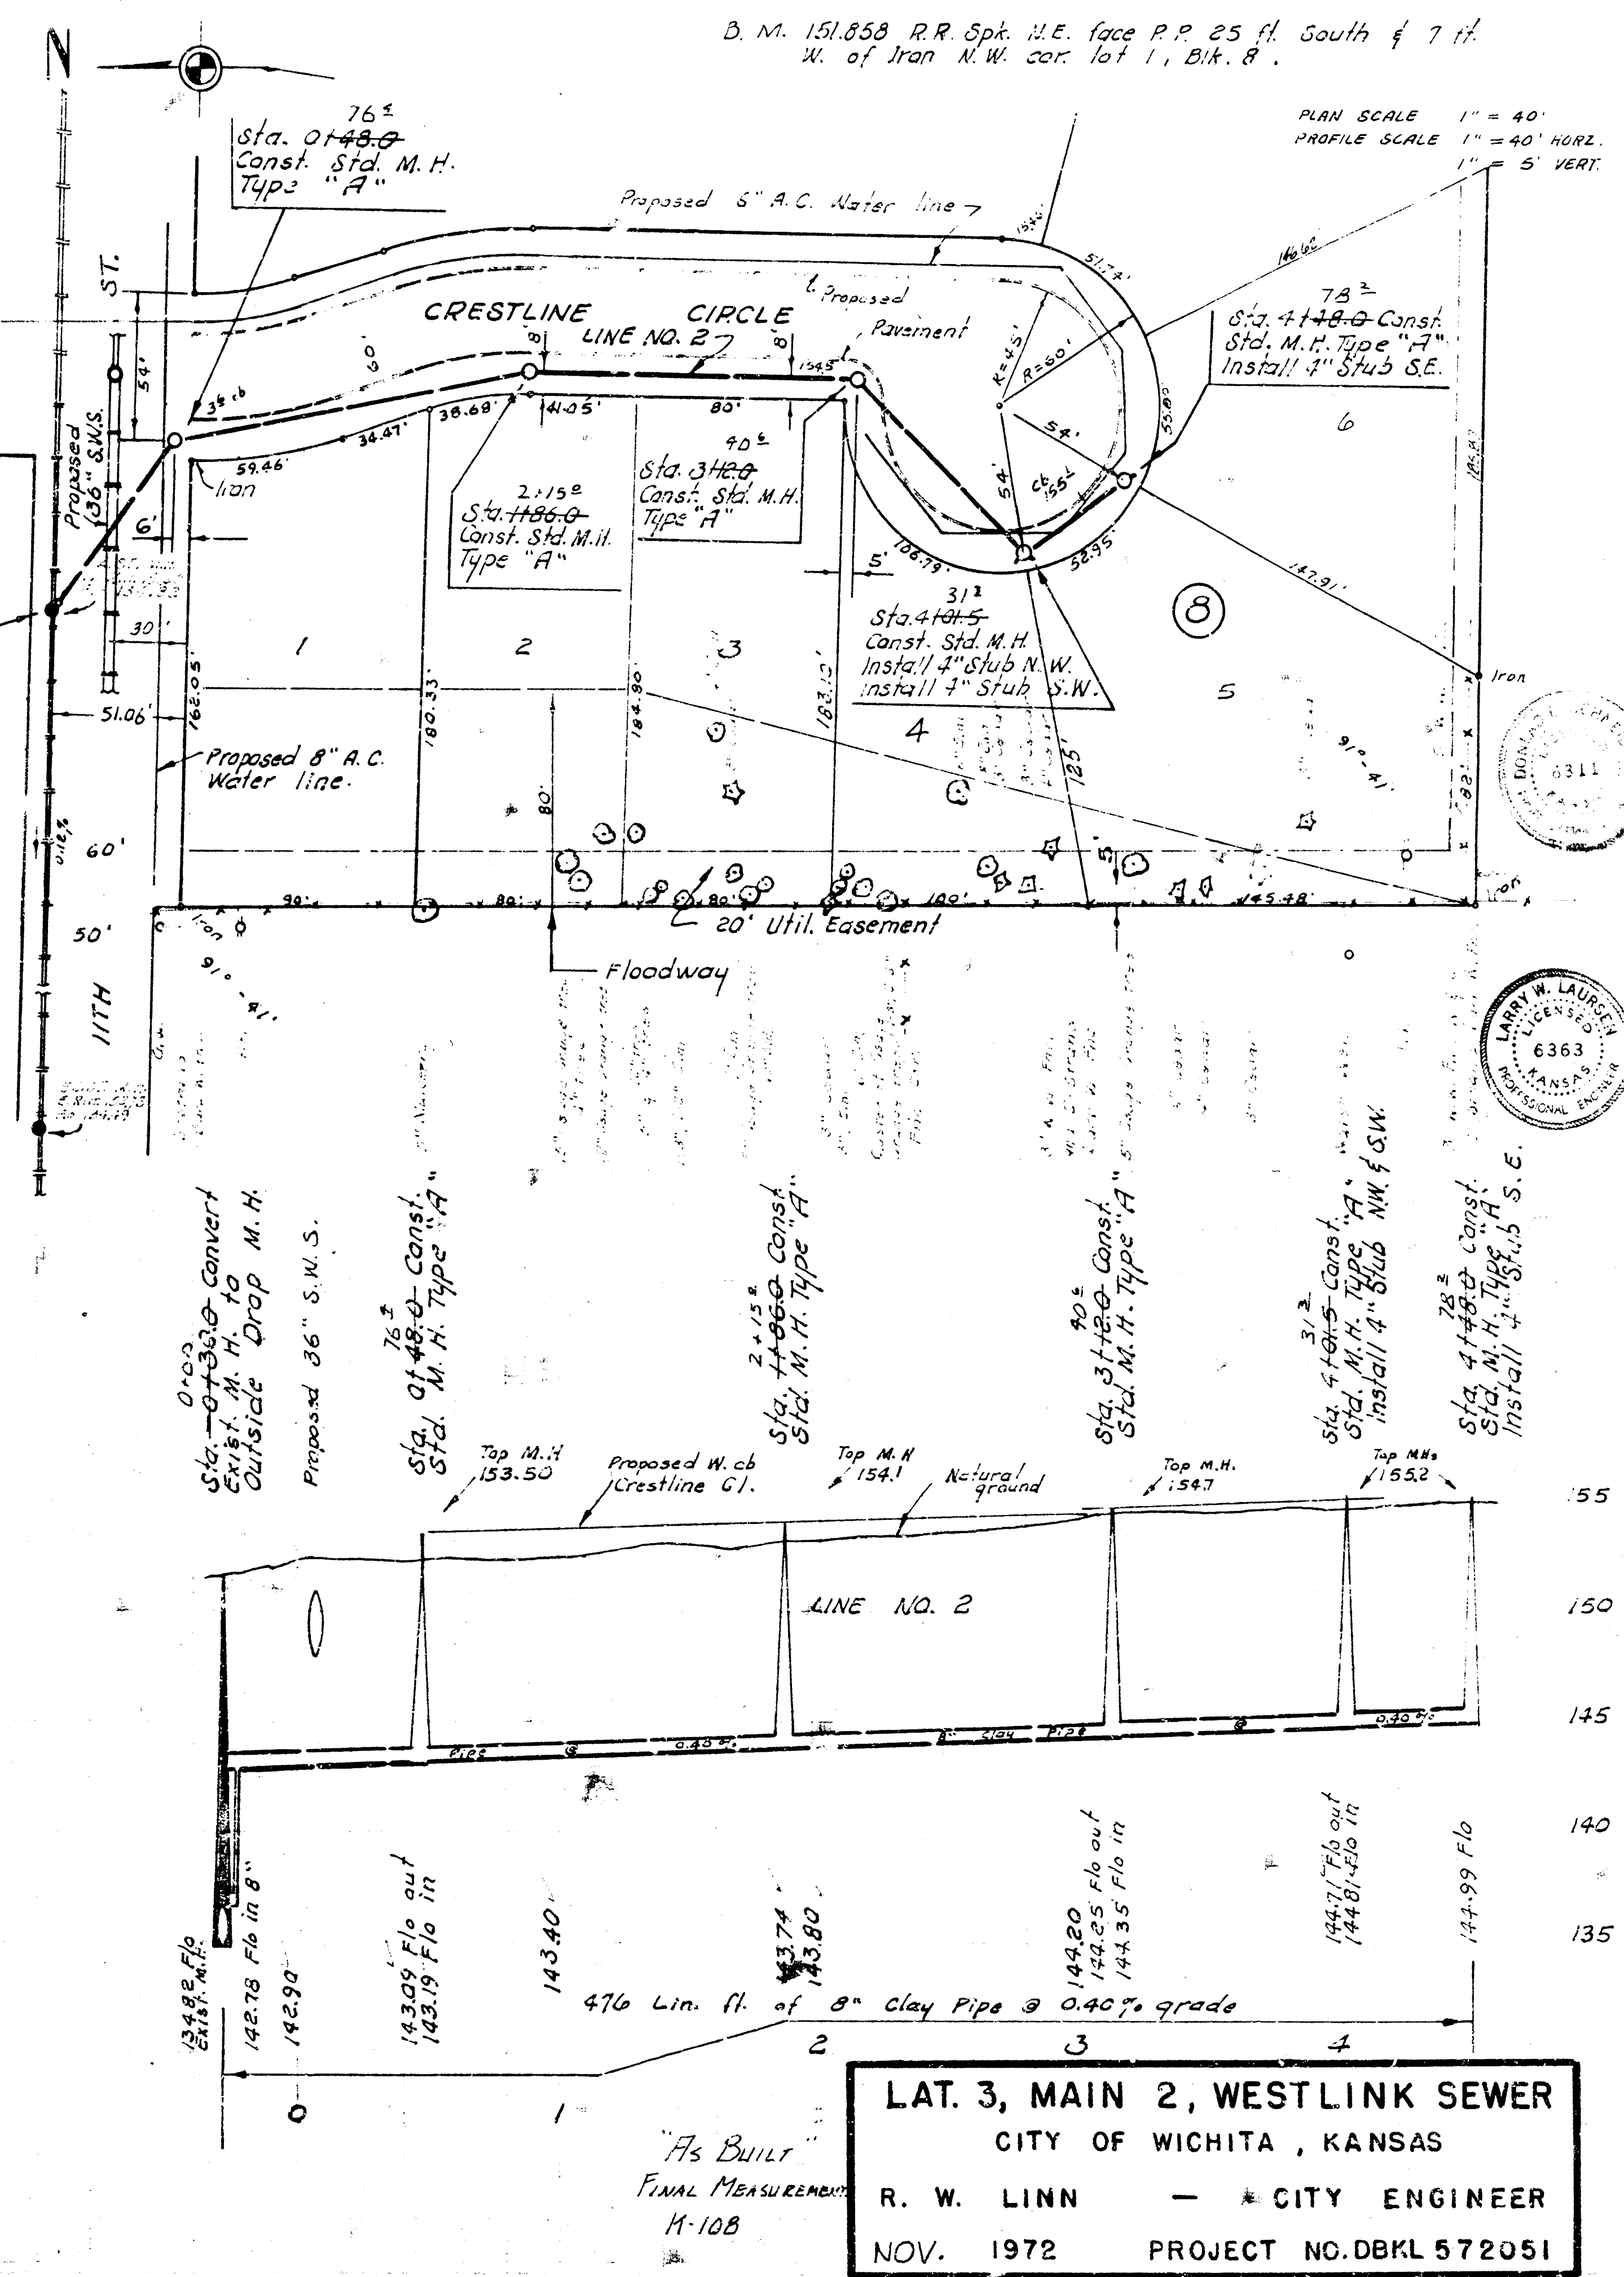

LAT. 3, MAIN 2, WESTLINK SEWER
CITY OF WICHITA, KANSAS

R. W. LINN — CITY ENGINEER

NOV. 1972 PROJECT NO. DBKL 572051